


This Drawing Is The Copyright Of Coventry University
Estates Department & Must Not Be Reproduced
Without Their Permission. Figured Dimensions Must Be
Taken In Preference To Scaled Dimensions & All
Dimensions Must Be Verified On Site Prior To
Commencing Any Works.

(Net Internal Area)

(Gross Internal Area)

(Gross External Area)

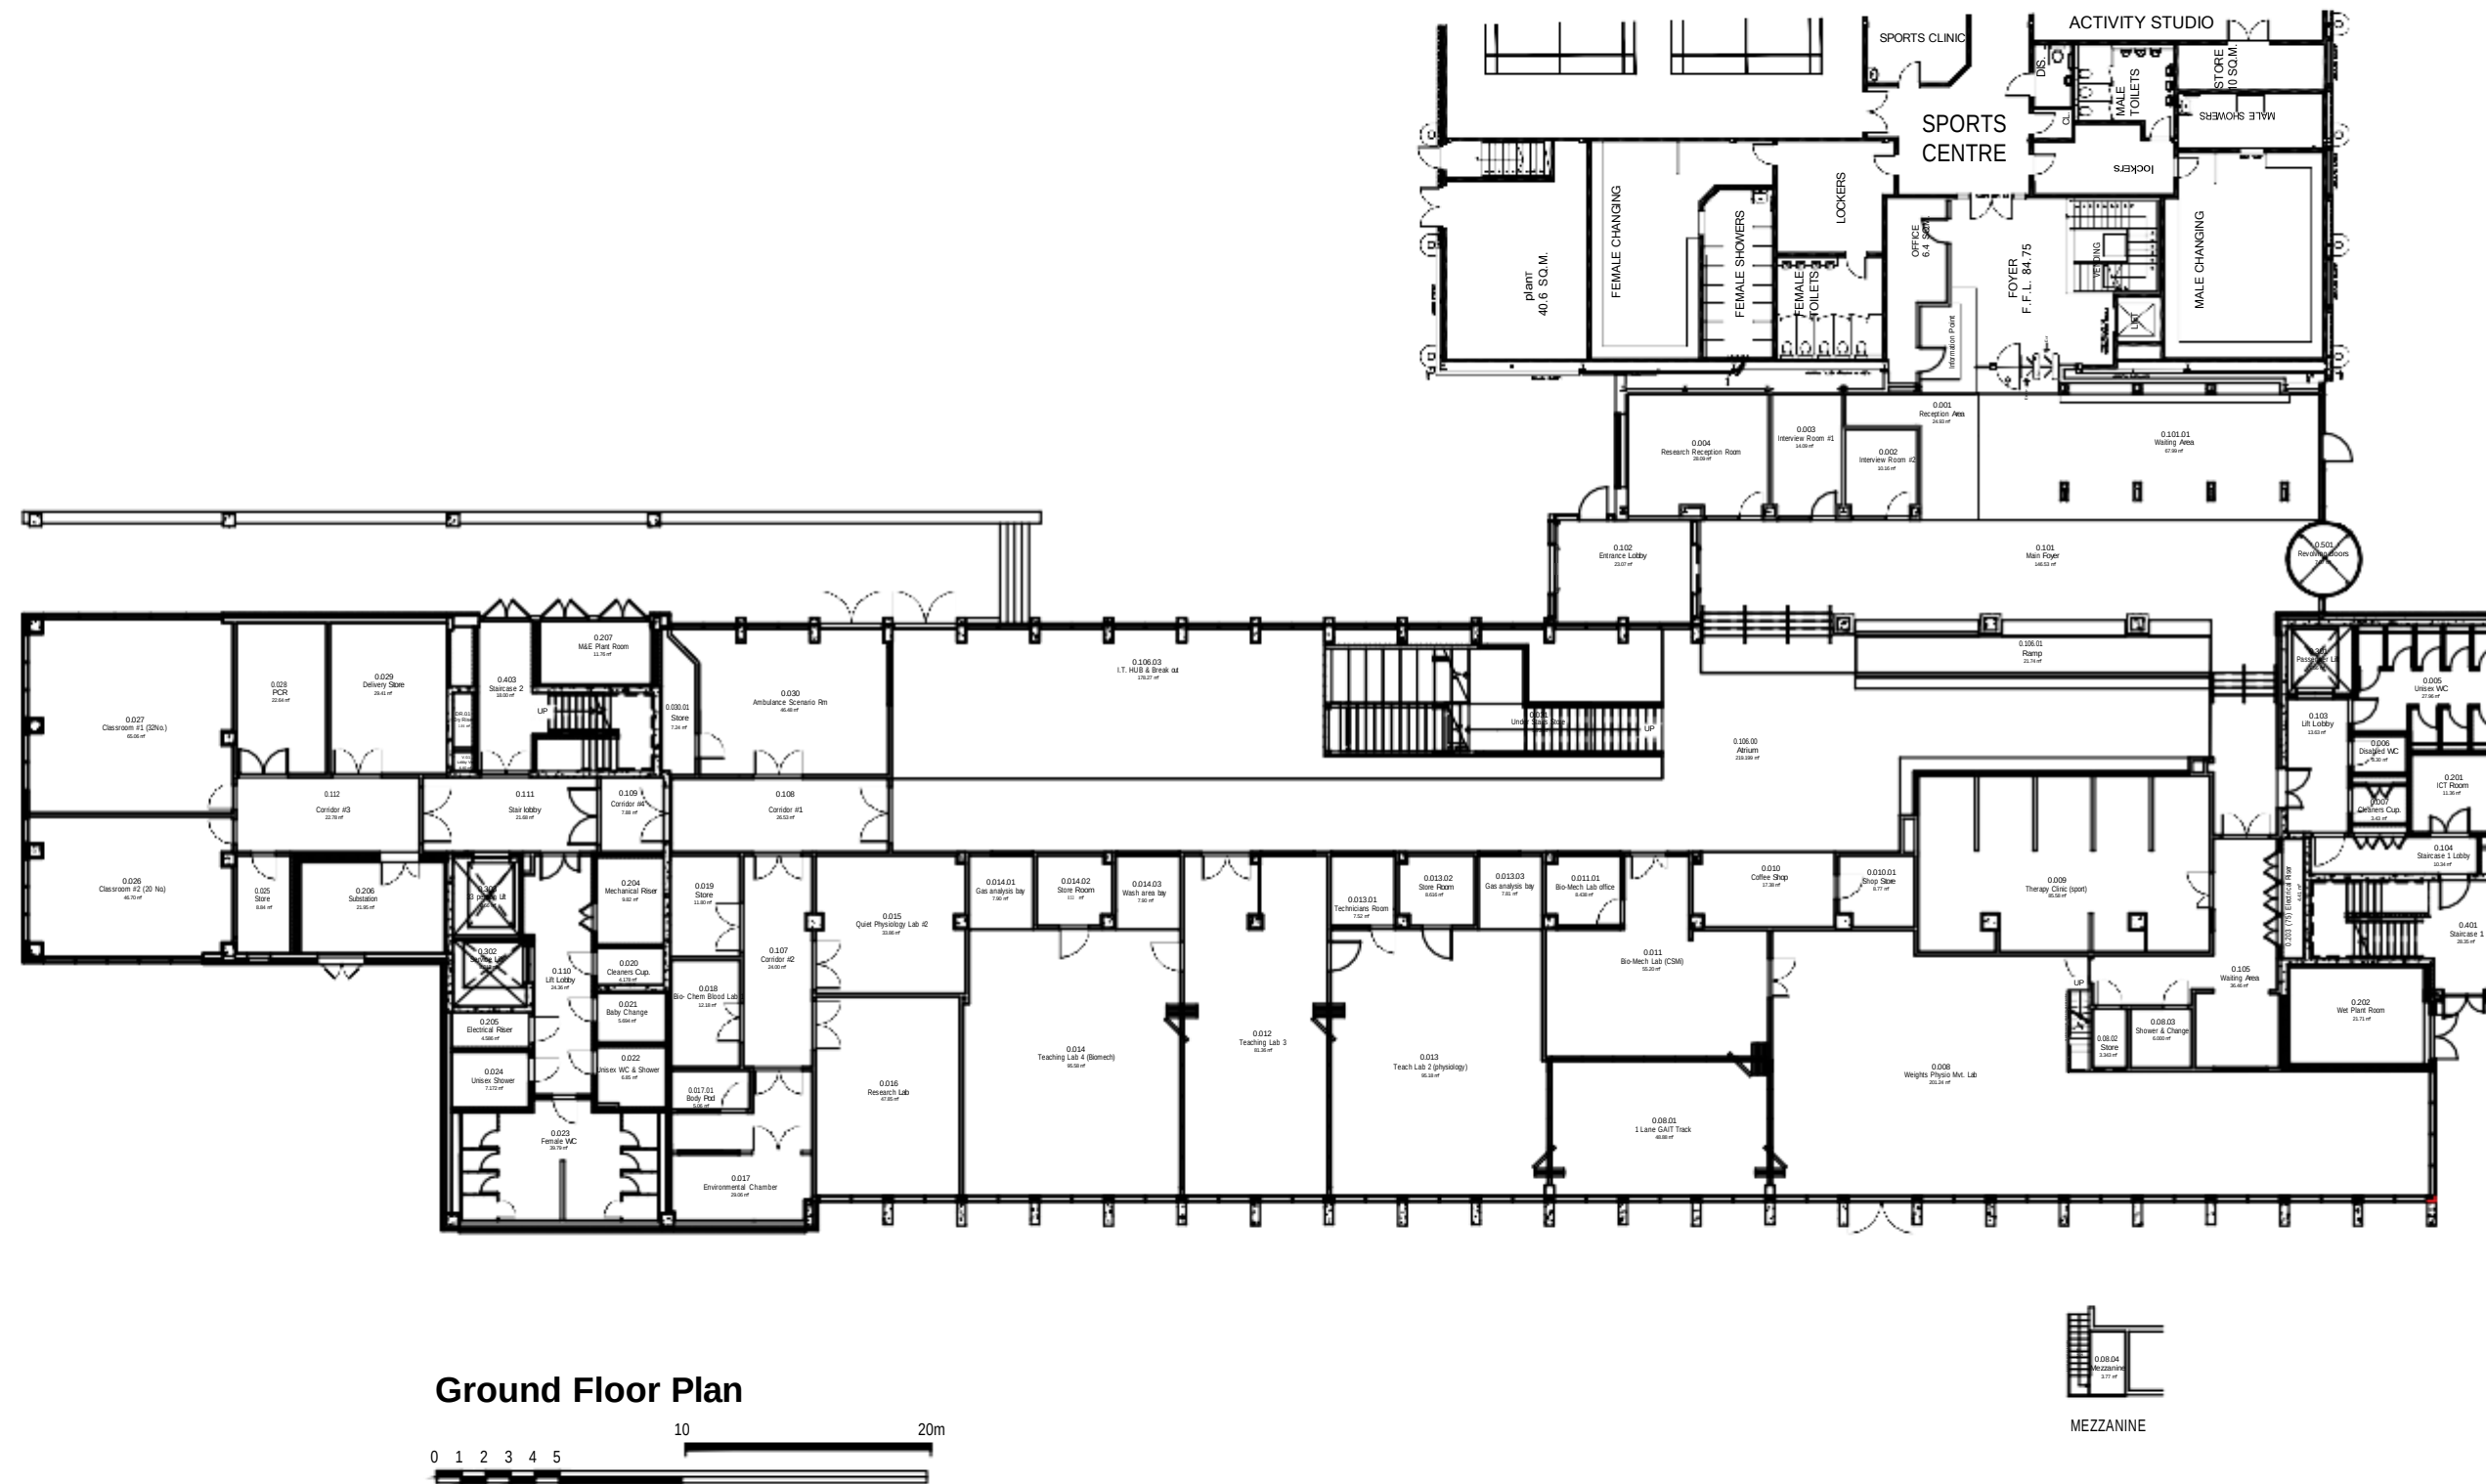

Rev.	Date	Amendment
------	------	-----------




RECORD DRAWING


ALISON GINGELL

GROUND FLOOR PLAN

DRAWN PSC		CHKD HS	DATE 09/02/2018
SCALE 1/200 @ A1	DRAWING No. AG001-COV-00-GF-M2-A		REV. 0000

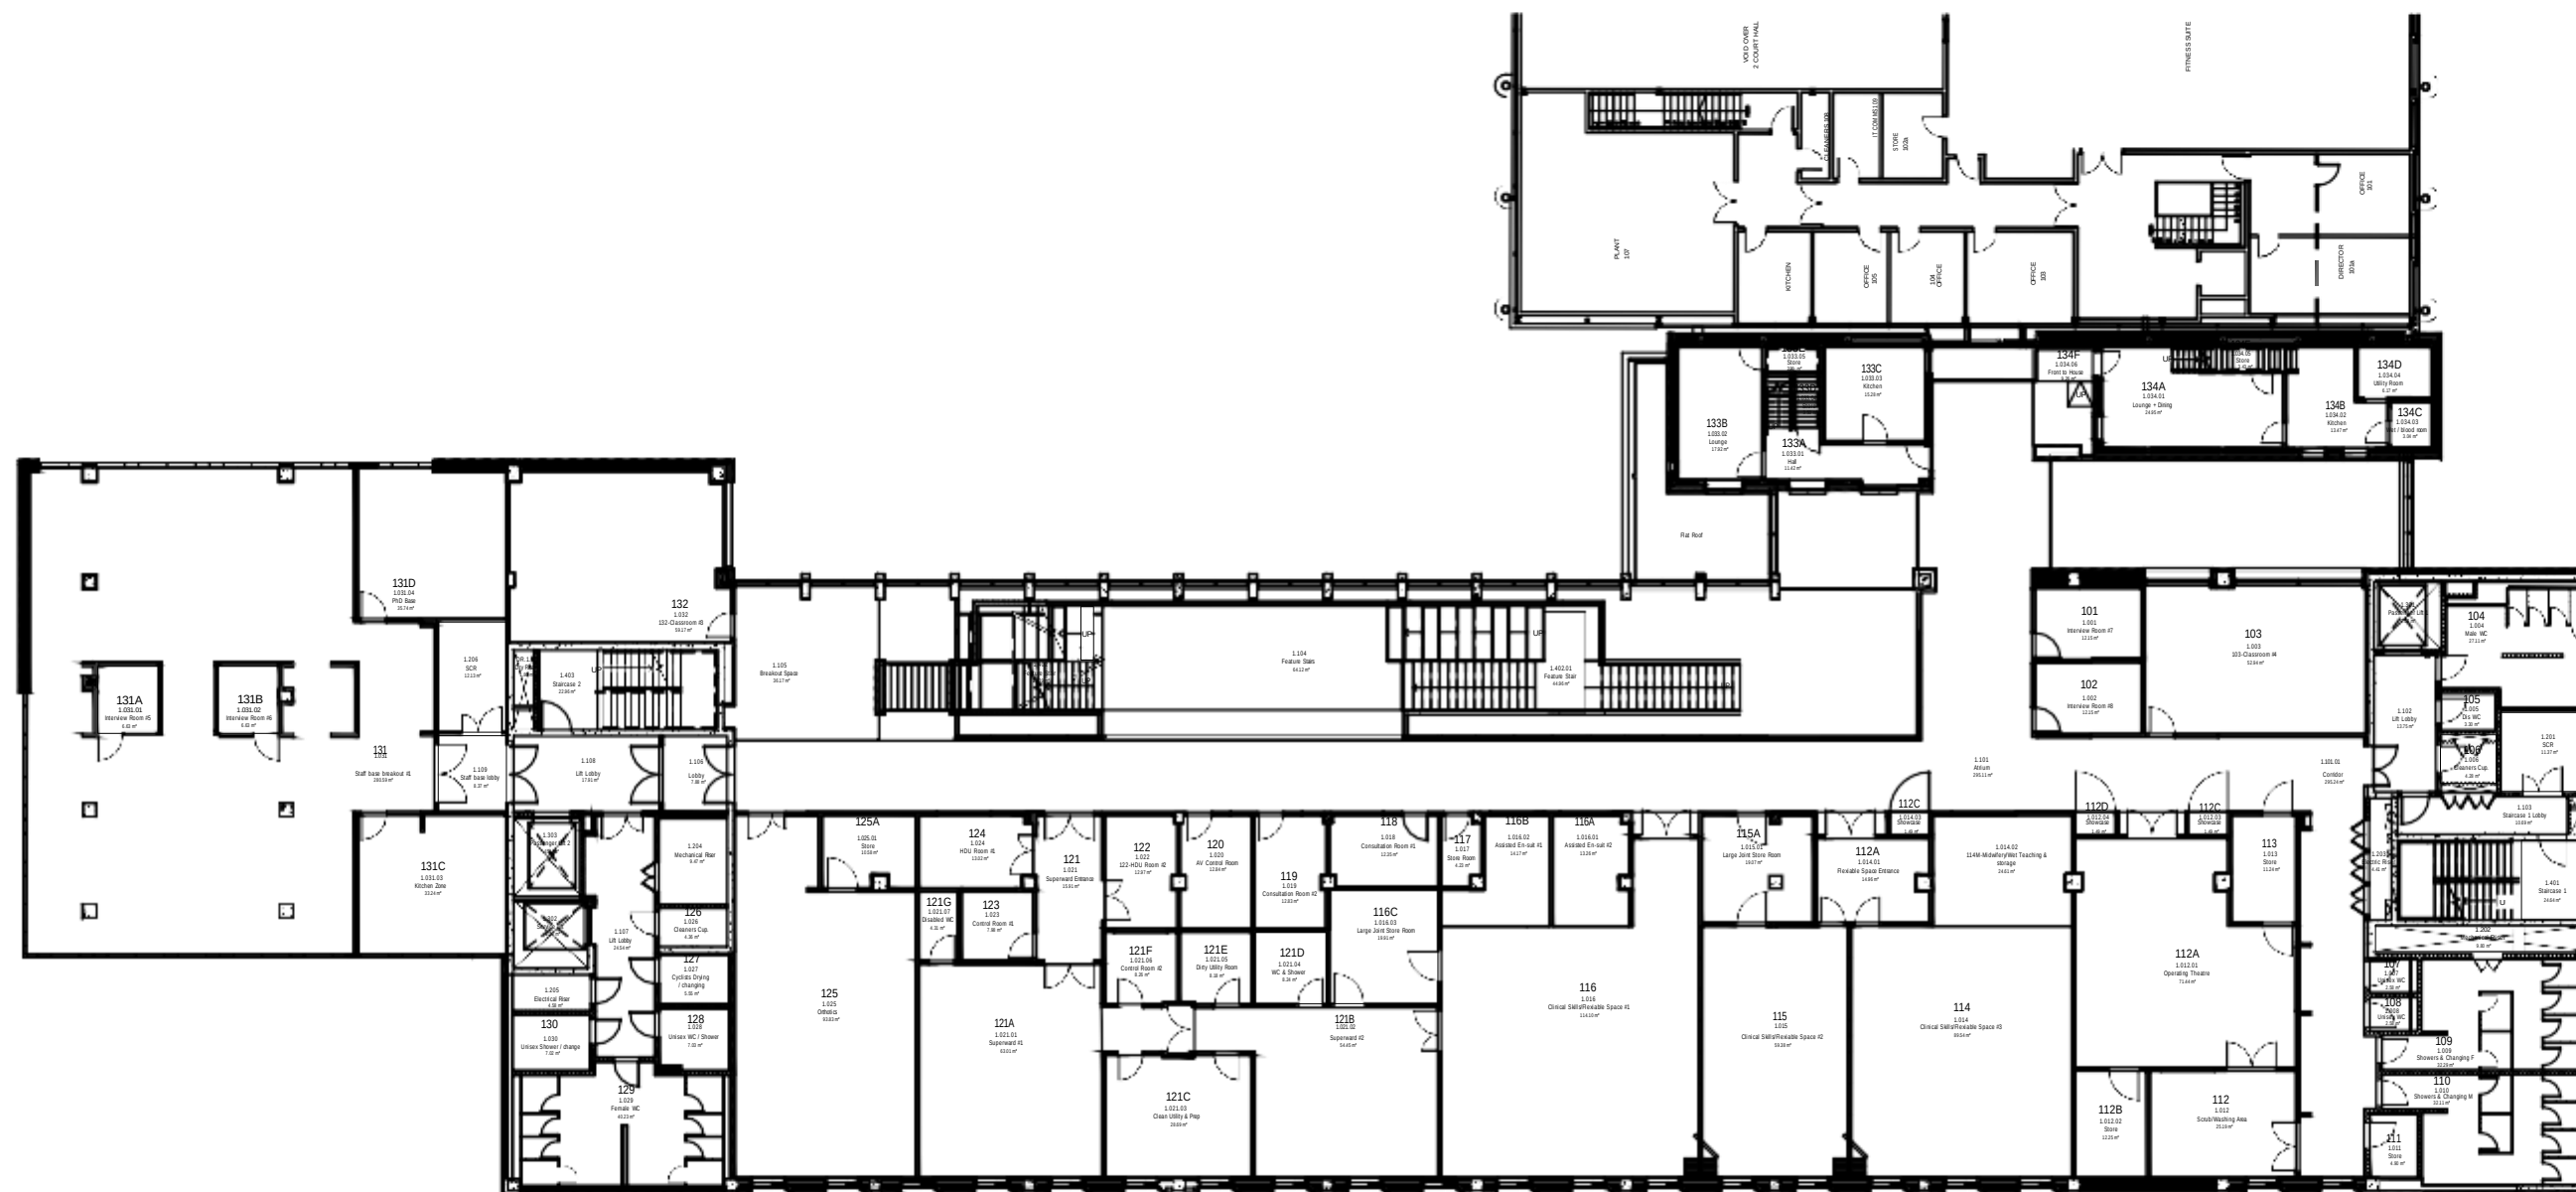

First Floor Plan

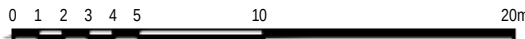

NOTES

This Drawing Is The Copyright Of Coventry University
Estates Department & Must Not Be Reproduced
Without Their Permission. Figured Dimensions Must Be
Taken In Preference To Scaled Dimensions & All
Dimensions Must Be Verified On Site Prior To
Commencing Any Works.

NIA : 1409m²
(Net Internal Area)

GIA : 2678.20m²
(Gross Internal Area)

GEA : 2819.24m²
(Gross External Area)



Rev.	Date	Amendment
------	------	-----------



Estates Department
Priory Street, Coventry
CV1 5FB
Tel: 024 76887688
Fax: 024 76887336

CURRENT STATUS

RECORD DRAWING

PROJECT


ALISON GINGELL BUILDING

TITLE


FIRST FLOOR PLAN

DRAWN	CHKD	DATE
PC	HS	09/02/2018

SCALE	DRAWING No.	REV.
1/200 @ A1	SHB001-COV-00-01-M2-A	0000

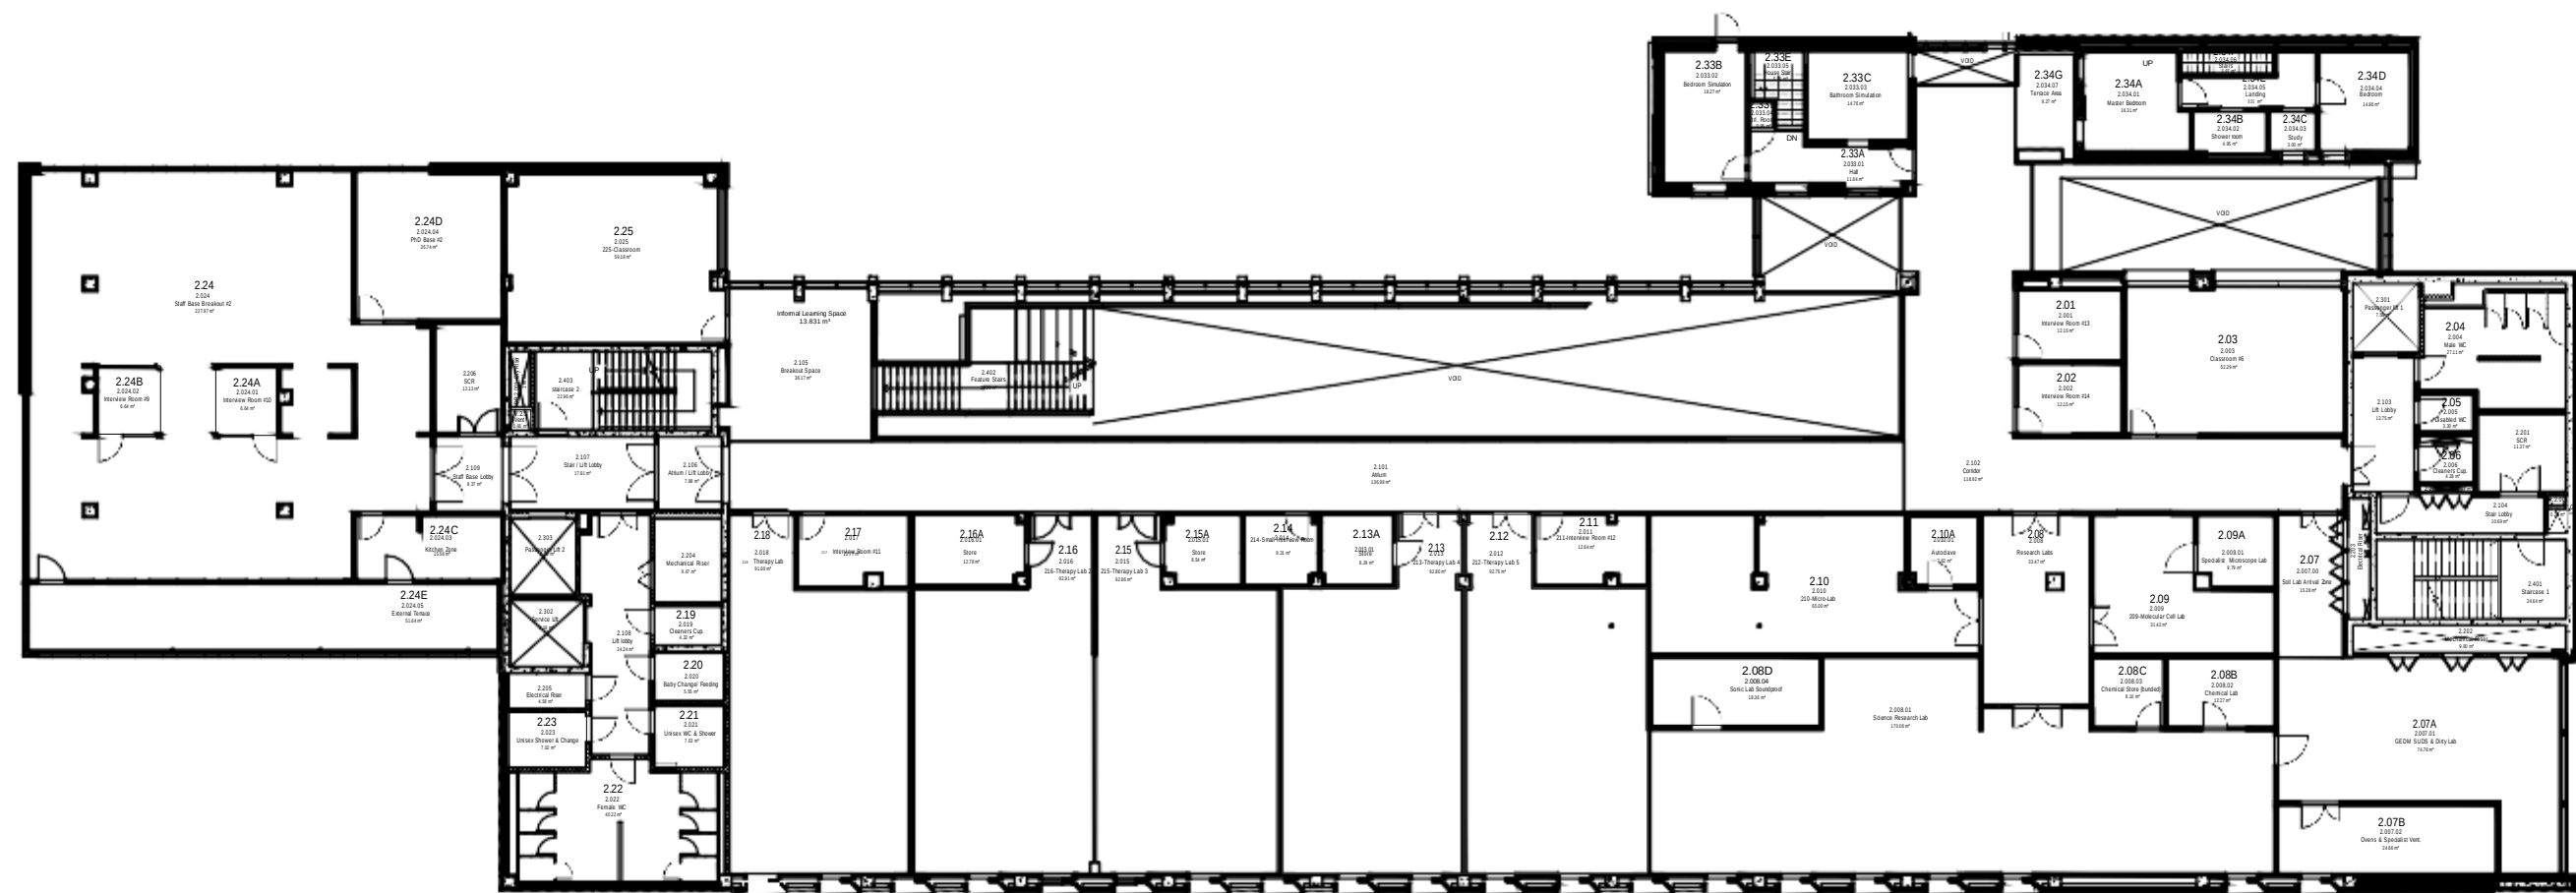

Second Floor Plan

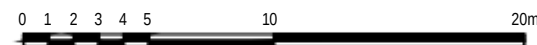

NOTES

This Drawing Is The Copyright Of Coventry University Estates Department & Must Not Be Reproduced Without Their Permission. Figured Dimensions Must Be Taken In Preference To Scaled Dimensions & All Dimensions Must Be Verified On Site Prior To Commencing Any Works.

NIA : 1511m²
(Net Internal Area)

GIA : 2670.65m²
(Gross Internal Area)

GEA : 2817.41m²
(Gross External Area)



Rev.	Date	Amendment



Estates Department
Priory Street, Coventry
CV1 5FB
Tel: 024 76887688
Fax: 024 76887336

CURRENT STATUS

RECORD DRAWING


PROJECT

ALISON GINGELL BUILDING


TITLE

SECOND FLOOR PLAN

DRAWN	PC	CHKD	HS	DATE	09/02/2018
SCALE	1/200 @ A1	DRAWING No.	SHB001-COV-00-02-M2-A	REV.	0000

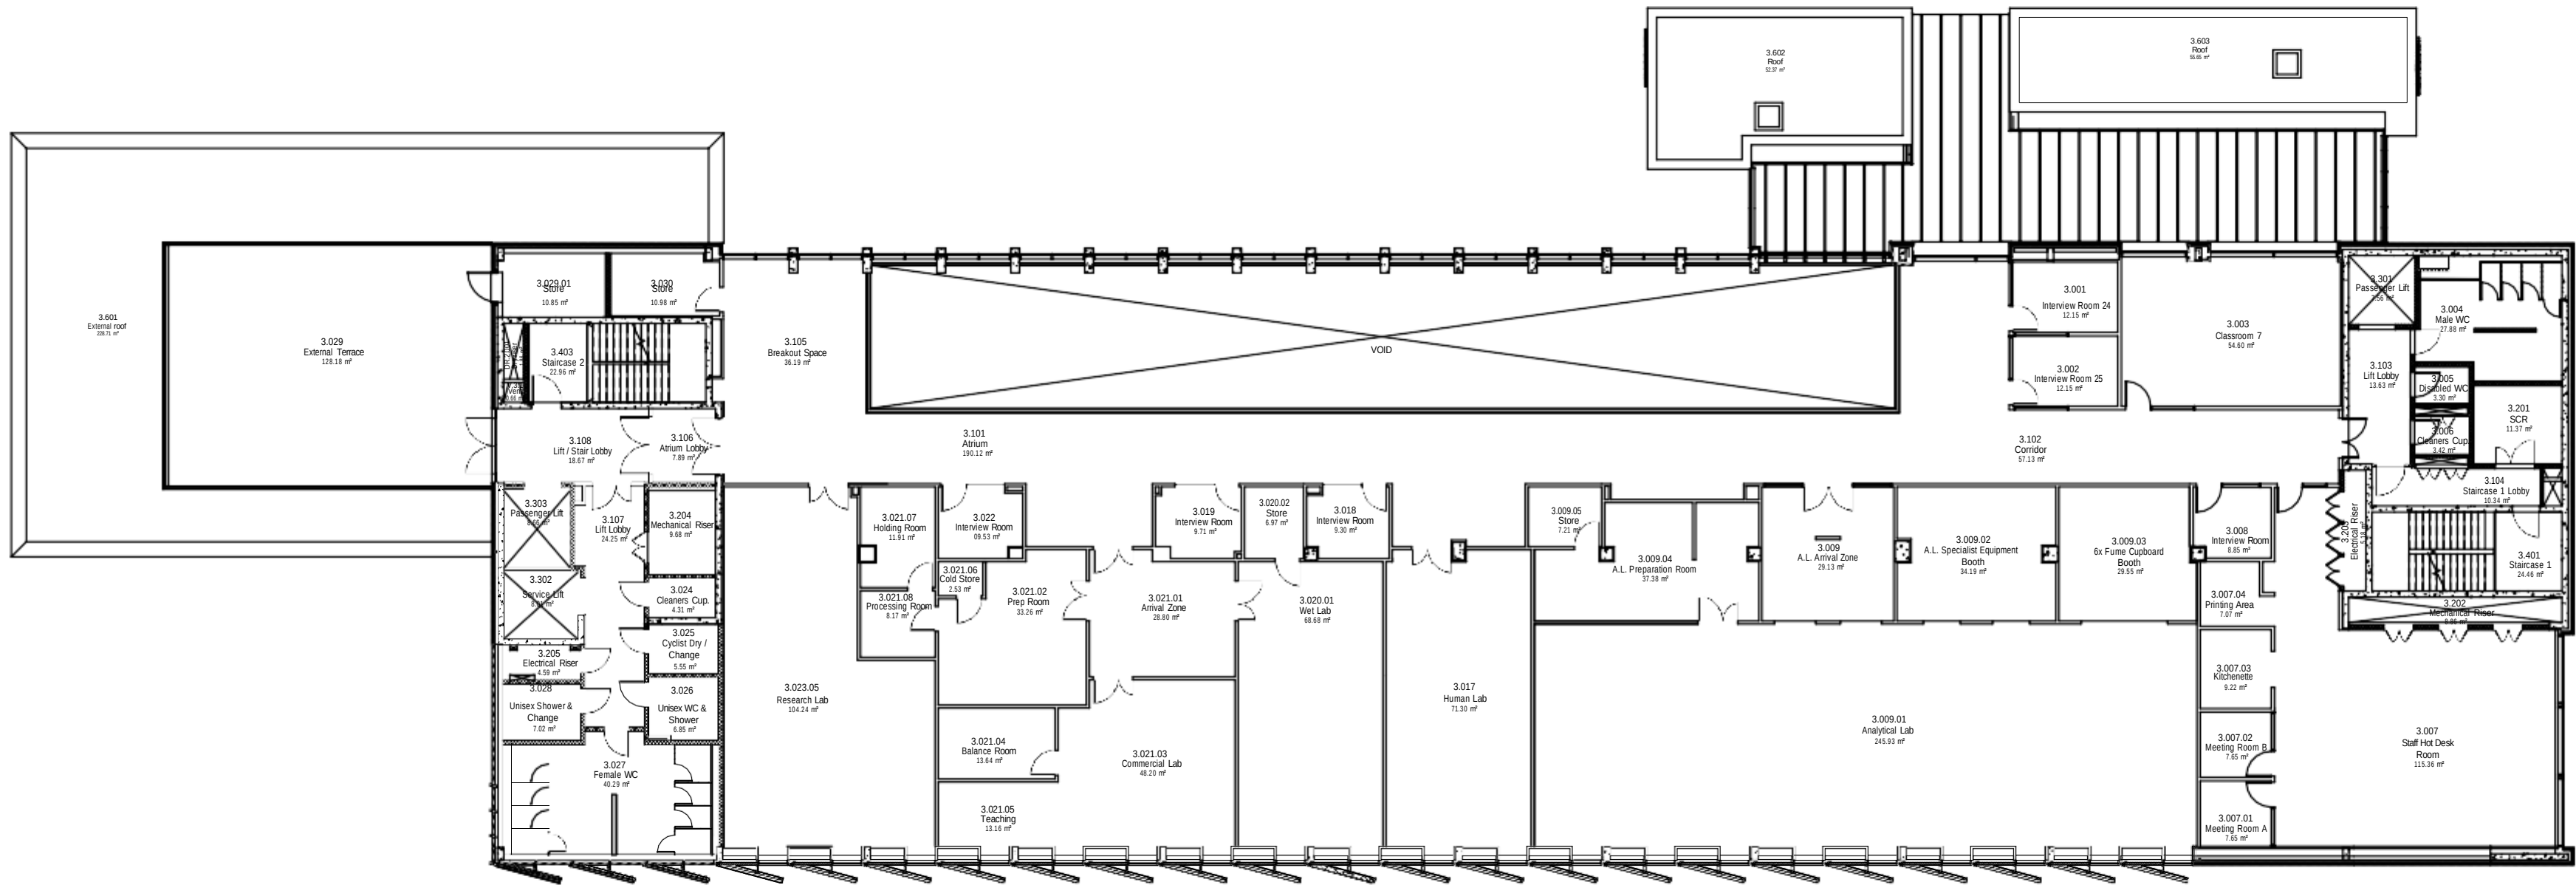

Third Floor Plan

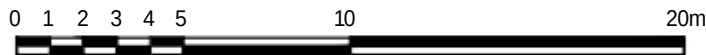

NOTES

This Drawing Is The Copyright Of Coventry University
Estates Department & Must Not Be Reproduced
Without Their Permission. Figured Dimensions Must Be
Taken In Preference To Scaled Dimensions & All
Dimensions Must Be Verified On Site Prior To
Commencing Any Works.

NIA : 1398m²
(Net Internal Area) :

GIA : 1740.75m²
(Gross Internal Area)

GEA : 2118.26m²
(Gross External Area)



Rev.	Date	Amendment
------	------	-----------



Estates Department
Priority Street, Coventry
CV1 5FB
Tel: 024 76887688
Fax: 024 76887336

CURRENT STATUS

RECORD DRAWING

PROJECT


ALISON GINGELL

TITLE


THIRD FLOOR PLAN

DRAWN	KA	CHKD	EM	DATE	20/06/2019
-------	----	------	----	------	------------

SCALE	1/150 @ A1	DRAWING No.	SHB001-COV-00-03-M2-A	REV.	0000
-------	------------	-------------	-----------------------	------	------

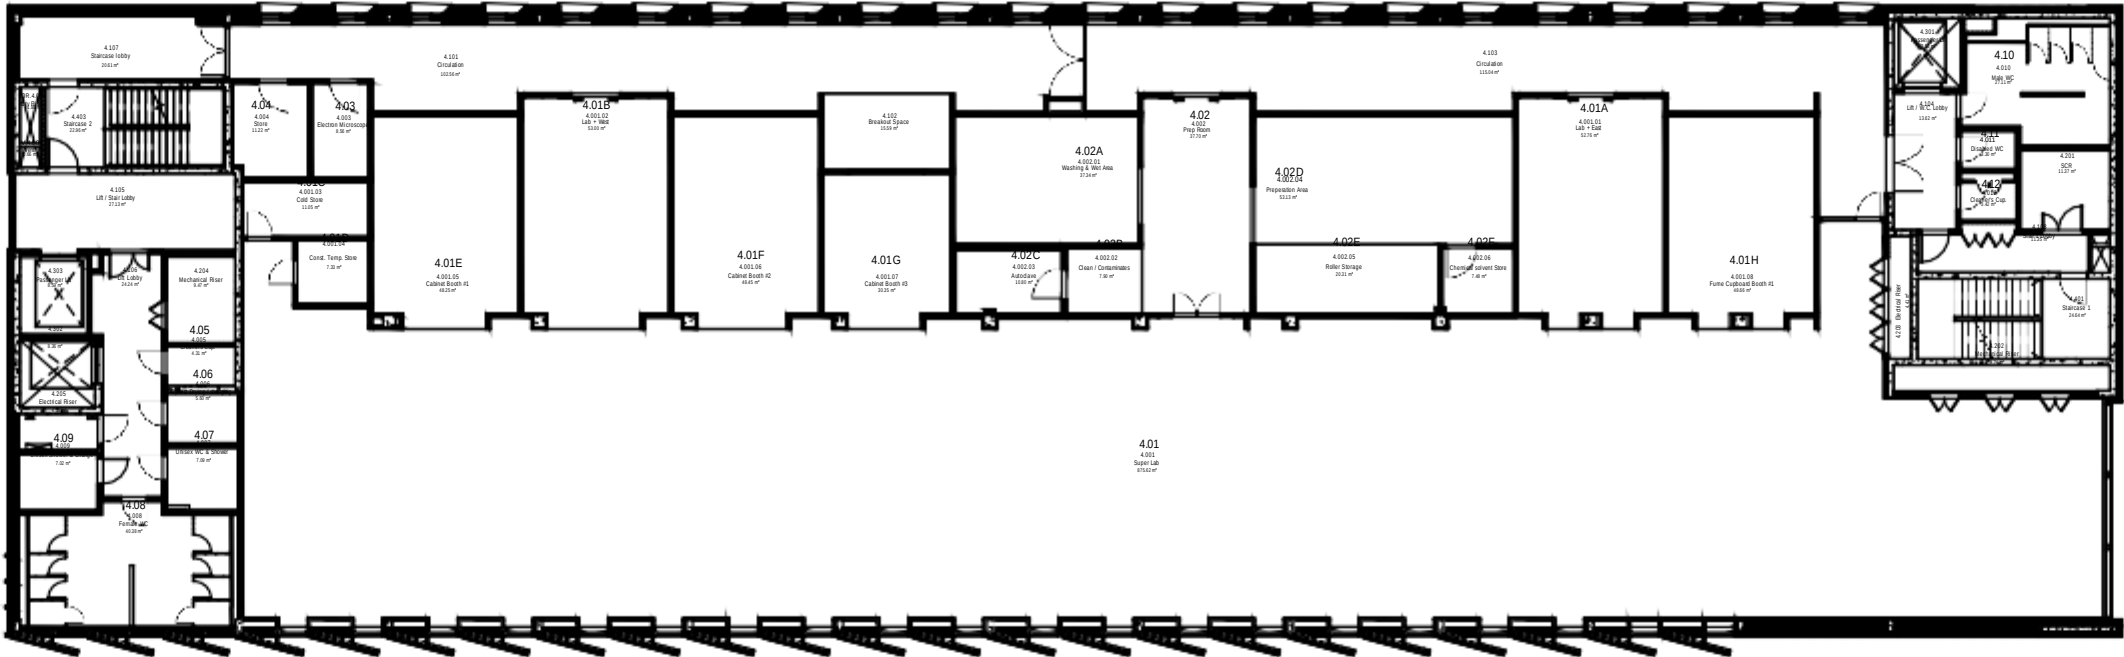

Fourth Floor Plan

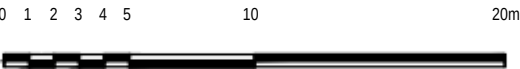

NOTES

This Drawing Is The Copyright Of Coventry University
Estates Department & Must Not Be Reproduced
Without Their Permission. Figured Dimensions Must Be
Taken In Preference To Scaled Dimensions & All
Dimensions Must Be Verified On Site Prior To
Commencing Any Works.

NIA : 1386m²

(Net Internal Area) :

GIA : 1992.86m²

(Gross Internal Area)

GEA : 2145.57m²

(Gross External Area)



Rev.	Date	Amendment



Estates Department
Priority Street, Coventry
CV1 5FB
Tel: 024 76887688
Fax: 024 76887336

CURRENT STATUS

RECORD DRAWING

PROJECT


ALISON GINGELL BUILDING

TITLE

FOURTH FLOOR PLAN

DRAWN	CHKD	DATE
PC	HS	09/02/2018

SCALE	DRAWING No.	REV.
1:200 @ A1	SHB001-COV-00-04-M2-A	0000

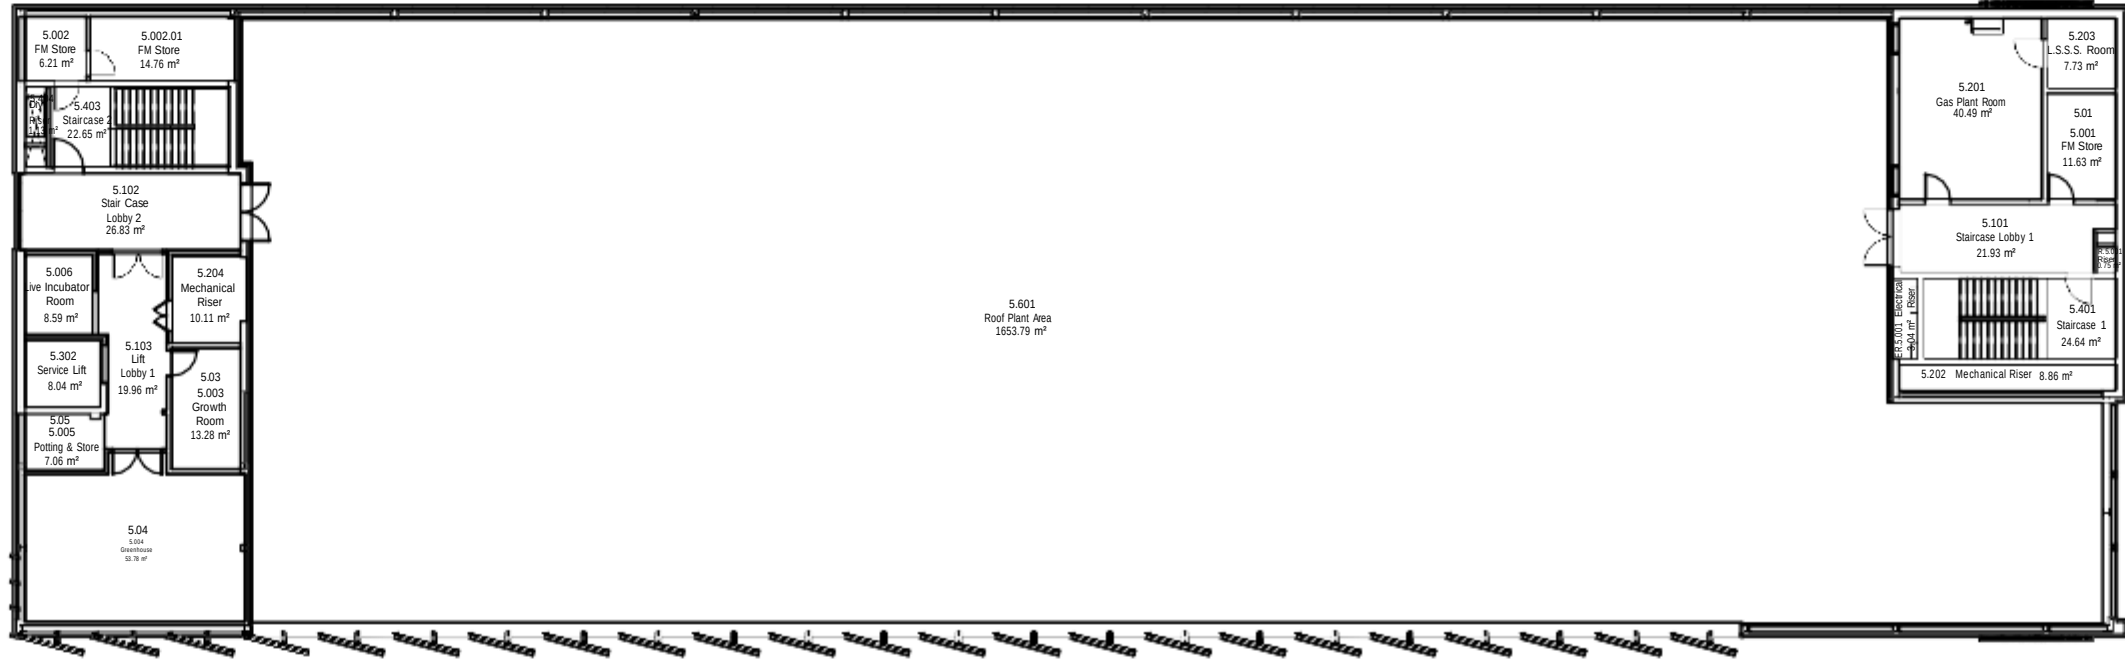

Roof Plan

NIA = 1963.41 m²
GEA = 2145.05 m²

0 1 2 3 4 5 10 20m

NOTES

This Drawing Is The Copyright Of Coventry University
Estates Department & Must Not Be Reproduced
Without Their Permission. Figured Dimensions Must Be
Taken In Preference To Scaled Dimensions & All
Dimensions Must Be Verified On Site Prior To
Commencing Any Works.



Rev.	Date	Amendment
------	------	-----------



Estates Department
Priority Street, Coventry
CV1 5FB
Tel: 024 76887688
Fax: 024 76887336

CURRENT STATUS

RECORD DRAWING

PROJECT

ALISON GINGELL BUILDING

TITLE

ROOF

DRAWN	SYL	CHKD CHKD	DATE 11/06/2018
-------	-----	--------------	--------------------

SCALE	DRAWING No.	REV.
1/200 @ A1	AG001-COV-00-R-M2-A	0000