

NOTES

This Drawing Is The Copyright Of Coventry University Estates Department & Must Not Be Reproduced Without Their Permission. Figured Dimensions Must Be Taken In Preference To Scaled Dimensions & All Dimensions Must Be Verified On Site Prior To Commencing Any Works.

AREAS

GEA (Gross External Area)	
GIA (Gross Internal Area)	3949.84 m ²
GIA Mezzanine	426.1 m
GIA Basement	45.18m ²
NIA (Net Internal Area)	



0 1 2 3 4 5 10 20m

D	14/02/2023	Refurbishment to Mezzanine & AL-G03	SG
C	21/09/2021	Refurbishment to east wing storage facilities	
B	20/12/2020	External Spaces (Cycle) Added	
A	26/10/2020	The Floor plan updated	
-	15/04/2020	The Floor plan data NOT up to date	
Rev	Date	Amendment	Drawn



Coventry
University

Estate Department
Prior Street, Coventry
CV1 5PF
Tel: 024 76887688
Fax: 024 76887336

CURRENT STATUS

RECORD DRAWING

PROJECT

ALMA BUILDING

TITLE

GROUND FLOOR PLAN & MEZZANINE FLOOR PLAN

DRAWN EM CHKD DATE 26/10/2020


SCALE 1:200 DRAWING No. AL001-COV-00-G-M2-A REV D

NOTES

This Drawing Is The Copyright Of Coventry University Estates Department & Must Not Be Reproduced Without Their Permission. Figured Dimensions Must Be Taken In Preference To Scaled Dimensions & All Dimensions Must Be Verified On Site Prior To Commencing Any Works.

AREAS

GEA (Gross External Area)	1497.38m ²
GIA (Gross Internal Area)	1326.54 m ²
nia (Net Internal Area)	981.71m ²

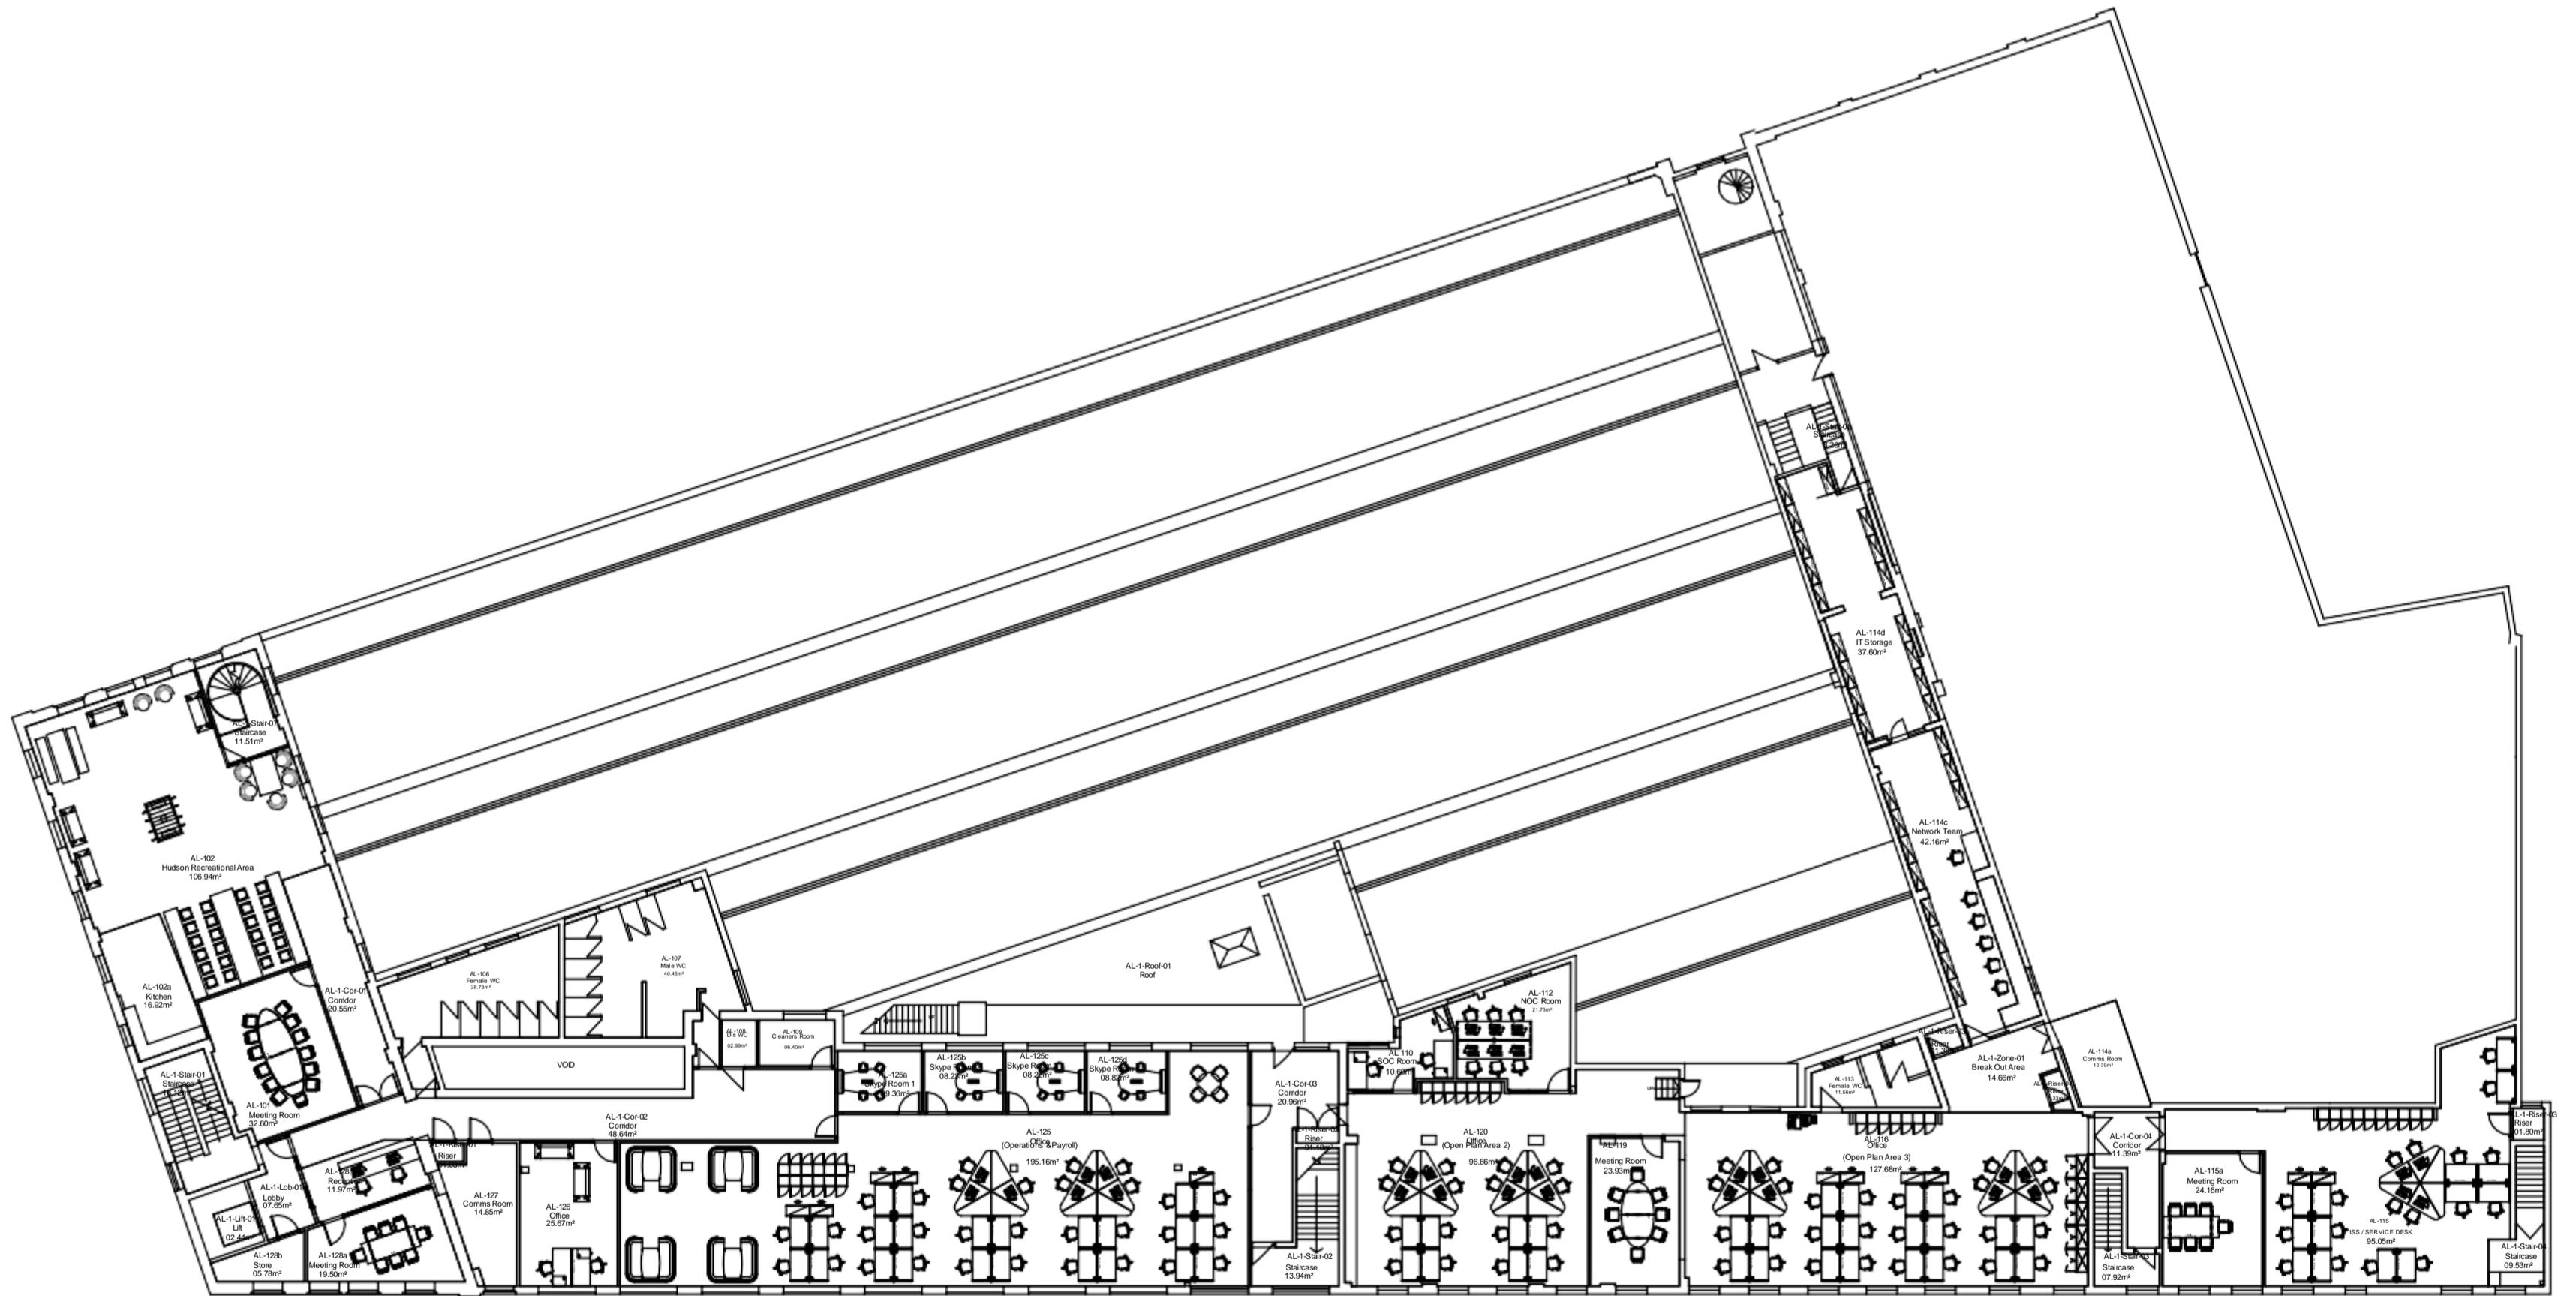

ALMA - FIRST FLOOR PLAN

06/03/2025	Furniture layout updated	KA
21/09/2023	NIA added	SG
22/08/2023	GEA added	SG
14/02/2023	Mezzanine spaces removed on 1st Floor	SG
30/10/2020	The Floor plan updated	
14/04/2020	The drawing spaces are NOT up to date	



 Coventry
University

Estates Department
Priory Street, Coventry
CV1 5FB
Tel: 024 76887688
Fax: 024 76887336

CURRENT STATUS		RECORD DRAWING	
PROJECT		ALMA BUILDING	
TITLE			
FIRST FLOOR PLAN			
RAWN EM	CHKD CHKD	DATE	14/04/2020
CALE 1/200 @ A1	DRAWING No. AL001-COV-00-01-M2-A	REV.	E



NOTES	
This Drawing Is The Copyright Of Coventry University Estates Department & Must Not Be Reproduced Without Their Permission. Figured Dimensions Must Be Taken In Preference To Scaled Dimensions & All Dimensions Must Be Verified On Site Prior To Commencing Any Works.	
AREAS	
GEA (Gross External Area)	854.45m ²
GIA (Gross Internal Area)	450.30m ²
NIA (Net Internal Area)	409.76m ²



D	22/08/2023	GEA, NIA added	SG
C	14/02/2023	Space numbering change 210a & 210b	SG
B	28/04/2022	Changes to floor layout and spaces	
A	30/10/2020	The floor plan updated	

Rev. Date Amendment Drawn



Coventry
University

Estate Department
Priory Street, Coventry
CV1 5FB
Tel: 024 76887688
Fax: 024 76887336

CURRENT STATUS
RECORD DRAWING

PROJECT
ALMA BUILDING


TITLE
SECOND FLOOR PLAN

DRAWN EM CHKD DATE 25/09/2018

SCALE 1/100 @ A2 DRAWING No. AL001-COV-00-02-M2-A REV. D

NOTES

This Drawing Is The Copyright Of Coventry University Estates Department & Must Not Be Reproduced Without Their Permission. Figured Dimensions Must Be Taken In Preference To Scaled Dimensions & All Dimensions Must Be Verified On Site Prior To Commencing Any Works.

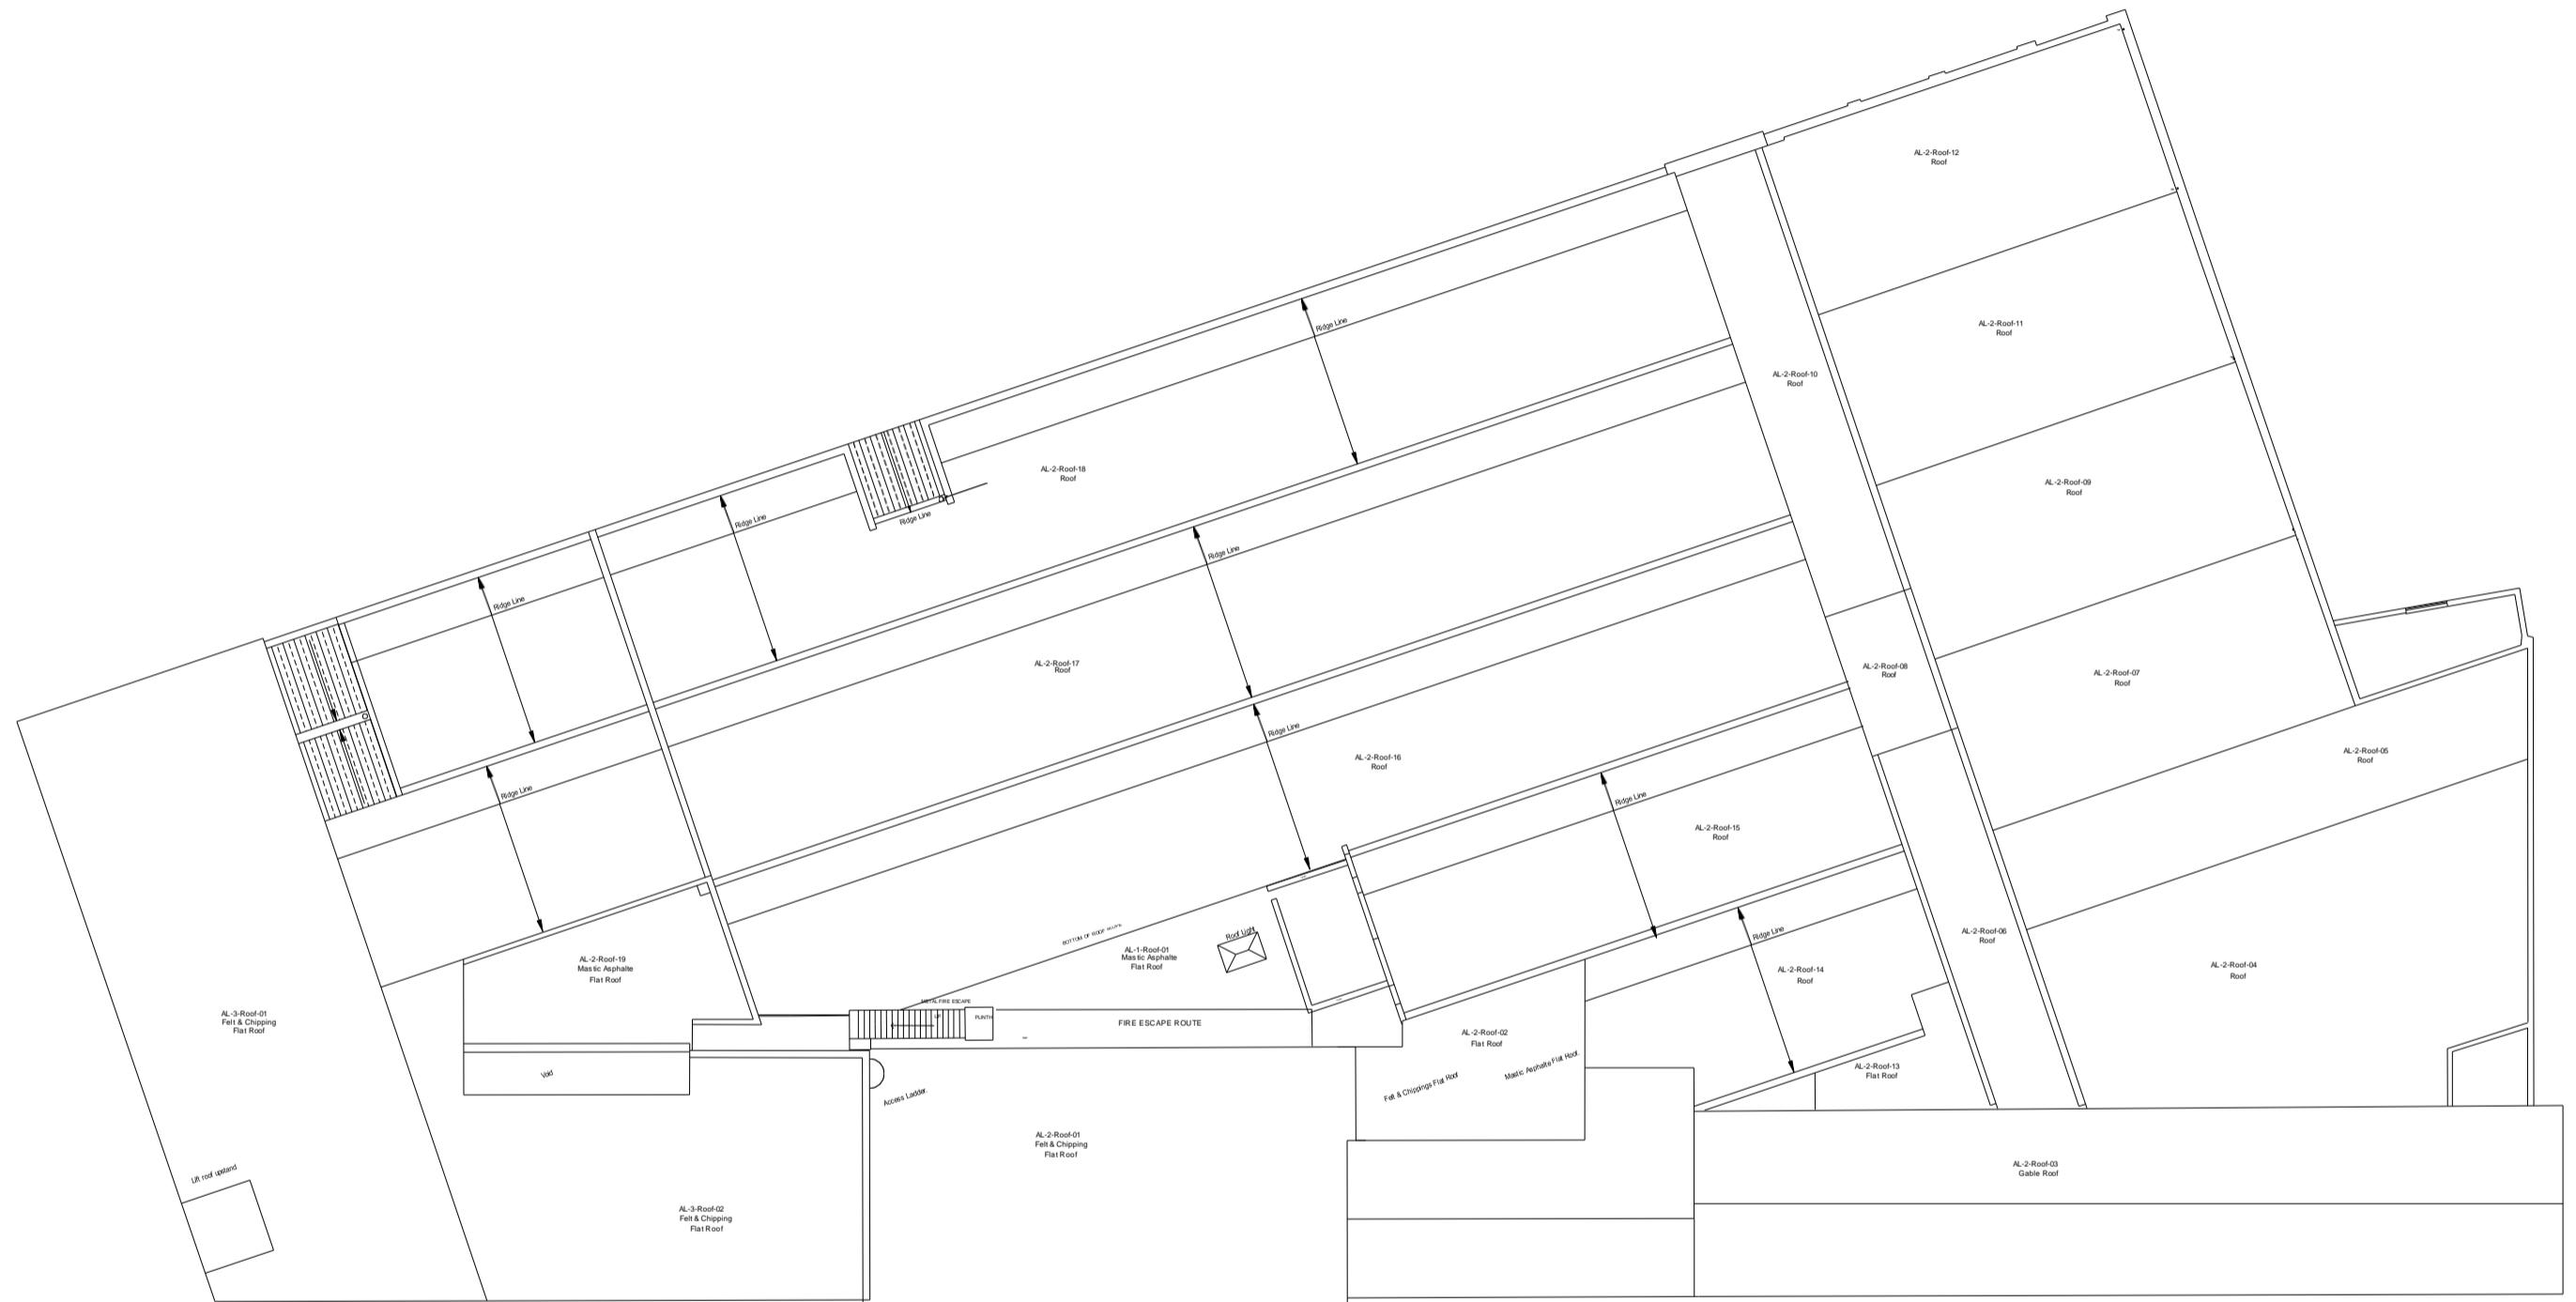

ALMA - ROOF PLAN

Rev. Date Amendment



Coventry
University

Estates Department
Priory Street, Coventry
CV1 5FB
Tel: 024 76887688
Fax: 024 76887336

CURRENT STATUS
RECORD DRAWING

PROJECT
ALMA BUILDING

TITLE
ROOF PLAN

DRAWN	EM	CHKD	DATE
-------	----	------	------

11/12/2020

SCALE	1200 @ A2	DRAWING No.	AL001-COV-00-R-M2-A	REV.
-------	-----------	-------------	---------------------	------

X