

This Drawing Is The Copyright Of Coventry University Estates Department & Must Not Be Reproduced Without Their Permission. Figured Dimensions Must Be Taken In Preference To Scaled Dimensions & All Dimensions Must Be Verified On Site Prior To Commencing Any Works.

GEA (Gross External Area)	1637.88 m ²
GIA (Gross Internal Area)	1554.16 m ²
NIA (Net Internal Area)	956.48 m ²



B	28/02/24	Furniture layout added & AS-G20, AS-G22 Space outline updated & AS-G28A Added	SG
A	13/09/21	Site Detail & Staircase 4 added. Spaces amended	
Rev.	Date	Amendment	Author



CURRENT STATUS

PROJECT
ARMSTRONG SIDDELEY

DRAWN PSC	CHKD EM	DATE 13/07/2018
--------------	------------	--------------------


SCALE	DRAWING No.	REV.
N.T.S	AS001-COV-00-GF-M2-A	B

NOTES

This Drawing Is The Copyright Of Coventry University
Estates Department & Must Not Be Reproduced
Without Their Permission. Figured Dimensions Must Be
Taken In Preference To Scaled Dimensions & All
Dimensions Must Be Verified On Site Prior To
Commencing Any Works.

AREAS

GEA (Gross External Area)	1663.06 m ²
GIA (Gross Internal Area)	1574.68 m ²
NIA (Net Internal Area)	1127.97 m ²

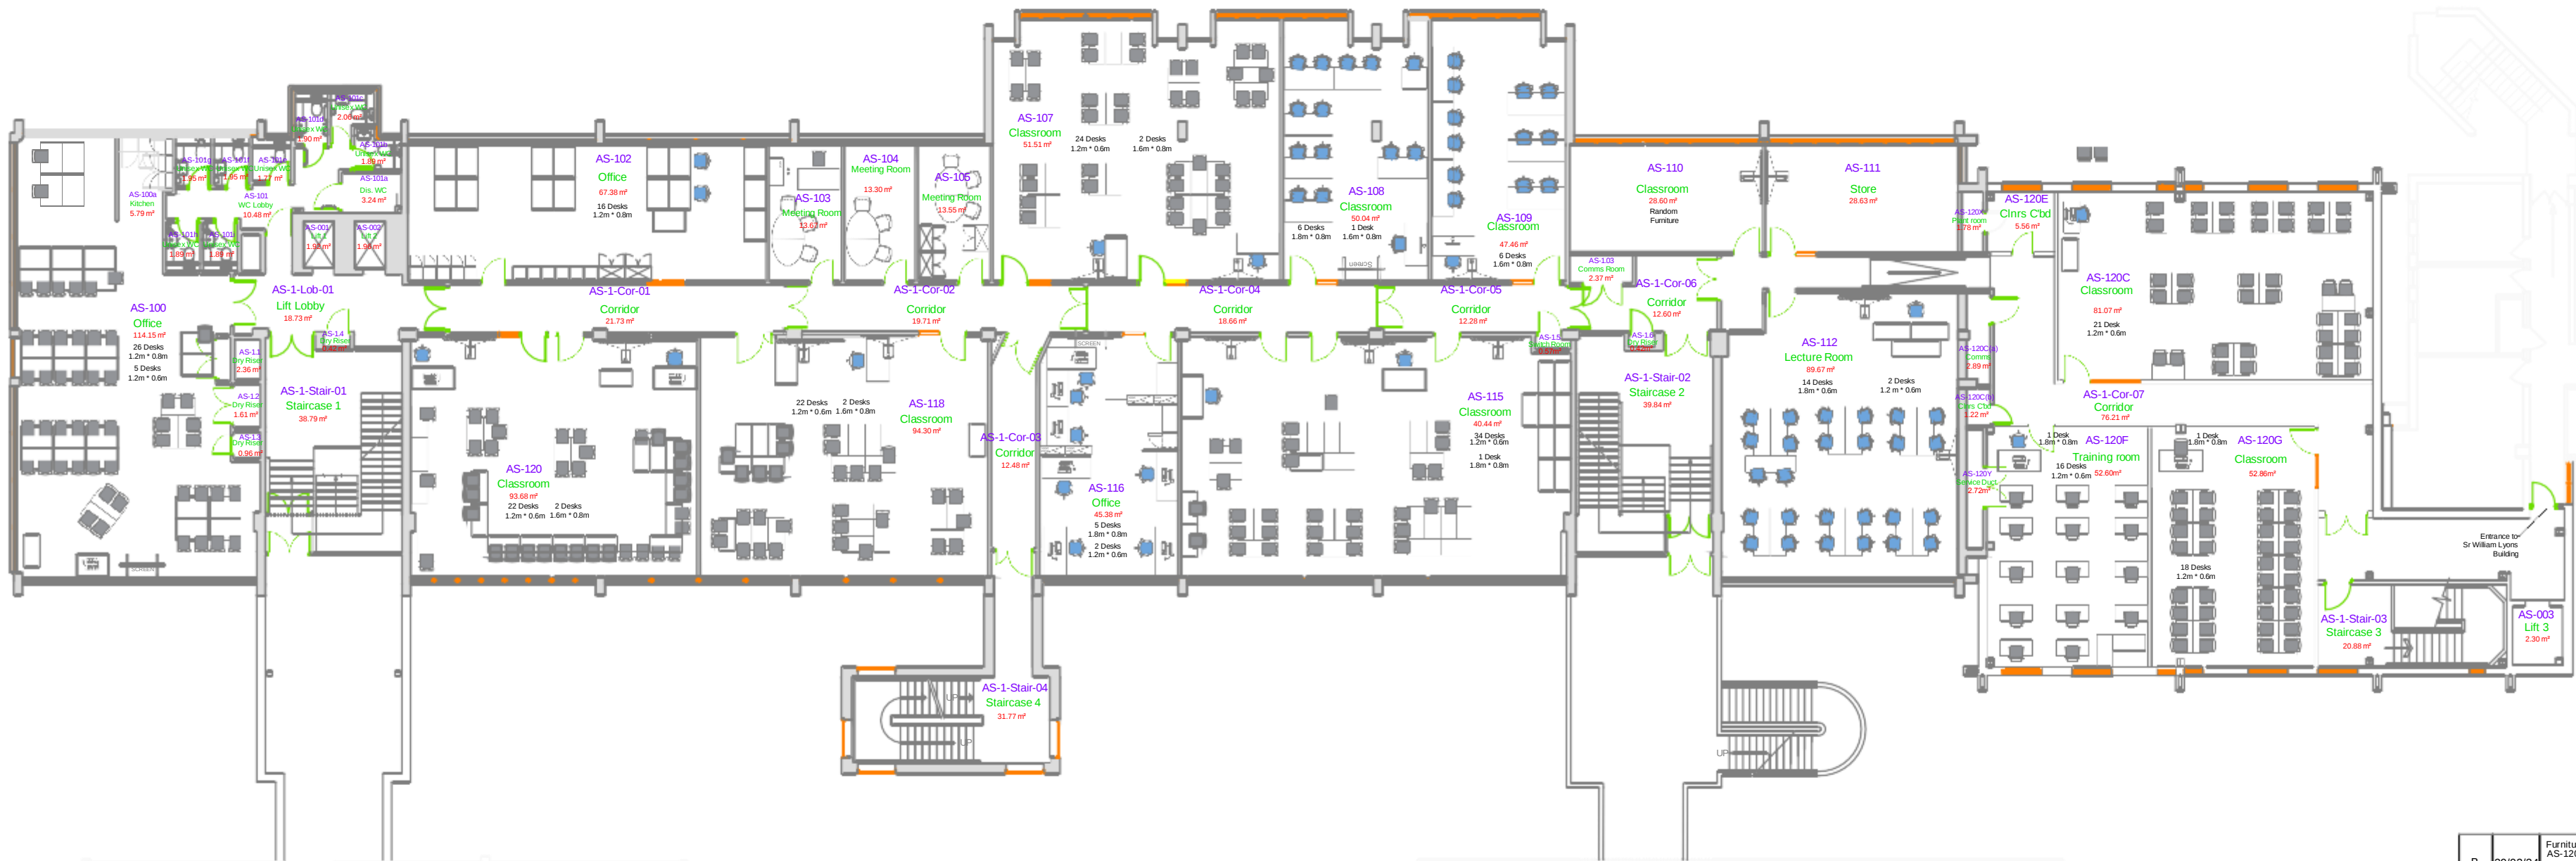

First Floor Plan



B	29/02/24	Furniture Layout added/Updated - AS-120G, AS-120F Area updated -119, 120 merged - 117, 118 merged 113, 114, 115 merged.	SG
A	13/09/21	Staircase 4 added. Spaces amended	
Rev.	Date	Amendment	Author




Estates Department
Priory Street, Coventry
CV1 5FB
Tel: 024 76887688
Fax: 024 76887336

CURRENT STATUS		
RECORD DRAWING		
PROJECT		
ARMSTRONG SIDDELEY		
TITLE		
FIRST FLOOR PLAN		
DRAWN	CHD EM	DATE 06/09/2021
SCALE	DRAWING No. AS001-COV-00-01-M2-A	REV. B

This Drawing Is The Copyright Of Coventry University
Estates Department & Must Not Be Reproduced
Without Their Permission. Figured Dimensions Must Be
Taken In Preference To Scaled Dimensions & All
Dimensions Must Be Verified On Site Prior To
Commencing Any Works.

GEA (Gross External Area)	1577.71 m ²
GIA (Gross Internal Area)	1495.84 m ²
NIA (Net Internal Area)	1100.36 m ²

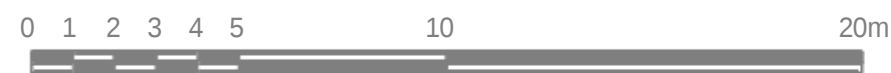

C	12/09/24	225C and 225E merged to from a new lecture theatre (225C). Furniture layout updated for 212, 213, 234 and 237	SG
B	22/02/24	Furniture layout added & AS-237, AS-234 Space outline updated & AS-200A, AS-200B, AS-211A Added & Windows added	SG
Rev.	Date	Amendment	Author



CURRENT STATUS

PROJECT

ARMSTRONG SIDDELEY

DRAWN PSC	CHKD EM	DATE 06/09/2021
--------------	------------	--------------------


SCALE	DRAWING No.	REV.
N.T.S	AS001-COV-00-02-M2-A	C

NOTES

This Drawing Is The Copyright Of Coventry University
Estates Department & Must Not Be Reproduced
Without Their Permission. Figured Dimensions Must Be
Taken In Preference To Scaled Dimensions & All
Dimensions Must Be Verified On Site Prior To
Commencing Any Works.

AREAS

GEA (Gross External Area)	1565.15 m ²
GIA (Gross Internal Area)	1482.12 m ²
NIA (Net Internal Area)	977.14 m ²

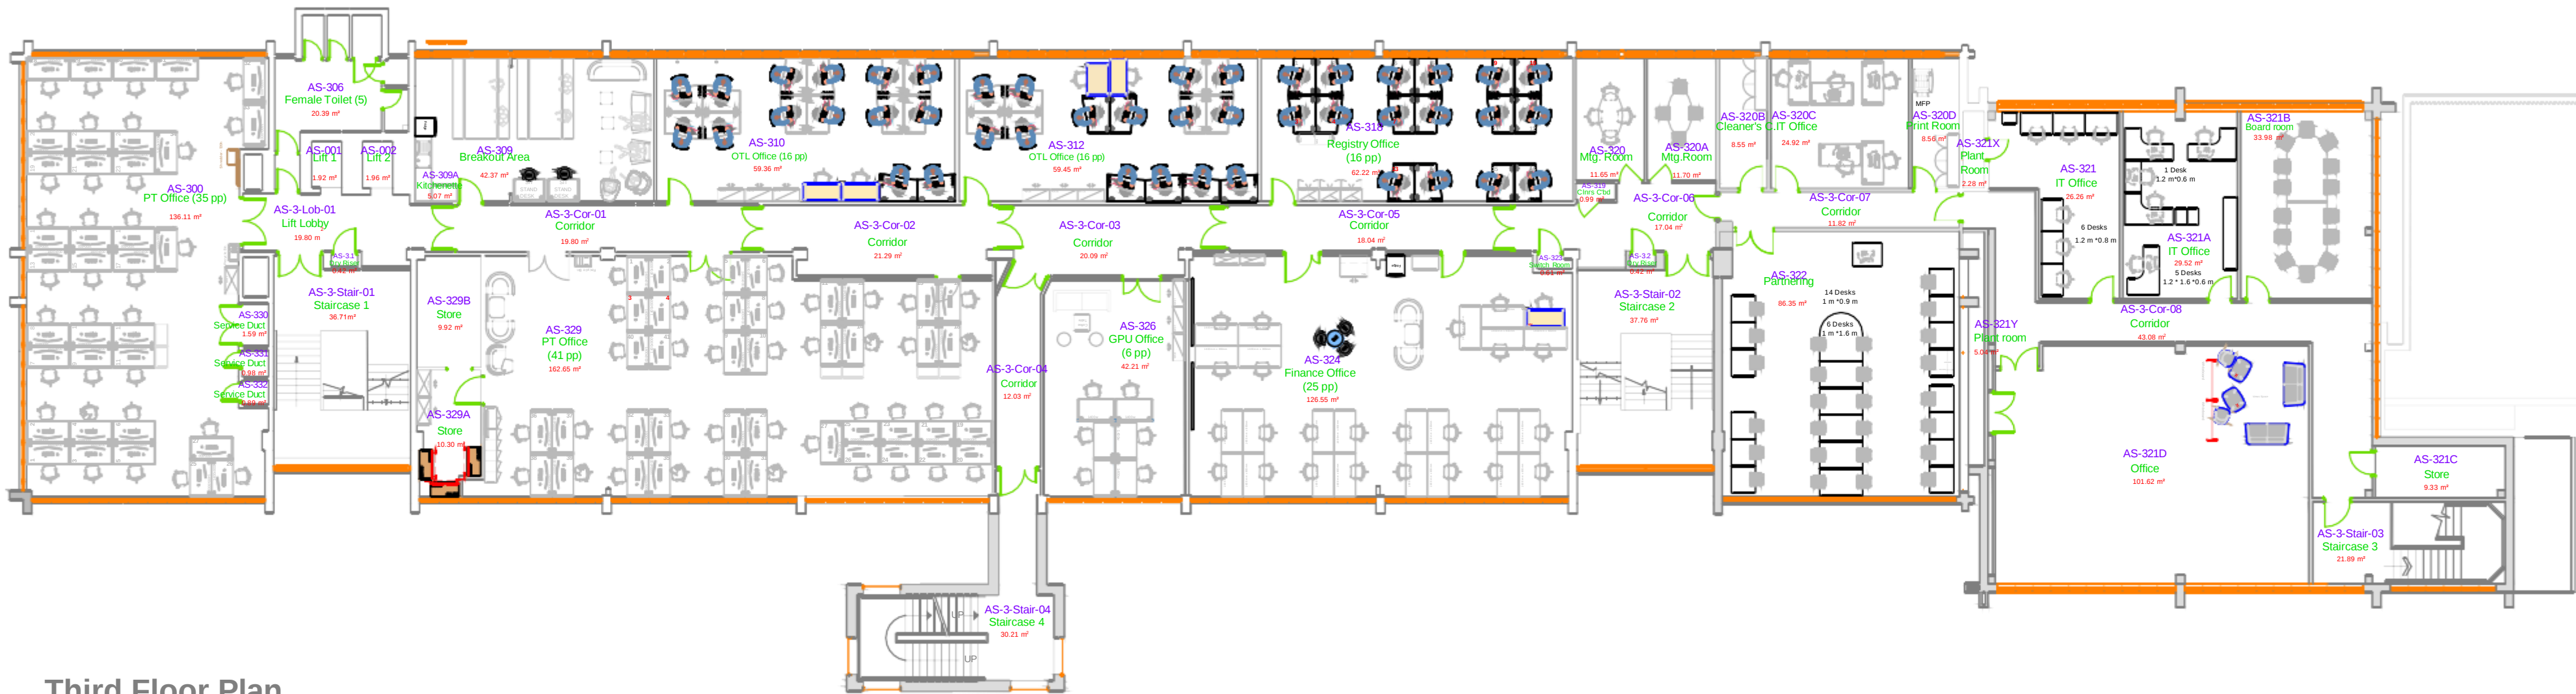

Third Floor Plan



C	05/07/24	Space descriptions, furniture layout, windows updated	SG
B	28/02/24	Furniture layout added & AS-G309A Added	SC
A	13/09/21	Staircase 4 added. Spaces Amended	
Rev.	Date	Amendment	Author



Estates Department
Priory Street, Coventry
CV1 5FB
Tel: 024 76887688
Fax: 024 76887336

CURRENT STATUS

RECORD DRAWING

PROJECT

ARMSTRONG SIDDELEY

TITLE

THIRD FLOOR PLAN

DRAWN	PSC	CHKD EM	DATE	06/09/2021
SCALE	N.T.S.	DRAWING No.	AS001-COV-00-03-M2-A	REV. C

NOTES


This Drawing is The Copyright Of Coventry University Estates Department & Must Not Be Reproduced Without Their Permission. Figured Dimensions Must Be Taken In Preference To Scaled Dimensions & All Dimensions Must Be Verified On Site Prior To Commencing Any Works.

AREAS

GEA (Gross External Area)	1664.82m ²
GIA (Gross Internal Area)	1559.48m ²
NIA (Net Internal Area)	1170.07m ²



Fourth Floor Plan

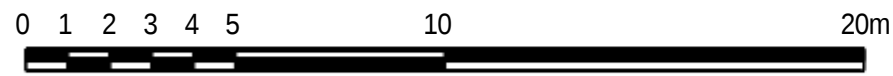

D	05/07/24	Space descriptions, furniture layout, windows updated	SG
C	28/02/24	Furniture layout added & AS-G309A Added	SG
B	13/09/21	Staircase 4 added. Spaces Amended	
A	13/09/21	Staircase 4 added. Spaces Amended	
Rev.	Date	Amendment	Author

Estates Department
Priority Street, Coventry
CV1 5FB
Tel: 024 76887688
Fax: 024 76887336

CURRENT STATUS		
RECORD DRAWING		
PROJECT		
ARMSTRONG SIDDELEY		
TITLE		
FOURTH FLOOR PLAN		
DRAWN	KA	CHKD EM
SCALE	N.T.S.	DATE 06/09/2021
DRAWING No.	AS001-COV-00-04-M2-A	REV. D



Roof Plan



NOTES

This Drawing is The Copyright Of Coventry University
Estates Department & Must Not Be Reproduced
Without Their Permission. Figured Dimensions Must Be
Taken in Preference To Scaled Dimensions & All
Dimensions Must Be Verified On Site Prior To
Commencing Any Works.



A	13/09/21	Staircase 4 added. Spaces Amended
Rev.	Date	Amendment
 Estates Department Priory Street, Coventry CV1 5PB Tel: 024 76887688 Fax: 024 76887336		
CURRENT STATUS		
RECORD DRAWING		
PROJECT		
ARMSTRONG SIDDELEY		
TITLE		
ROOF PLAN		
DRAWN	CHKD	DATE
PSC	EM	18/04/2013
SCALE	DRAWING No.	REV.
N.T.S.	AS001-COV-00-05-M2-A	A