




NOTES		
This Drawing Is The Copyright Of Coventry University Estates Department & Must Not Be Reproduced Without Their Permission. Figured Dimensions Must Be Taken In Preference To Scaled Dimensions & All Dimensions Must Be Verified On Site Prior To Commencing Any Works.		
AREAS		
GIA (Gross Internal Area)	#####	
		
* Rev.	* Date	* Amendment
		
Estates Department Priory Street, Coventry CV1 5FB Tel: 024 76887688 Fax: 024 76887336		
CURRENT STATUS		
RECORD DRAWING		
PROJECT		
BEATRICE SHILLING BUILDING		
TITLE		
FIRST FLOOR PLAN		
DRAWN EM/KA	CHKD	DATE 17/02/2020
SCALE 1/100 @ A1	DRAWING No. ECB2001-COV-00-01-M2-A	
		REV. 0000


This Drawing Is The Copyright Of Coventry University
Estates Department & Must Not Be Reproduced
Without Their Permission. Figured Dimensions Must Be
Taken In Preference To Scaled Dimensions & All
Dimensions Must Be Verified On Site Prior To
Commencing Any Works.

GIA (Gross Internal Area)	1668.05 m ²
---------------------------	------------------------

GIA (Gross Internal Area)	1668.05 m ²
---------------------------	------------------------

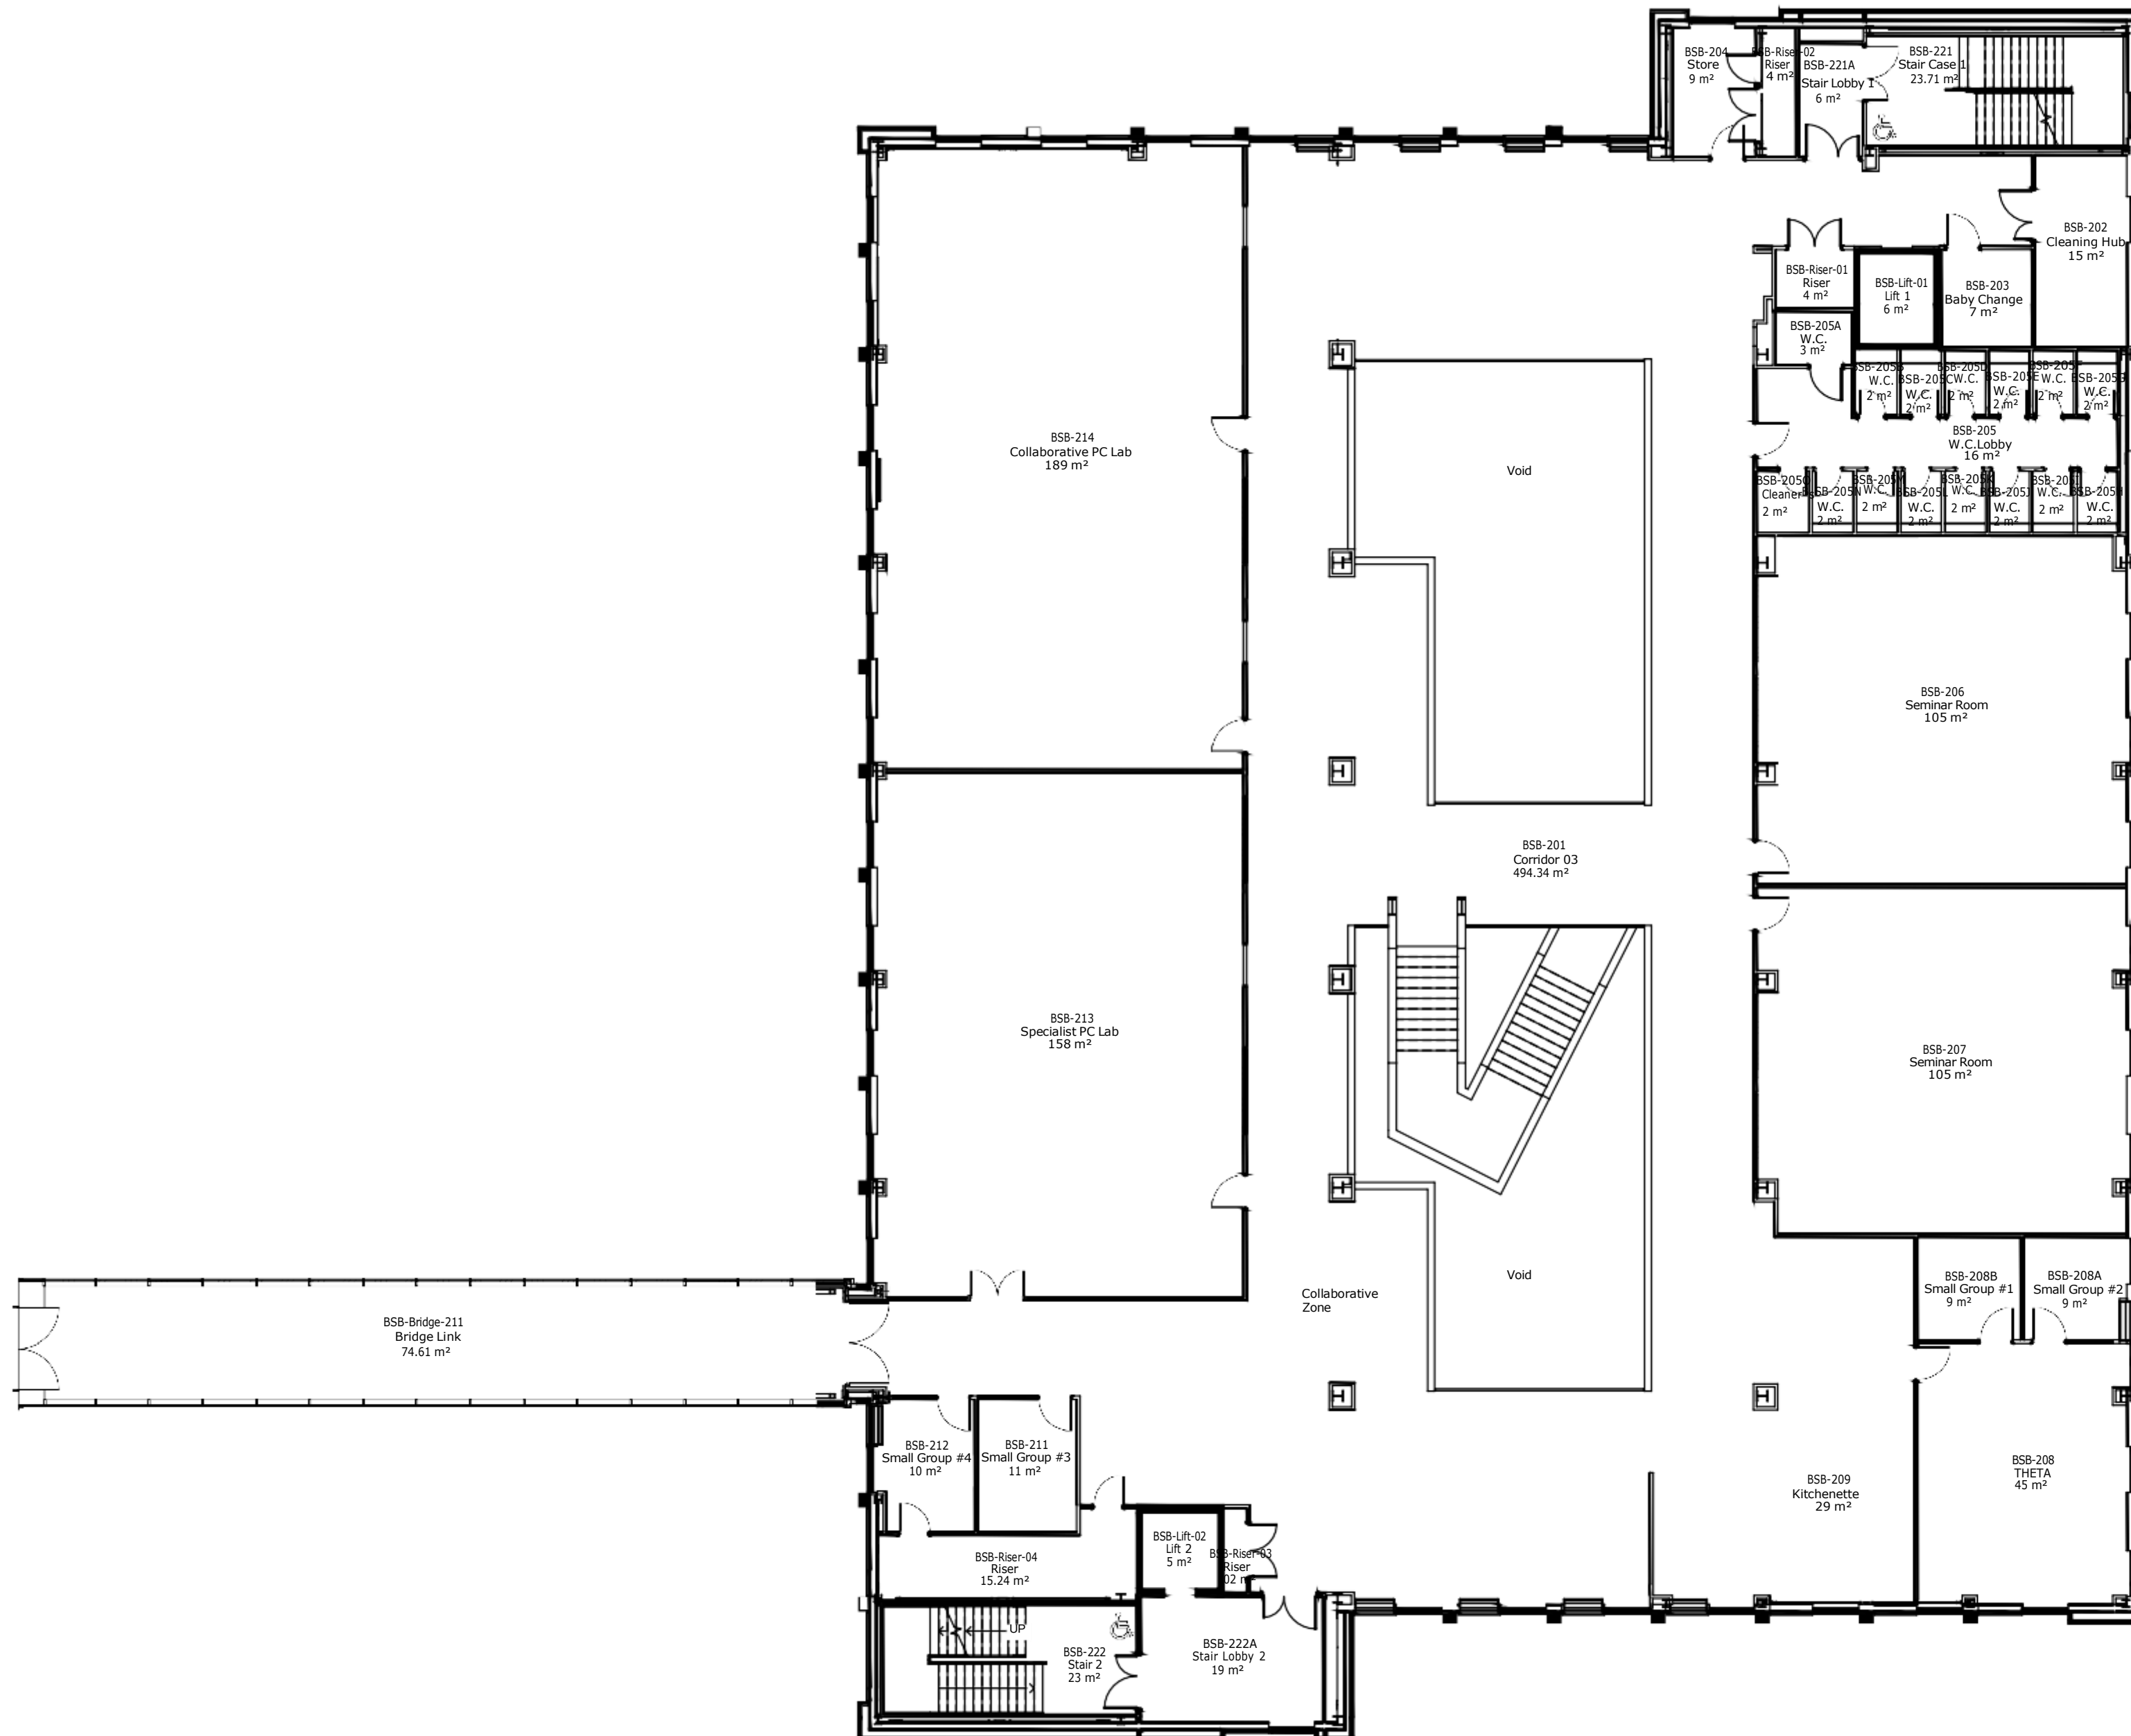

Second Floor Plan

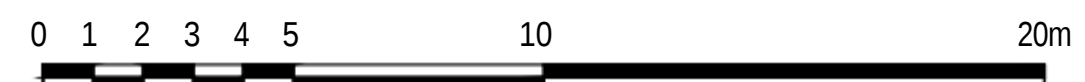

CURRENT STATUS


PROJECT
BEATRICE SHILLING BUILDING (ECB2)

PROJECT
BEATRICE SHILLING BUILDING (ECB2)


TITLE	AS BUILT SECOND FLOOR PLAN
-------	----------------------------

DRAWN	CHKD	DATE
EM	CHKD	13/02/2020

SCALE 1/100 @ A1	DRAWING No. BS001-COV-00-02-M2-A	REV. 0000
---------------------	-------------------------------------	--------------

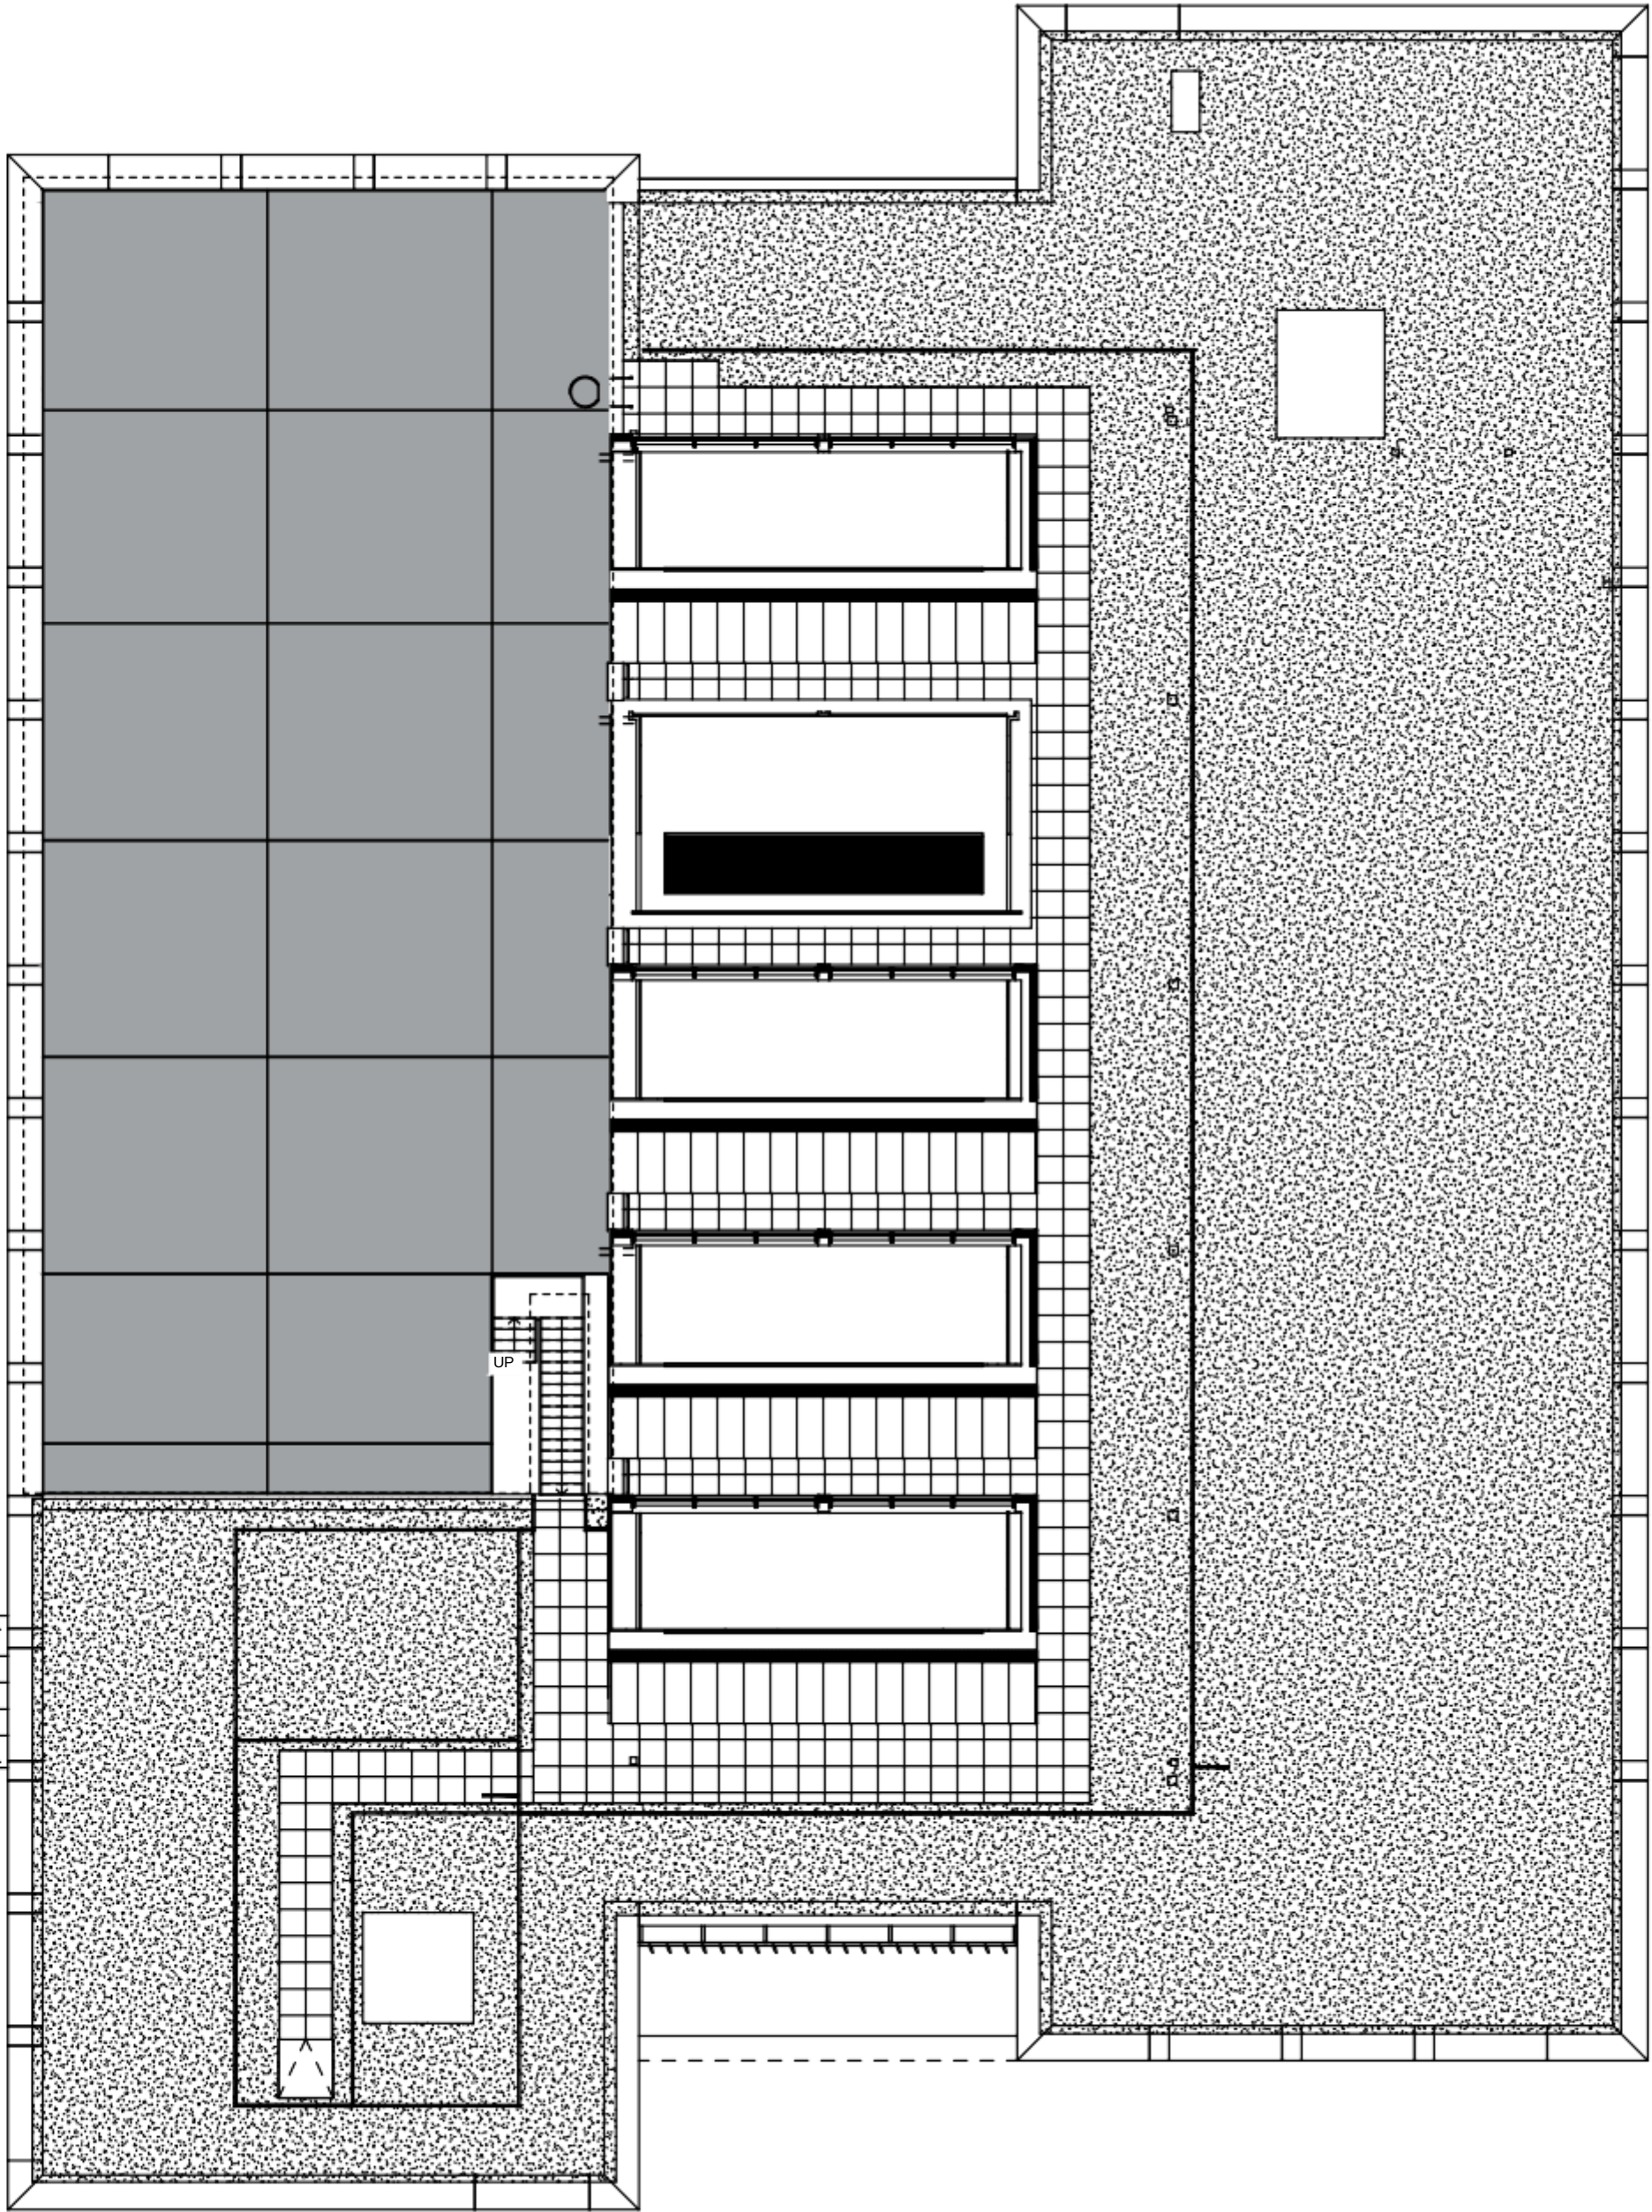

Roof Plan

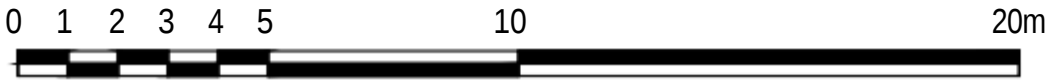

NOTES

This Drawing Is The Copyright Of Coventry University
Estates Department & Must Not Be Reproduced
Without Their Permission. Figured Dimensions Must Be
Taken In Preference To Scaled Dimensions & All
Dimensions Must Be Verified On Site Prior To
Commencing Any Works.

AREAS

GIA (Gross Internal Area) #####



Rev.	Date	Amendment
------	------	-----------



Estates Department
Priority Street, Coventry
CV1 5FB
Tel: 024 76887688
Fax: 024 76887336

CURRENT STATUS

RECORD DRAWING

PROJECT

BEATRICE SHILLING BUILDING (ECB2)

TITLE

AS BUILT ROOF PLAN

DRAWN	EM	CHKD	CHKD	DATE	13/02/2020
-------	----	------	------	------	------------

SCALE	1/100 @ A1	DRAWING No.	BS001-COV-00-R-M2-A	REV.	0000
-------	------------	-------------	---------------------	------	------