

NOTES


This Drawing Is The Copyright Of Coventry University Estates Department & Must Not Be Reproduced Without Their Permission. Figured Dimensions Must Be Taken In Preference To Scaled Dimensions & All Dimensions Must Be Verified On Site Prior To Commencing Any Works.




CW - First Floor Plan

GIA (gross Internal Area)	1805.78 m ²
GEA (gross External Area)	000.00 m ²


Upper FF Level

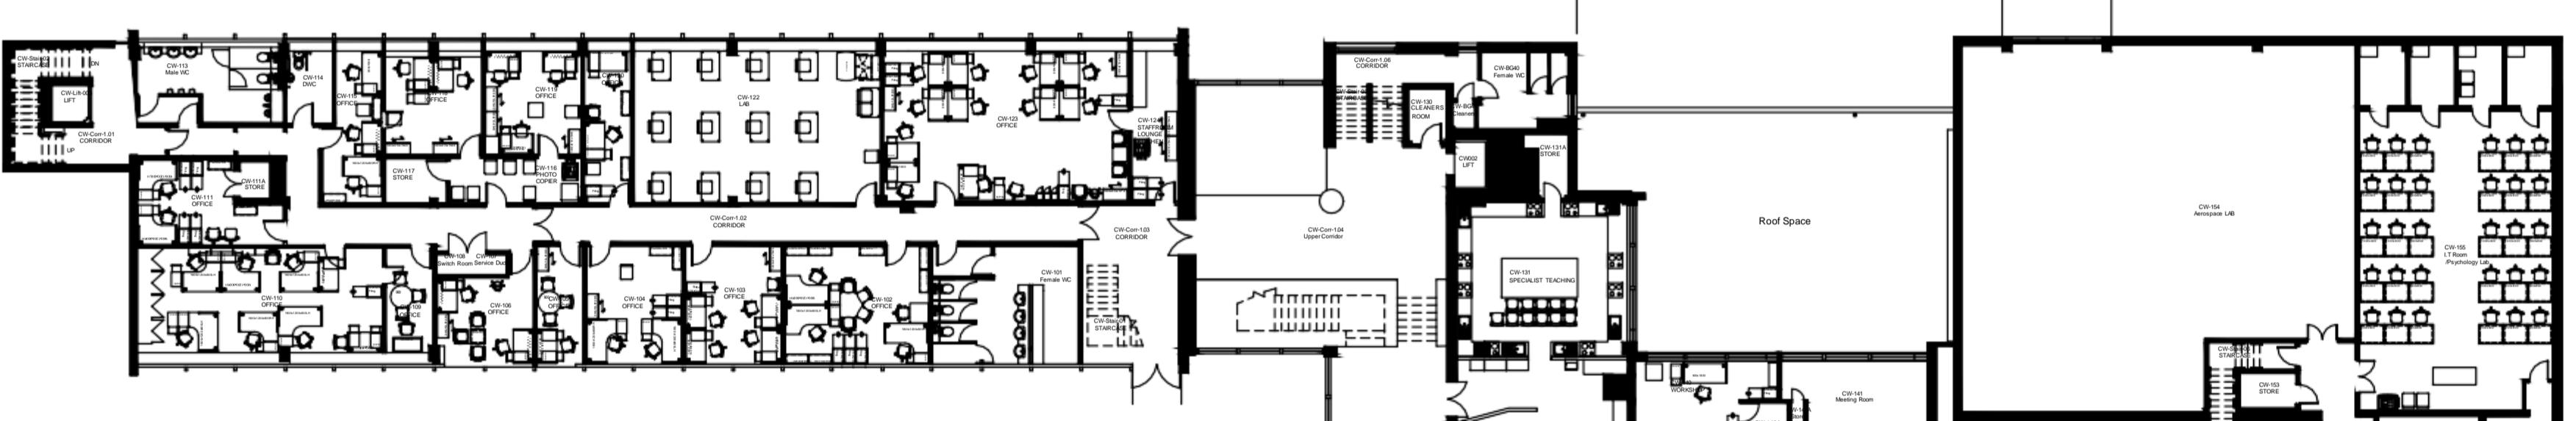

First Floor Plan

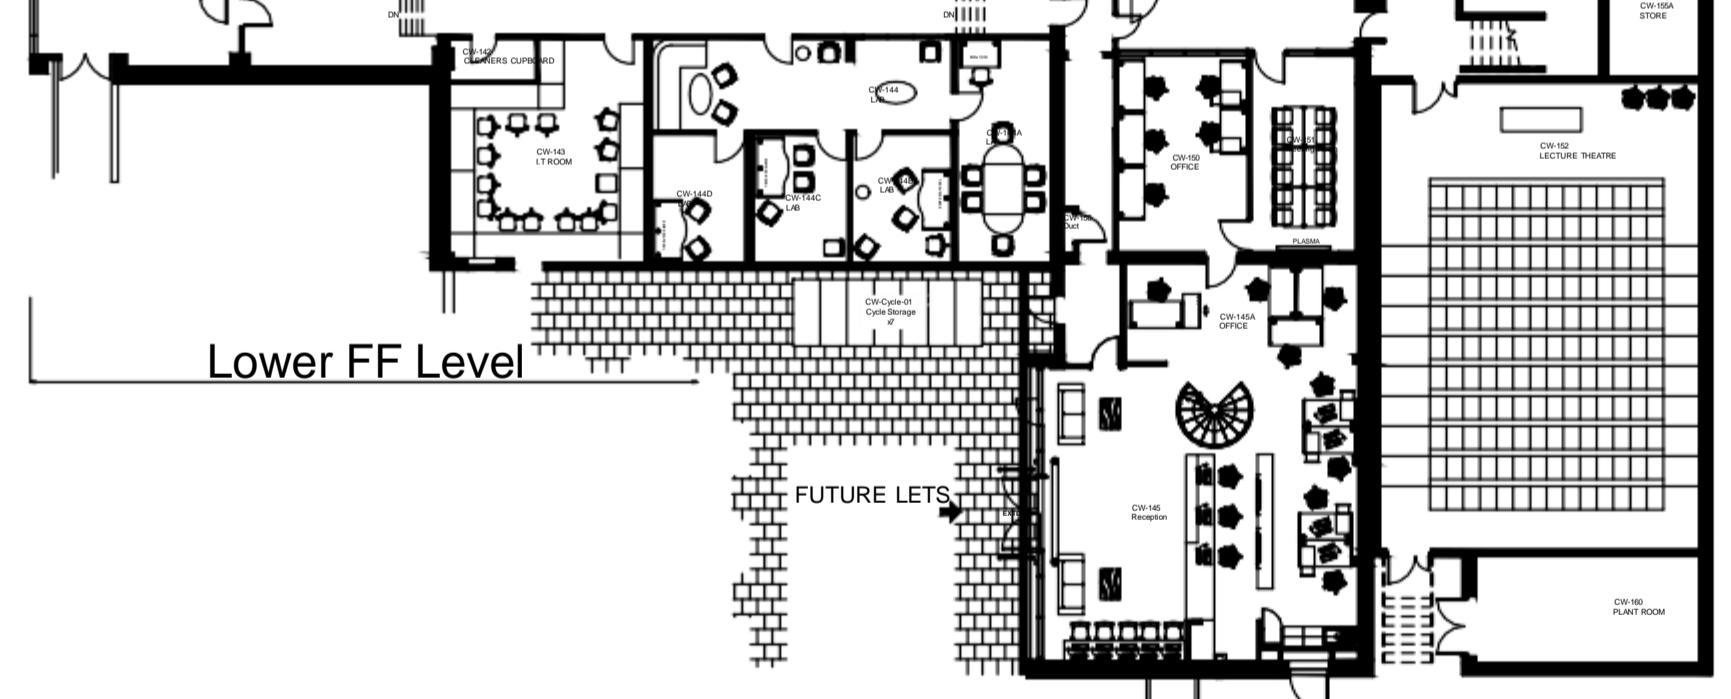

Lower FF Level

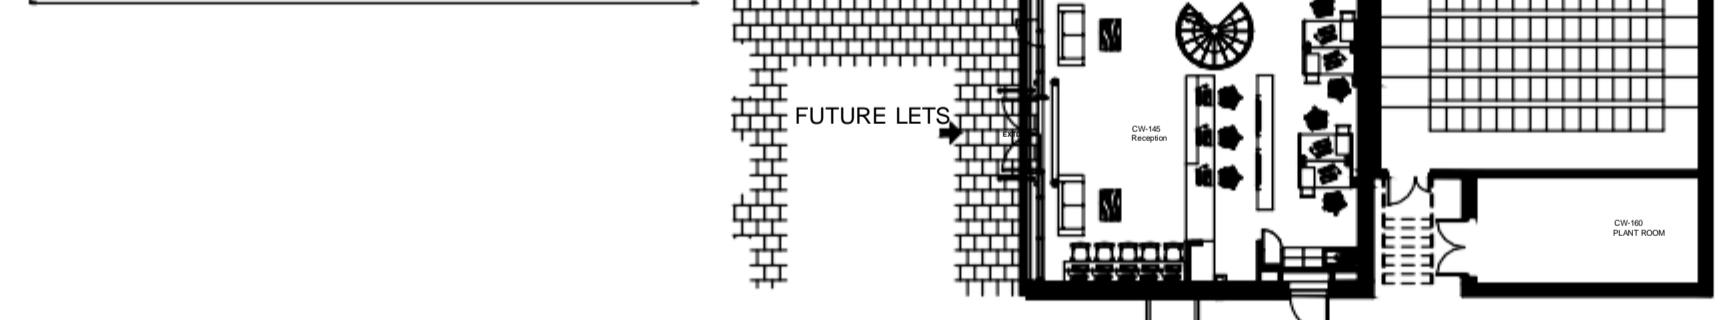

0 0.5 1 2.5 5 10m

A 03/09/2021 Drawing amended to match as built floor plan

Rev. Date Amendment



Coventry
University

Estates Department
Philly Street, Coventry
CV1 5FB
Tel: 024 76887688
Fax: 024 76887336

CURRENT STATUS

RECORD DRAWING

PROJECT

CHARLES WARD BUILDING

TITLE

AS BUILT FIRST FLOOR PLAN

DRAWN EM CHKD DATE 20/11/2018

SCALE 1/150 @ A1 DRAWING No. CW001-COV-00-01-M2-A REV. A

NOTES

This Drawing Is The Copyright Of Coventry University Estates Department & Must Not Be Reproduced Without Their Permission. Figured Dimensions Must Be Taken In Preference To Scaled Dimensions & All Dimensions Must Be Verified On Site Prior To Commencing Any Works.



CW - First Floor Mezz Plan

GIA (gross Internal Area)	178.14 m ²
------------------------------	-----------------------

GEA (gross External Area)	000.00 m ²
------------------------------	-----------------------

A 03/09/2021 Drawing amended to match as built floor plan
Rev. Date Amendment



Coventry
University

Estates Department
Priory Street, Coventry
CV1 5FB
Tel: 024 76887688
Fax: 024 76887336

CURRENT STATUS

RECORD DRAWING

PROJECT


CHARLES WARD BUILDING

TITLE

AS BUILT MEZZANINE FLOOR
PLAN

DRAWN EM	CHKD CHKD	DATE 20/11/2018
-------------	--------------	--------------------

SCALE 1/50 @ A1	DRAWING No. CW001-COV-00-MZ-M2-A	REV. A
--------------------	-------------------------------------	-----------

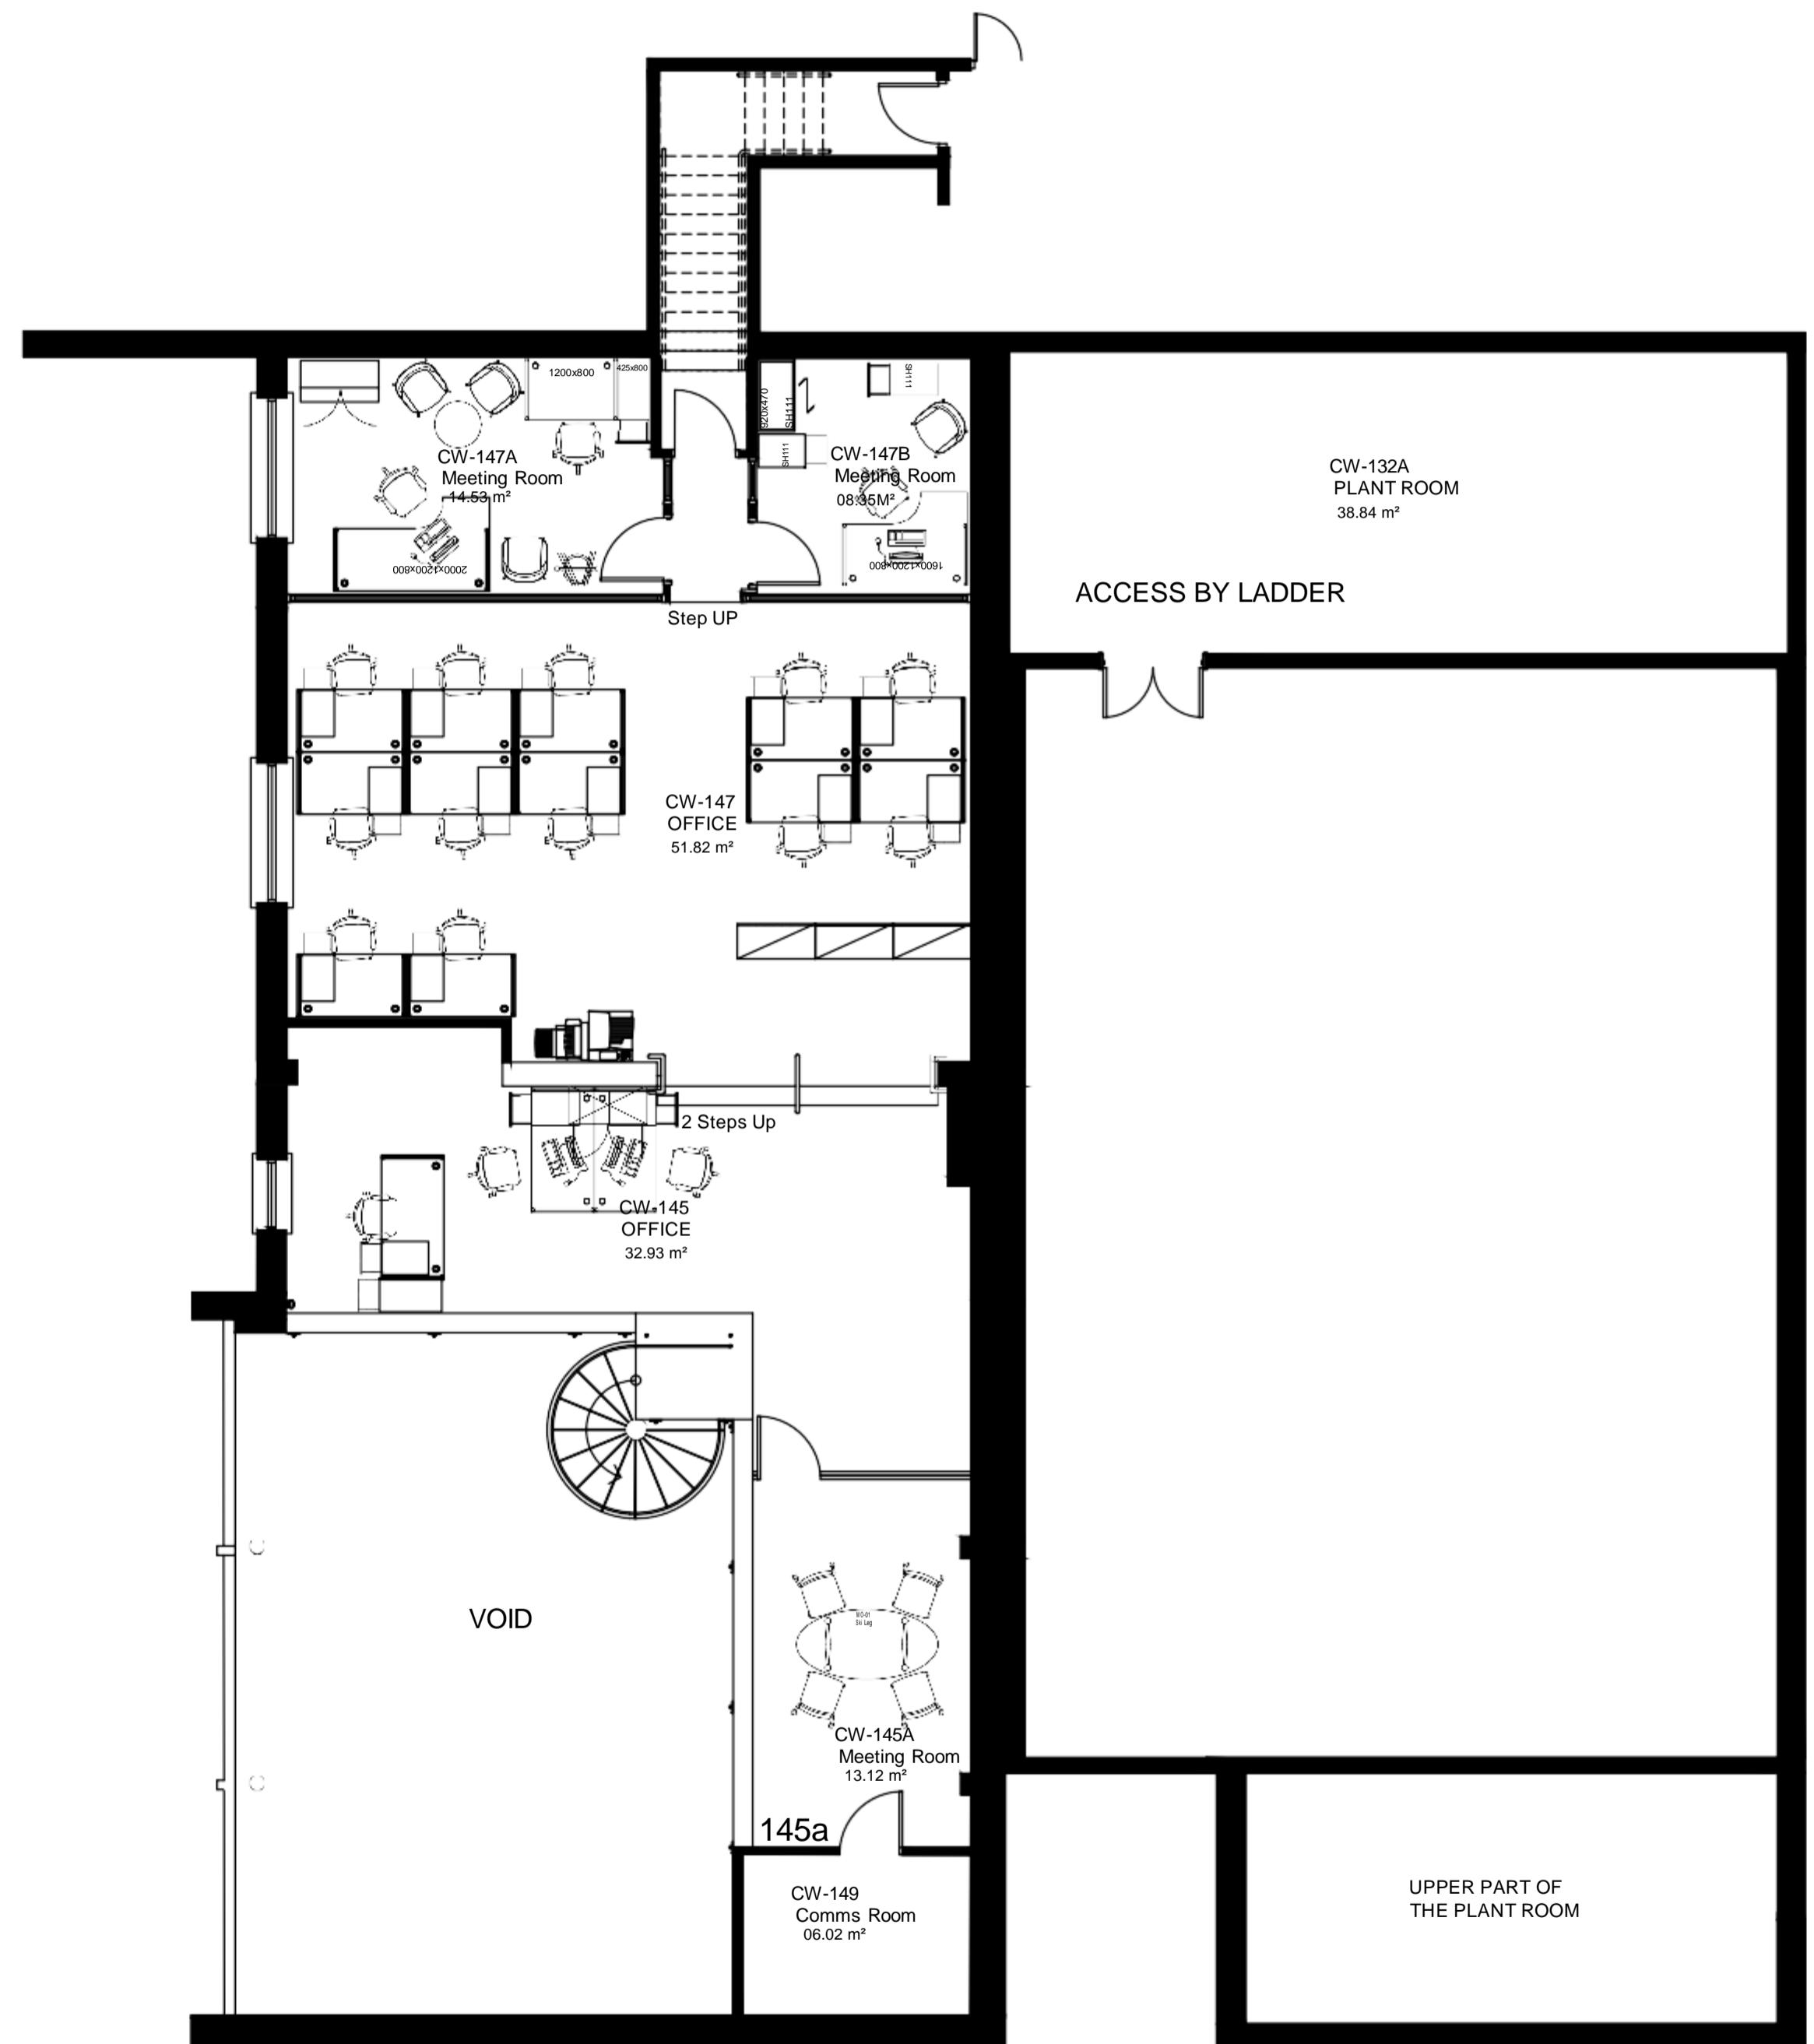

Future Lets Mezz

NOTES


This Drawing Is The Copyright Of Coventry University Estates Department & Must Not Be Reproduced Without Their Permission. Figured Dimensions Must Be Taken In Preference To Scaled Dimensions & All Dimensions Must Be Verified On Site Prior To Commencing Any Works.



CW - Second Floor Plan

GIA (gross Internal Area)	584.46 m ²
------------------------------	-----------------------

GEA (gross External Area)	000.00 m ²
------------------------------	-----------------------

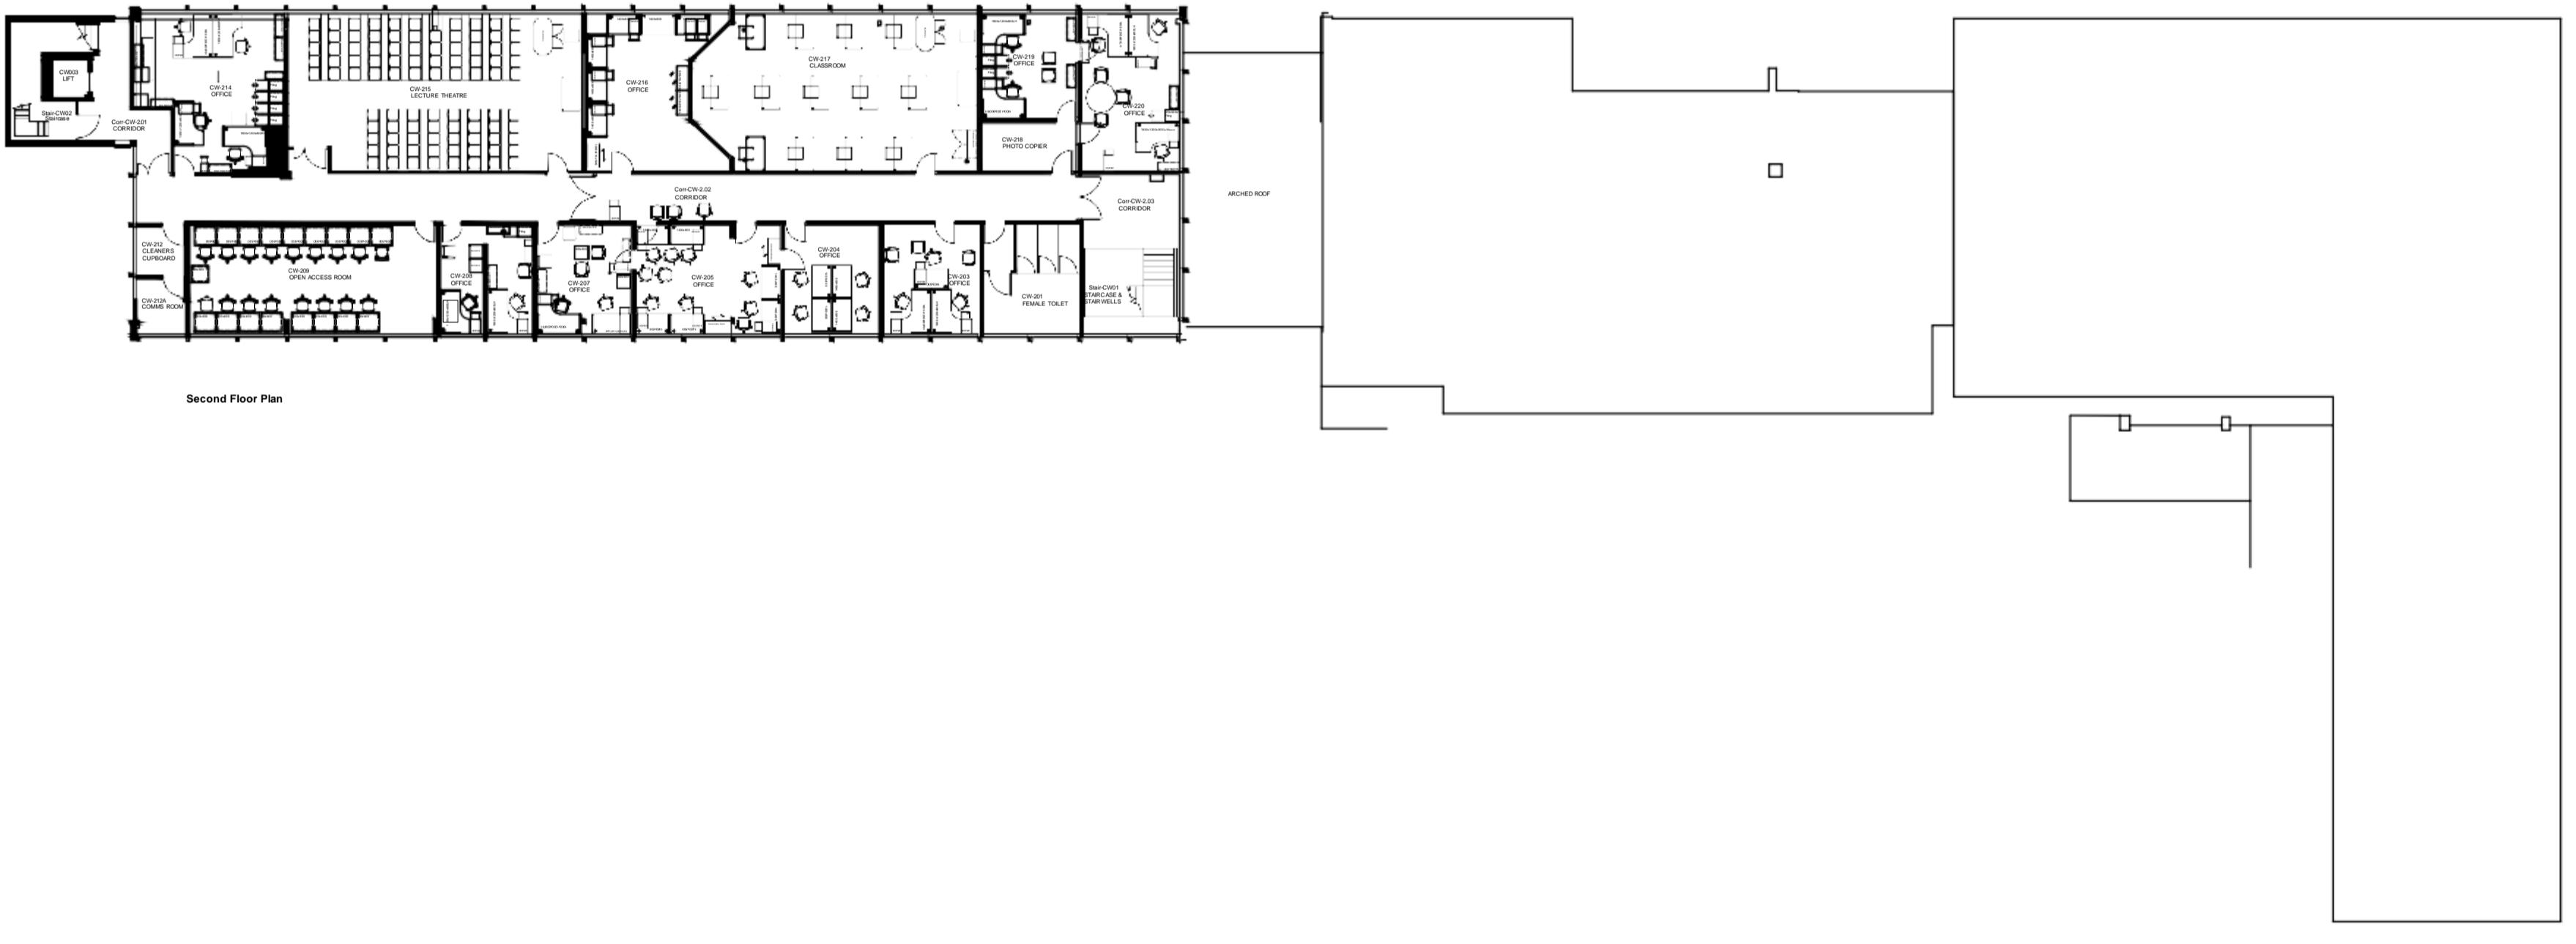

0 0.5 1 2.5 5 10m

A 03/09/2021 Drawing amended to match as built floor plan
Rev. Date Amendment



Estate Department
Philly Street, Coventry
CV1 5FB
Tel: 024 76887688
Fax: 024 76887336

CURRENT STATUS

RECORD DRAWING

PROJECT

CHARLES WARD BUILDING

TITLE

AS BUILT SECOND FLOOR PLAN

DRAWN EM	CHKD	DATE
----------	------	------

20/11/2018

SCALE 1/150 @ A1	DRAWING No. CW001-COV-00-02-M2-A	REV. A
------------------	----------------------------------	--------


NOTES

This Drawing Is The Copyright Of Coventry University Estates Department & Must Not Be Reproduced Without Their Permission. Figured Dimensions Must Be Taken In Preference To Scaled Dimensions & All Dimensions Must Be Verified On Site Prior To Commencing Any Works.



CW - Roof Plan

GIA (gross Internal Area)	22.79 m ²
GEA (gross External Area)	000.00 m ²

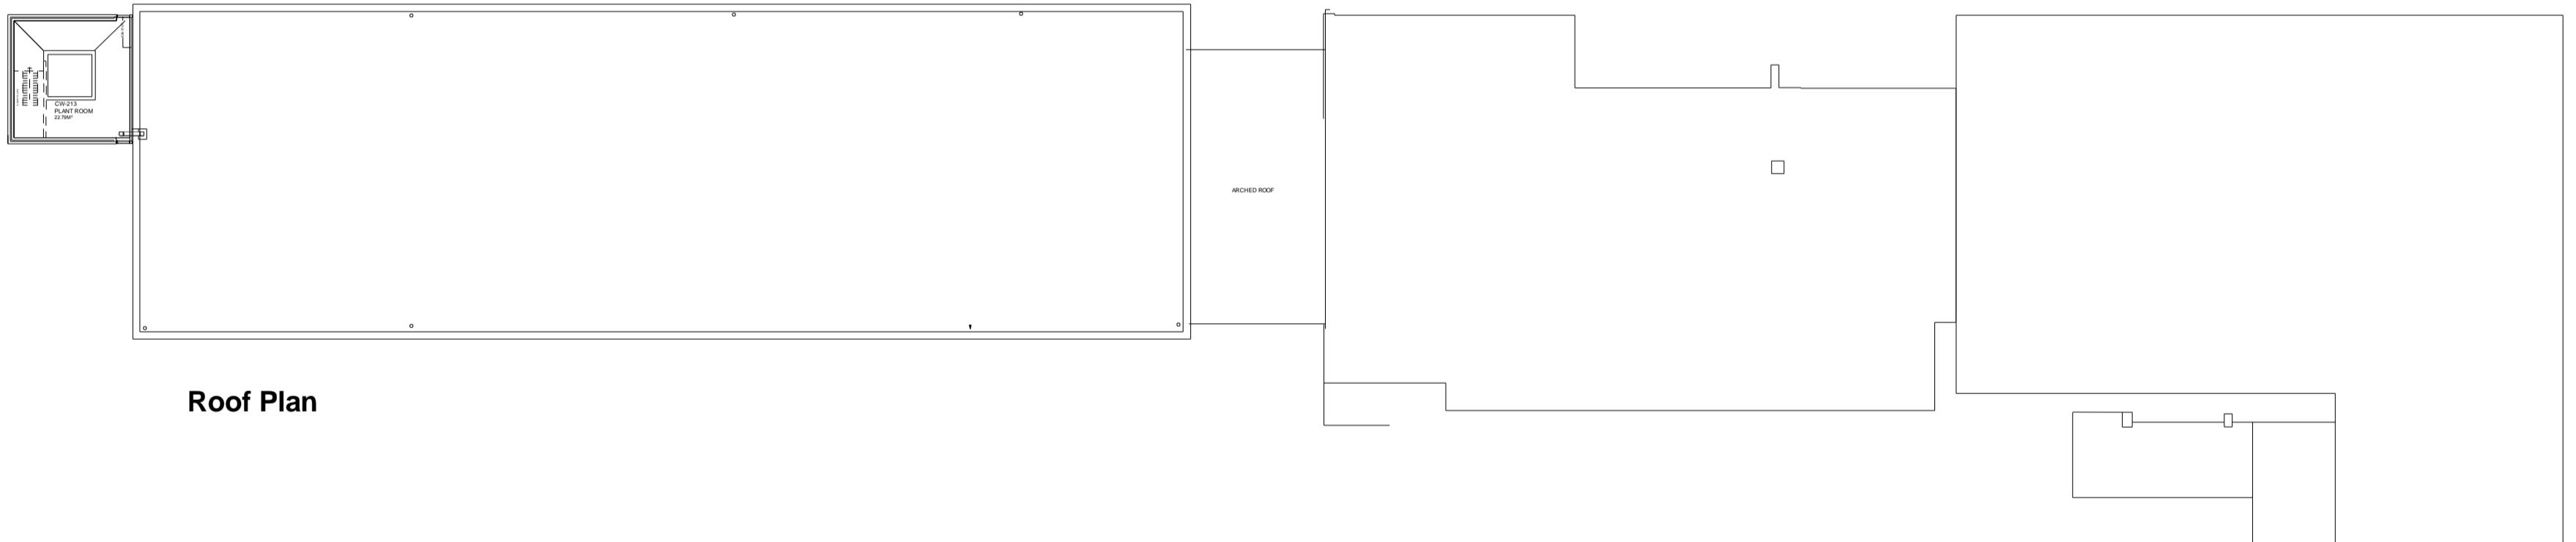

Roof Plan

A 20/11/2018 Drawing amended to match as built floor plan
Rev. Date Amendment



Coventry
University

Estate Department
Priory Street, Coventry
CV1 5FB
Tel: 024 76887688
Fax: 024 76887336

CURRENT STATUS

RECORD DRAWING

PROJECT

CHARLES WARD BUILDING

TITLE

AS BUILT ROOF PLAN

0 0.5 1 2.5 5 10m

DRAWN EM CHKD DATE 20/11/2018

SCALE 1/150 @ A1 DRAWING No. CW001-COV-00-R-M2-A REV. 0000