


NOTES

This Drawing Is The Copyright Of Coventry University Estates Department & Must Not Be Reproduced Without Their Permission. Figured Dimensions Must Be Taken In Preference To Scaled Dimensions & All Dimensions Must Be Verified On Site Prior To Commencing Any Works.



AREAS

GIA (Gross Internal Area)	306.14 m ²
GEA (Gross External Area)	340.71 m ²

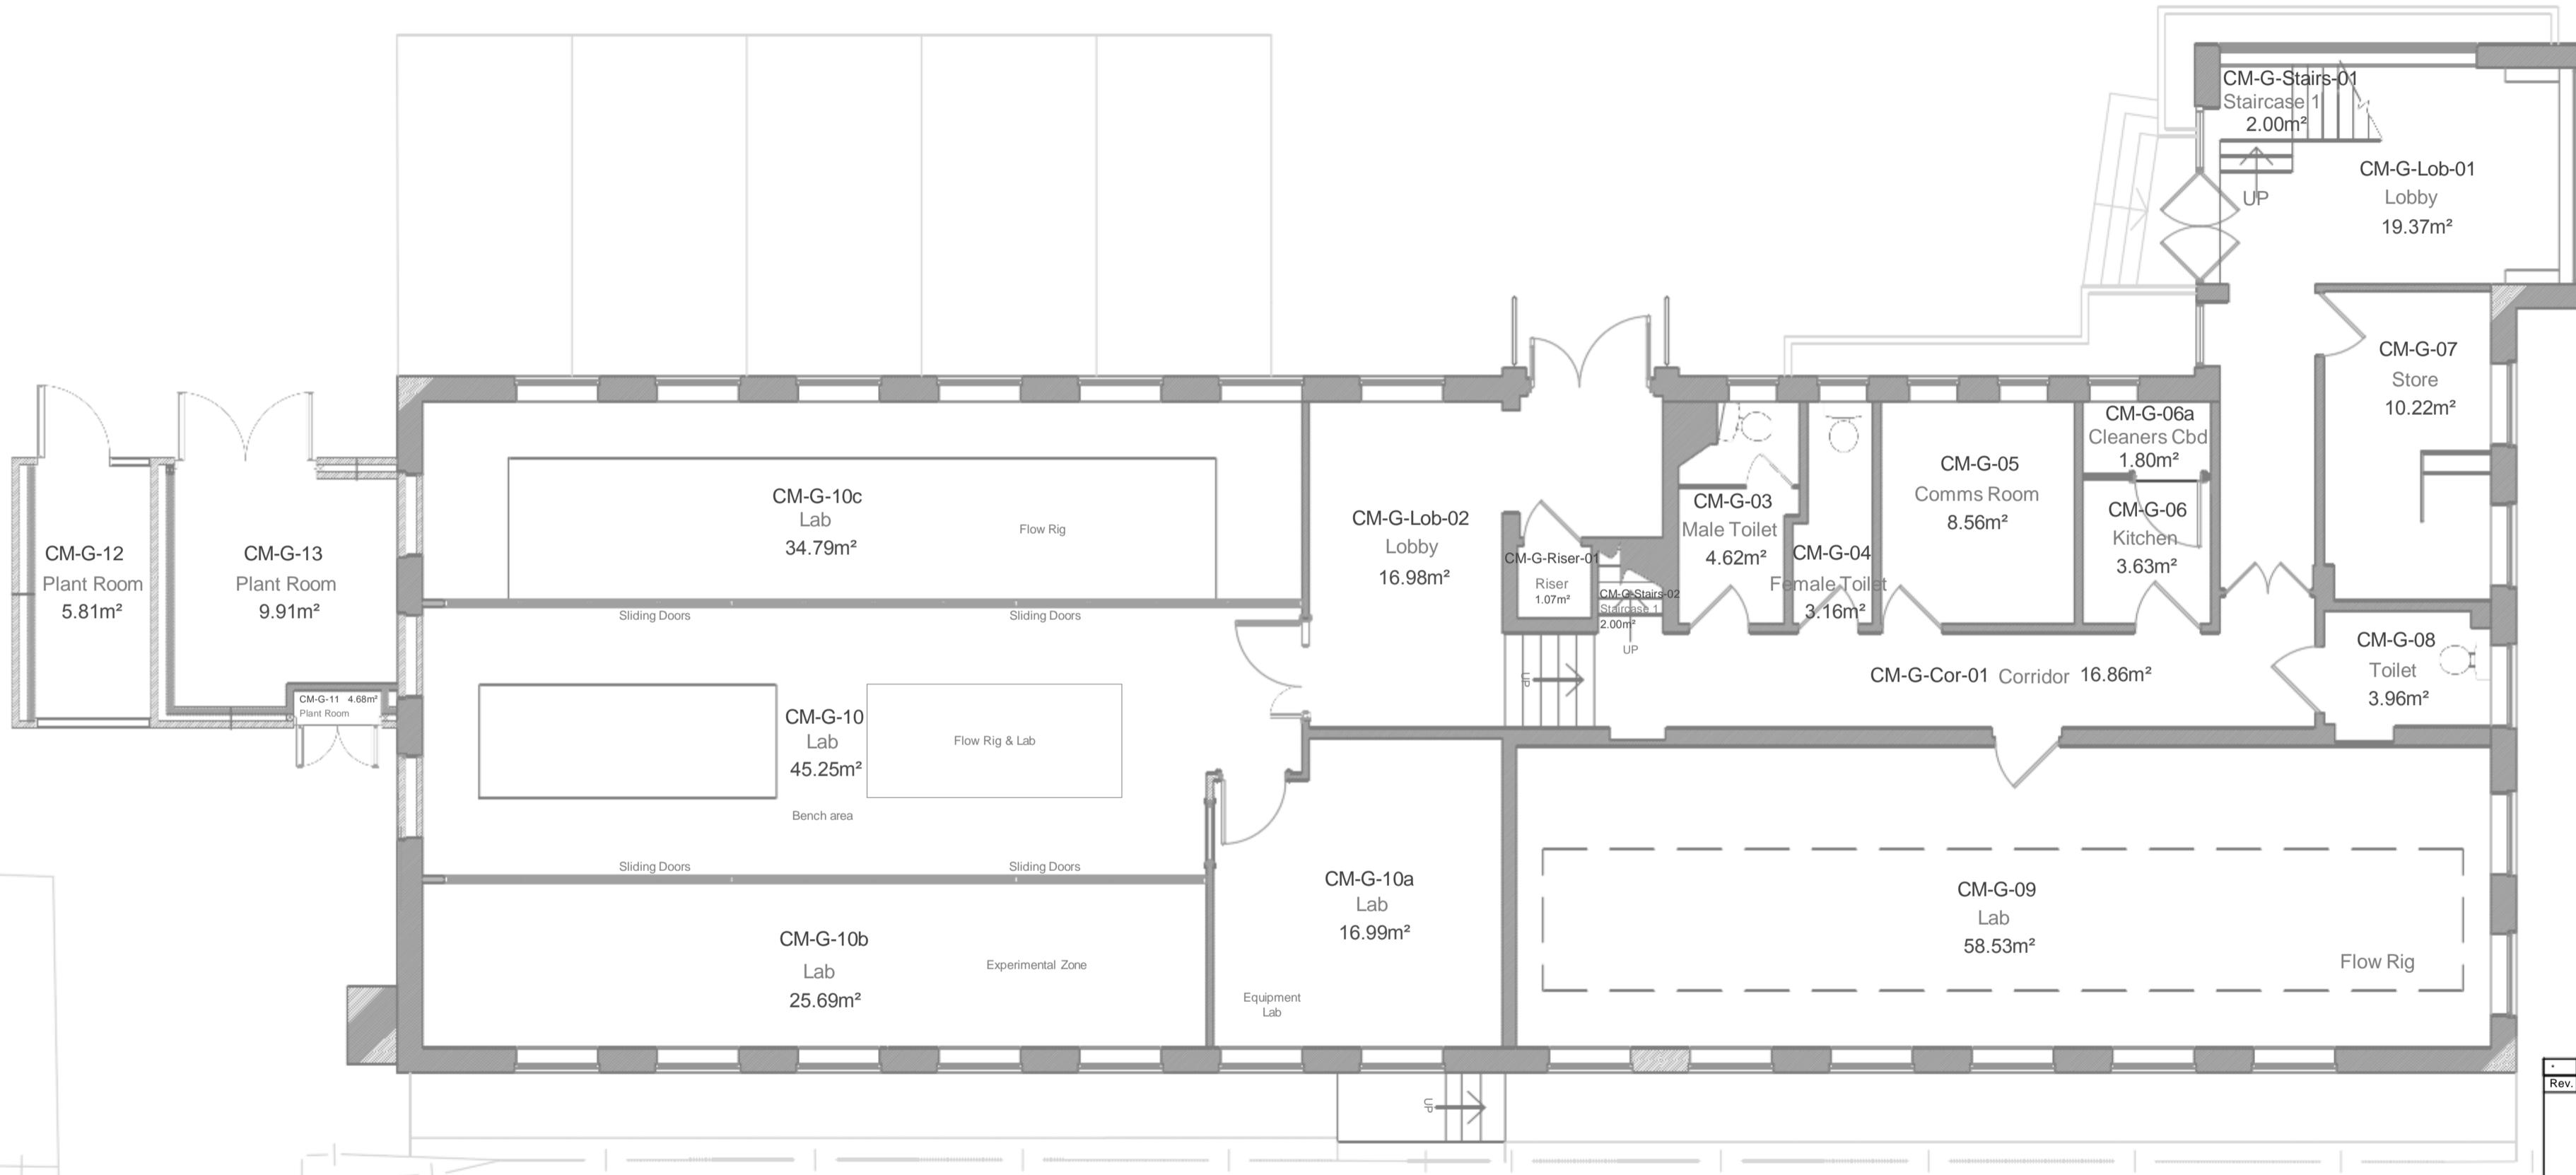


NOTES

This Drawing Is The Copyright Of Coventry University Estates Department & Must Not Be Reproduced Without Their Permission. Figured Dimensions Must Be Taken In Preference To Scaled Dimensions & All Dimensions Must Be Verified On Site Prior To Commencing Any Works.



AREAS

GIA (Gross Internal Area)	287.98 m ²
GEA (Gross External Area)	319.95 m ²

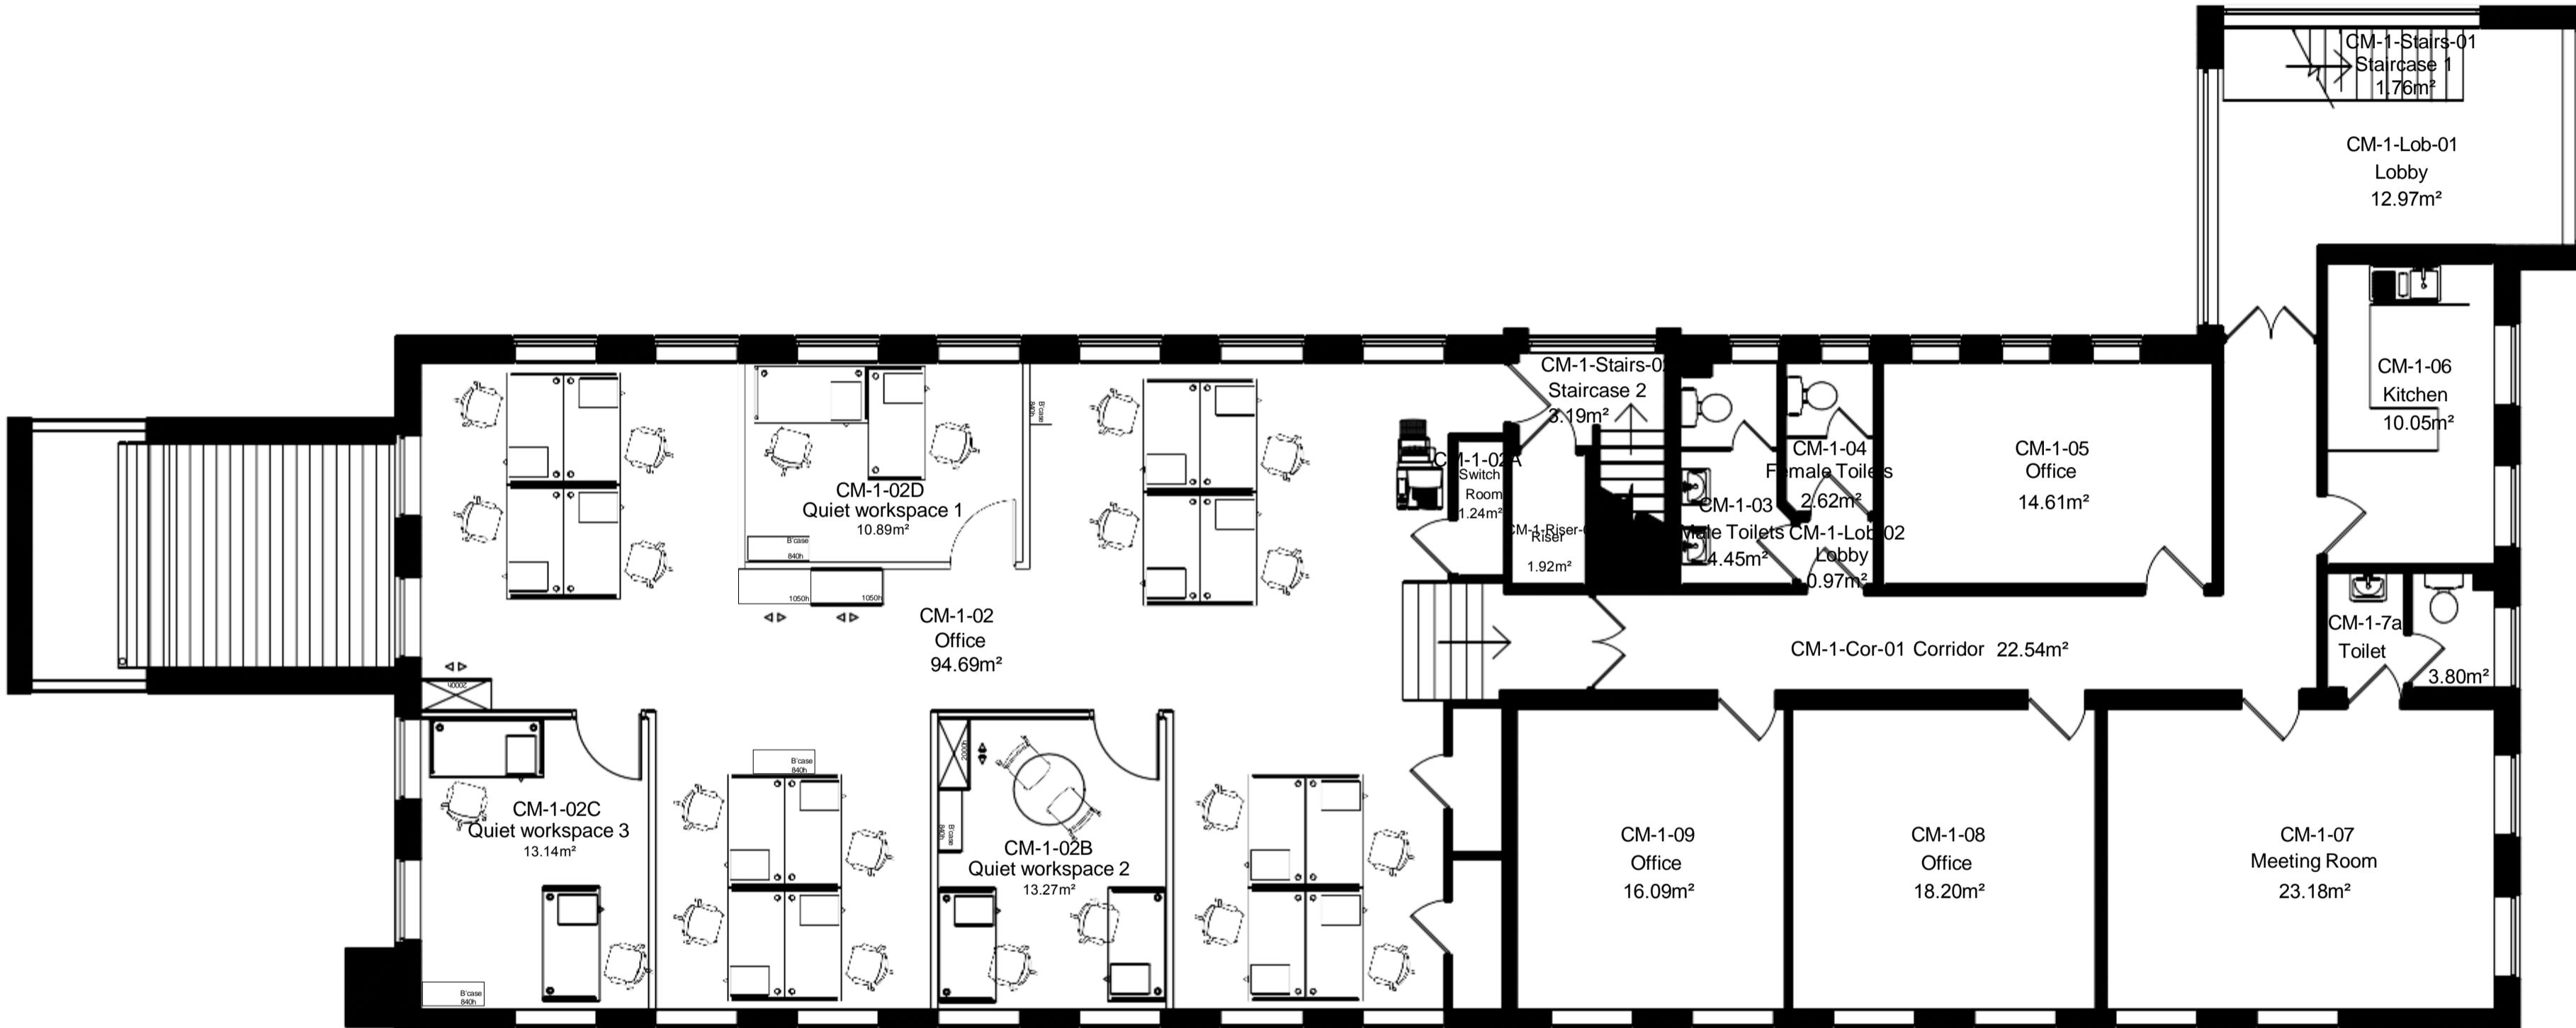

First Floor Plan

Rev.	Date	Amendment
 Coventry University		
Estates Department Priory Street, Coventry CV1 5FB Tel: 024 76887688 Fax: 024 76887336		
CURRENT STATUS		
RECORD DRAWING		
PROJECT CYRIL MAUDSLEY		
TITLE FIRST FLOOR PLAN		
DRAWN	09/07/2020	DATE
EM	HS	09/07/2020
SCALE	DRAWING No.	REV.
1:50 @ A1	CM001-COV-00-01-M2-A	0000