



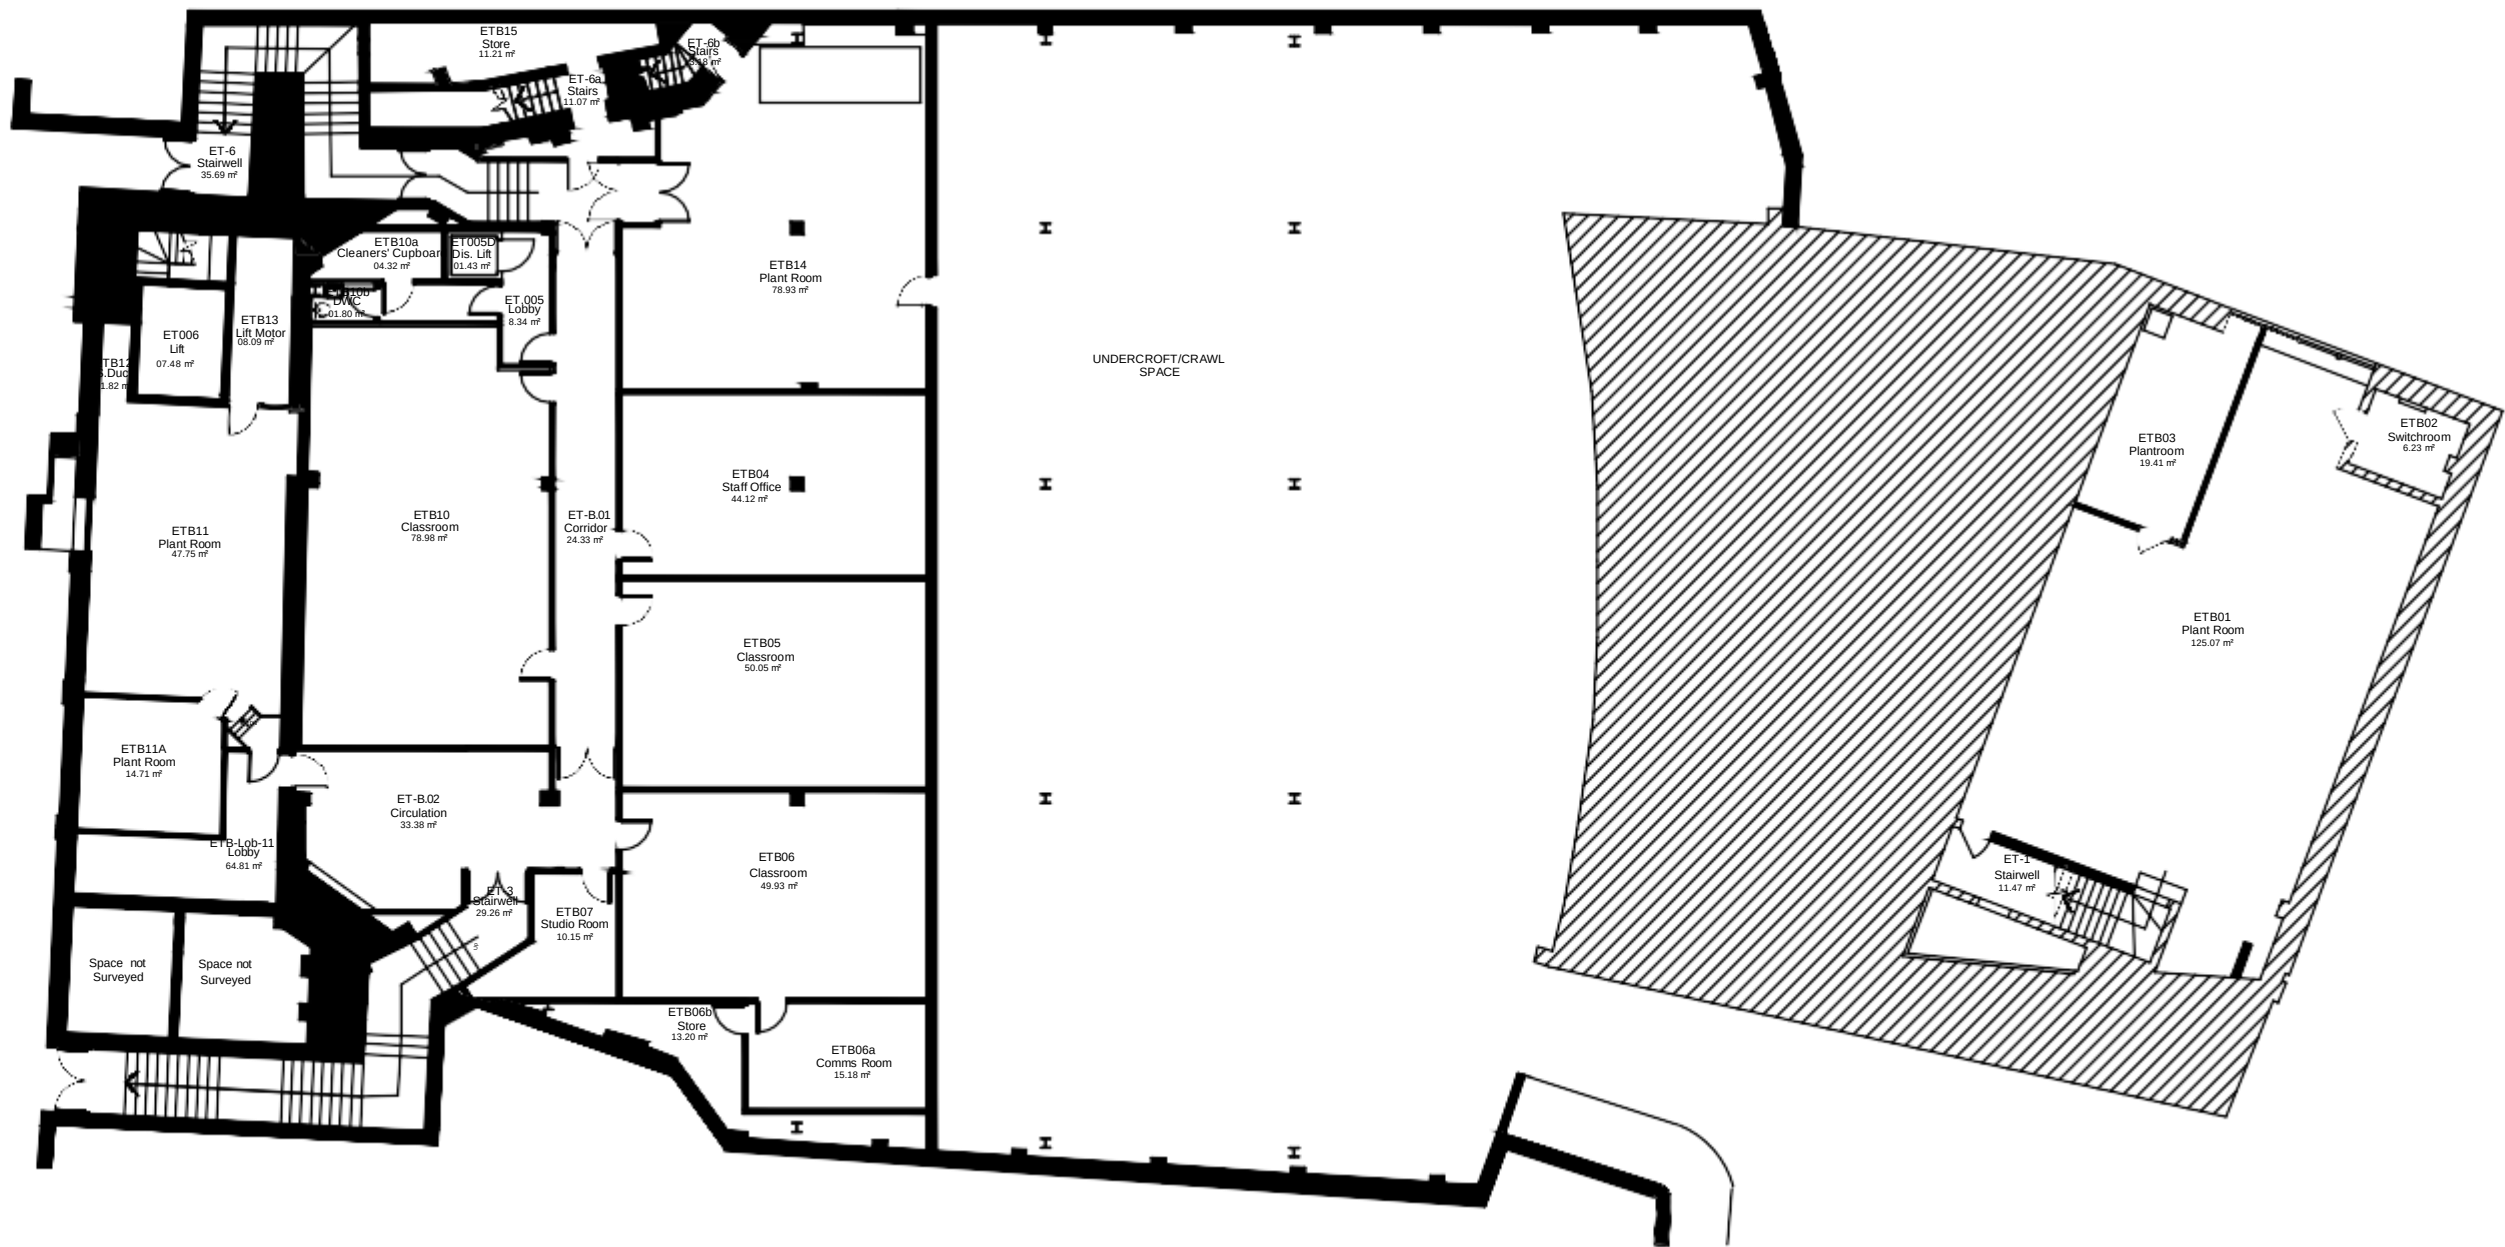


Basement Plan

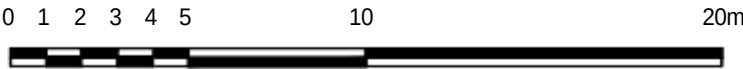

NOTES

This Drawing Is The Copyright Of Coventry University Estates Department & Must Not Be Reproduced Without Their Permission. Figured Dimensions Must Be Taken In Preference To Scaled Dimensions & All Dimensions Must Be Verified On Site Prior To Commencing Any Works.

Rev.	Date	Amendment	DRWN
A	07/03/2018	Drawing amended to match as built floor plan. Disabled Toilet Repositioned and Room B10a converted to Cleaners' cupboard. Room B08 demolished to create new informal Learning area. New fire door fitted on corridor.	EM

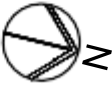


A	15/11/2018	GIA = 824.91 m²	EM
Rev.	Date	Amendment	DRWN



Estates Department
Priory Street, Coventry
CV1 5FB
Tel: 024 76887688
Fax: 024 76887336

CURRENT STATUS			
RECORD DRAWING			
PROJECT			
ELLEN TERRY			
TITLE			
BASEMENT PLAN			
DRAWN		CHKD	DATE
EM		HS	07/03/2018
SCALE		DRAWING No.	REV.
1/200		ET001-COV-00-B-M2-A	0000

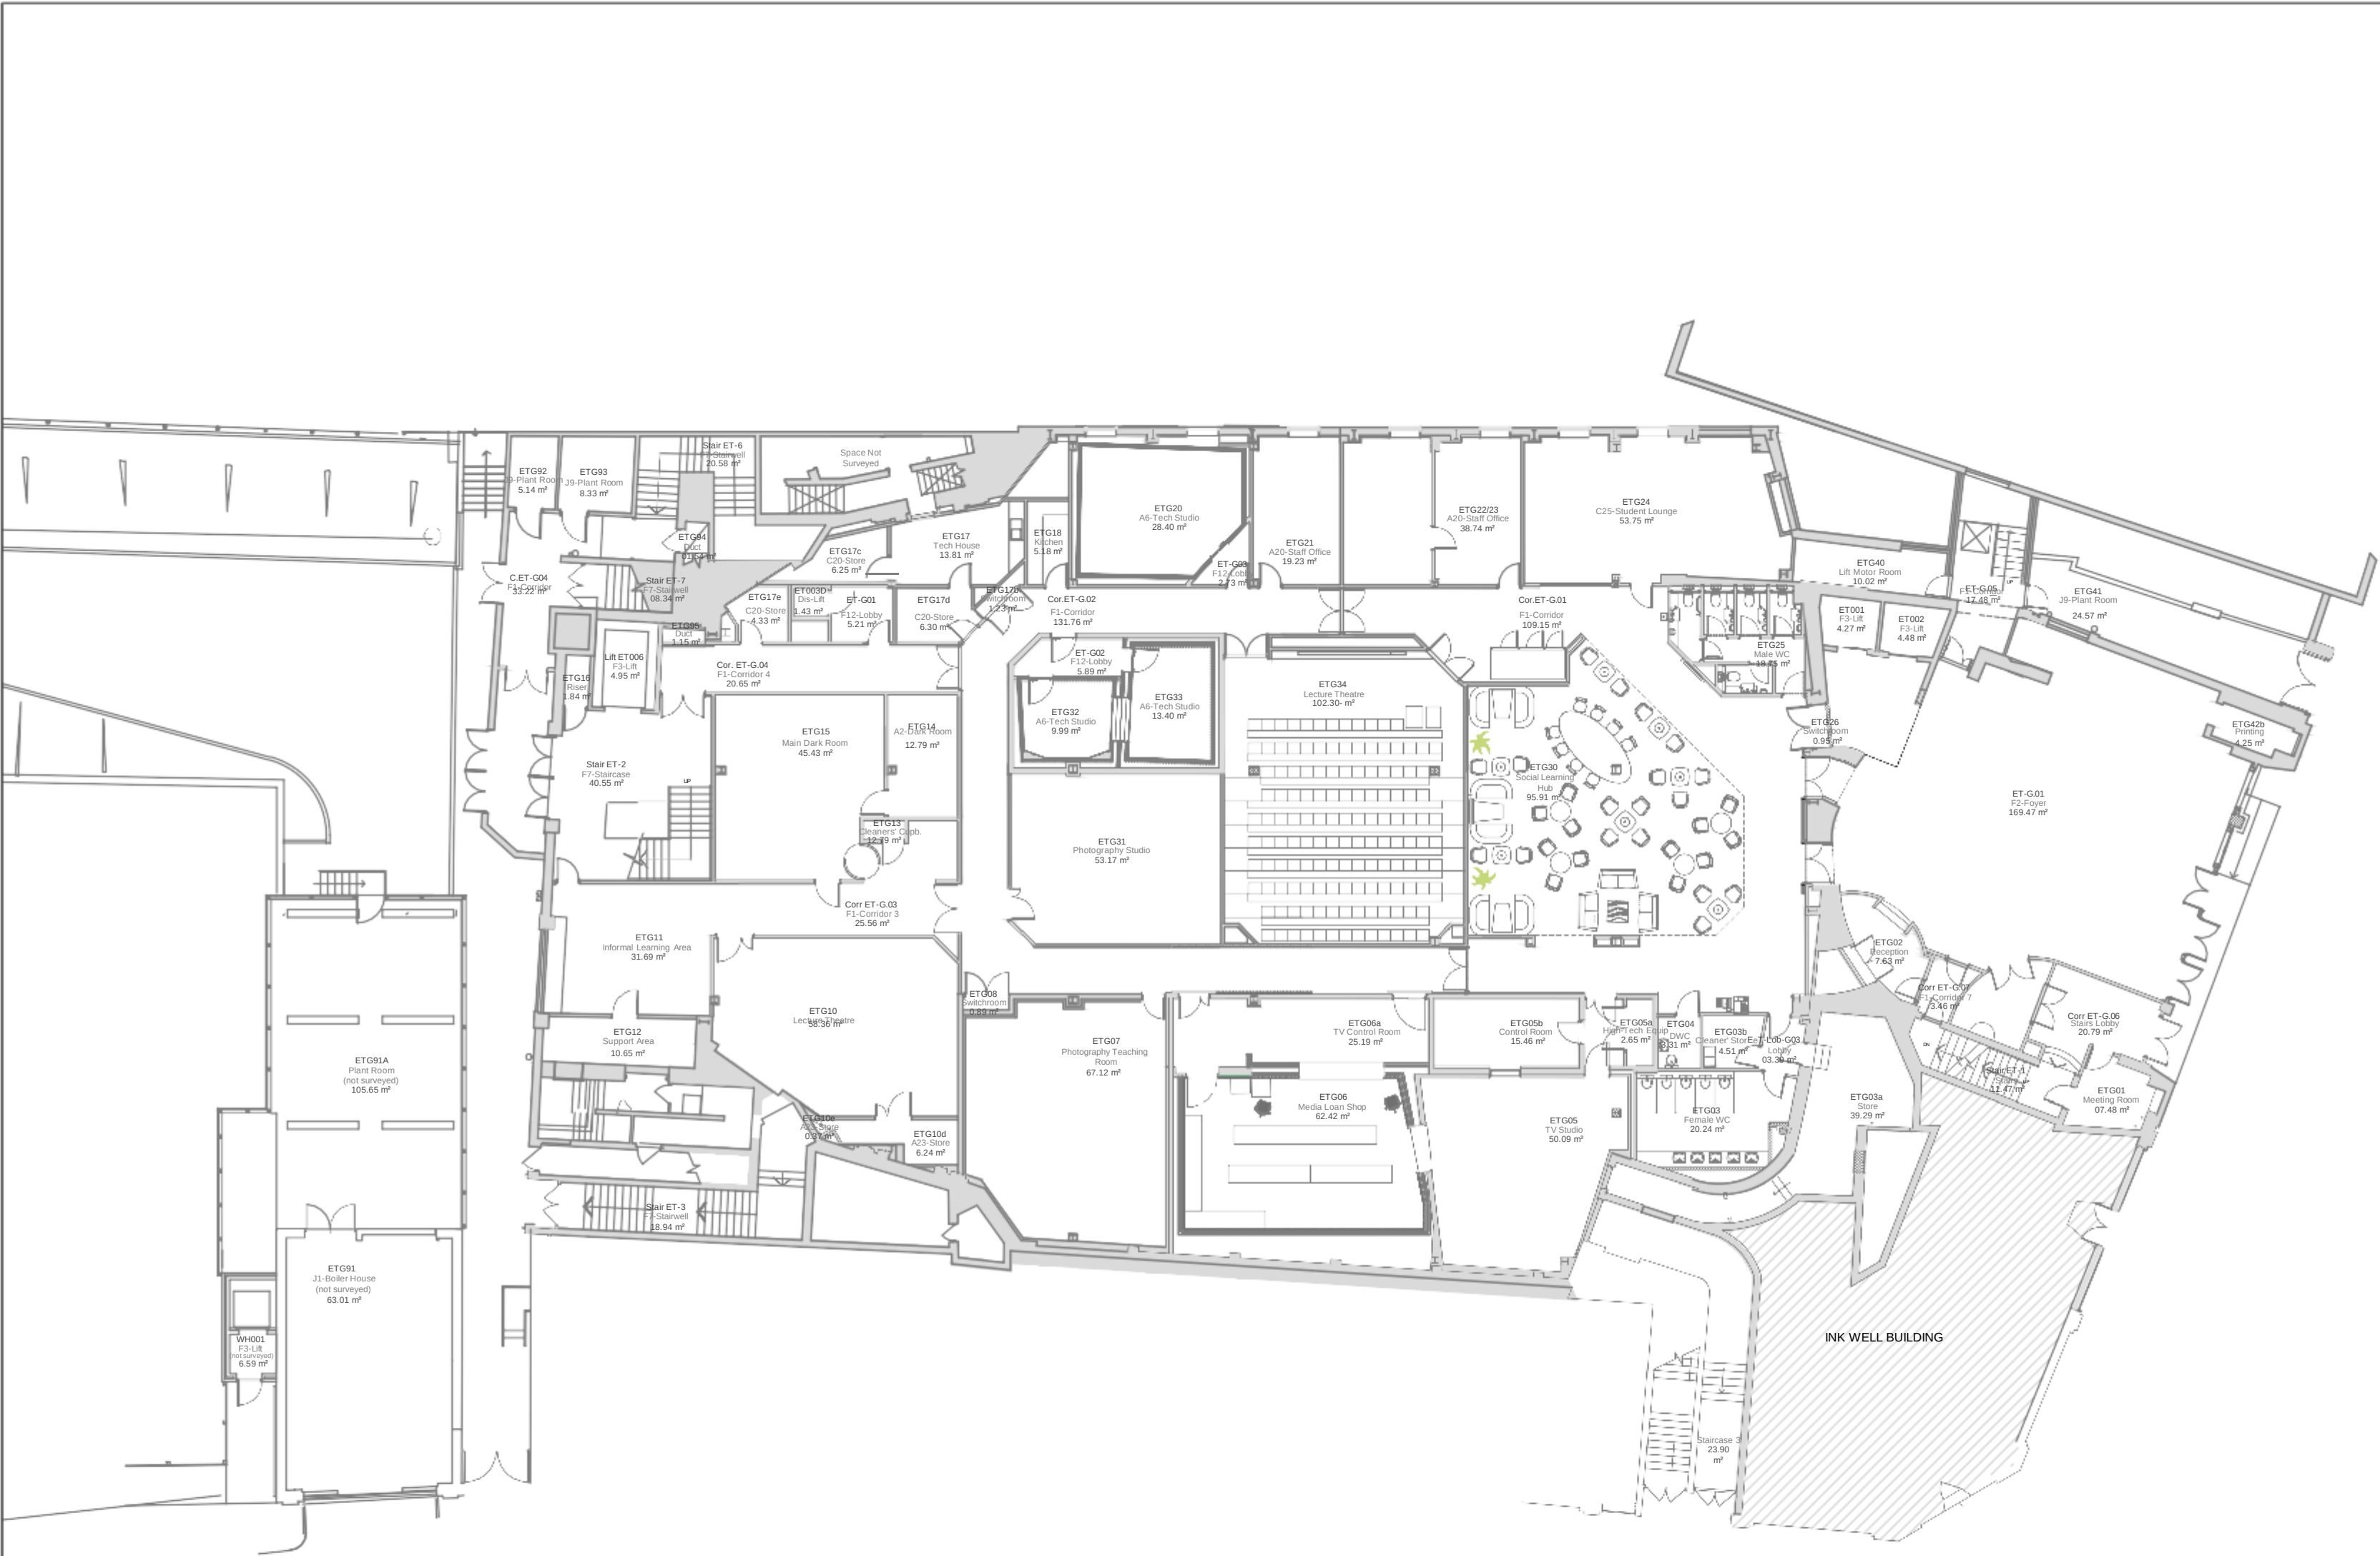

Ground Floor Plan

NOTES

This Drawing Is The Copyright Of Coventry University Estates Department & Must Not Be Reproduced Without Their Permission. Figured Dimensions Must Be Taken In Preference To Scaled Dimensions & All Dimensions Must Be Verified On Site Prior To Commencing Any Works.

Rev.	Date	Amendment	DRWN
A	09/03/2018	Drawing amended to match as built floor plan. Rooms G41, G42 & G42a demolished to increase main foyer space. Partitioning wall between room G30 and G35 demolished to make one media shop.	EM
B	26/09/2022	Drawing amended to match as per refurbishment to the Ground floor.	EM




A	09/11/18	GIA = 2146.33 m ²
Rev.	Date	Amendment




Estates Department
Priory Street, Coventry
CV1 5FB
Tel: 024 76887688
Fax: 024 76887336

CURRENT STATUS		
RECORD DRAWING		
PROJECT SCHOOL OF ART & DESIGN PERFORMING ARTS ELLEN TERRY BUILDING		
TITLE AS BUILT GROUND FLOOR PLAN		
DRAWN EM	CHKD HS	DATE 07/03/2018
SCALE 1/200	DRAWING No. ET001-COV-00-GF-M2-A	REV. B

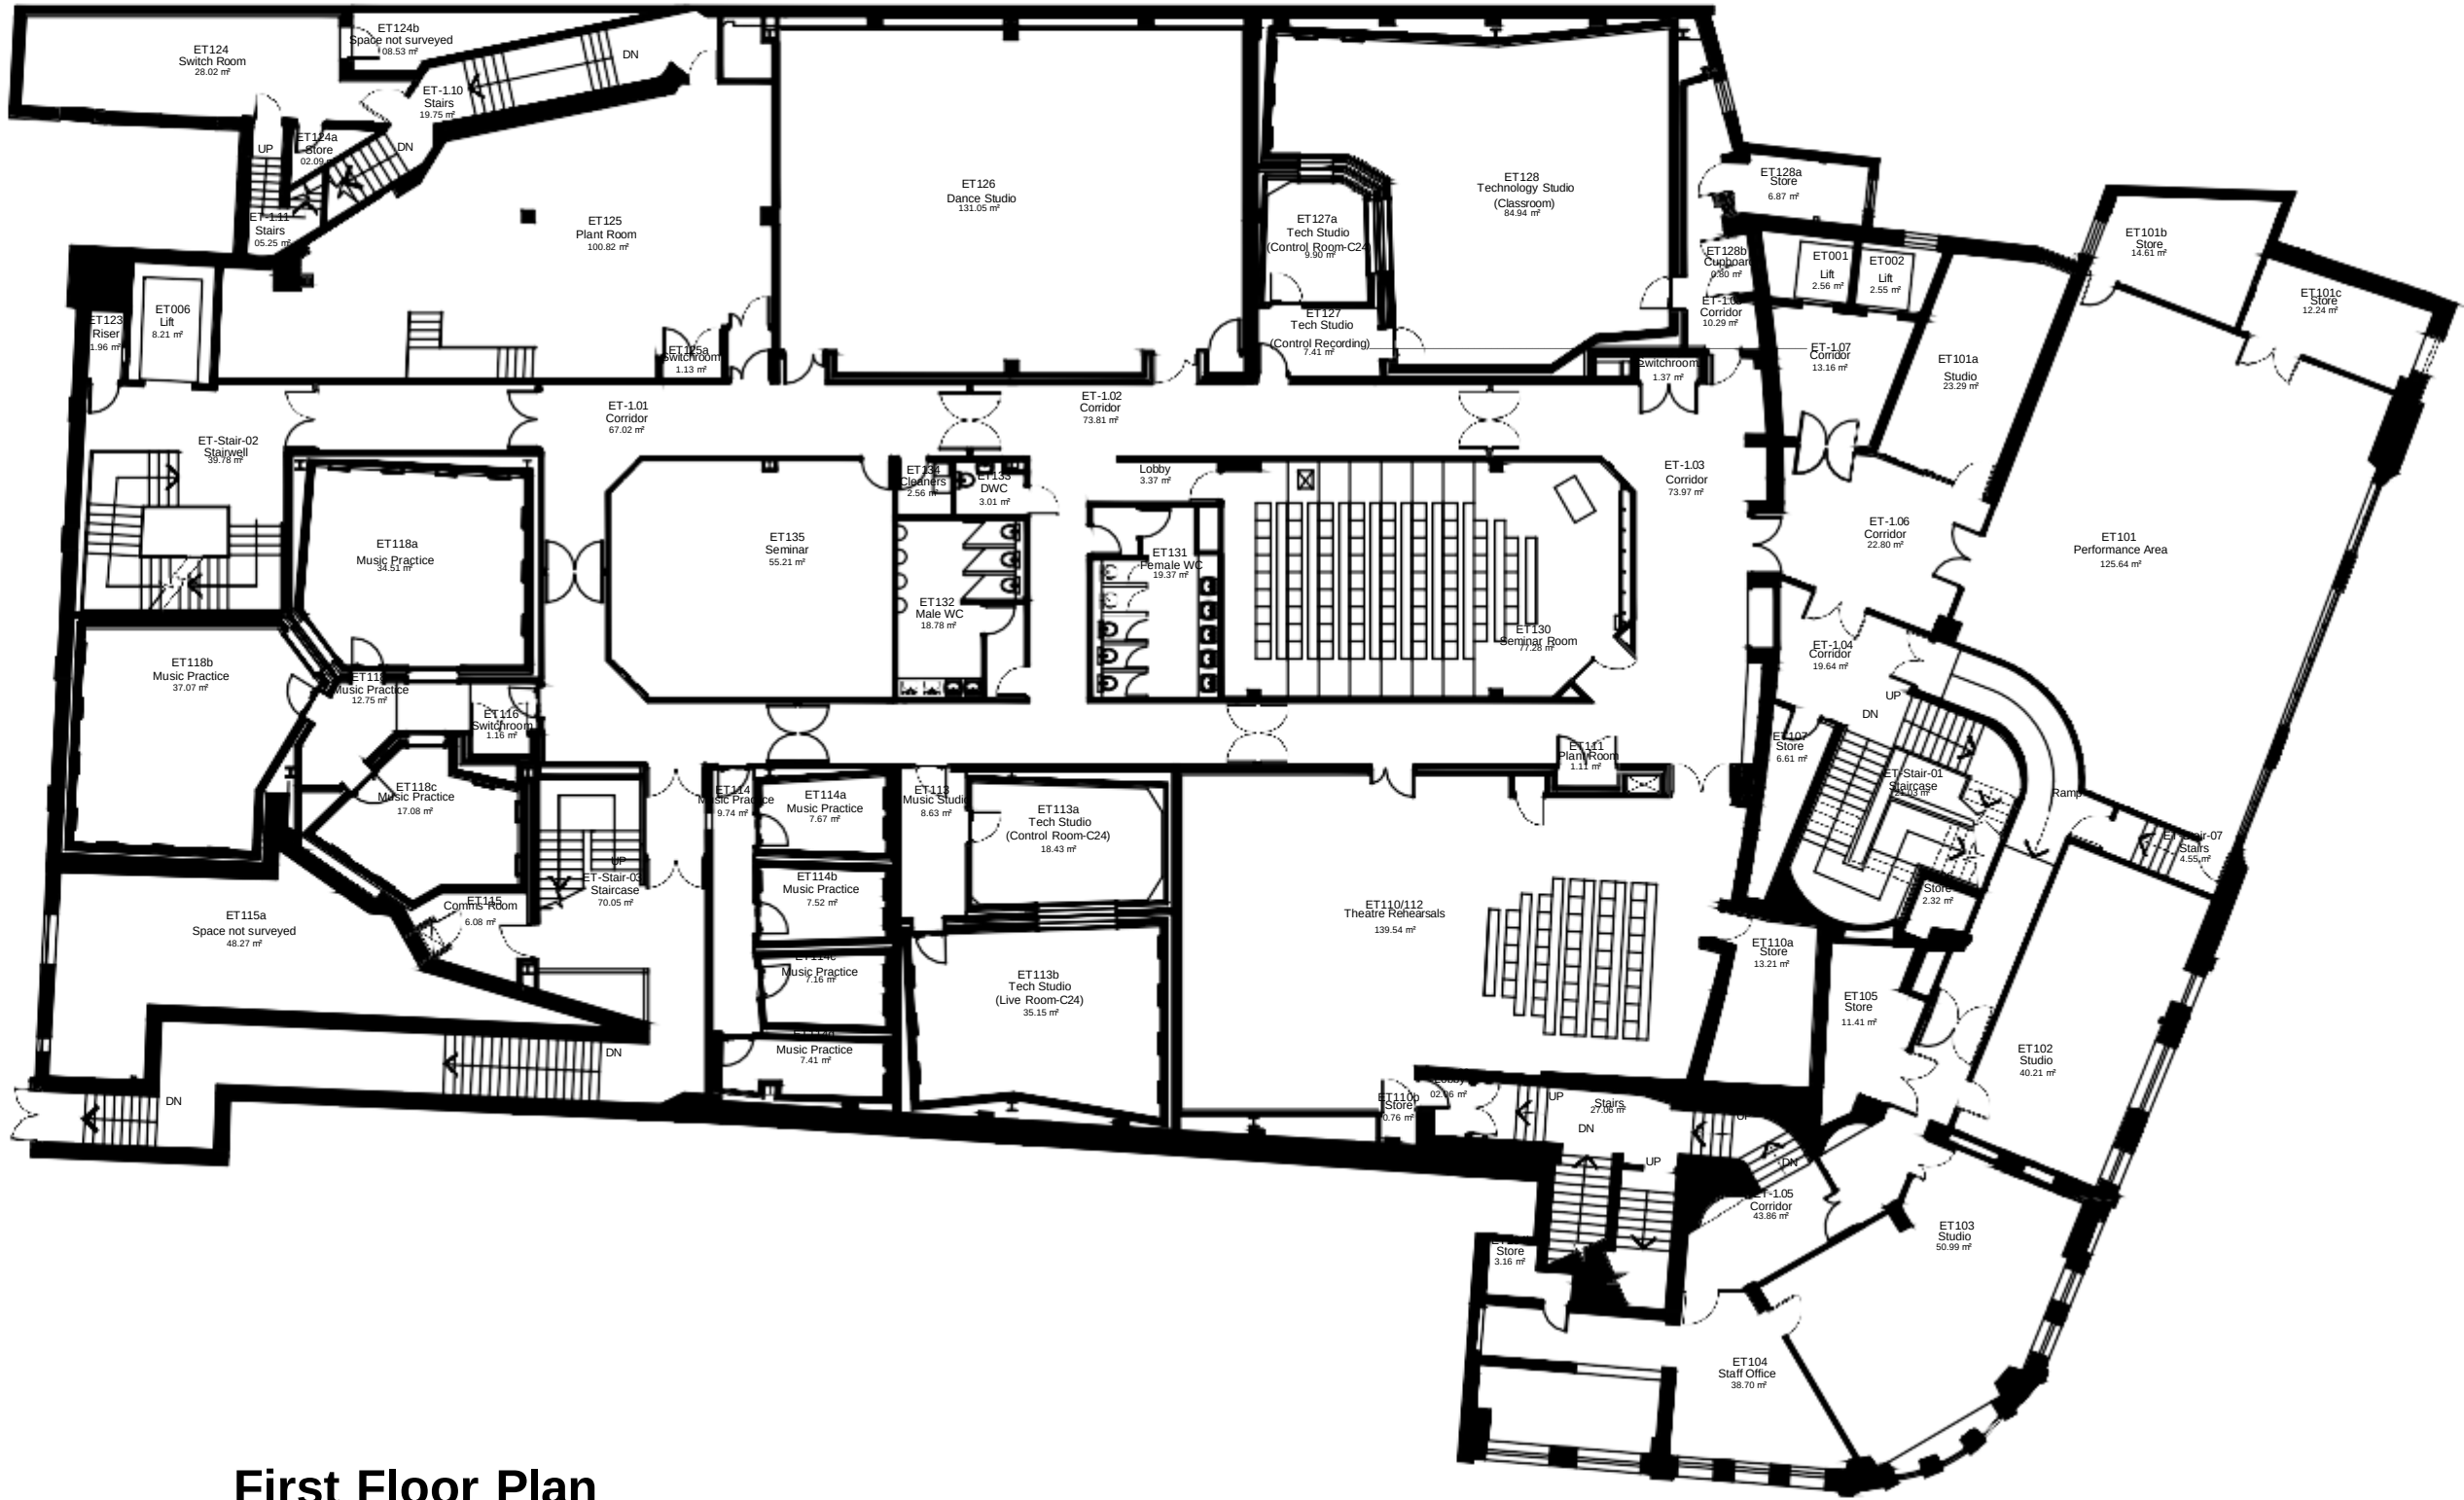

First Floor Plan

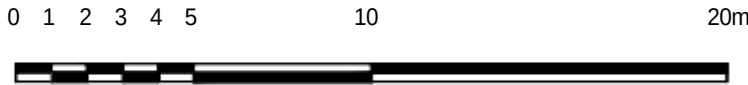

NOTES

This Drawing Is The Copyright Of Coventry University Estates Department & Must Not Be Reproduced Without Their Permission. Figured Dimensions Must Be Taken In Preference To Scaled Dimensions & All Dimensions Must Be Verified On Site Prior To Commencing Any Works.

Rev.	Date	Amendment	DRWN
A	12/03/2018	Drawing amended to match as built floor plan.	EM




A	15/11/18	GIA = 2079.52 m²
Rev.	Date	Amendment




Estates Department
Priory Street, Coventry
CV1 5FB
Tel: 024 76887688
Fax: 024 76887336

CURRENT STATUS			
RECORD DRAWING			
PROJECT			
ELLEN TERRY			
TITLE			
FIRST FLOOR PLAN			
DRAWN EM		CHKD HS	DATE 07/03/2018
SCALE 1/200		DRAWING No. ET001-COV-00-01-M2-A	REV. 0000

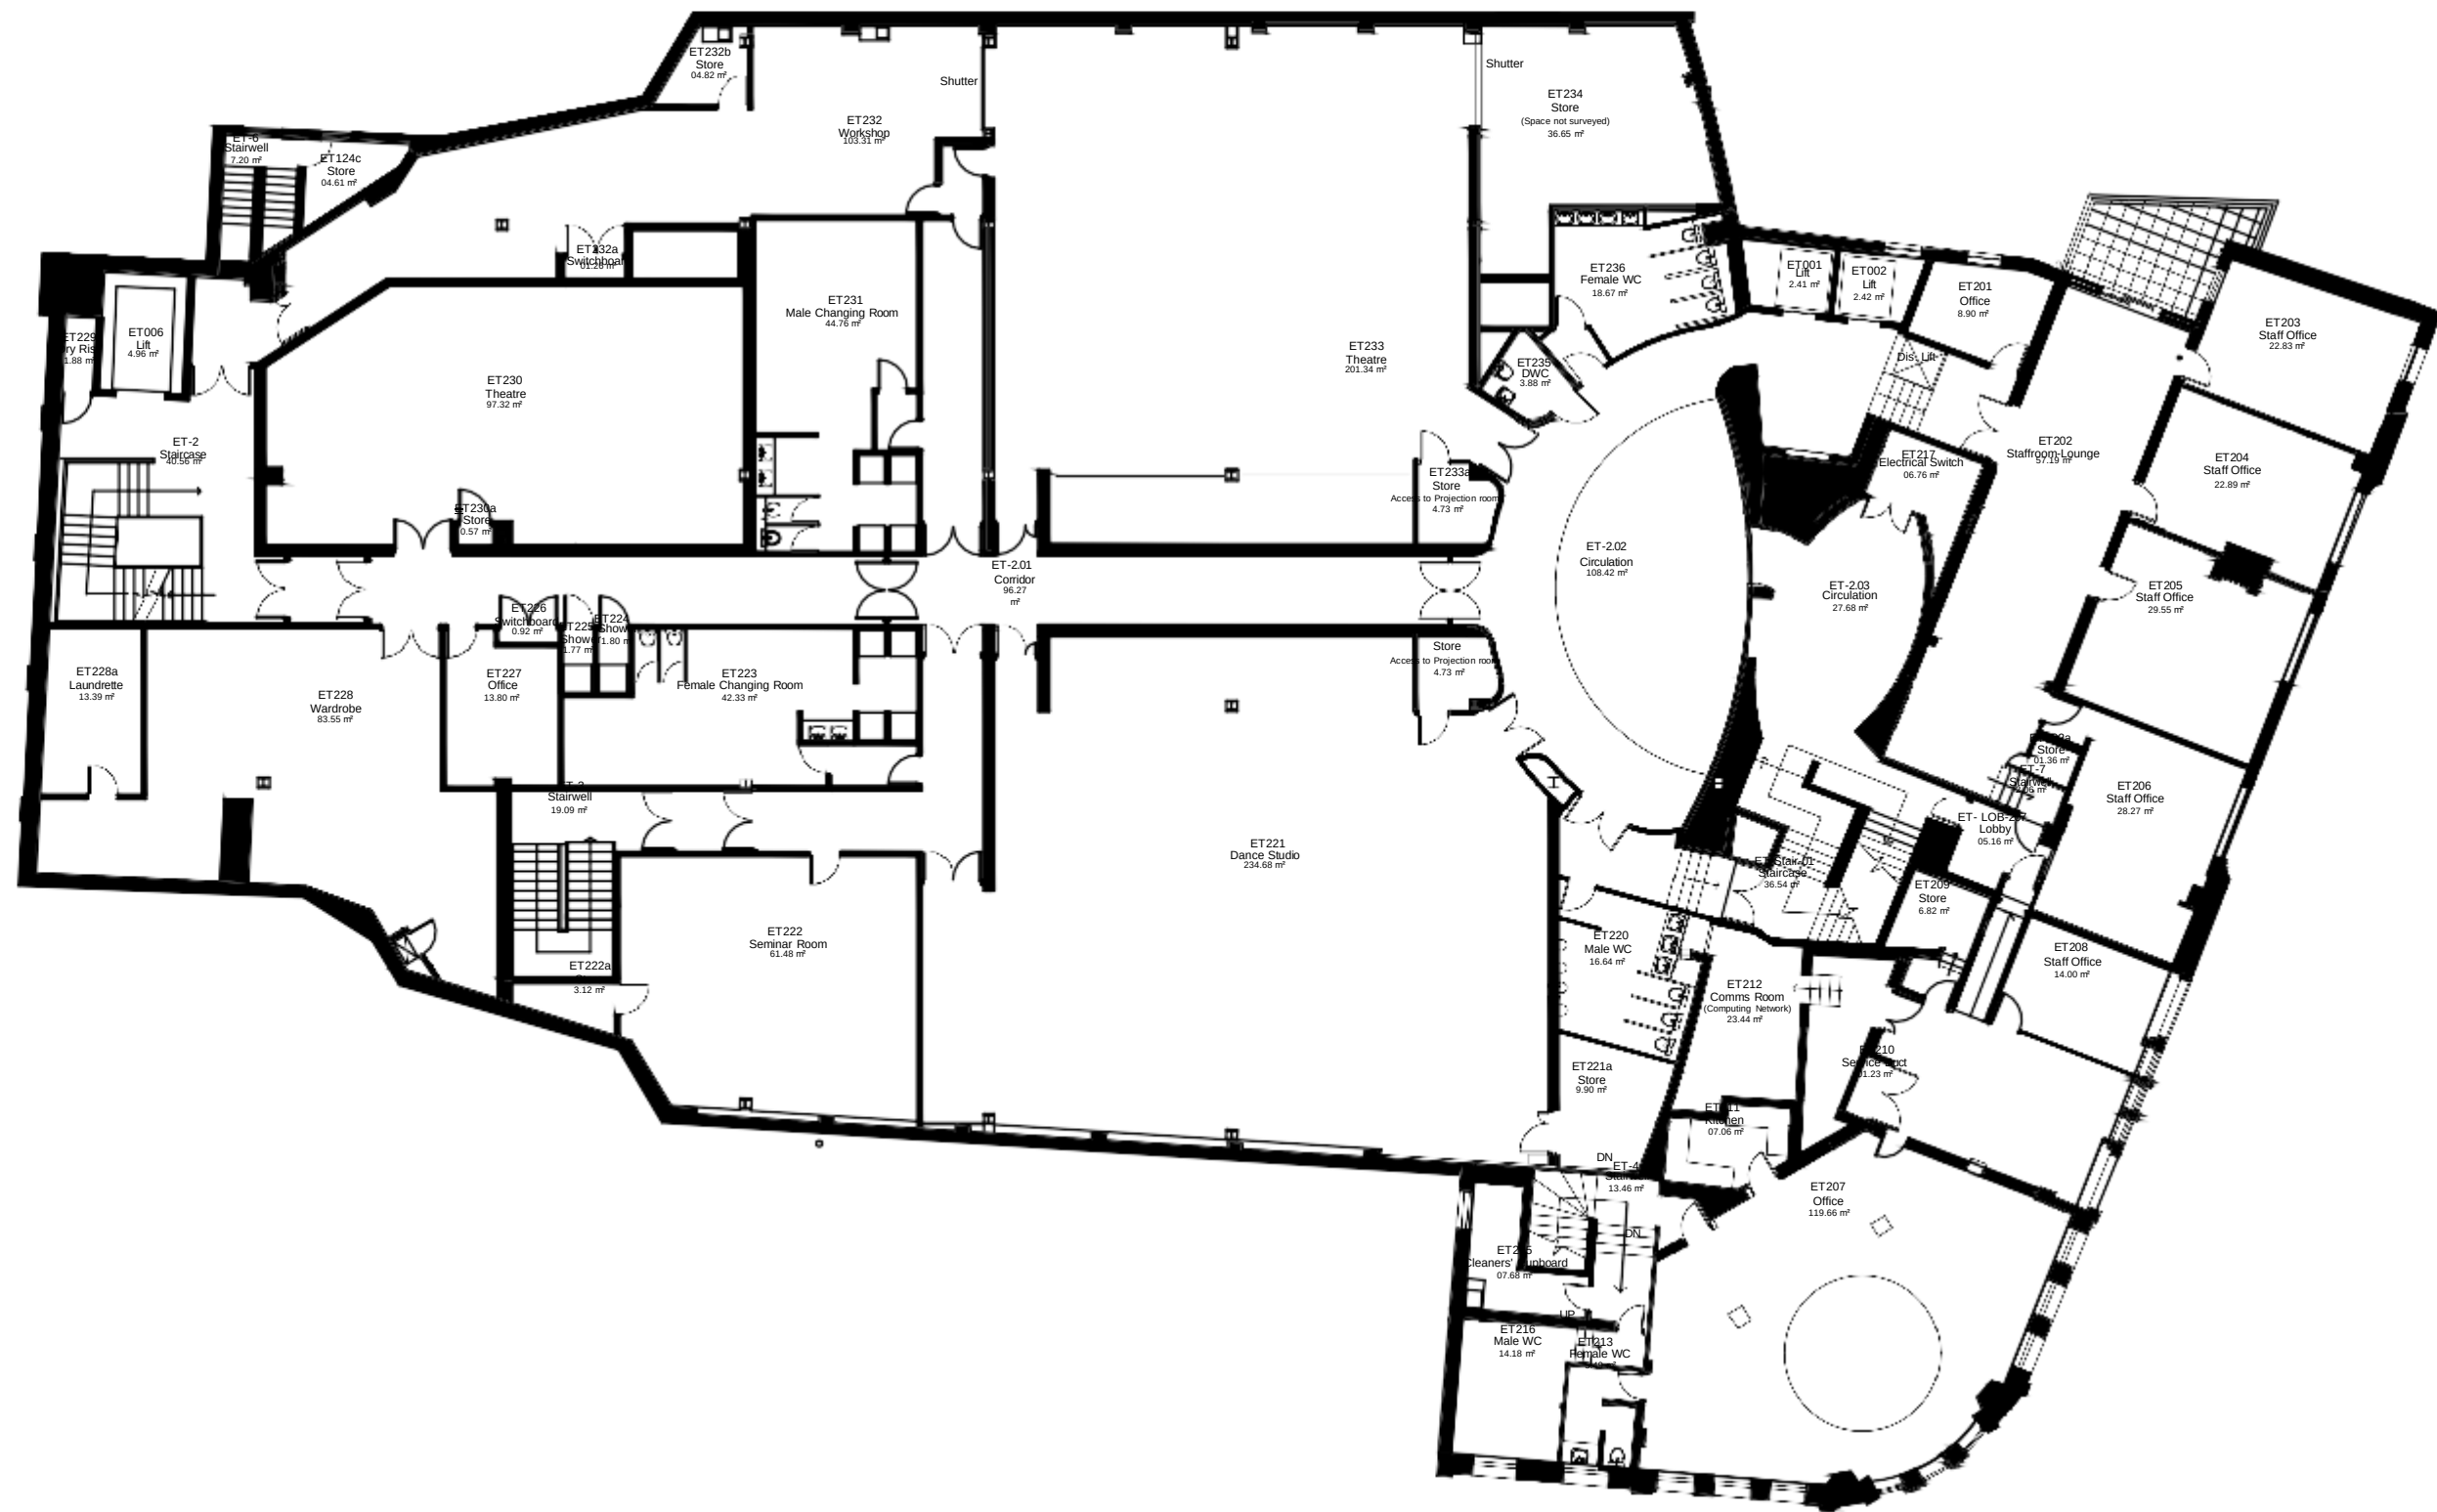

Second Floor Plan

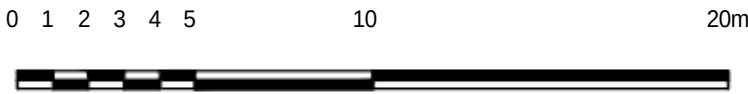

NOTES

This Drawing Is The Copyright Of Coventry University Estates Department & Must Not Be Reproduced Without Their Permission. Figured Dimensions Must Be Taken In Preference To Scaled Dimensions & All Dimensions Must Be Verified On Site Prior To Commencing Any Works.

Rev.	Date	Amendment	DRWN
A	14/03/2018	Drawing amended to match as built floor plan.	EM




A	15/11/18	GIA = 1906.88 m²
Rev.	Date	Amendment




Estates Department
Priory Street, Coventry
CV1 5FB
Tel: 024 76887688
Fax: 024 76887336

CURRENT STATUS			
RECORD DRAWING			
PROJECT			
ELLEN TERRY			
TITLE			
AS BUILT SECOND FLOOR PLAN			
DRAWN EM		CHKD HS	DATE 12/03/2018
SCALE 1/200		DRAWING No. ET001-COV-00-02-M2-A	REV. 0000

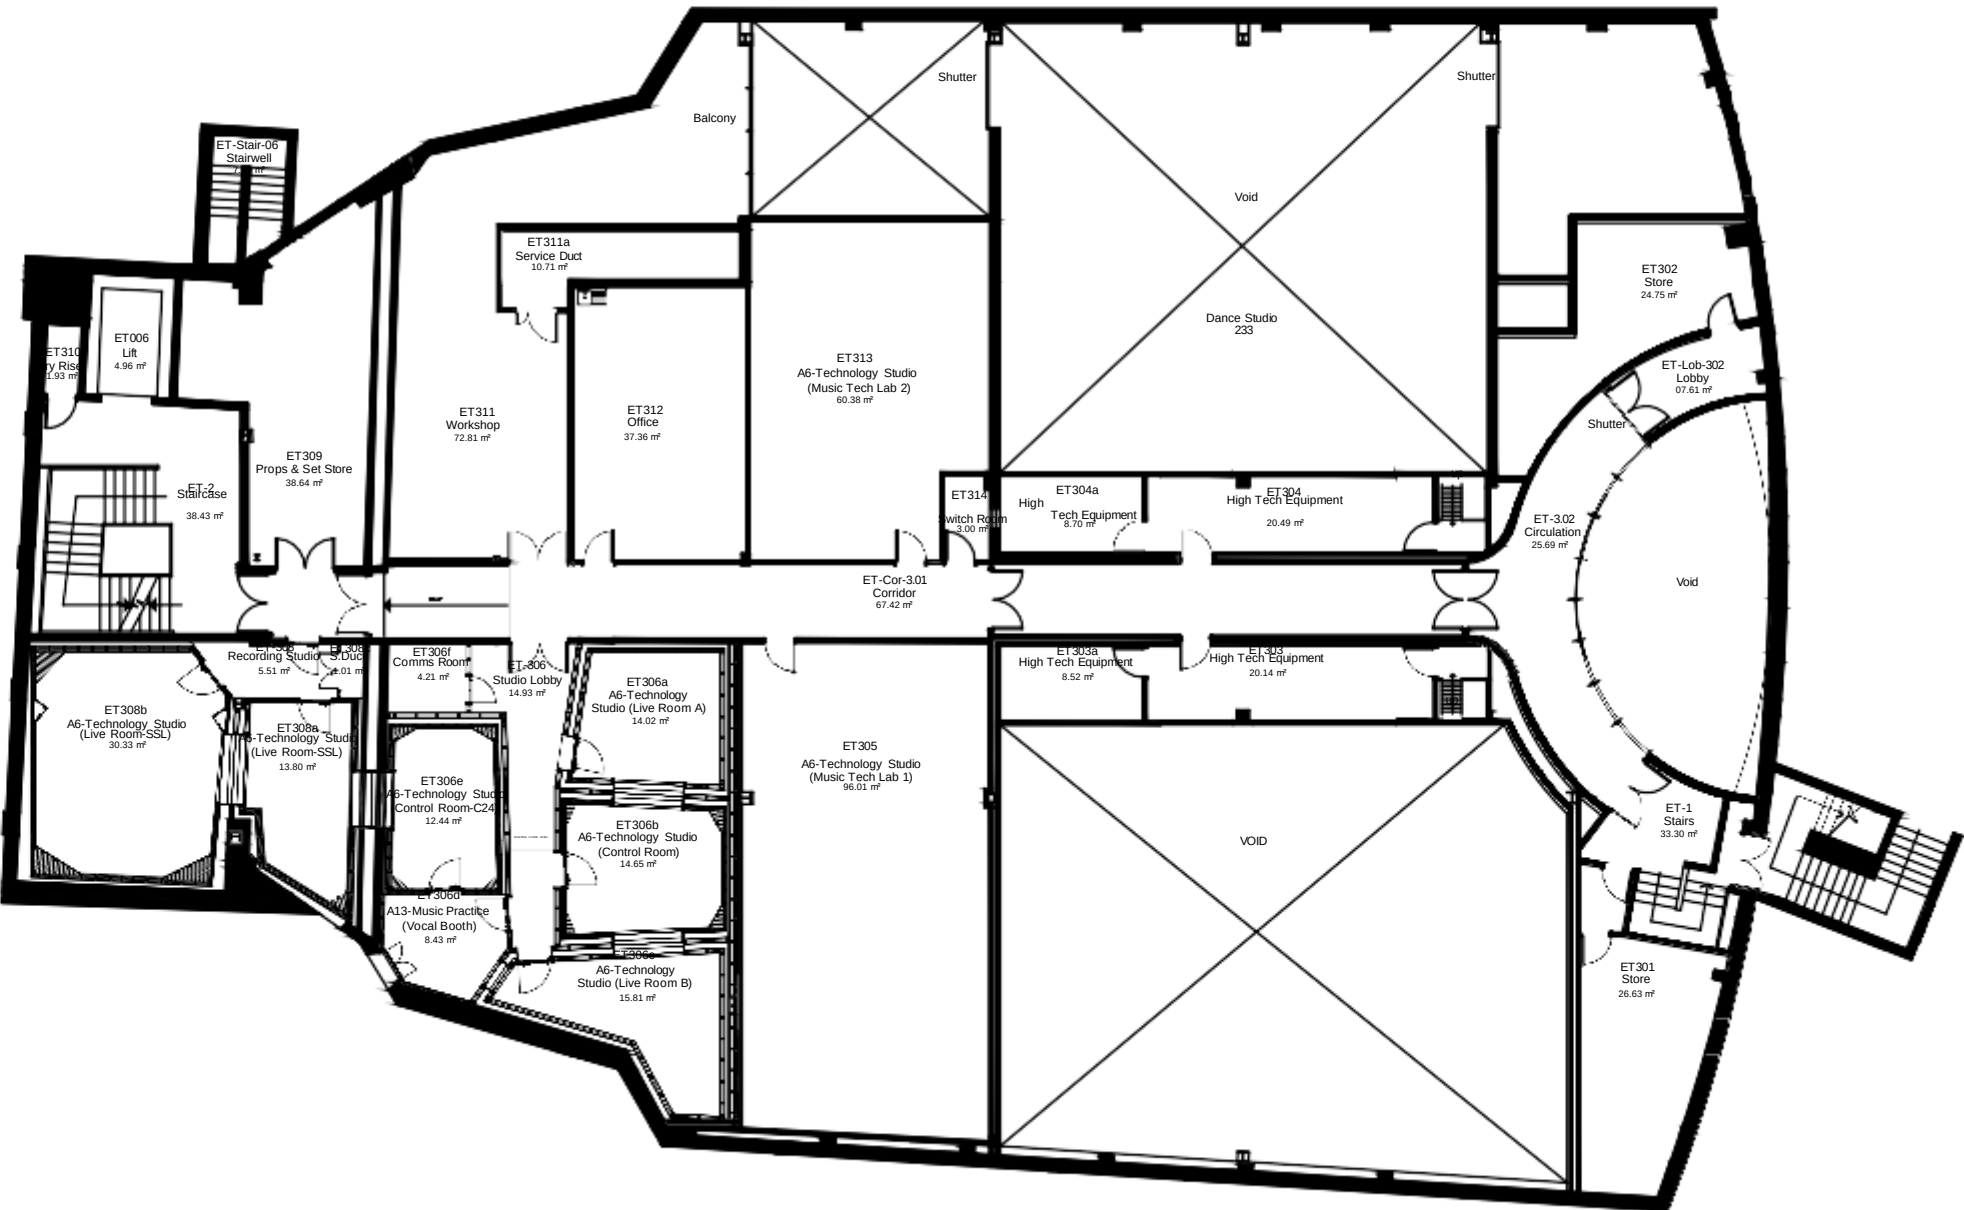

Third Floor Plan

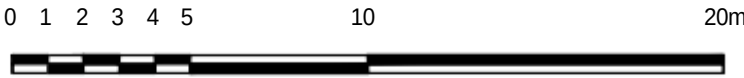

NOTES

This Drawing Is The Copyright Of Coventry University Estates Department & Must Not Be Reproduced Without Their Permission. Figured Dimensions Must Be Taken In Preference To Scaled Dimensions & All Dimensions Must Be Verified On Site Prior To Commencing Any Works.

Rev.	Date	Amendment	DRWN
A	08/03/2018	Drawing amended to match as built floor plan.	EM




A	15/11/18	GIA = 847.80 m ²
Rev.	Date	Amendment




Estates Department
Priory Street, Coventry
CV1 5FB
Tel: 024 76887688
Fax: 024 76887336

CURRENT STATUS			
RECORD DRAWING			
PROJECT			
ELLEN TERRY			
TITLE			
AS BUILT THIRD FLOOR PLAN			
DRAWN		CHKD	DATE
EM		HS	13/03/2018
SCALE		DRAWING No.	REV.
1/200		ET001-COV-00-03-M2-A	0000

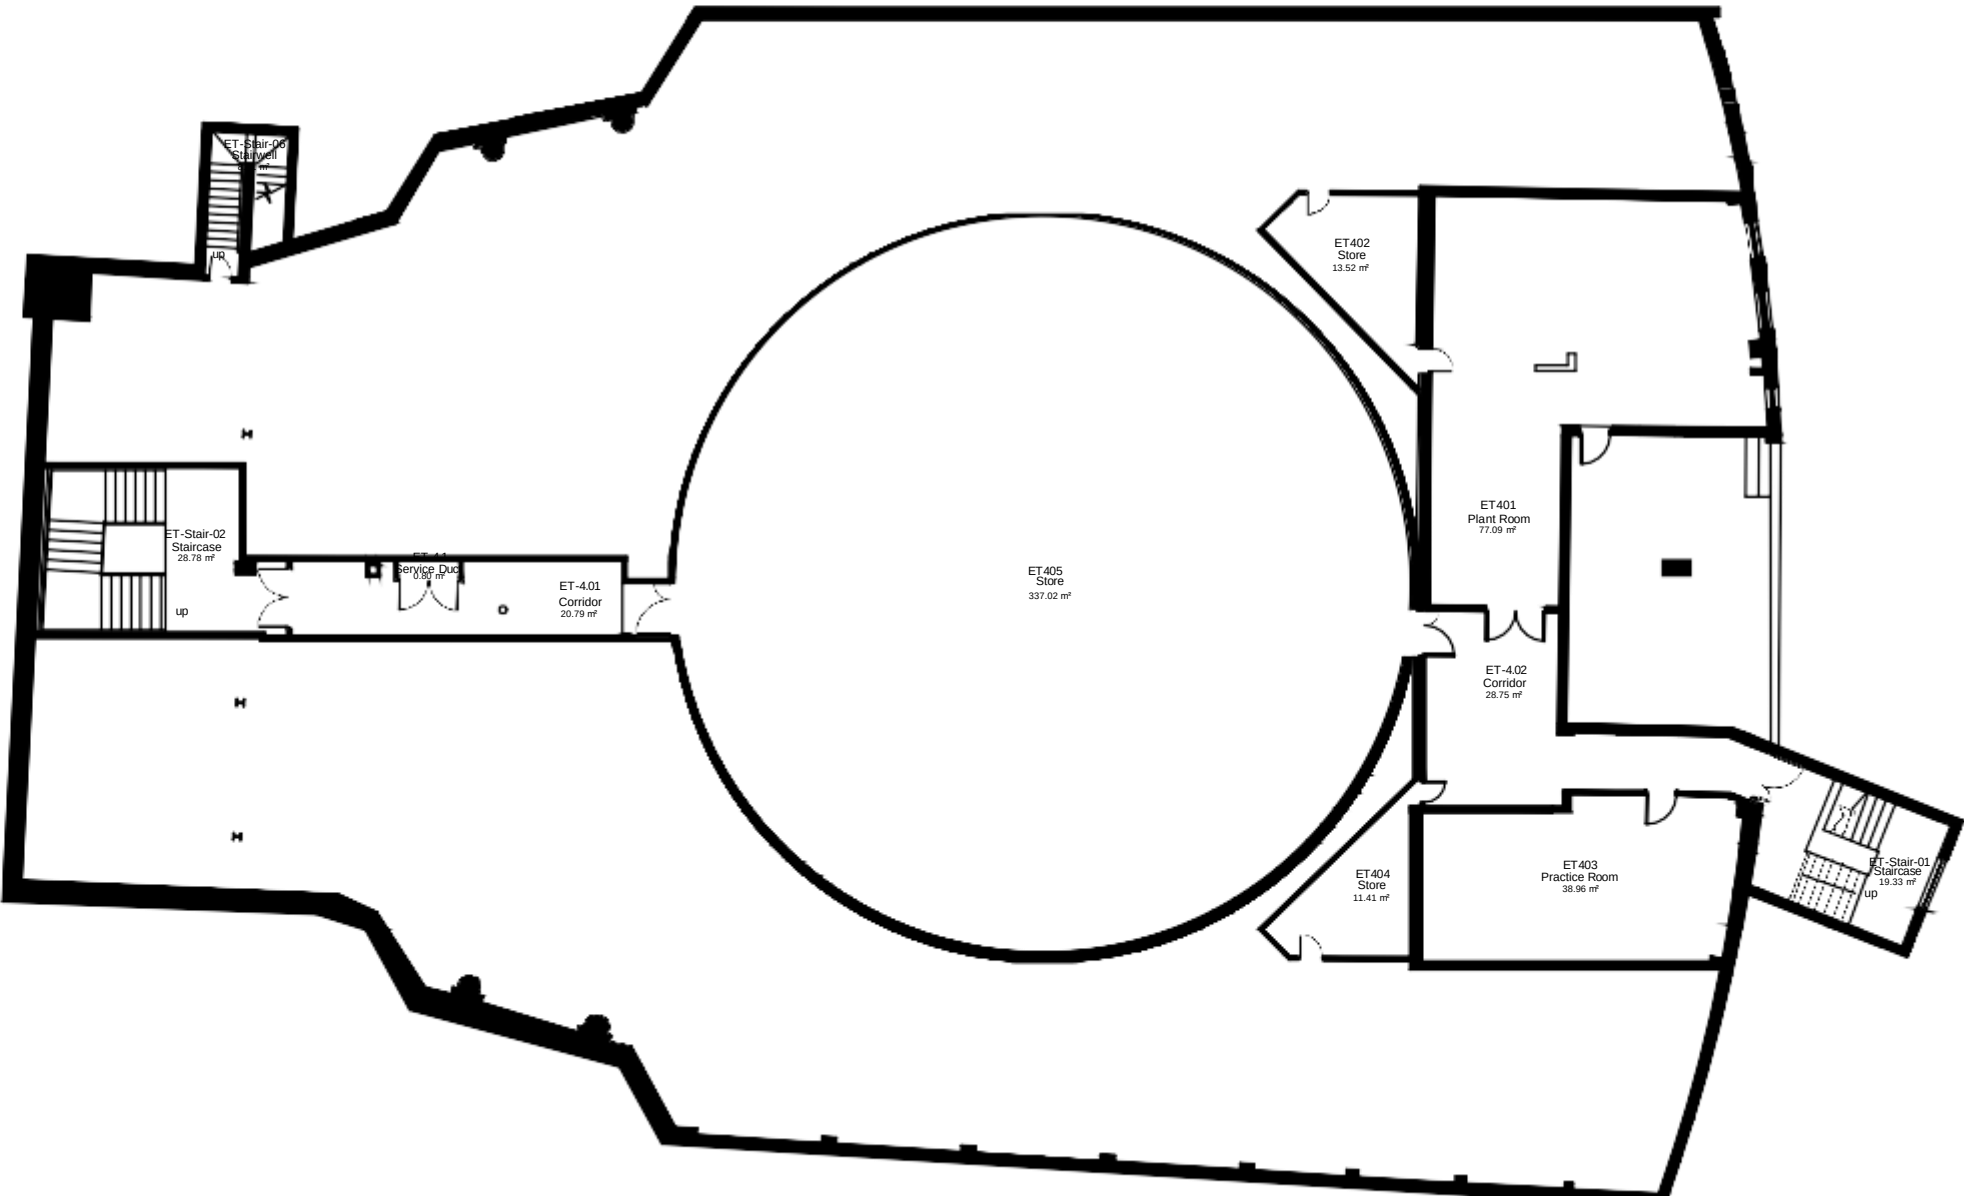


Fourth Floor Plan

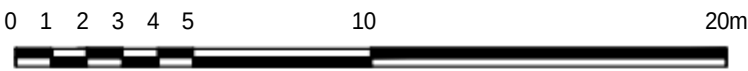

NOTES

This Drawing Is The Copyright Of Coventry University Estates Department & Must Not Be Reproduced Without Their Permission. Figured Dimensions Must Be Taken In Preference To Scaled Dimensions & All Dimensions Must Be Verified On Site Prior To Commencing Any Works.

Rev.	Date	Amendment	DRWN
A	15/03/2018	Drawing amended to match as built floor plan.	EM

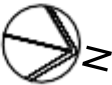

A	15/11/18	GIA = 593.51 m²
Rev.	Date	Amendment



Estates Department
Priory Street, Coventry
CV1 5FB
Tel: 024 76887688
Fax: 024 76887336

CURRENT STATUS			
RECORD DRAWING			
PROJECT			
ELLEN TERRY			
TITLE			
FOURTH FLOOR PLAN			
DRAWN		CHKD	DATE
EM		HS	13/03/2018
SCALE		DRAWING No.	REV.
1/200		ET001-COV-00-04-M2-A	0000