



NOTES

This Drawing Is The Copyright Of Coventry University Estates Department & Must Not Be Reproduced Without Their Permission. Figured Dimensions Must Be Taken In Preference To Scaled Dimensions & All Dimensions Must Be Verified On Site Prior To Commencing Any Works.

AREAS

GIA (Gross Internal Area)	55.07 m²

Rev.	Date	Amendment

Coventry University

Estates Department

Priority Street, Coventry

CV1 5FB

Tel: 024 76887688

Fax: 024 76887336

CURRENT STATUS

RECORD DRAWING

PROJECT


ELM BANK

TITLE

BASEMENT

DRAWN	CHKD	DATE
PC	HS	12/04/2019

SCALE	DRAWING No.	REV.
1/100 @ A1	EB001-COV-00-B-M2-A	0000
1/200 @ A2		

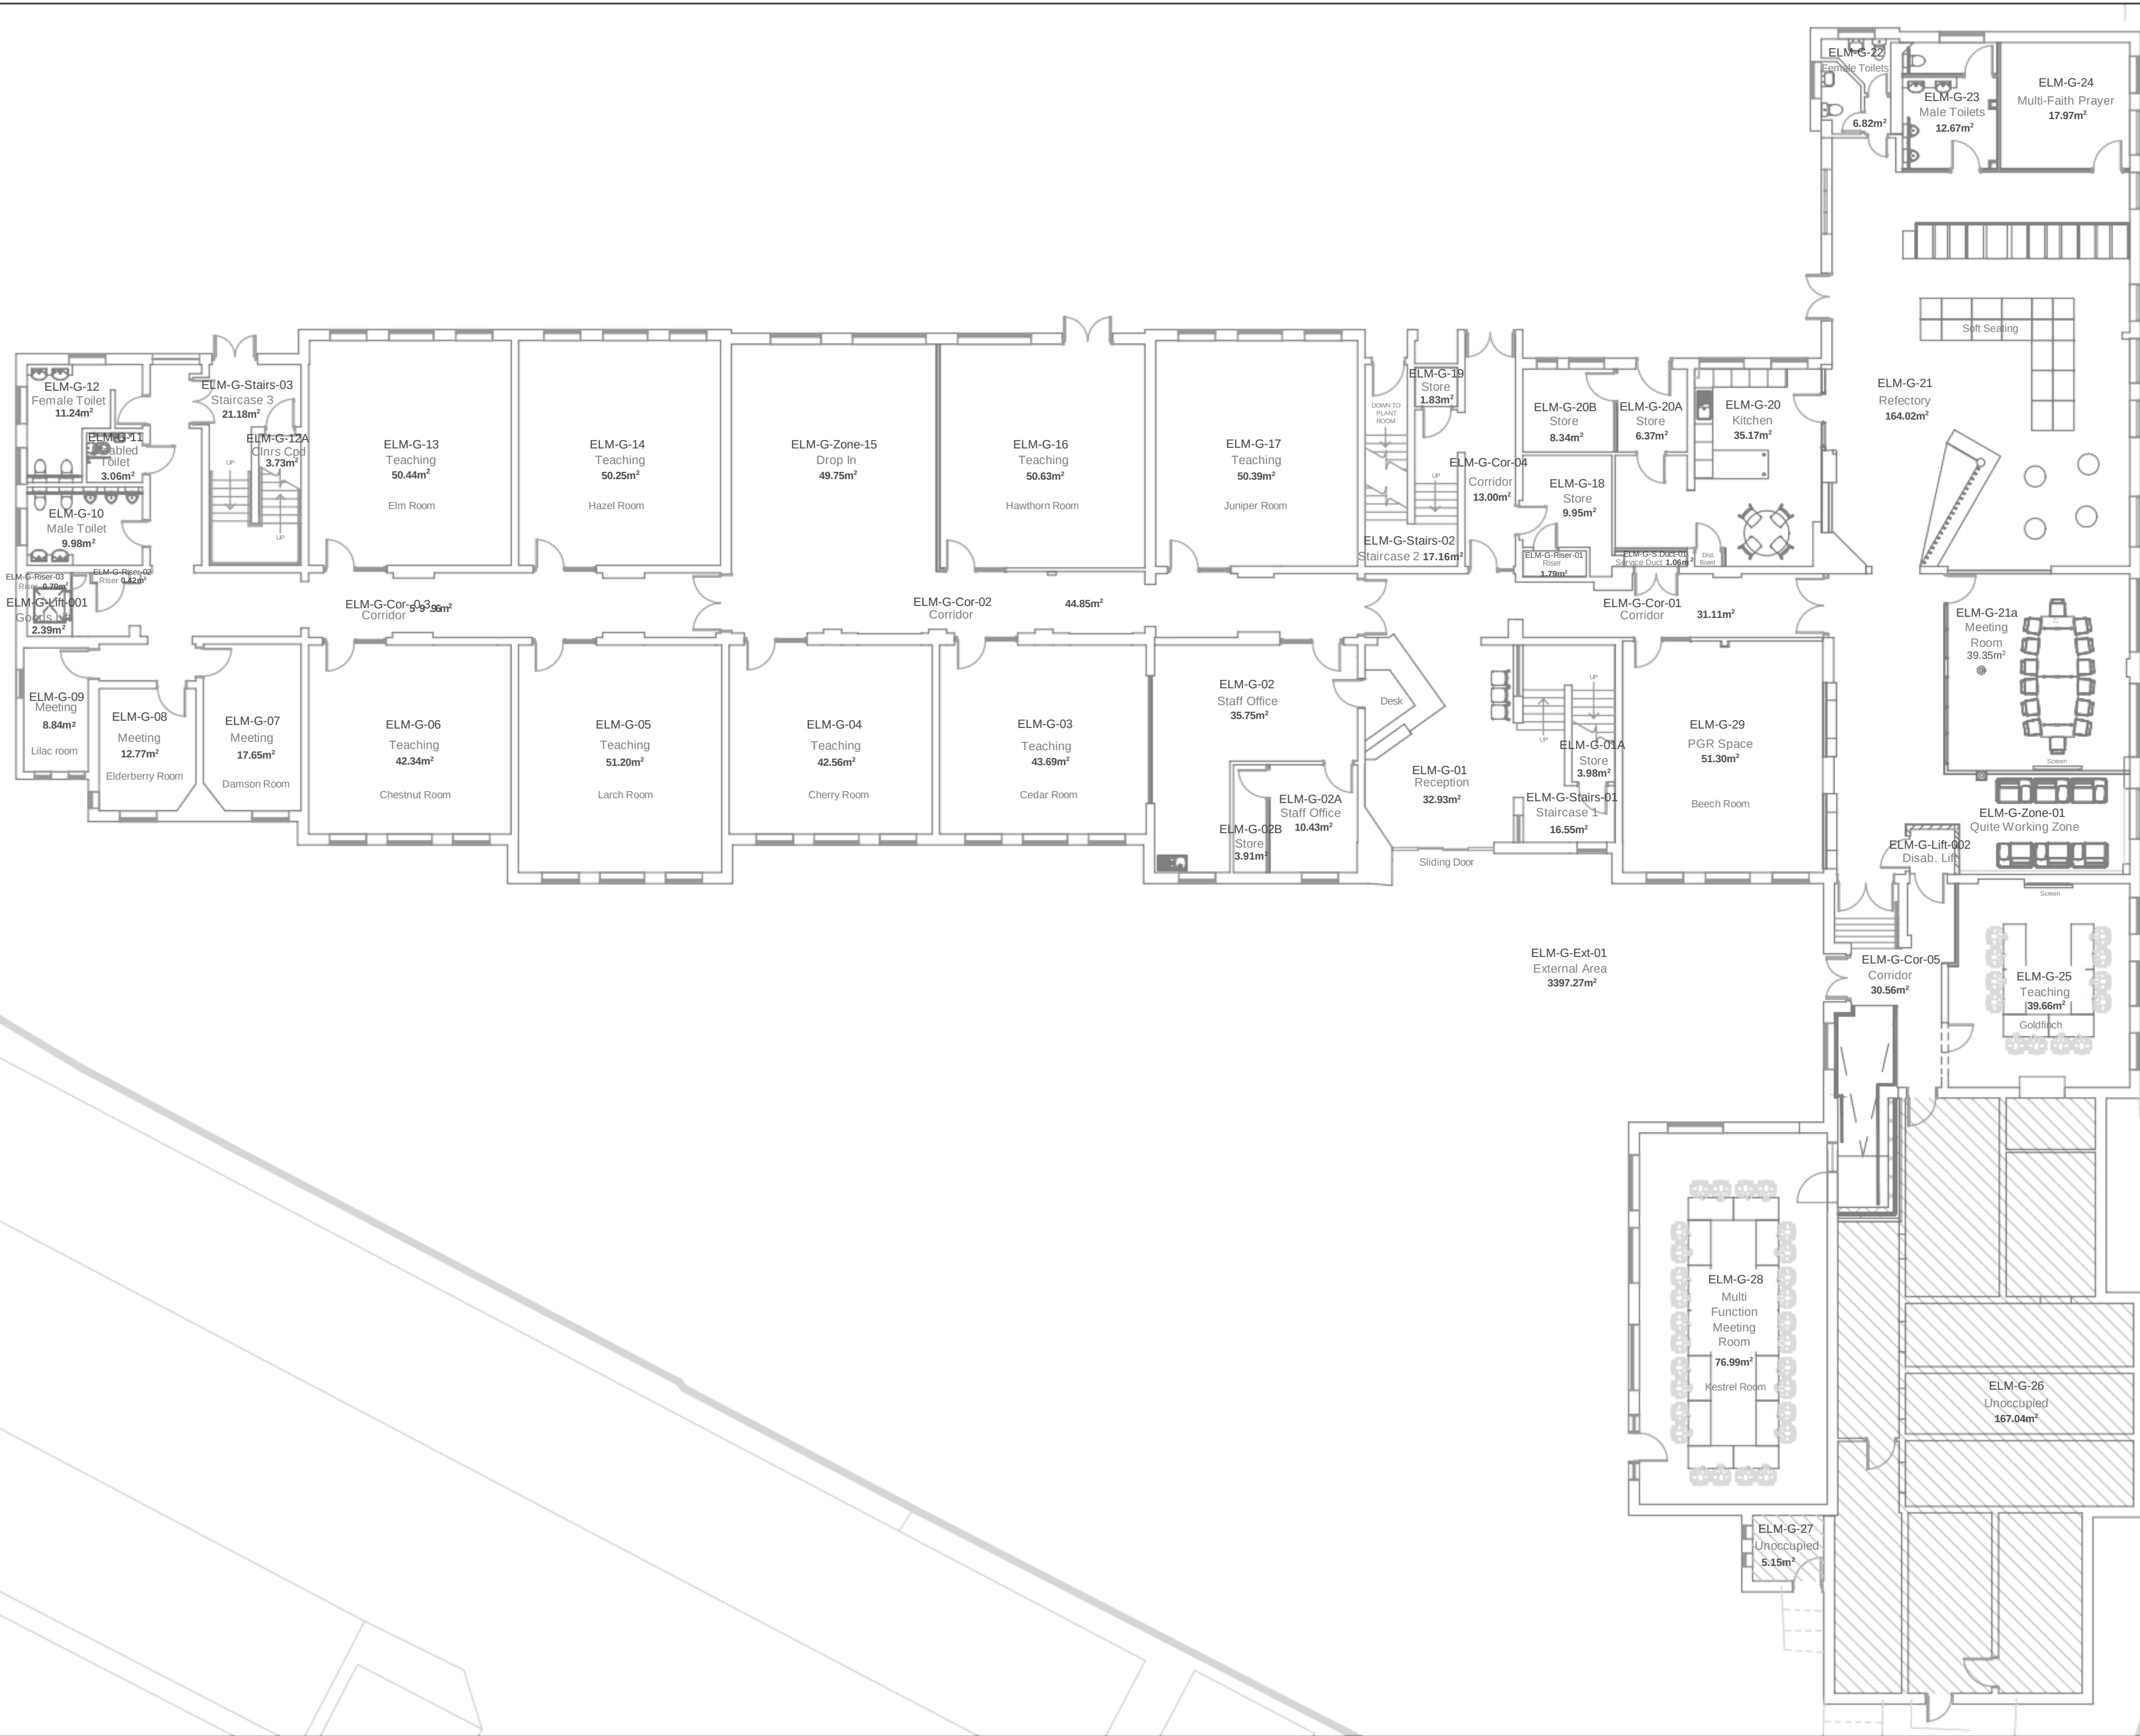

NOTES

This Drawing Is The Copyright Of Coventry University
Estates Department & Must Not Be Reproduced
Without Their Permission. Figured Dimensions Must Be
Taken In Preference To Scaled Dimensions & All
Dimensions Must Be Verified On Site Prior To
Commencing Any Works.

AREAS

GEA (Gross External Area)	1688.77 m ²
GIA (Gross Internal Area)	1414.38 m ²
NIA (Net Internal Area)	1051.20 m ²



Rev.	Date	Amendment
	16/05/22	Changes made following refurbishments of G-20 to G29



Estates Department
Priory Street, Coventry
CV1 5FB
Tel: 024 76887688
Fax: 024 76887336

CURRENT STATUS

RECORD DRAWING


PROJECT

ELM BANK

TITLE

GROUND FLOOR PLAN

DRAWN PC		CHKD HS	DATE 12/04/2019
SCALE 1/100 @ A1 1/200 @ A2		DRAWING No. EB001-COV-00-GF-M2-A	REV. A

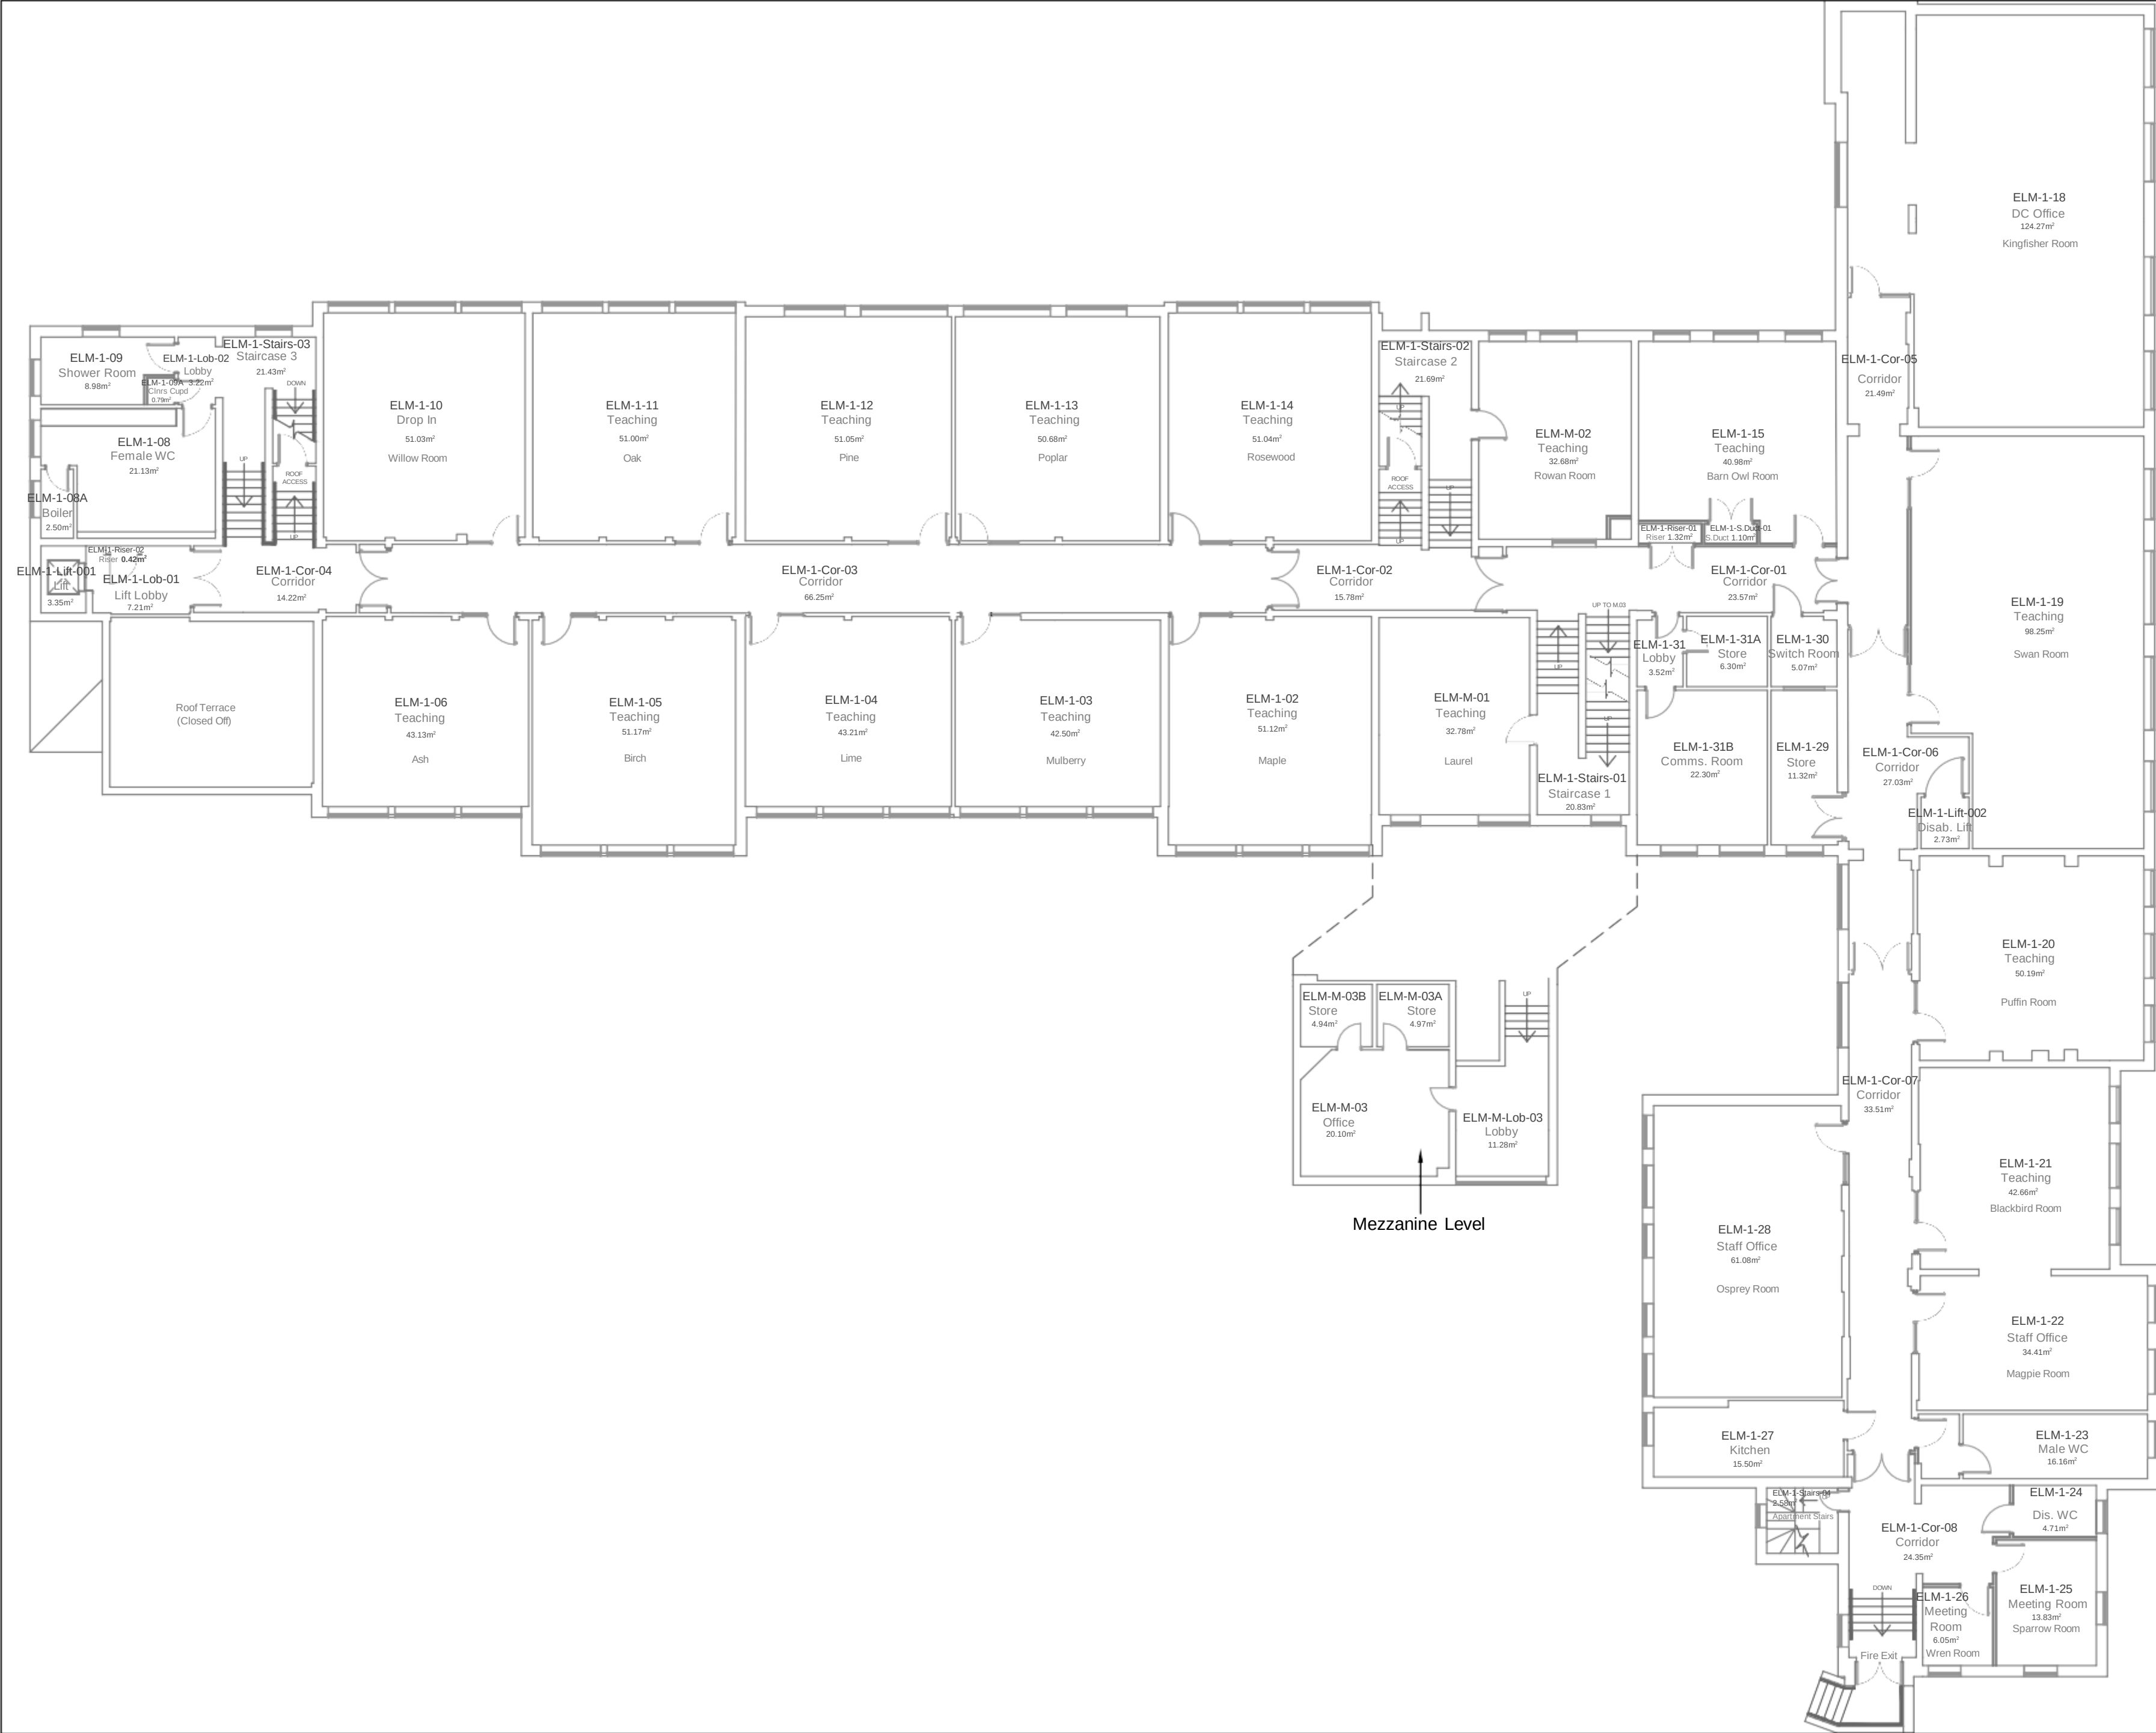

NOTES

This Drawing is The Copyright Of Coventry University Estates Department & Must Not Be Reproduced Without Their Permission. Figured Dimensions Must Be Taken in Preference To Scaled Dimensions & All Dimensions Must Be Verified On Site Prior To Commencing Any Works.

AREAS

GEA (Gross External Area)	1643.38 m²
GIA (Gross Internal Area)	1584.03 m²
NIA (Net Internal Area)	1094.01 m²

A	16/05/22	1-18 Enlarged. Gap made between 1-21 & 1-22
Rev.	Date	Amendment

Estates Department
Priory Street, Coventry
CV1 5PB
Tel: 024 76887688
Fax: 024 76887336

CURRENT STATUS

RECORD DRAWING

PROJECT

ELM BANK

TITLE

FIRST FLOOR PLAN

DRAWN	PC	CHKD	HS	DATE	12/04/2019
SCALE	1/100 @ A1	DRAWING No.	EB001-COV-00-01-M2-A	REV.	A
	1/200 @ A2				



NOTES

This Drawing Is The Copyright Of Coventry University
Estates Department & Must Not Be Reproduced
Without Their Permission. Figured Dimensions Must Be
Taken In Preference To Scaled Dimensions & All
Dimensions Must Be Verified On Site Prior To
Commencing Any Works.

AREAS

GIA (Gross Internal Area)	112.44 m²

Rev.	Date	Amendment

Estates Department
Priority Street, Coventry
CV1 5FB
Tel: 024 76887688
Fax: 024 76887336

CURRENT STATUS

RECORD DRAWING

PROJECT

ELM BANK

TITLE

SECOND FLOOR PLAN

DRAWN	CHKD	DATE
PC	HS	12/04/2019

SCALE	DRAWING No.	REV.
1/100 @ A1 1/200 @ A2	XX001-COV-00-B-02-A	0000