

## NOTES

This Drawing Is The Copyright Of Coventry University Estates Department & Must Not Be Reproduced Without Their Permission. Figured Dimensions Must Be Taken In Preference To Scaled Dimensions & All Dimensions Must Be Verified On Site Prior To Commencing Any Works.

## AREAS


GEA (Gross External Area)	3248.22 m <sup>2</sup>
GIA (Gross Internal Area)	3141.00 m <sup>2</sup>
NIA (Net Internal Area)	1607.71 m <sup>2</sup>



## Service Spine AREAS

GEA (Gross External Area)	
GIA (Gross Internal Area)	266.11 m <sup>2</sup>
NIA (Net Internal Area)	110.92 m <sup>2</sup>

## Service Area

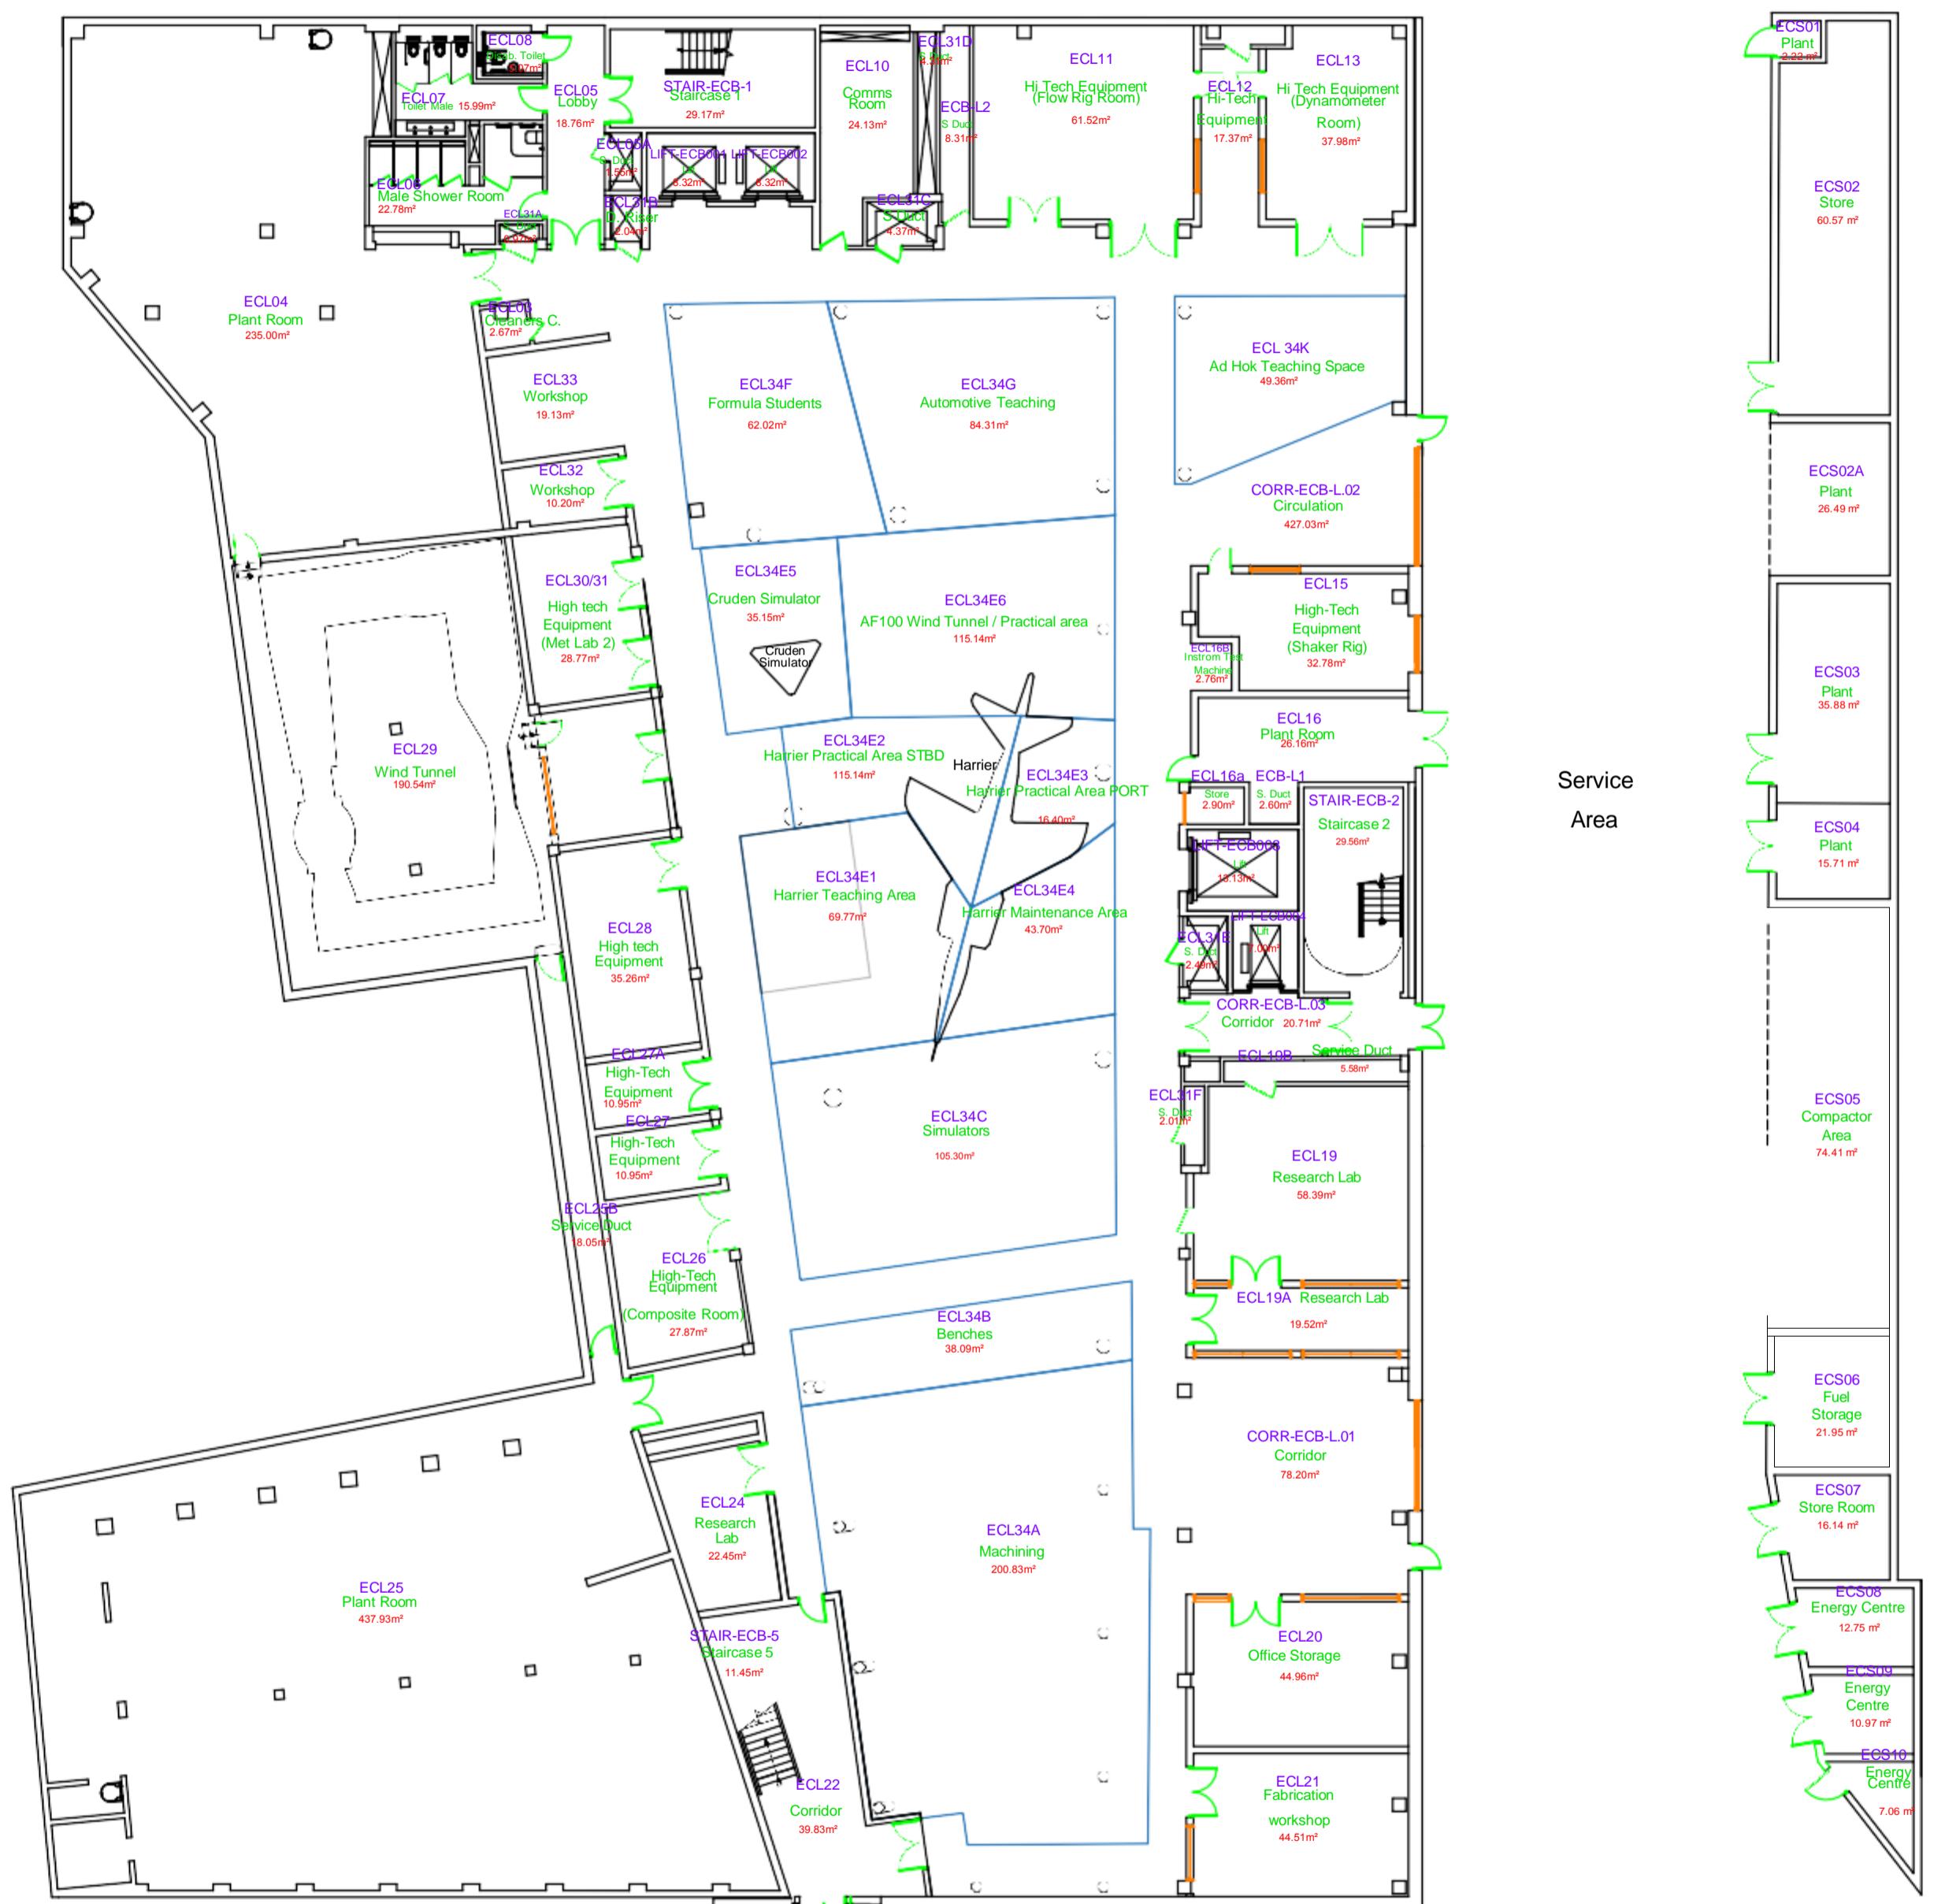

0 1 2 3 4 5 10 20m

B 10/03/20 2 NEW SPACES ADDED AND OTHERS REDRAWN AROUND HARRIER  
A 26/06/19 HPEC DIVIDED INTO SMALLER SPACES. ENERGY CENTRE SPACES ADDED  
Rev. Date Amendment



Coventry  
University

Estates Department  
Perry Street, Coventry  
CV1 5FB  
Tel: 024 76887688  
Fax: 024 76887336


## CURRENT STATUS

## RECORD DRAWING

PROJECT	ENGINEERING & COMPUTING BUILDING
TITLE	LOWER GROUND FLOOR PLAN

DRAWN PC	CHKD HS	DATE
		10/03/2020

SCALE	1/150 @ A1 1/300 @ A2	DRAWING No.	XX001-COV-00-LG-M2-A	REV.
-------	--------------------------	-------------	----------------------	------

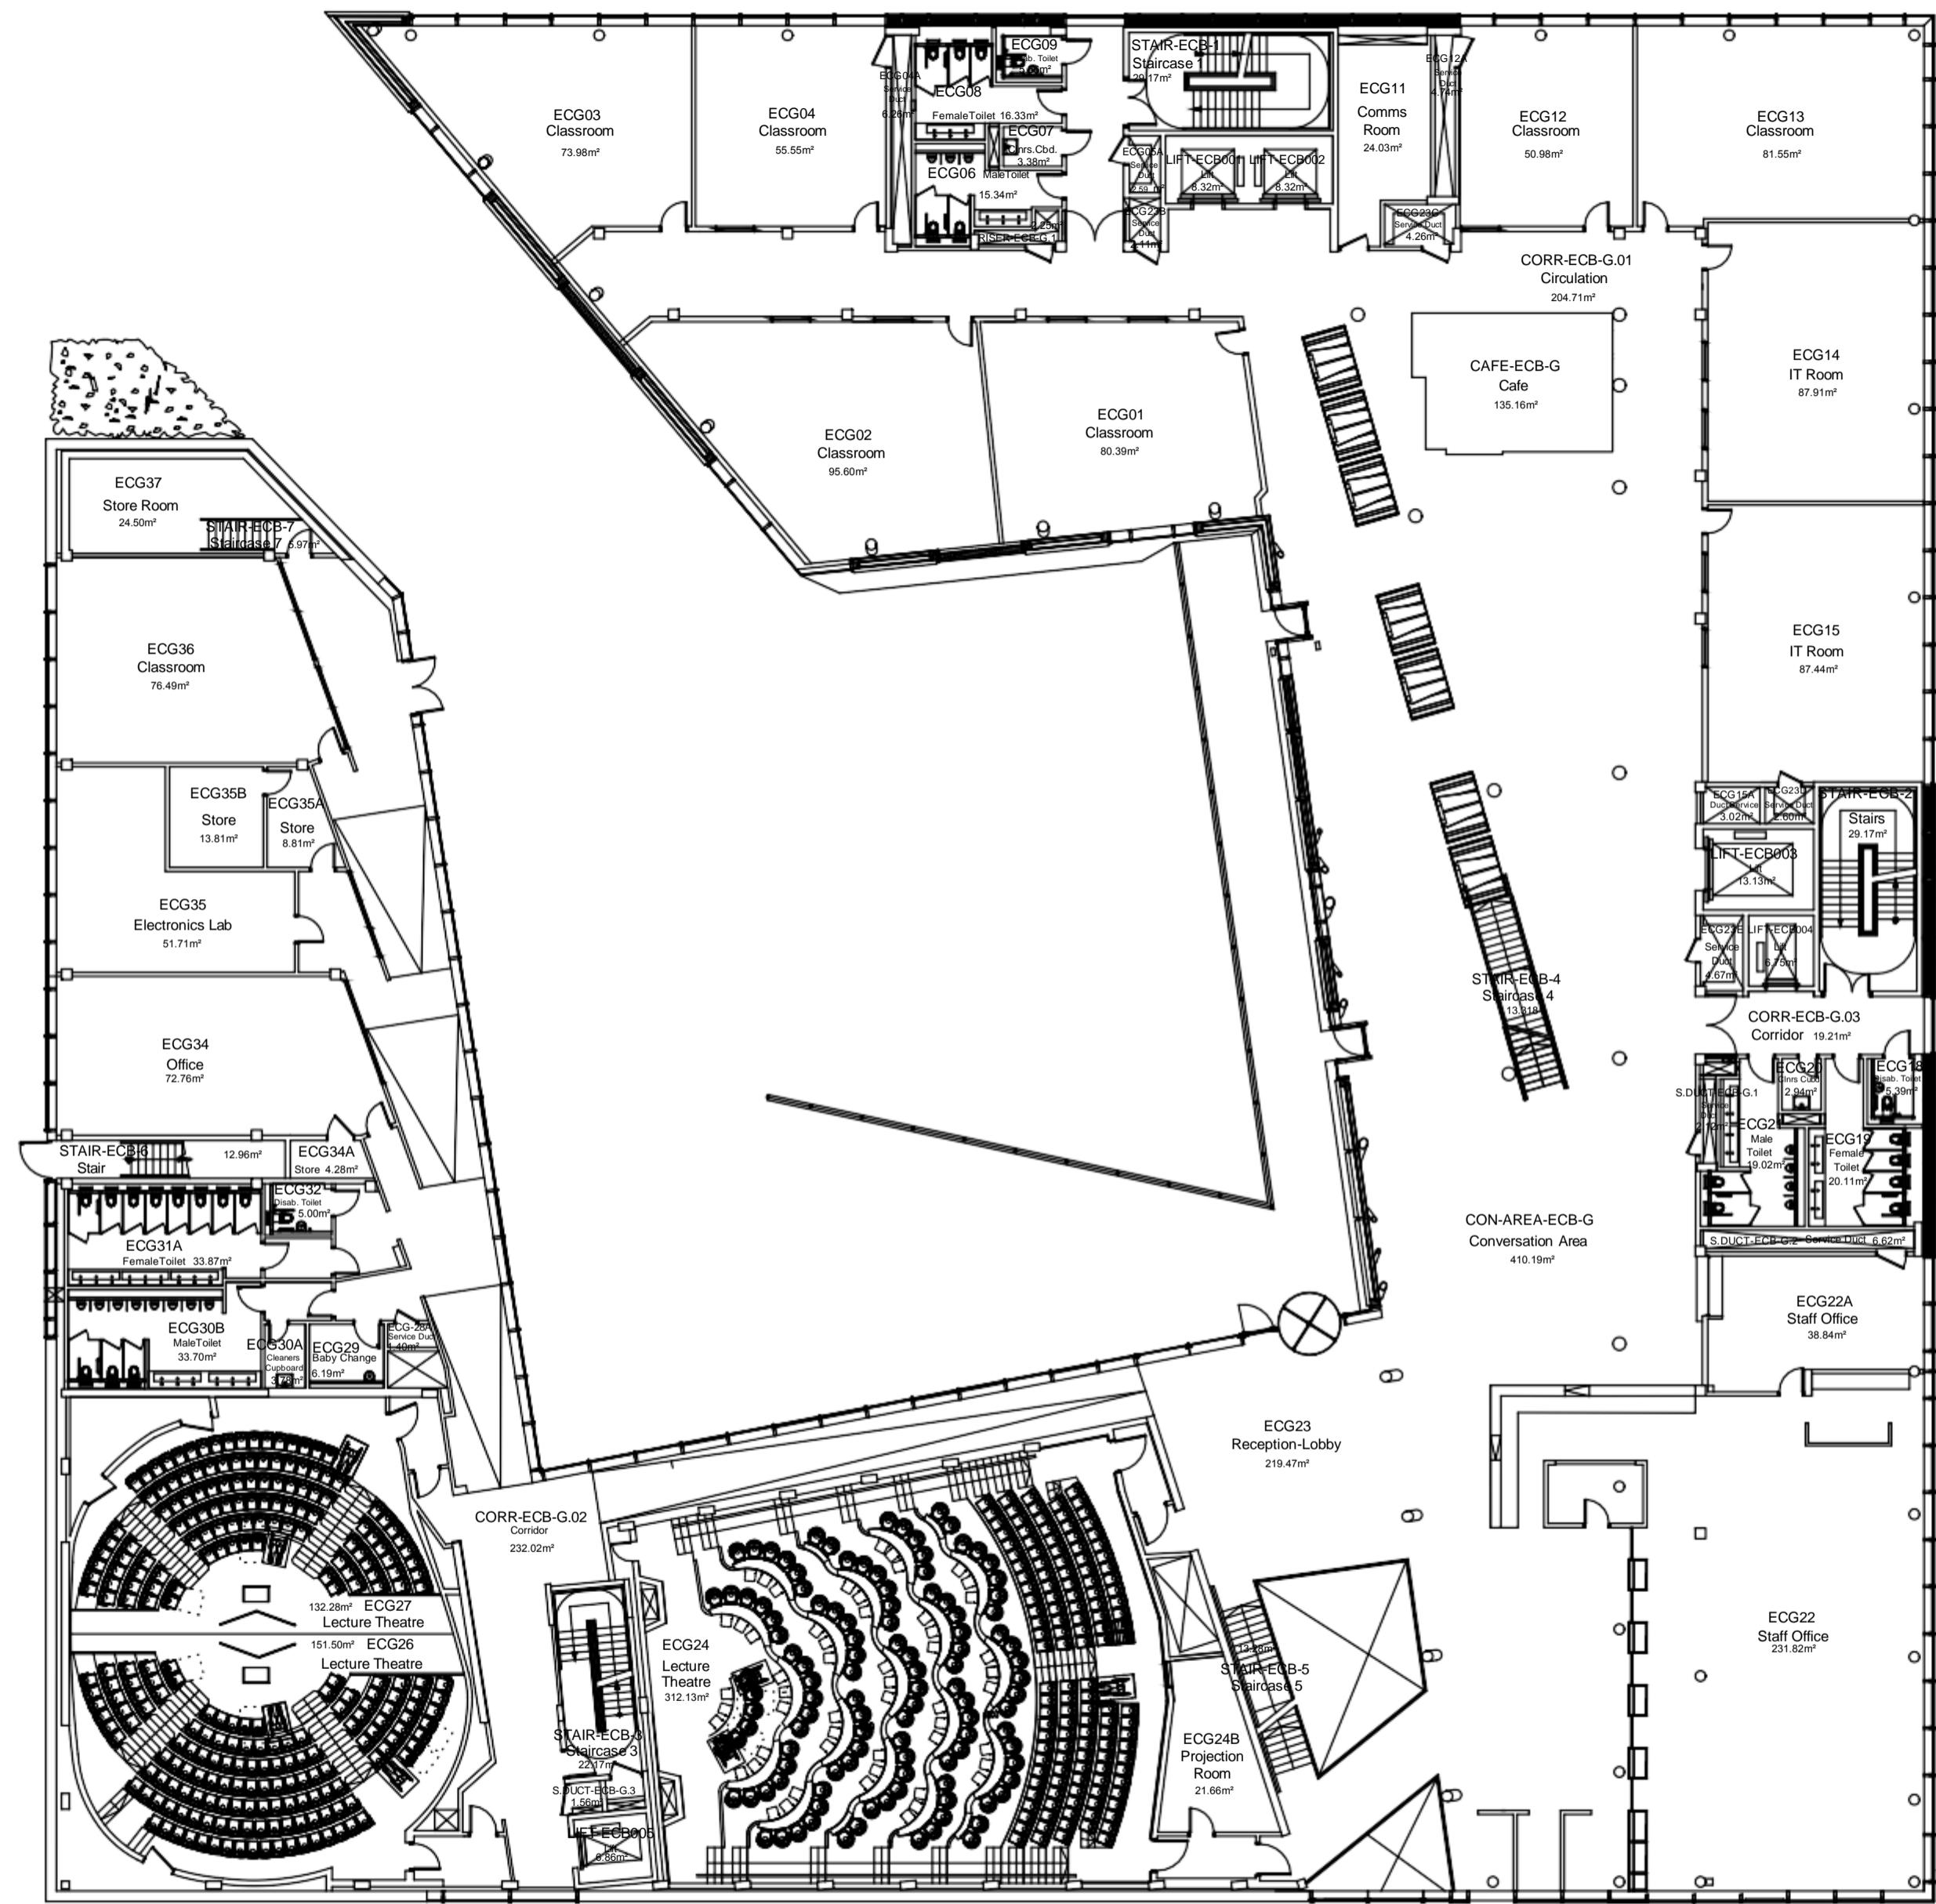

Upper Ground Floor

0 1 2 3 4 5 10 20m

**NOTES**  
This Drawing Is The Copyright Of Coventry University Estates Department & Must Not Be Reproduced Without Their Permission. Figured Dimensions Must Be Taken In Preference To Scaled Dimensions & All Dimensions Must Be Verified On Site Prior To Commencing Any Works.

**AREAS**

GIA (Gross Internal Area)	3569.10 m <sup>2</sup>
GEA (Gross External Area)	3816.23 m <sup>2</sup>



Rev. Date Amendment



**Coventry  
University**

Estates Department  
Priory Street, Coventry  
CV1 5FB  
Tel: 024 76887688  
Fax: 024 76887336

**CURRENT STATUS**


**RECORD DRAWING**

**PROJECT**  
ENGINEERING AND COMPUTING  
BUILDING

**TITLE**  
UPPER GROUND FLOOR PLAN

**DRAWN** PC **CHKD** HS **DATE** 24/07/2018

**SCALE** 1/150 @ A1 1/300 @ A2 **DRAWING No.** XX001-COV-00-UG-M2-A **REV.** 0000

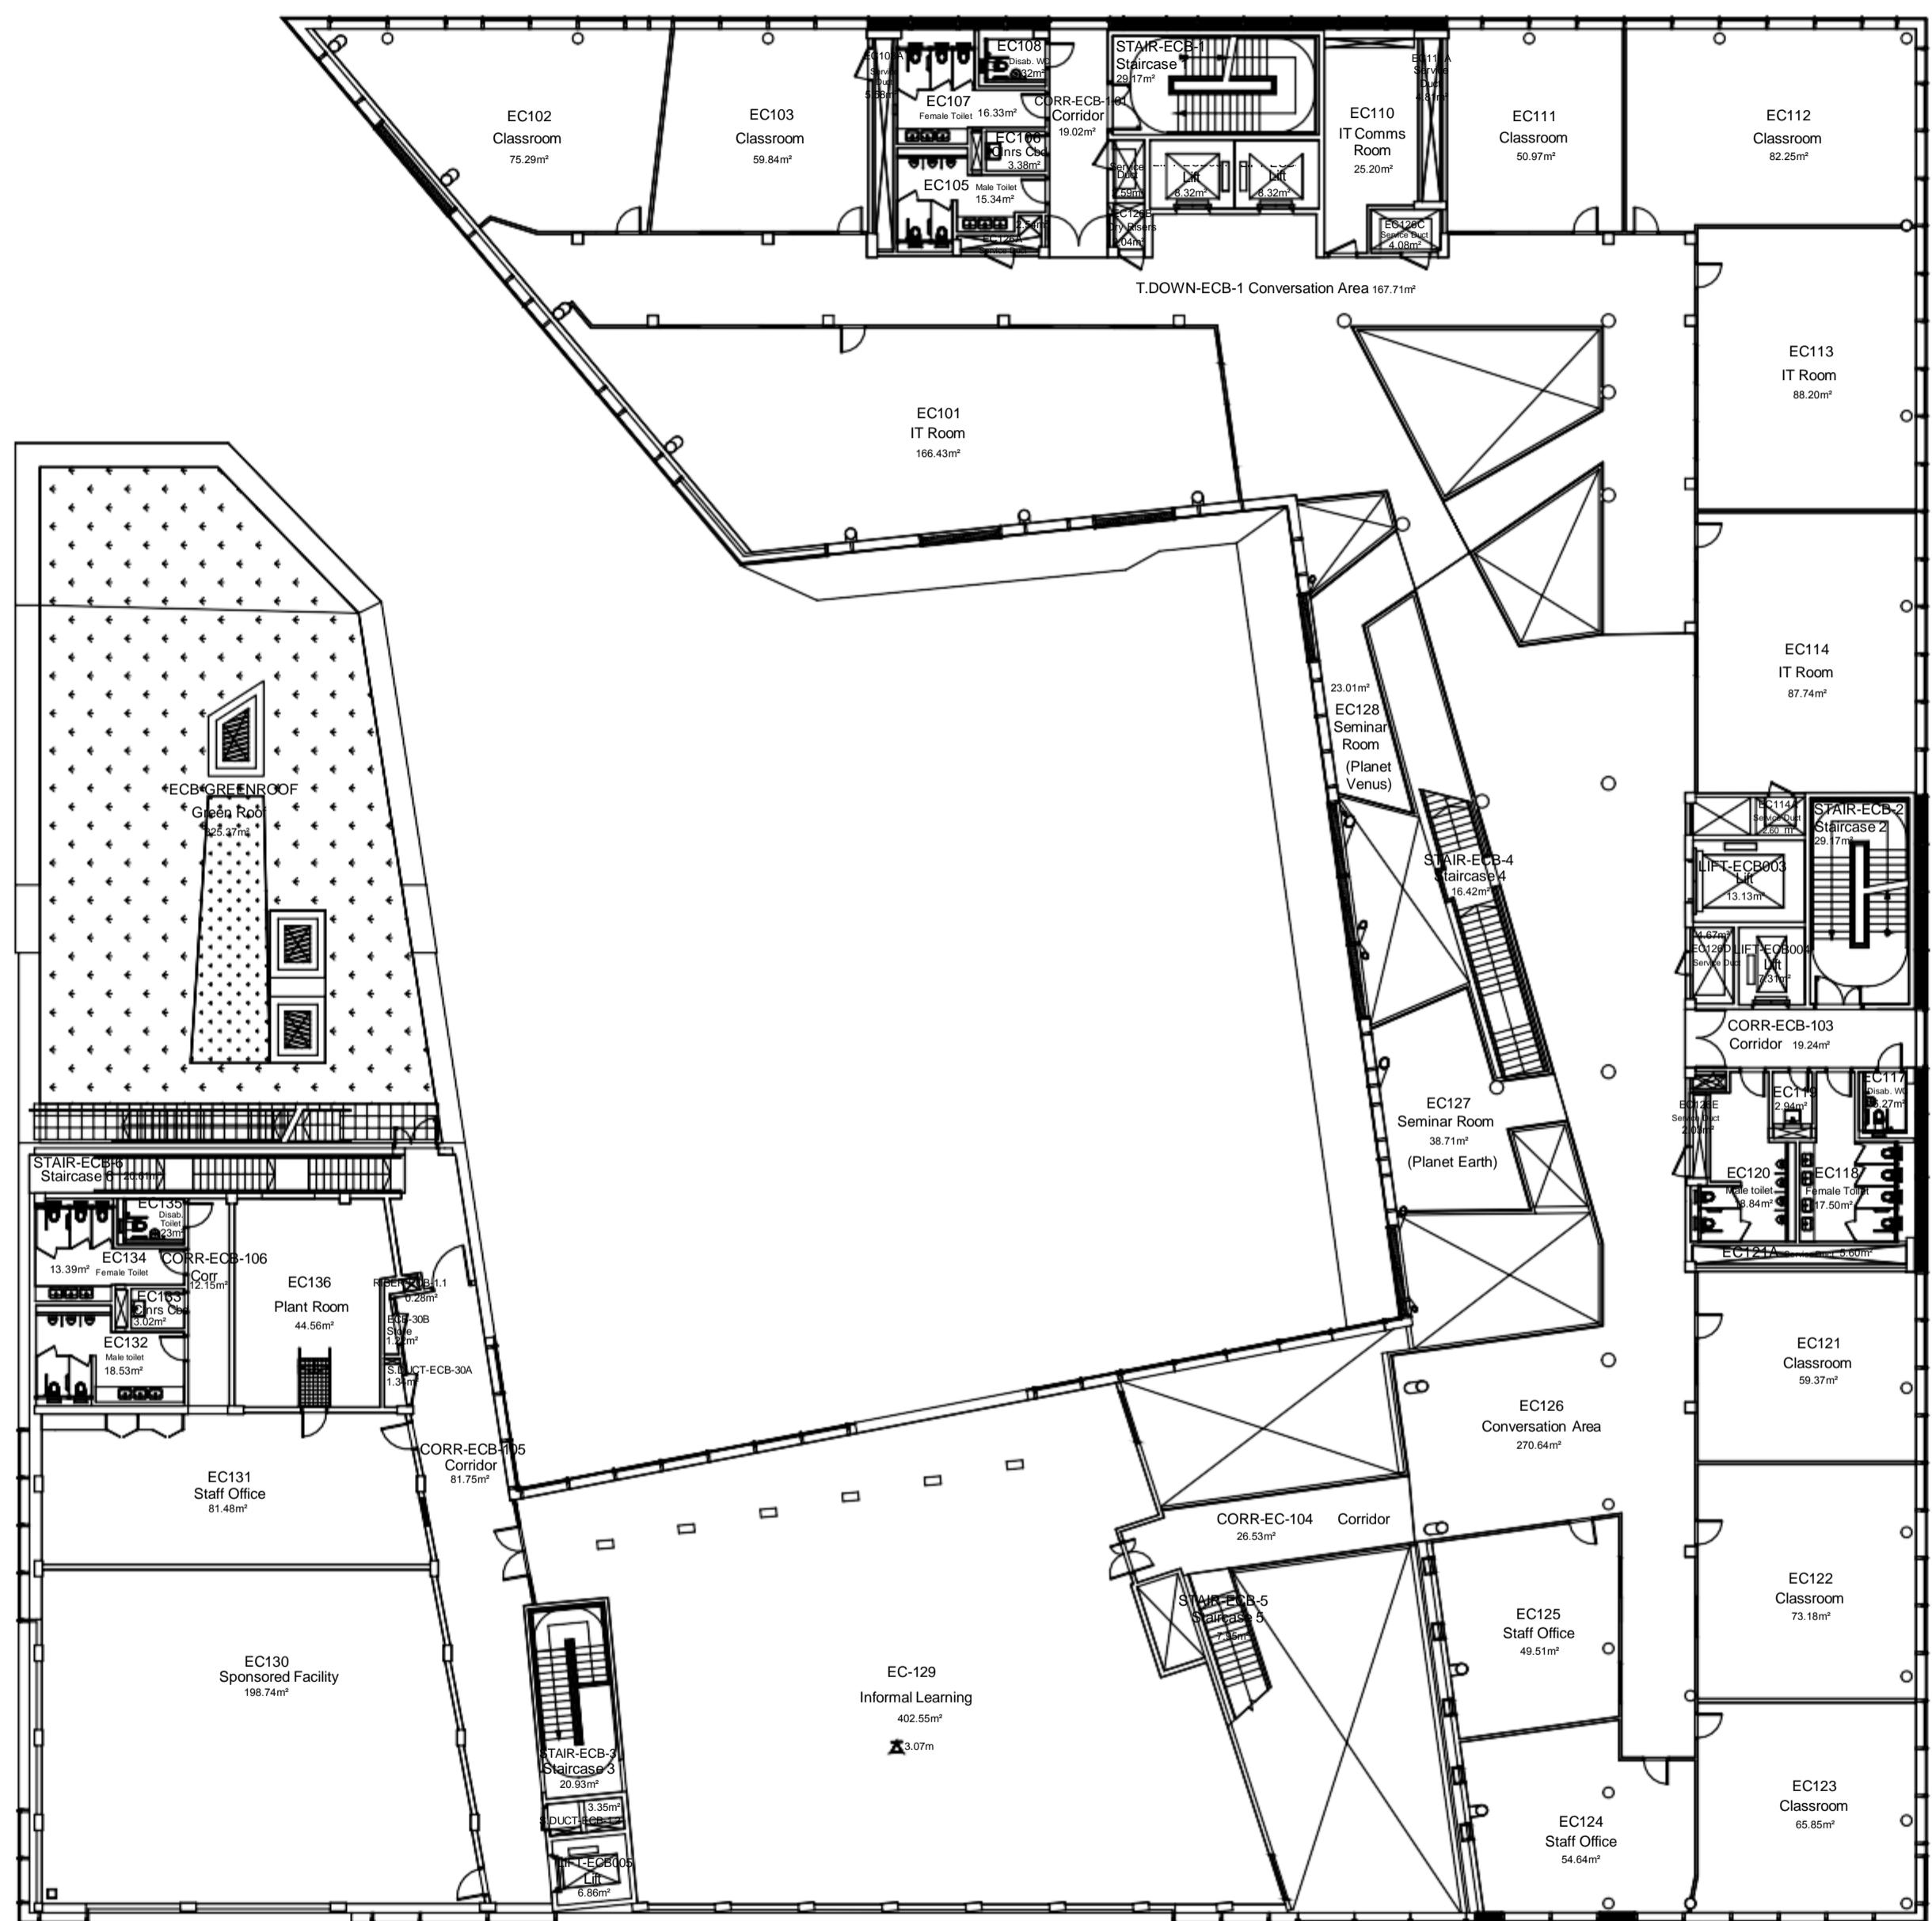

First Floor

0 1 2 3 4 5 10 20m

**NOTES**  
This Drawing Is The Copyright Of Coventry University Estates Department & Must Not Be Reproduced Without Their Permission. Figured Dimensions Must Be Taken In Preference To Scaled Dimensions & All Dimensions Must Be Verified On Site Prior To Commencing Any Works.

**AREAS**

GEA (Gross External Area)	3750.92 m <sup>2</sup>
GIA (Gross Internal Area)	2979.33 m <sup>2</sup>
NIA (Net Internal Area)	1726.50 m <sup>2</sup>



B 21/12/23 EC130 amended and EC131 added. KA  
A 19/07/22 CORR ECB-1.02 CHANGED TO T.DOWN-ECB-1

Rev. Date Amendment



**Coventry  
University**

Estates Department  
Priory Street, Coventry  
CV1 5FB  
Tel: 024 76887688  
Fax: 024 76887336

**CURRENT STATUS**


**RECORD DRAWING**

**PROJECT**  
ENGINEERING & COMPUTING  
BUILDING

**TITLE**  
FIRST FLOOR PLAN

**DRAWN** KA **CHKD** DATE 24/07/2018

**SCALE** 1/150 @ A1 **DRAWING No.** XX001-COV-00-01-M2-A **REV.** A  
1/300 @ A2

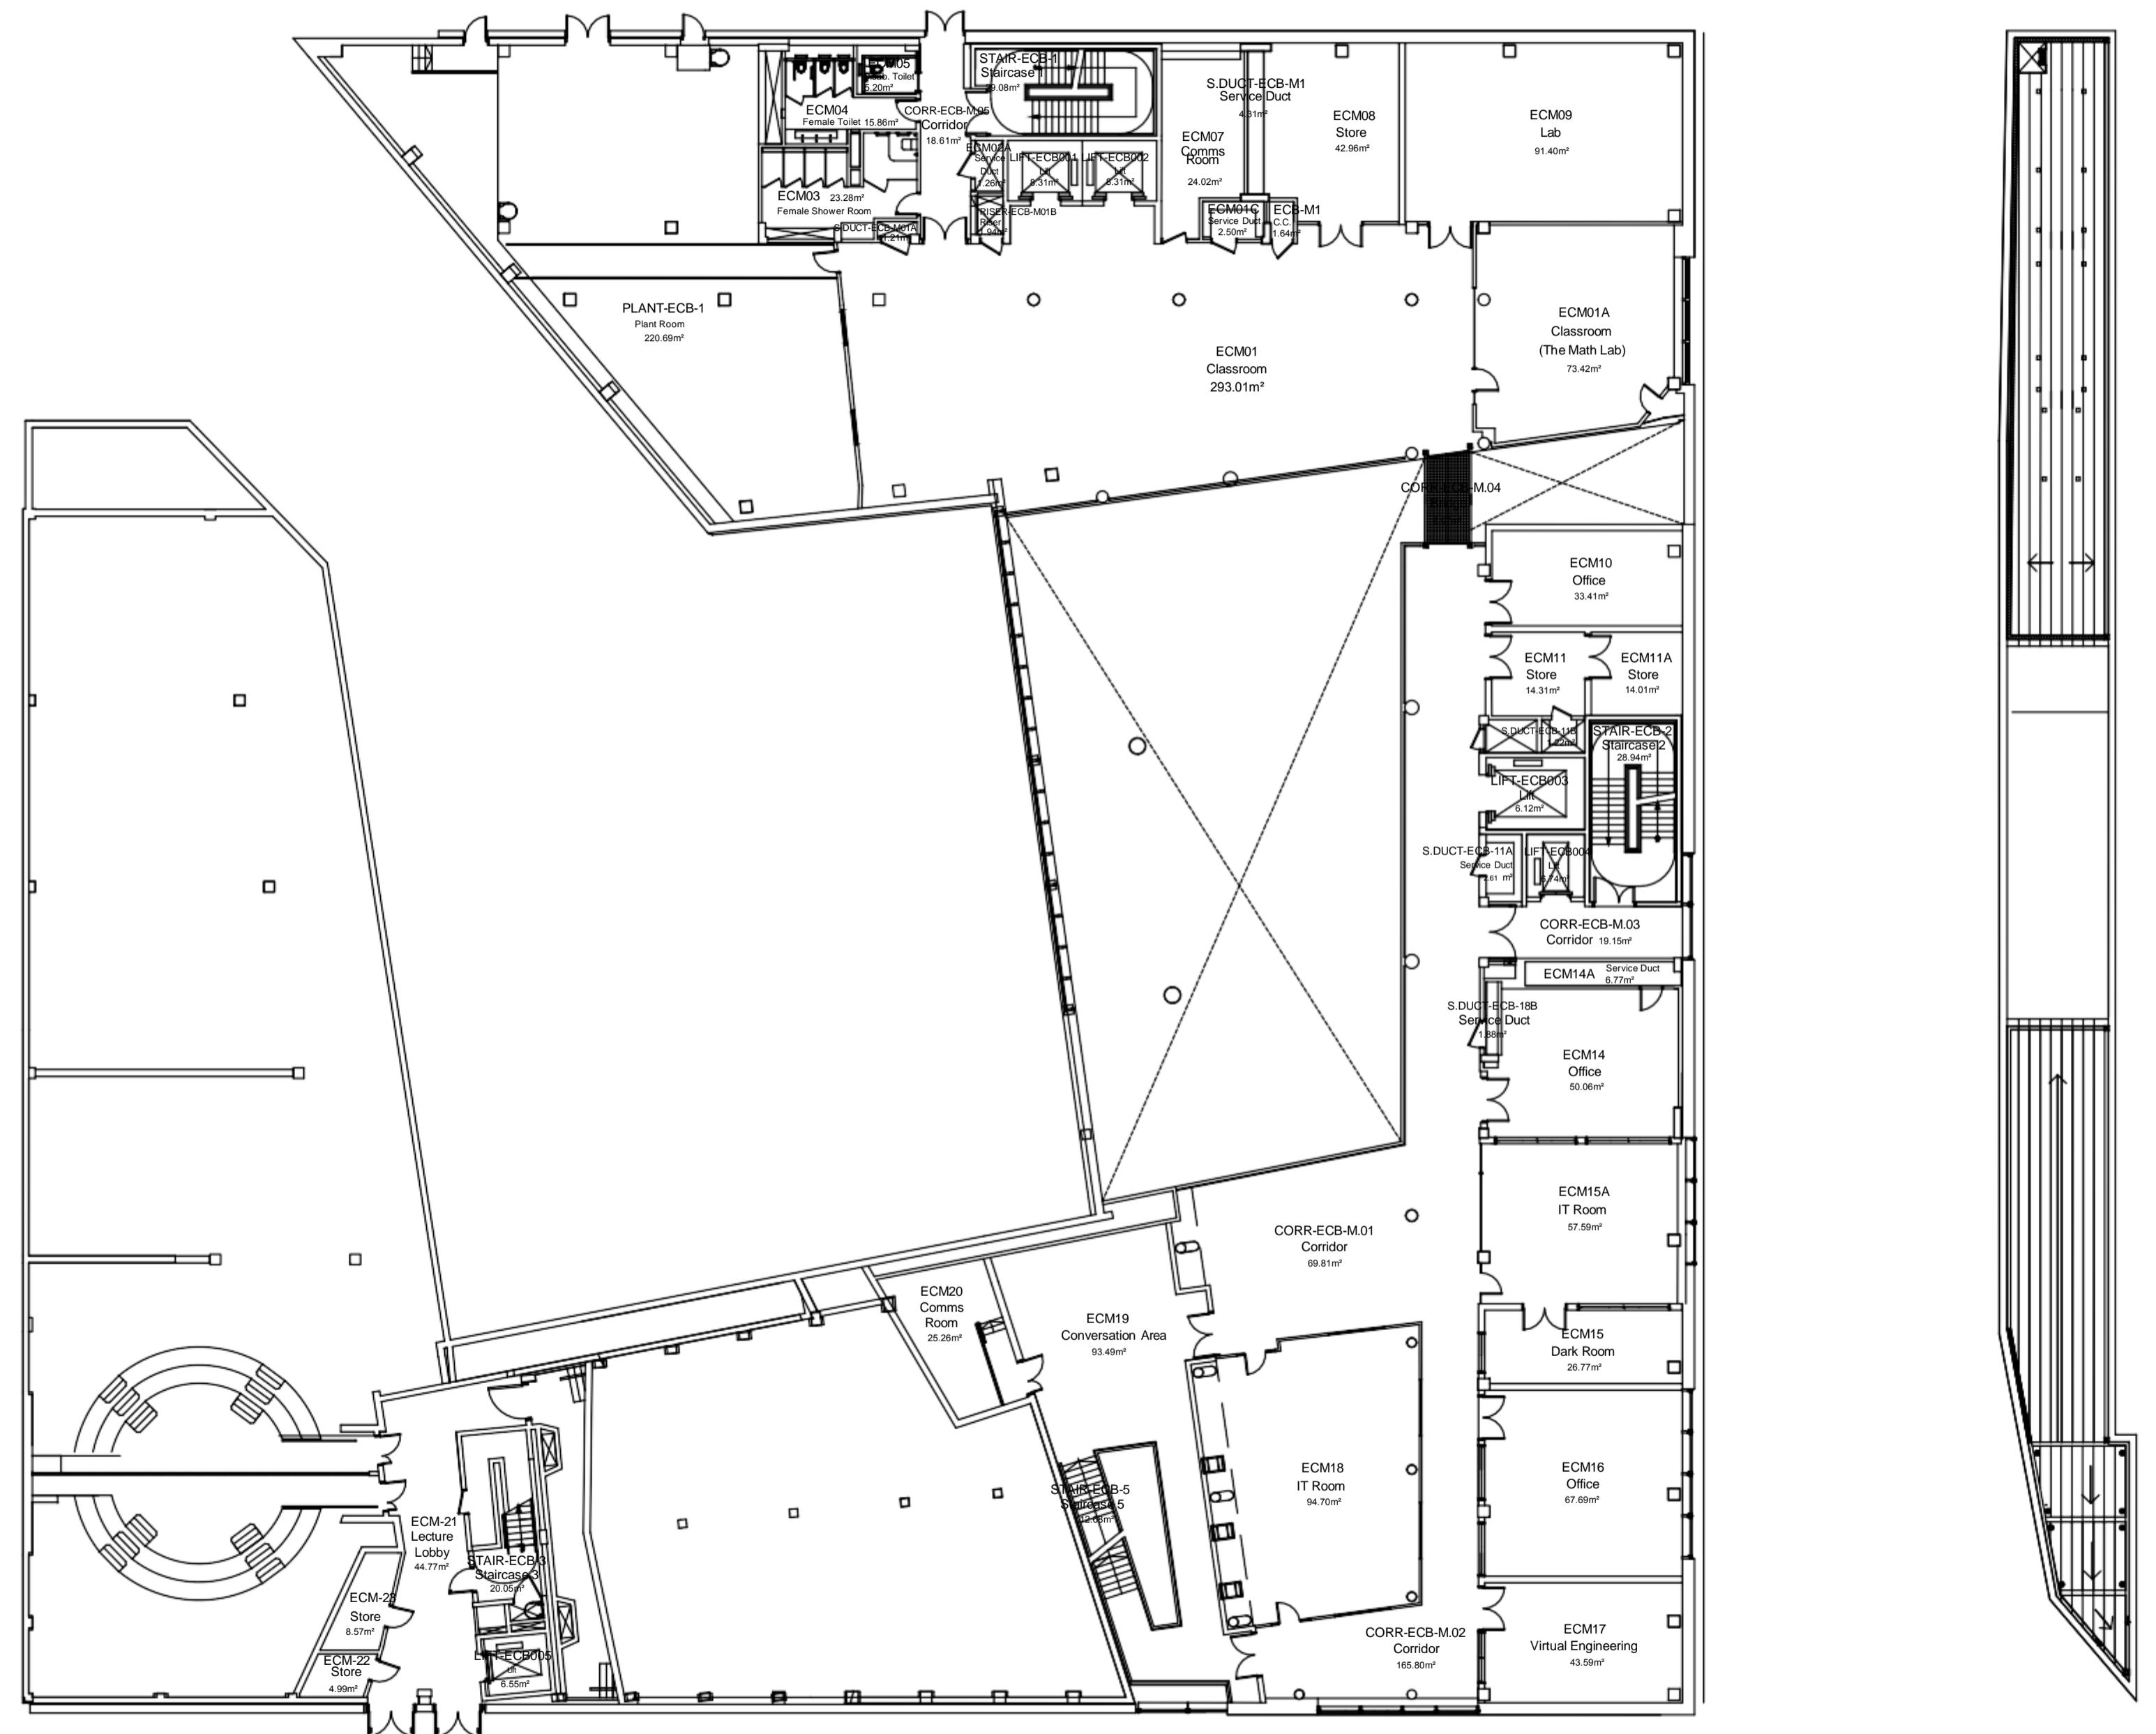

Mezzanine Floor

NOTES


This Drawing Is The Copyright Of Coventry University Estates Department & Must Not Be Reproduced Without Their Permission. Figured Dimensions Must Be Taken In Preference To Scaled Dimensions & All Dimensions Must Be Verified On Site Prior To Commencing Any Works.

AREAS

GIA (Gross Internal Area)	2804.26m <sup>2</sup>
GEA (Gross External Area)	3868.81 m <sup>2</sup>



Rev.	Date	Amendment
 <b>Coventry University</b>		
Estates Department Phry Street, Coventry CV1 5FB Tel: 024 76887688 Fax: 024 76887336		
CURRENT STATUS		
RECORD DRAWING		
PROJECT		
ENGINEERING AND COMPUTING		
BUILDING		
TITLE		
MEZZANINE FLOOR PLAN		
DRAWN	PC	CHKD
HS		DATE
		25/07/2018
SCALE		
1/150 @ A1		DRAWING No.
1/300 @ A2		XX001-COV-00-MF-M2-A
		REV.
		0000

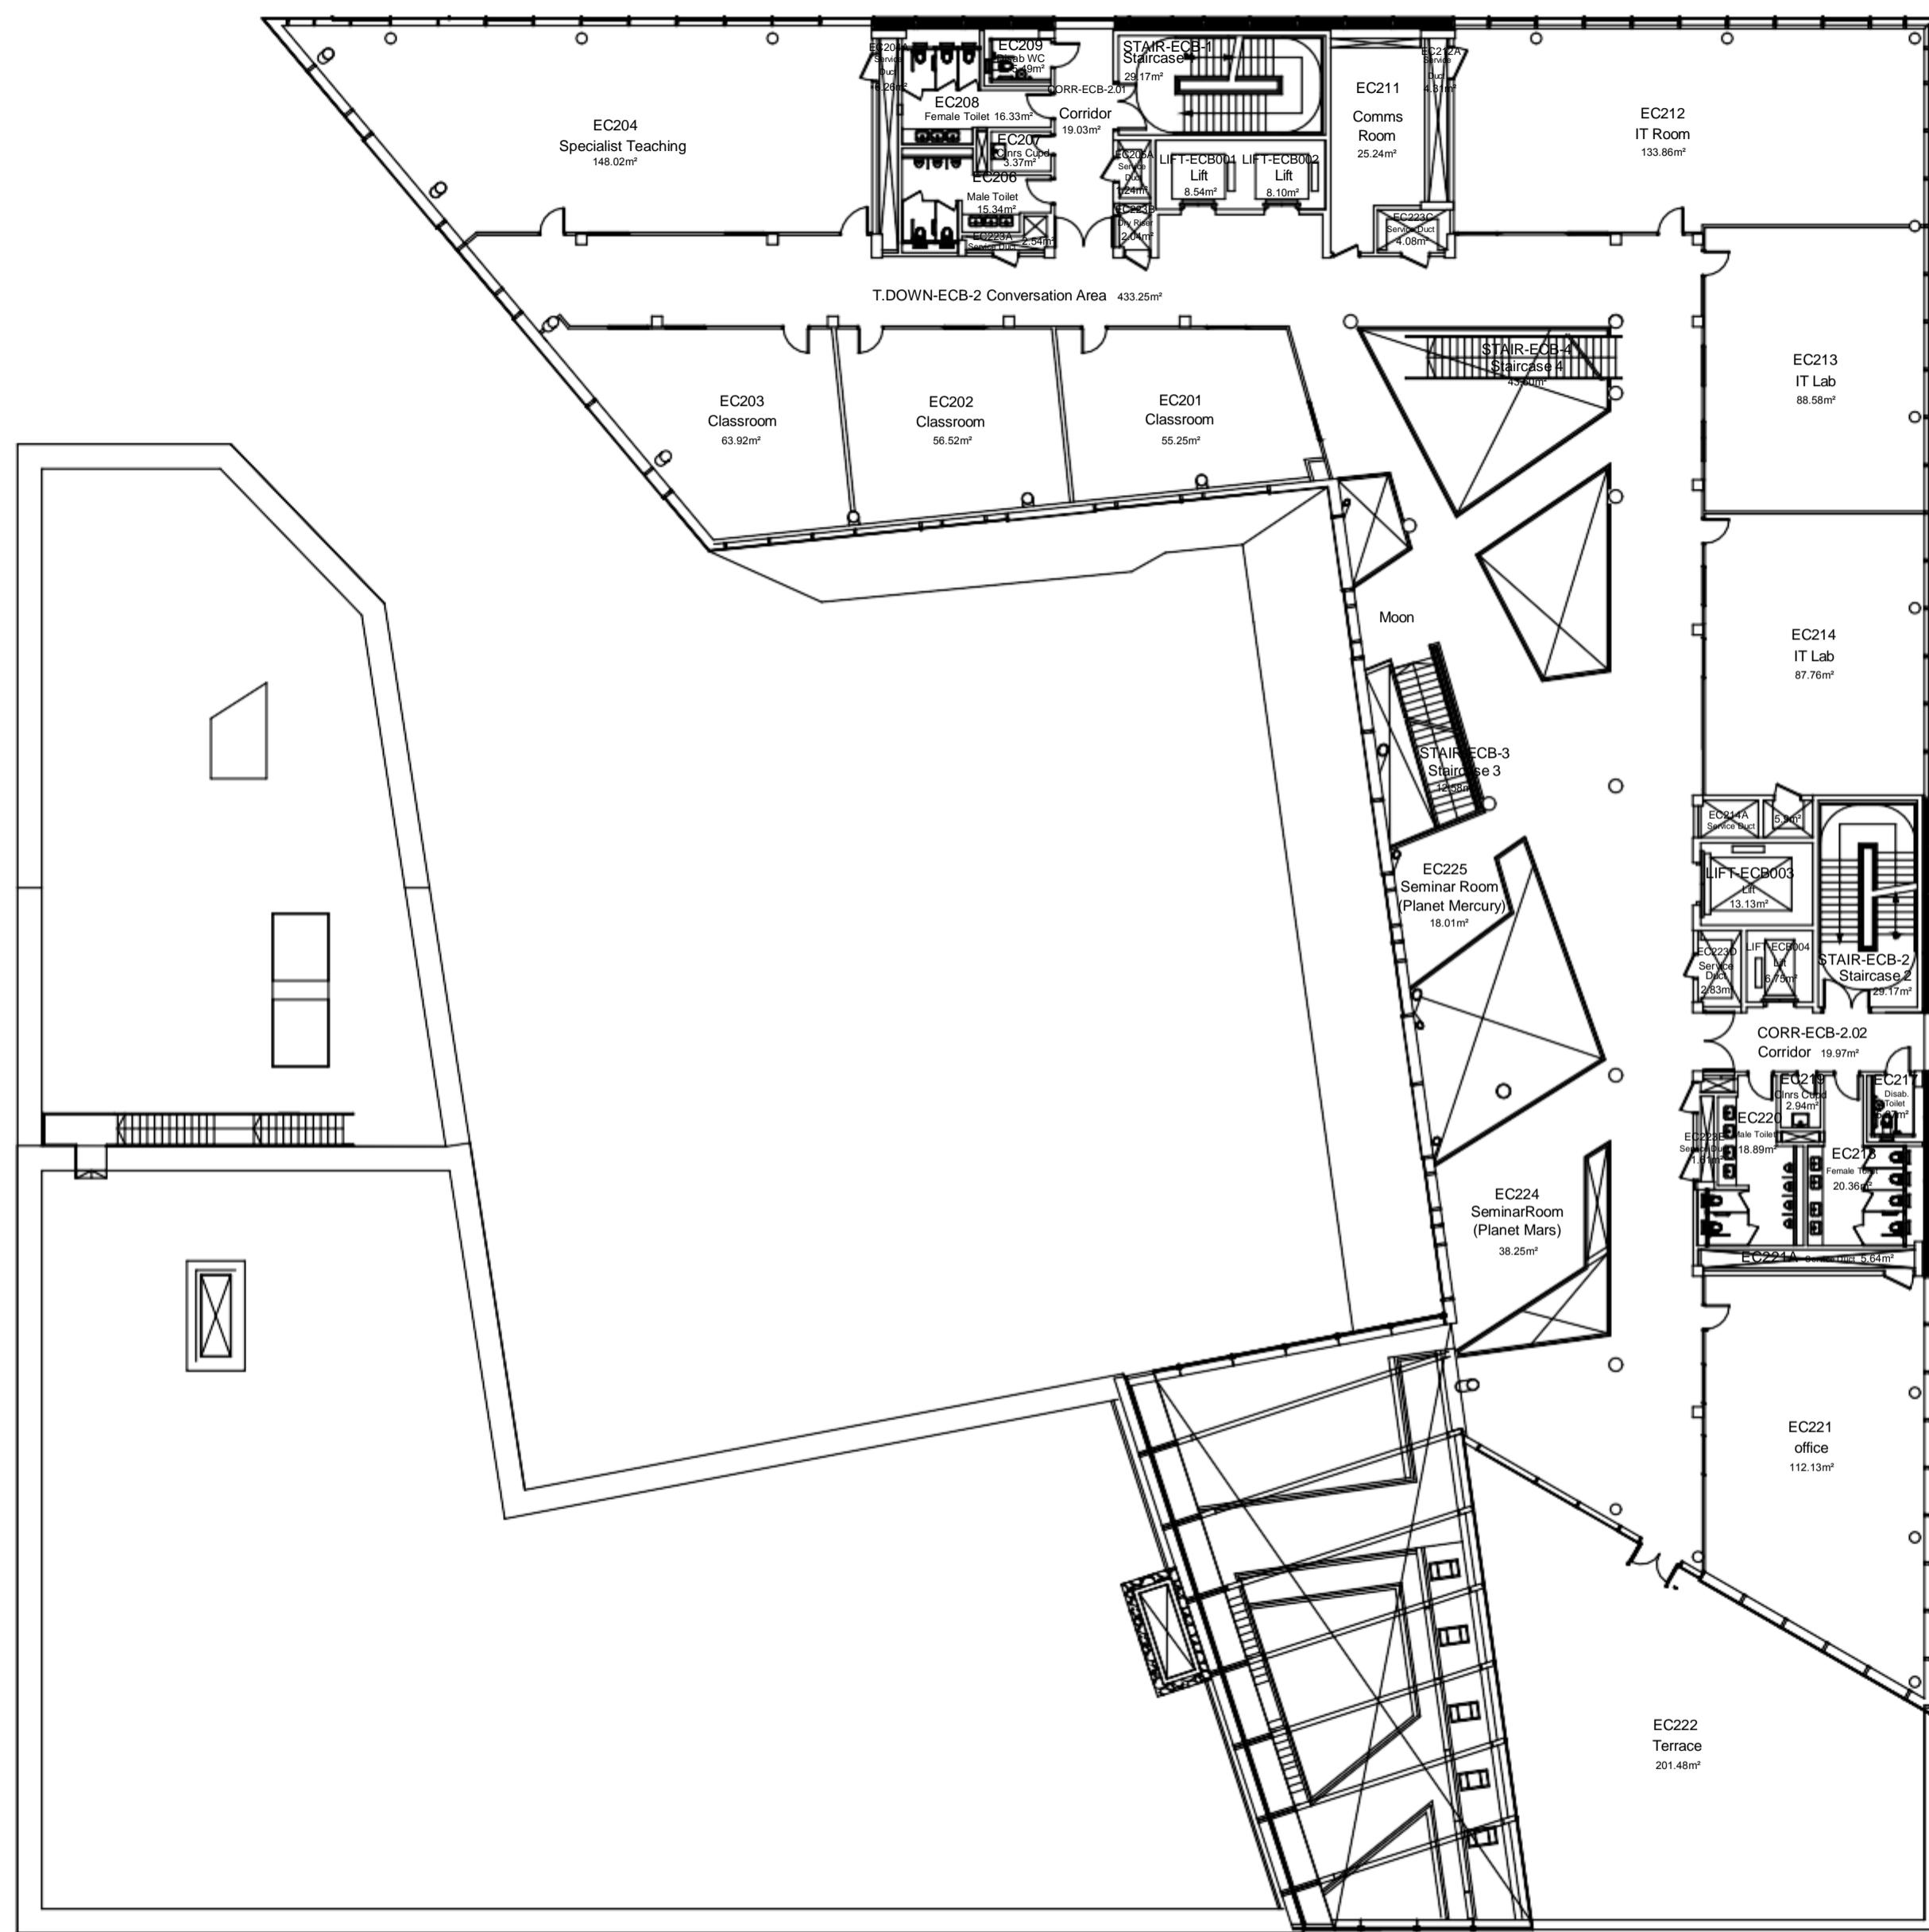

## Second Floor

A scale bar with numerical markings. The markings are 0, 1, 2, 3, 4, 5, 10, and 20m. The scale bar is 20 units long, with the 20m label at the right end.

## NOTES

## AREAS

GIA (Gross Internal Area)	1611.83 m <sup>2</sup>
GEA (Gross External Area)	1841.68 m <sup>2</sup>



*	*
Date	Amendment



 Coventry  
University

Estates Department  
Priory Street, Coventry  
CV1 5FB  
Tel: 024 76887688  
Fax: 024 76887336

## CURRENT STATUS

# RECORD DRAWING

---

## ENGINEERING AND COMPUTING BUILDING

## SECOND FLOOR PLAN

RAWN CHKD DATE  
PC HS 19/04/2018

CALE 1/150 @ A1 1/300 @ A2	DRAWING No. XX001-COV-00-02-M2-A	REV. 0000
----------------------------------	-------------------------------------	--------------



Third Floor

0 1 2 3 4 5 10 20m

**NOTES**  
This Drawing Is The Copyright Of Coventry University Estates Department & Must Not Be Reproduced Without Their Permission. Figured Dimensions Must Be Taken In Preference To Scaled Dimensions & All Dimensions Must Be Verified On Site Prior To Commencing Any Works.

**AREAS**

GEA (Gross External Area)	1607.47 m <sup>2</sup>
GIA (Gross Internal Area)	1482.06 m <sup>2</sup>
NIA (Net Internal Area)	688.75 m <sup>2</sup>



A 19/07/22 Conversation Area named as T.DOWN-ECB-3  
Rev. Date Amendment



Estates Department  
Philly Street, Coventry  
CV1 5FB  
Tel: 024 76887688  
Fax: 024 76887336

**CURRENT STATUS**

**RECORD DRAWING**

**PROJECT**  
ENGINEERING AND COMPUTING  
BUILDING

**TITLE**  
THIRD FLOOR

**DRAWN** PC **CHKD** HS **DATE** 19/11/2020

**SCALE** 1/150 @ A1 **DRAWING No.** ECB001-COV-00-03-M2-A **REV.** A  
1/300 @ A2

## NOTES

This Drawing Is The Copyright Of Coventry University Estates Department & Must Not Be Reproduced Without Their Permission. Figured Dimensions Must Be Taken In Preference To Scaled Dimensions & All Dimensions Must Be Verified On Site Prior To Commencing Any Works.

## AREAS

GIA (Gross Internal Area)	1303.63 m <sup>2</sup>
	#####
GEA (Gross External Area)	1526.97 m <sup>2</sup>



## Fourth Floor

0 1 2 3 4 5 10 20m



Estate Department  
Perry Street, Coventry  
CV1 5FB  
Tel: 024 76887688  
Fax: 024 76887336

## CURRENT STATUS

## RECORD DRAWING

PROJECT  
ENGINEERING AND COMPUTING  
BUILDING

TITLE  
FOURTH FLOOR

DRAWN PC CHKD HS DATE 19/02/2018


SCALE 1/150 @ A1 1/300 @ A2 DRAWING No. ECB001-COV-00-04-M2-A REV. 0000

## NOTES

This Drawing Is The Copyright Of Coventry University Estates Department & Must Not Be Reproduced Without Their Permission. Figured Dimensions Must Be Taken In Preference To Scaled Dimensions & All Dimensions Must Be Verified On Site Prior To Commencing Any Works.

## AREAS

GIA (Gross Internal Area)	136.71 m <sup>2</sup>
GEA (Gross External Area)	1476.39 m <sup>2</sup>

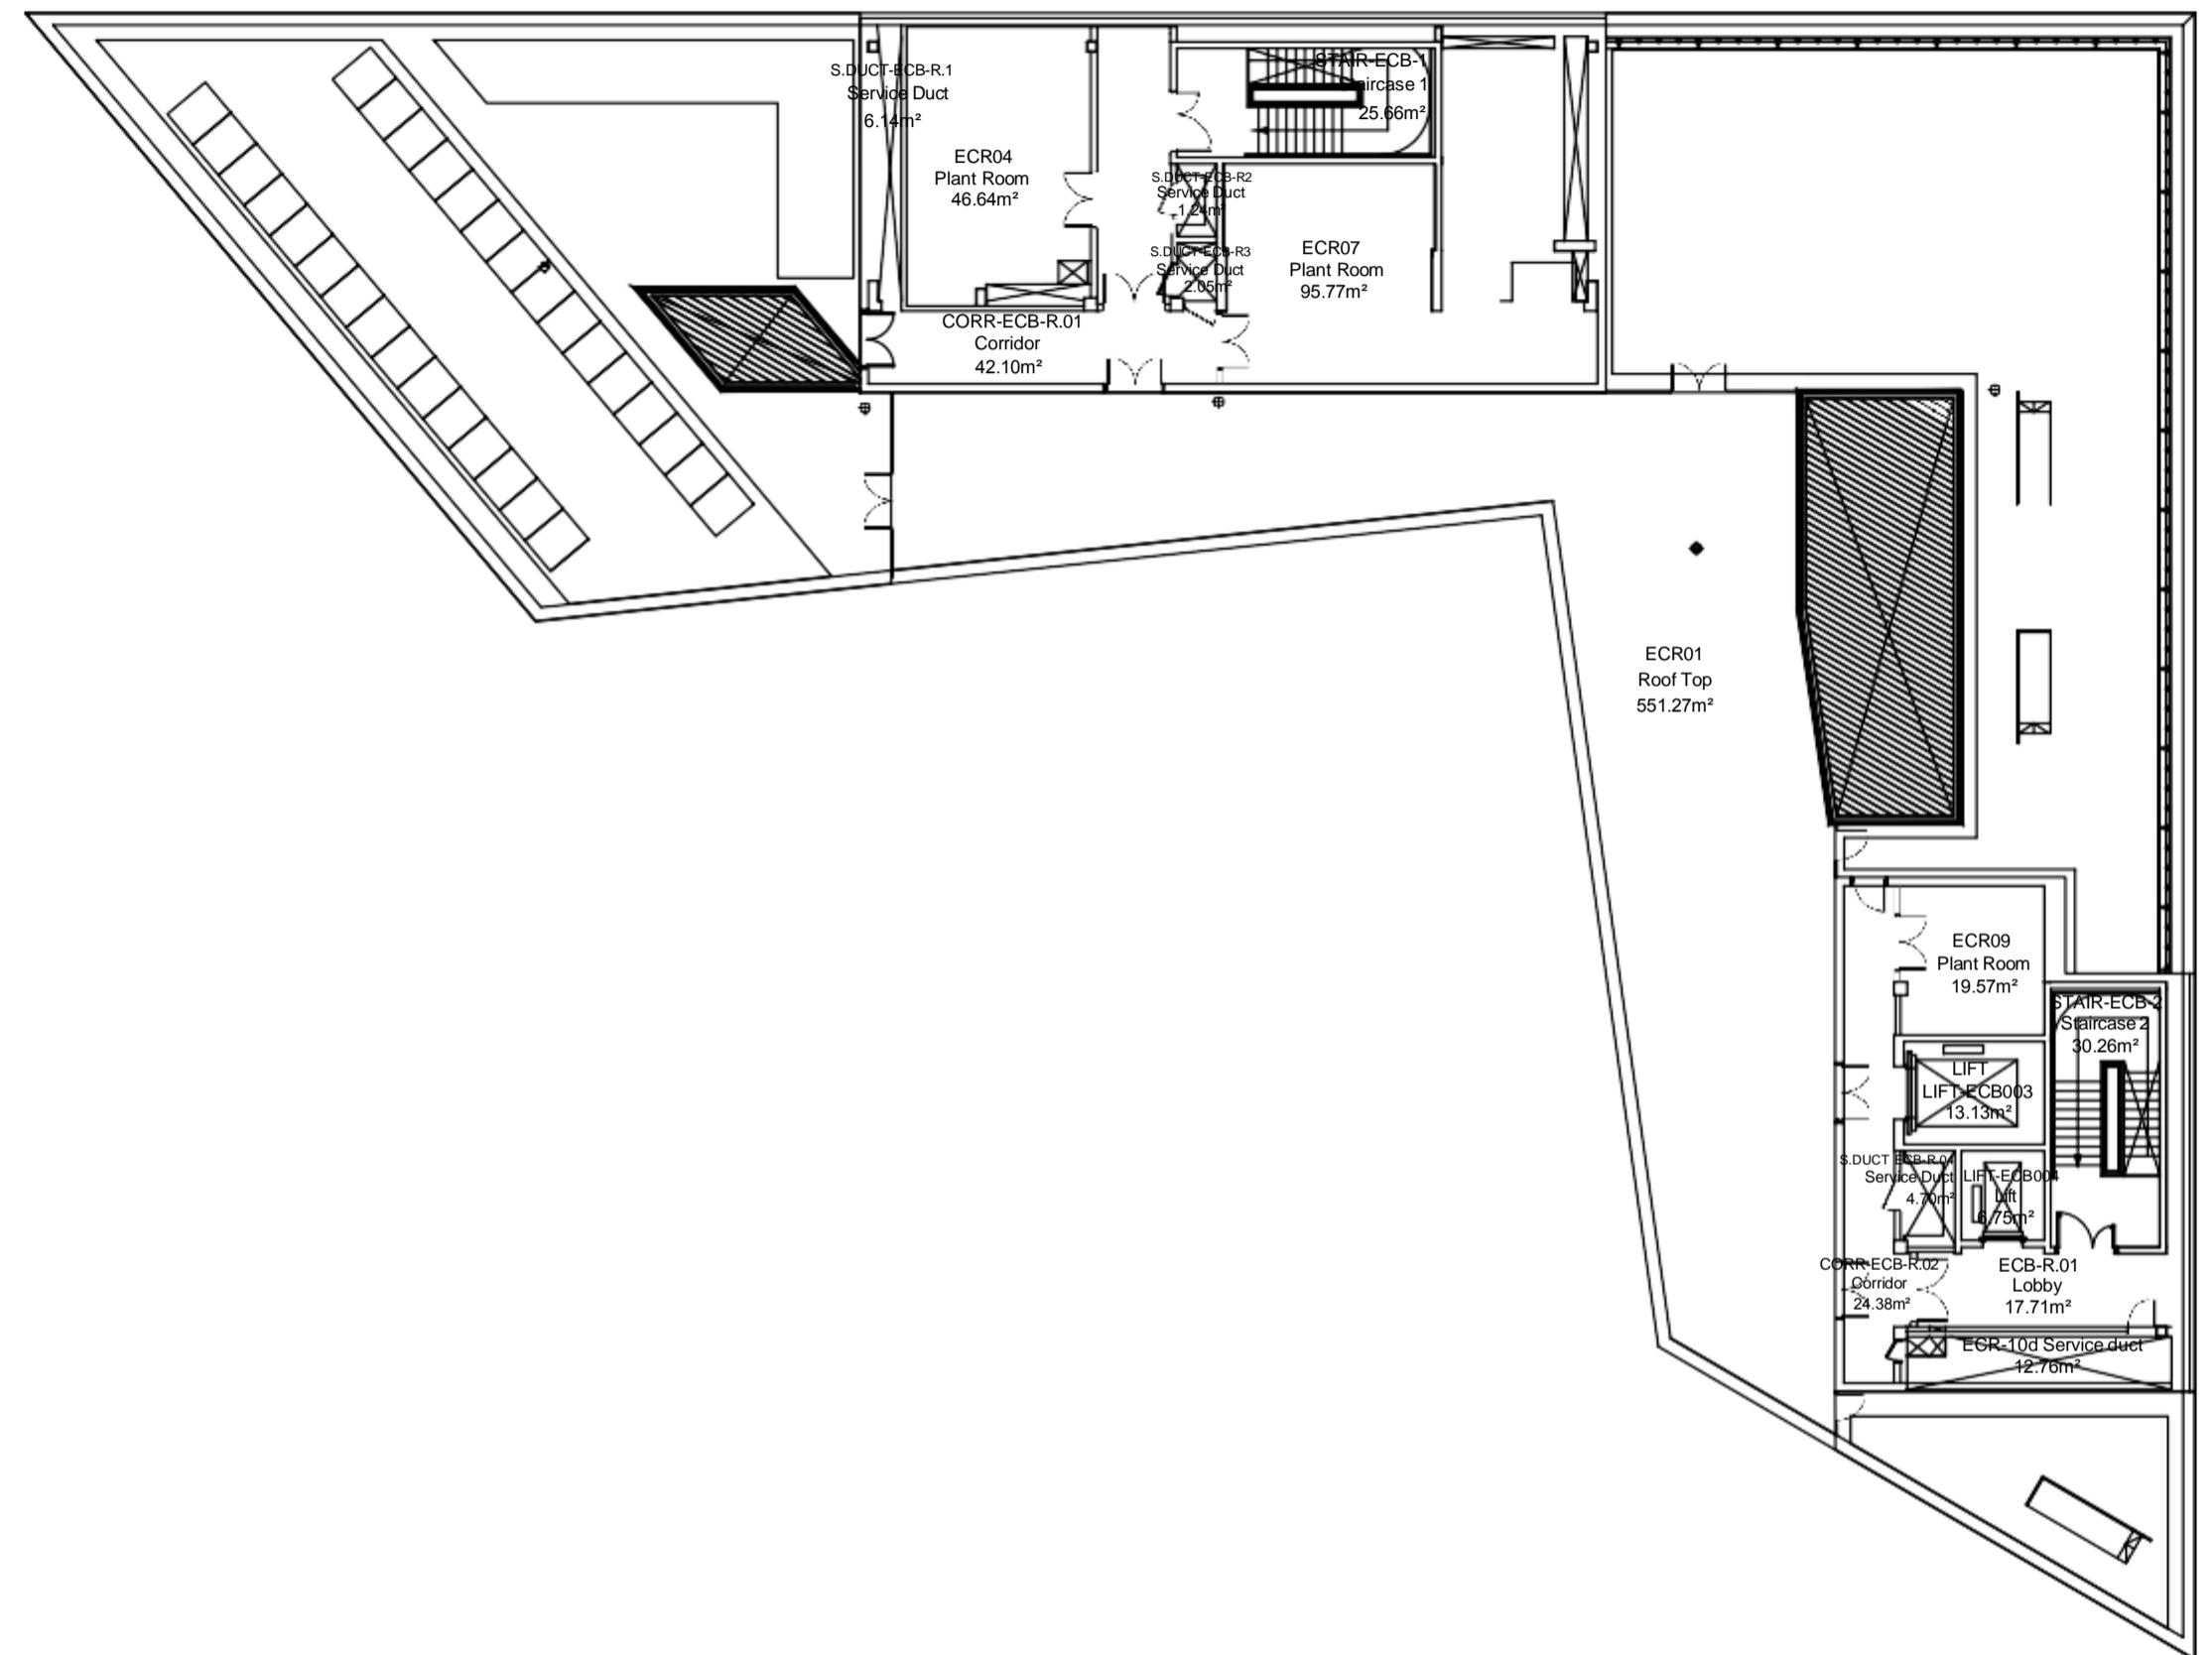

## Roof

0 1 2 3 4 5 10 20m

\* \* \*  
Rev. Date Amendment



**Coventry**  
University

Estates Department  
Philly Street, Coventry  
CV1 5FB  
Tel: 024 76887688  
Fax: 024 76887336

## CURRENT STATUS

## RECORD DRAWING

PROJECT  
ENGINEERING AND COMPUTING  
BUILDING

TITLE  
ROOF PLAN

DRAWN PC CHKD HS DATE 19/04/2018

SCALE 1/150 @ A1 1/300 @ A2 DRAWING No. XX001-COV-00-RF-M2-A REV. 0000