

NOTES

This Drawing Is The Copyright Of Coventry University Estates Department & Must Not Be Reproduced Without Their Permission. Figured Dimensions Must Be Taken In Preference To Scaled Dimensions & All Dimensions Must Be Verified On Site Prior To Commencing Any Works.



NOTE

GIA	1157.19 m ²
GEA	1240.57 m ²

A 06/02/2018 Drawing amended to match as built floor plan
Rev. Date Amendment



Coventry
University

Estates Department
Priority Street, Coventry
CV1 5FB
Tel: 024 76887688
Fax: 024 76887336

CURRENT STATUS

RECORD DRAWING

PROJECT


**FACULTY OF BUSINESS & LAW
GEORGE ELIOT BUILDING**

TITLE

GROUND FLOOR PLAN


DRAWN EM CHkD HS DATE 01/02/2018

SCALE 1:200 @ A2 DRAWING No. MF001-COV-00-GF-M2-A REV. 0000

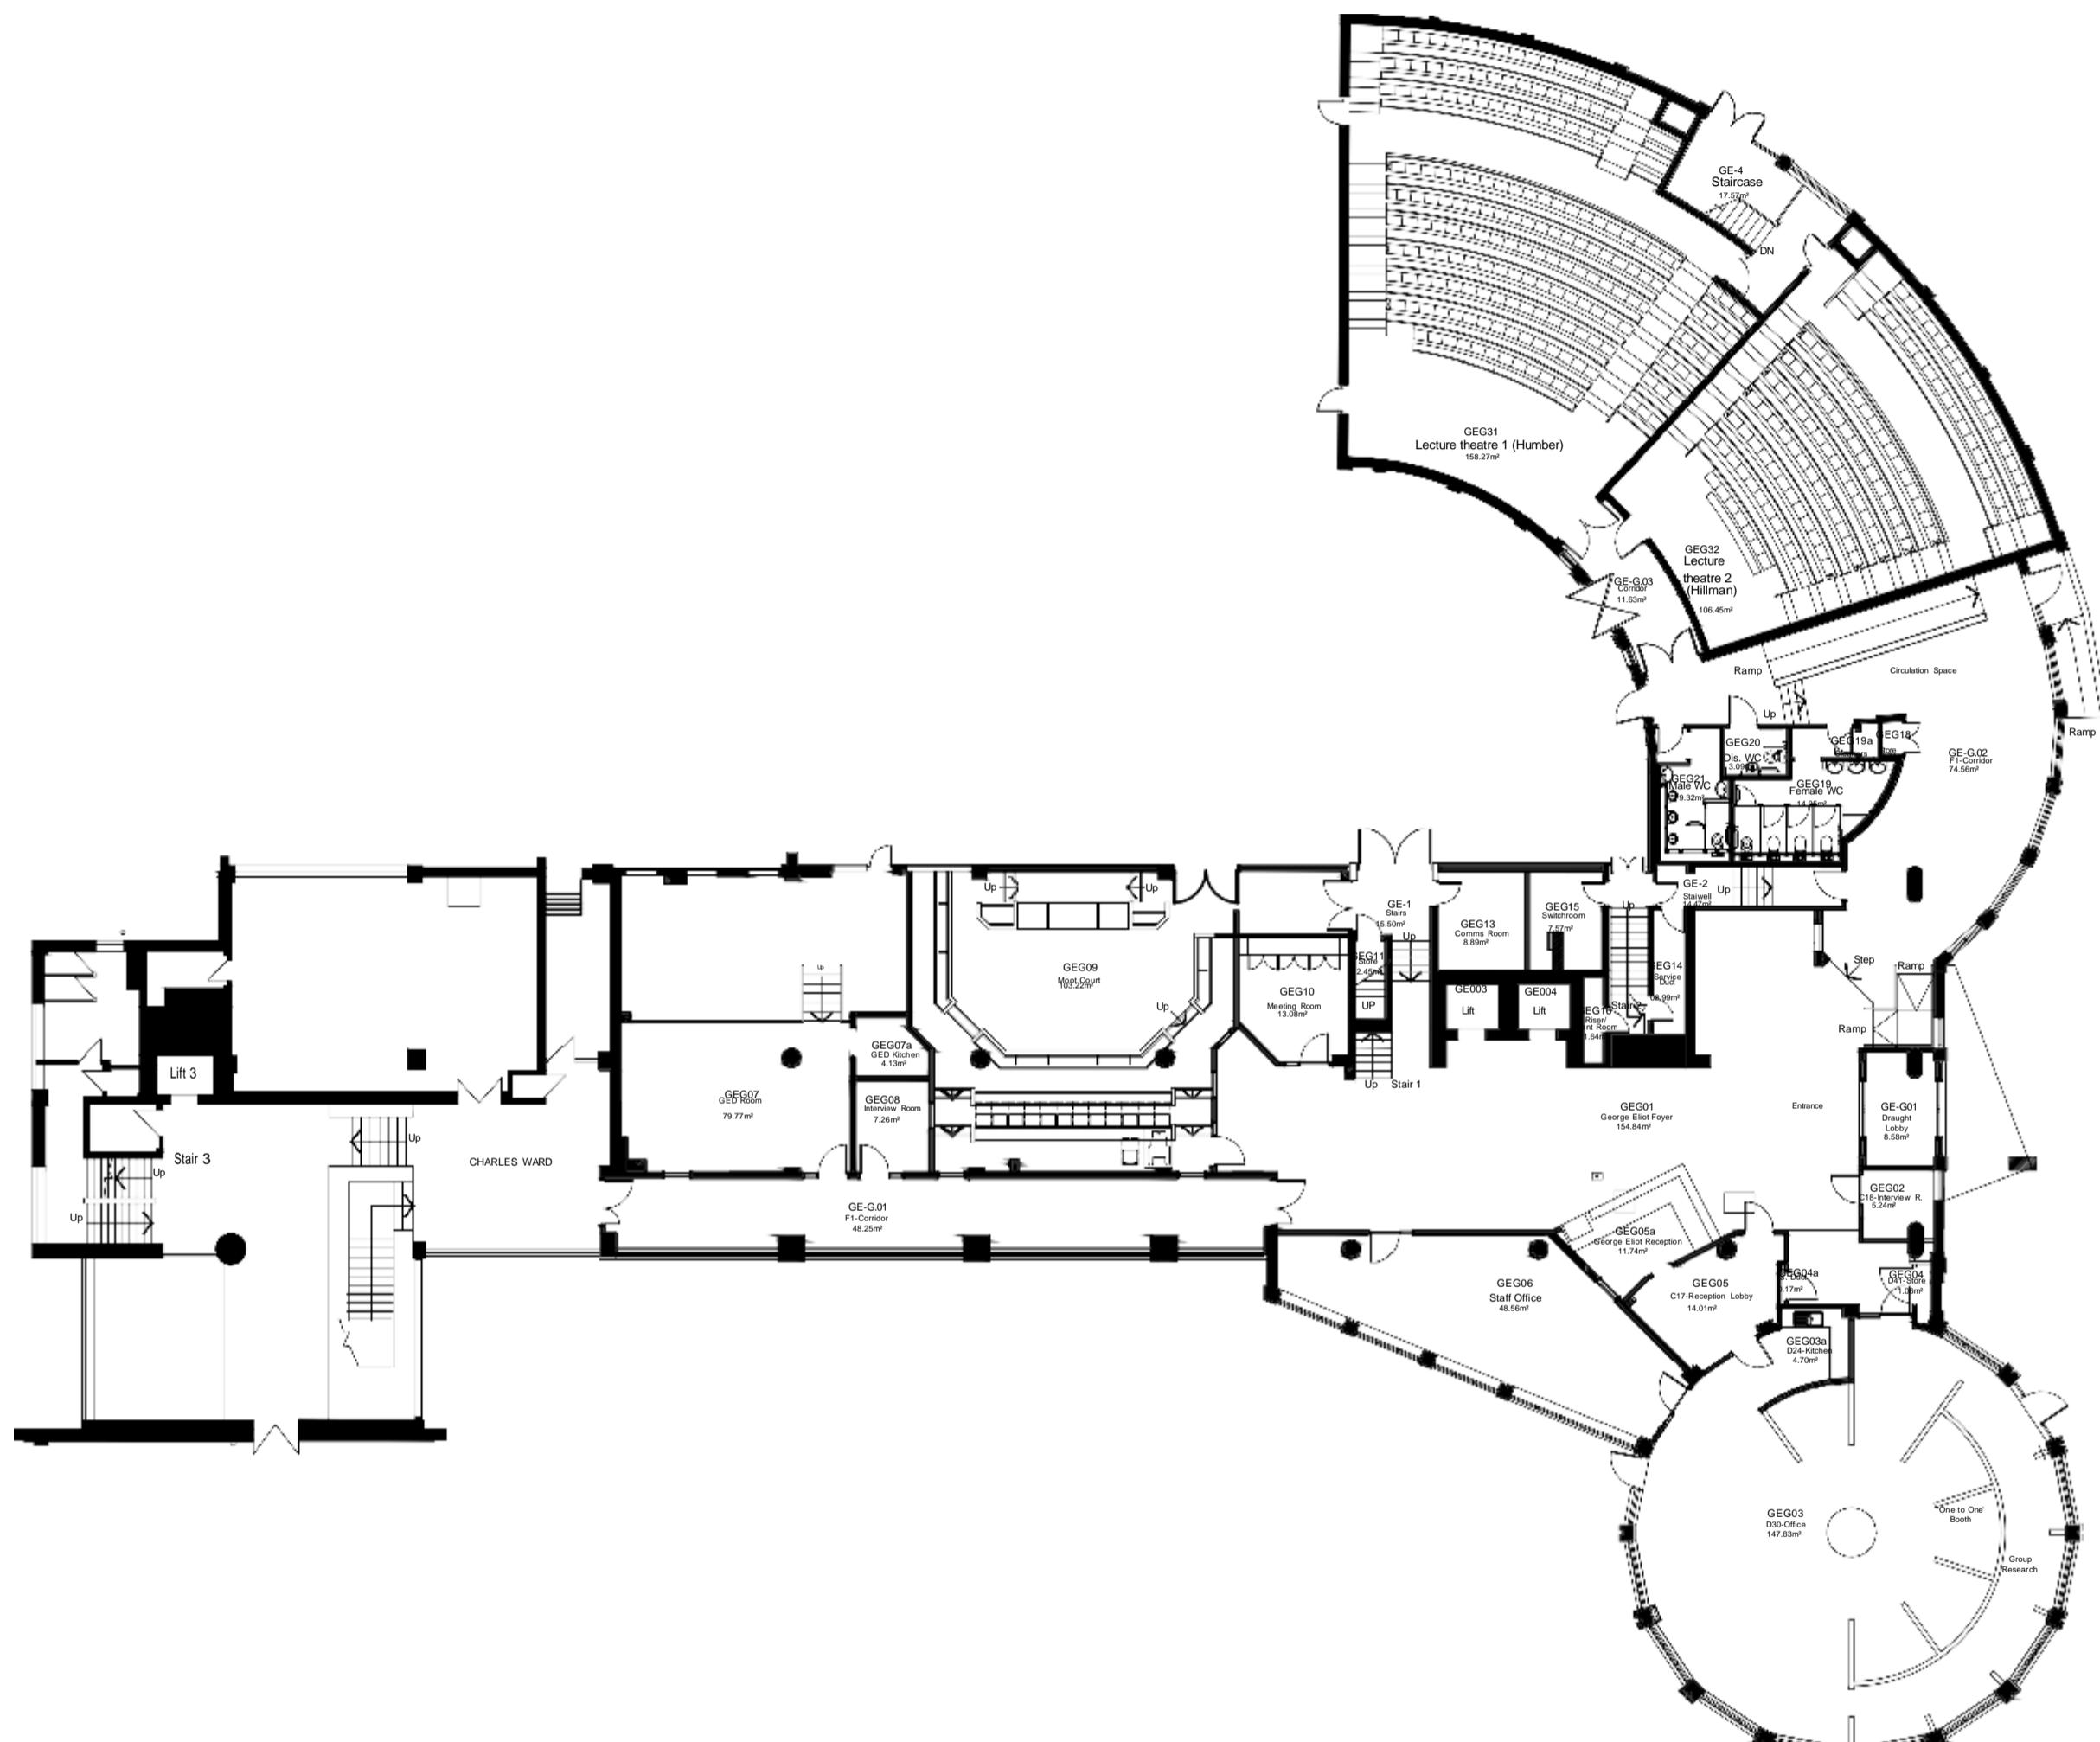

Ground Floor Plan

0 1 2 3 4 5 10 20m

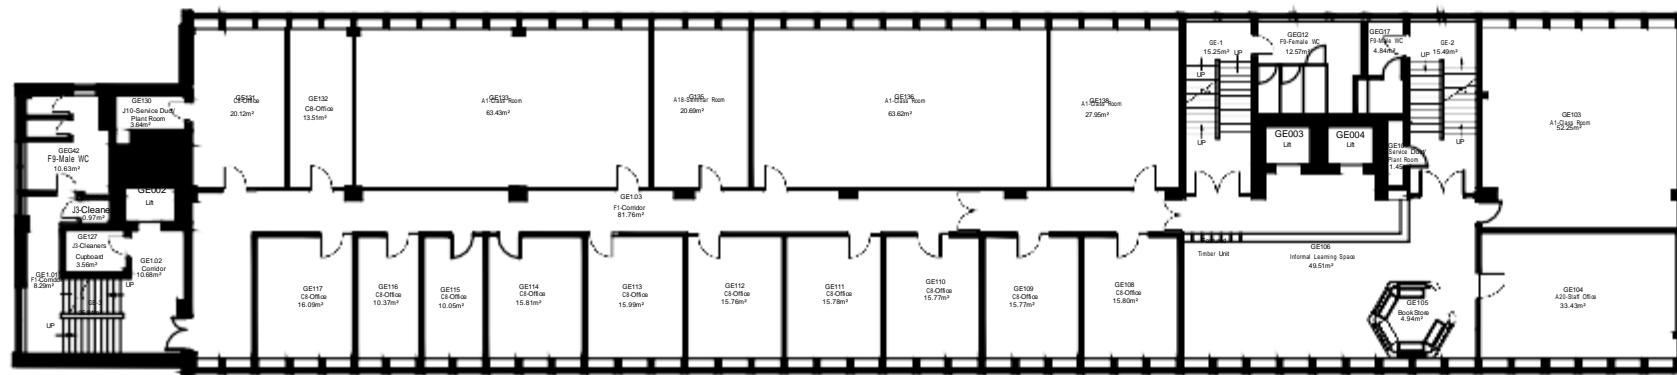

First Floor Plan



NOTES

This Drawing Is The Copyright Of Coventry University Estates Department & Must Not Be Reproduced Without Their Permission. Figured Dimensions Must Be Taken In Preference To Scaled Dimensions & All Dimensions Must Be Verified On Site Prior To Commencing Any Works.



NOTE	
GIA	721.23 m ²
GEA	793.94 m ²

B	07/10/2021	Rooms 131-138 areas updated
A	01/02/2018	Drawing amended to match as built floor plan
Rev.	Date	Amendment



Coventry
University

Estates Department
Priory Street, Coventry
CV1 5FB
Tel: 024 76887688
Fax: 024 76887336

CURRENT STATUS

DRAFT

PROJECT FACULTY OF BUSINESS & LAW
GEORGE ELIOT BUILDING

TITLE AS BUILT FIRST FLOOR PLAN

DRAWN EM		CHKD HS	DATE 01/02/2018
SCALE 1:200 @ A2	DRAWING No. ME001-COV-00-01-M2-A		REV. B

NOTES

This Drawing Is The Copyright Of Coventry University Estates Department & Must Not Be Reproduced Without Their Permission. Figured Dimensions Must Be Taken In Preference To Scaled Dimensions & All Dimensions Must Be Verified On Site Prior To Commencing Any Works.



NOTE

GIA	721.52 m ²
GEA	791.63 m ²

A	05/02/2018	Drawing amended to match as built floor plan
Rev.	Date	Amendment



**Coventry
University**

Estates Department
Priory Street, Coventry
CV1 5FB
Tel: 024 76887688
Fax: 024 76887336

CURRENT STATUS


DRAFT

PROJECT	FACULTY OF BUSINESS & LAW	
	GEORGE ELIOT BUILDING	

TITLE	AS BUILT SECOND FLOOR PLAN	
-------	----------------------------	--

DRAWN	EM	CHkD	DATE
		HS	05/02/2018

SCALE	DRAWING No.	REV.
1:200 @ A2	MF001-COV-00-02-M2-A	0000

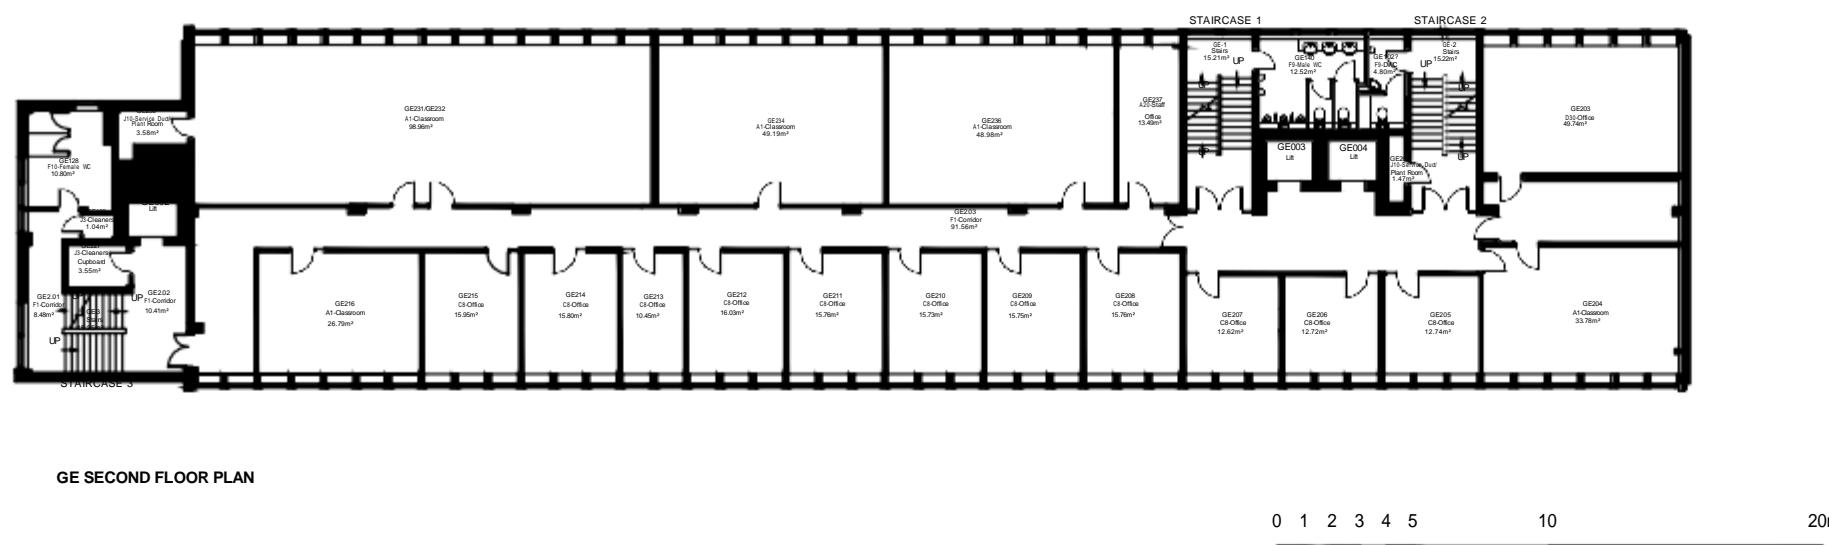

NOTES


This Drawing Is The Copyright Of Coventry University Estates Department & Must Not Be Reproduced Without Their Permission. Figured Dimensions Must Be Taken In Preference To Scaled Dimensions & All Dimensions Must Be Verified On Site Prior To Commencing Any Works.



NOTE

GIA	721.35 m ²
GEA	792.18 m ²

A 19/02/2018 Drawing amended to match as built floor plan
Rev. Date Amendment

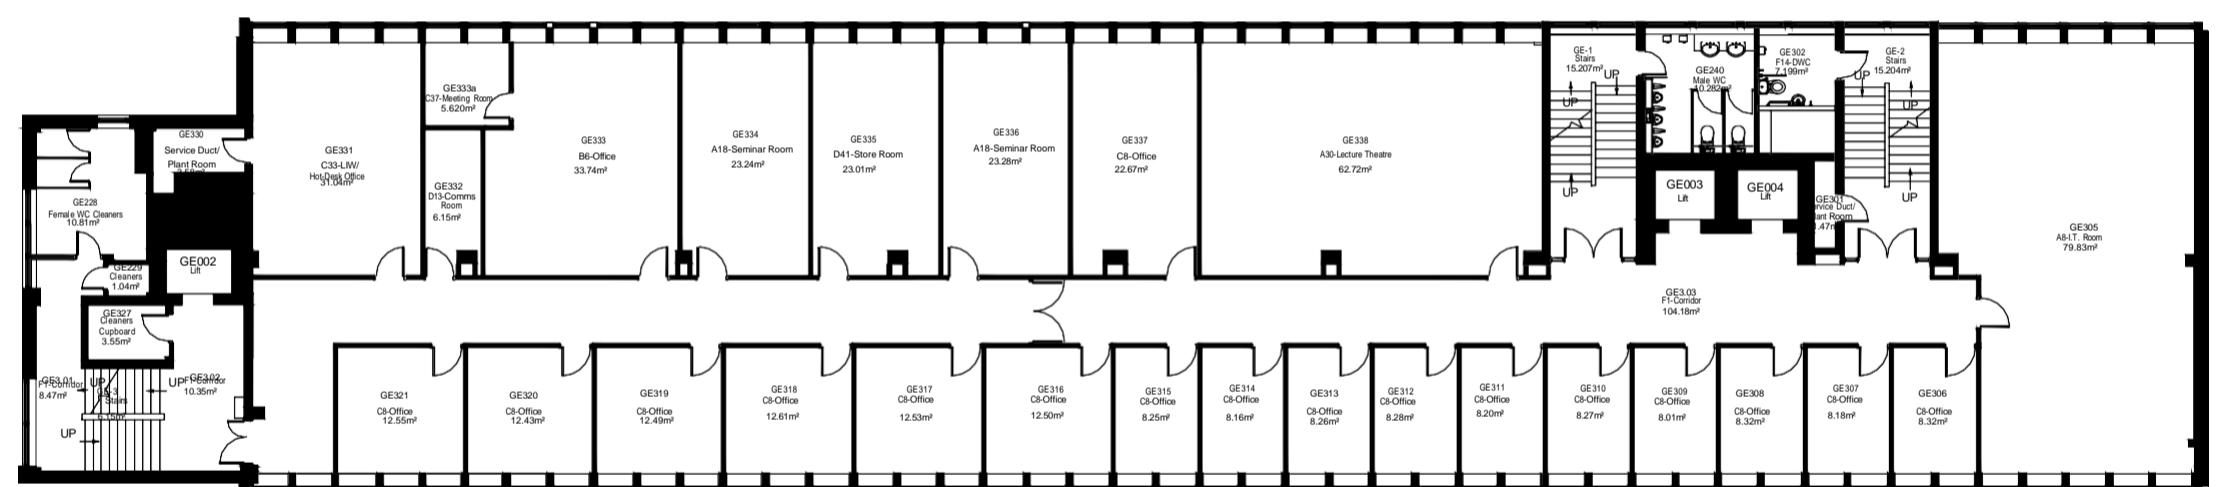

GE THIRD FLOOR PLAN



Estates Department
Priory Street, Coventry
CV1 5FB
Tel: 024 76887688
Fax: 024 76887336

CURRENT STATUS

DRAFT

PROJECT

FACULTY OF BUSINESS & LAW
GEORGE ELIOT BUILDING

TITLE

AS BUILT THIRD FLOOR PLAN

DRAWN	EM	CHkD	DATE
		HS	07/02/2018
SCALE	DRAWING No.	MF001-COV-00-03-M2-A	REV.

1:200 @ A2

NOTES

This Drawing Is The Copyright Of Coventry University Estates Department & Must Not Be Reproduced Without Their Permission. Figured Dimensions Must Be Taken In Preference To Scaled Dimensions & All Dimensions Must Be Verified On Site Prior To Commencing Any Works.



NOTE

GIA	721.56 m ²
GEA	792.18 m ²

A	21/02/2018	Drawing amended to match as built floor plan
Rev.	Date	Amendment



**Coventry
University**

Estates Department
Priory Street, Coventry
CV1 5FB
Tel: 024 76887688
Fax: 024 76887336

CURRENT STATUS

DRAFT

PROJECT


**FACULTY OF BUSINESS & LAW
GEORGE ELIOT BUILDING**

TITLE


AS BUILT FOURTH FLOOR PLAN

DRAWN	EM	CHKD	DATE
		HS	07/02/2018

SCALE	DRAWING No.	REV.
1:200 @ A2	MF001-COV-00-04-M2-A	0000

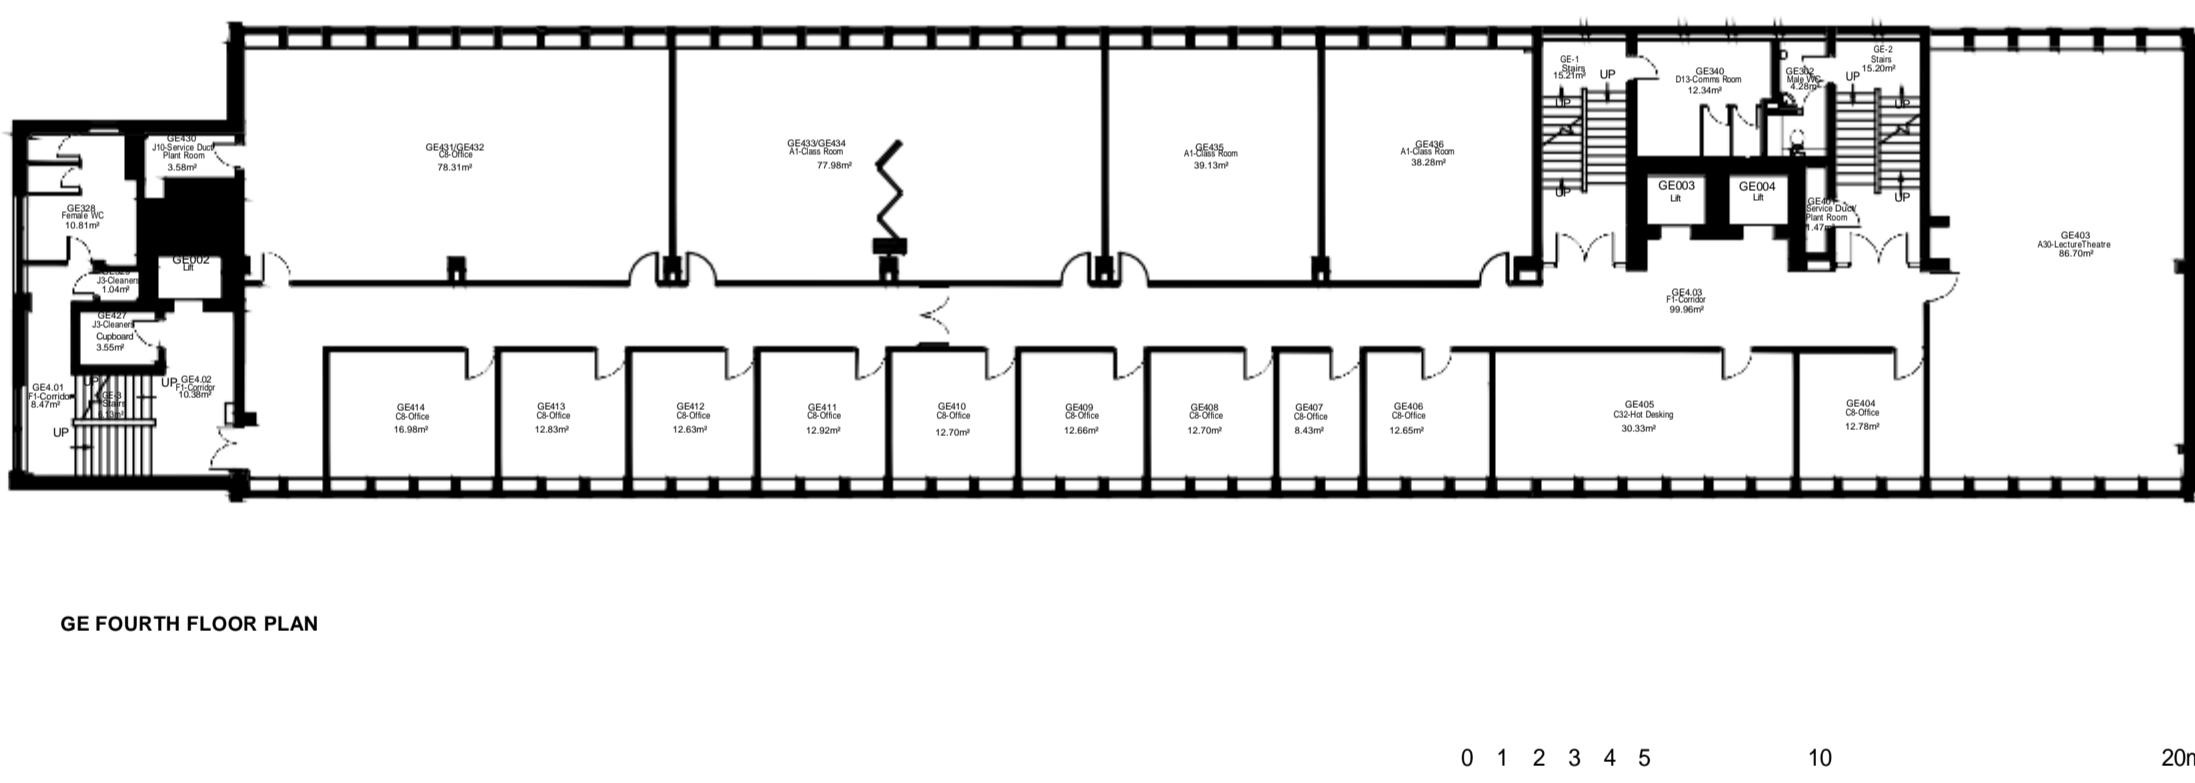


NOTES										
<p>This Drawing Is The Copyright Of Coventry University Estates Department & Must Not Be Reproduced Without Their Permission. Figured Dimensions Must Be Taken In Preference To Scaled Dimensions & All Dimensions Must Be Verified On Site Prior To Commencing Any Works.</p>										
										
NOTE										
GIA 721.35 m ²										
GEA 792.18 m ²										
<table border="1" style="width: 100%; border-collapse: collapse;"> <tr> <td style="width: 10%;">B</td> <td style="width: 10%;">26/07/2021</td> <td>Drawing amended as pre refurbishment</td> </tr> <tr> <td>A</td> <td>20/02/2018</td> <td>Drawing amended to match as built floor plan</td> </tr> <tr> <td>Rev.</td> <td>Date</td> <td>Amendment</td> </tr> </table>		B	26/07/2021	Drawing amended as pre refurbishment	A	20/02/2018	Drawing amended to match as built floor plan	Rev.	Date	Amendment
B	26/07/2021	Drawing amended as pre refurbishment								
A	20/02/2018	Drawing amended to match as built floor plan								
Rev.	Date	Amendment								
 Coventry University										
<small>Estates Department Priority Street, Coventry CV1 5FB Tel: 024 76887688 Fax: 024 76887336</small>										
CURRENT STATUS										
DRAFT										
PROJECT FACULTY OF BUSINESS & LAW GEORGE ELIOT BUILDING										
TITLE AS BUILT FIFTH FLOOR PLAN										
DRAWN EM CHKD HS DATE 26/07/2021										
SCALE 1:200 @ A2 DRAWING No. MF001-COV-00-05-M2-A REV. B										

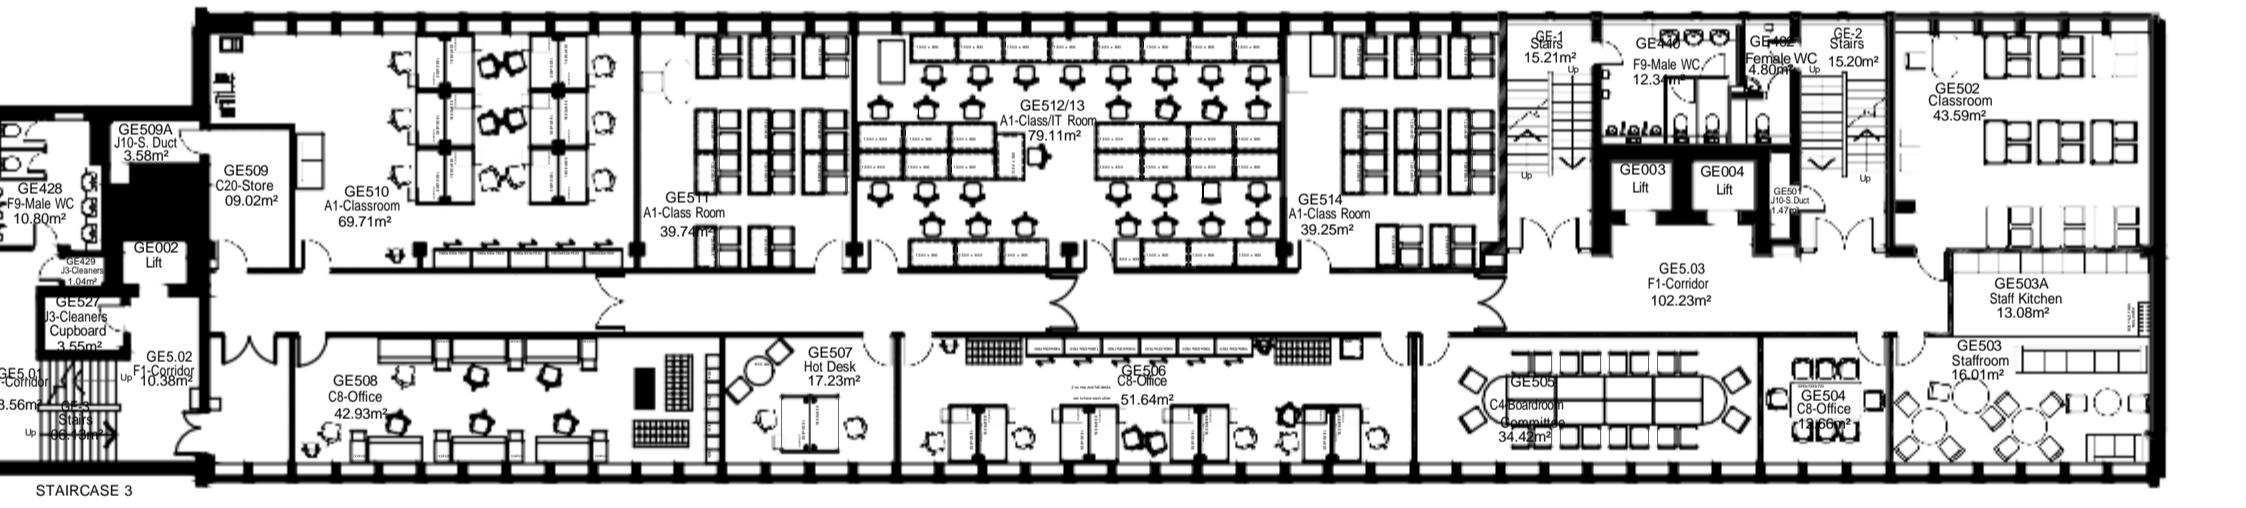

GE FIFTH FLOOR PLAN

0 1 2 3 4 5 10 20m

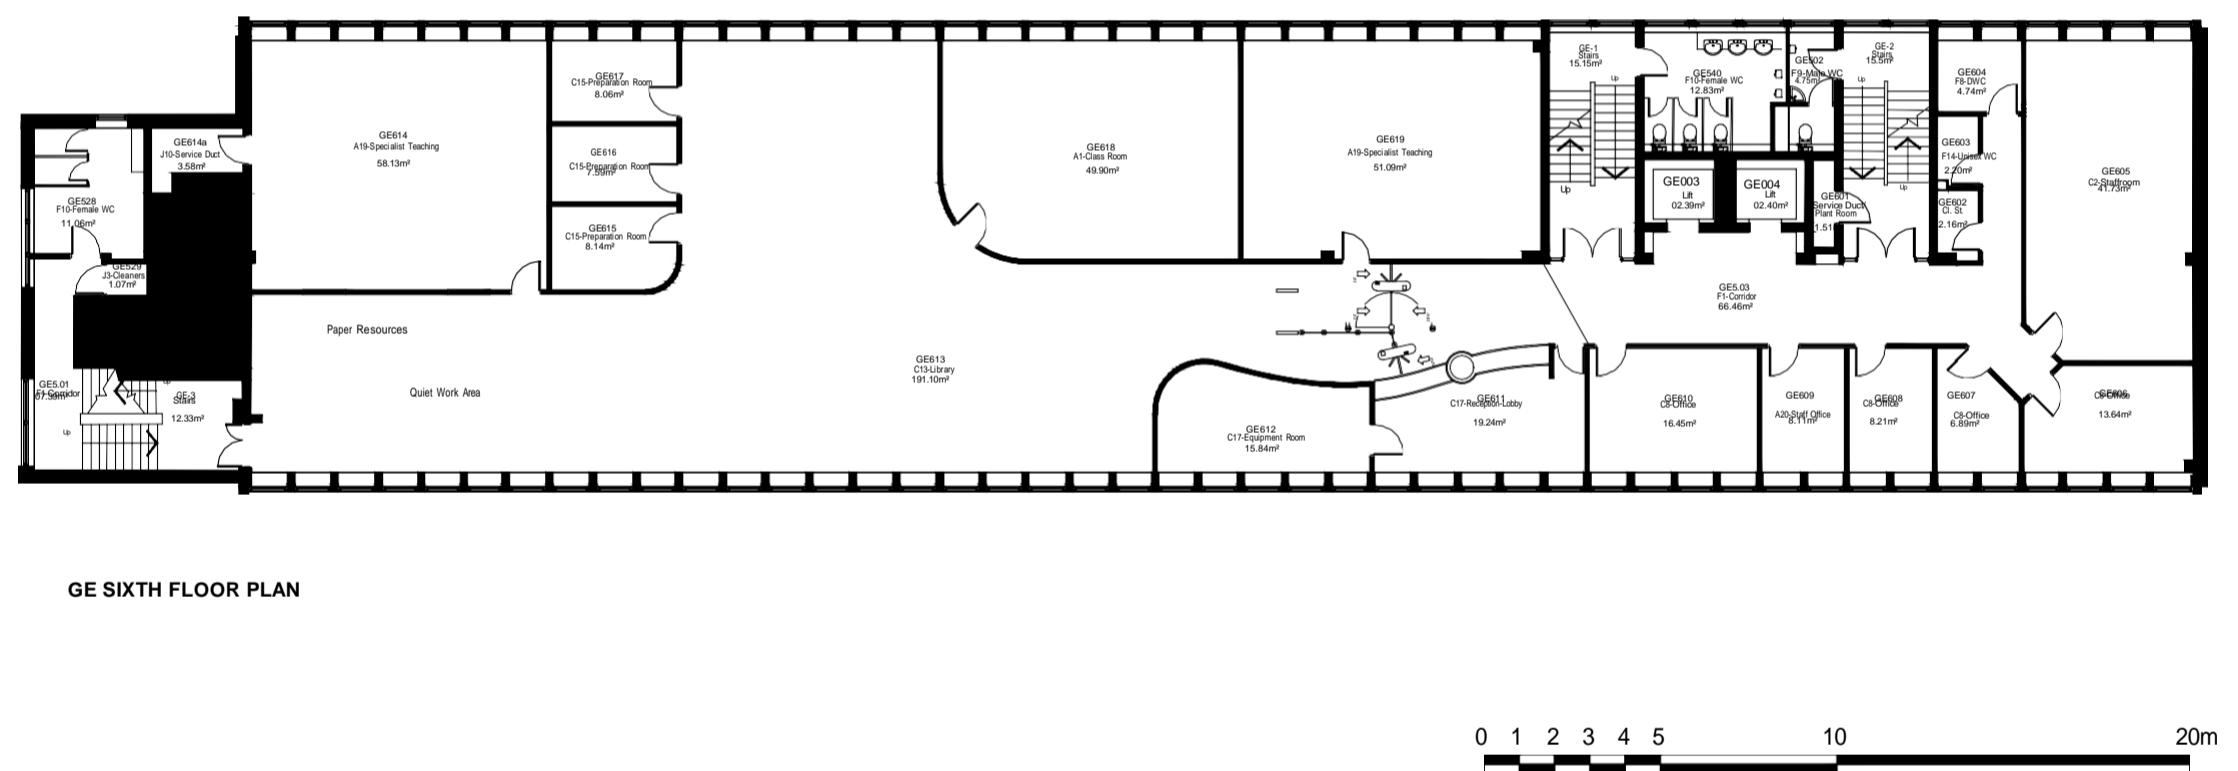

GE SIXTH FLOOR PLAN

0 1 2 3 4 5 10 20m

NOTES

This Drawing Is The Copyright Of Coventry University
states Department & Must Not Be Reproduced
Without Their Permission. Figured Dimensions Must Be
taken In Preference To Scaled Dimensions & All
dimensions Must Be Verified On Site Prior To
commencing Any Works.



NOTE

GIA	721.34 m ²
GEA	792.18 m ²

	08/02/2018	Drawing amended to match as built floor plan
Rev.	Date	Amendment



Coventry
University

Estates Department
Priory Street, Coventry
CV1 5FB
Tel: 024 76887688
Fax: 024 76887336


DRAFT

TLE AS BUILT SIXTH FLOOR PLAN

RAWN EM	CHkD HS	DATE 08/02/2018
CALE 1:200 @ A2	DRAWING No. MF001-COV-00-06-M2-A	REV. 0000

NOTES

This Drawing Is The Copyright Of Coventry University Estates Department & Must Not Be Reproduced Without Their Permission. Figured Dimensions Must Be Taken In Preference To Scaled Dimensions & All Dimensions Must Be Verified On Site Prior To Commencing Any Works.

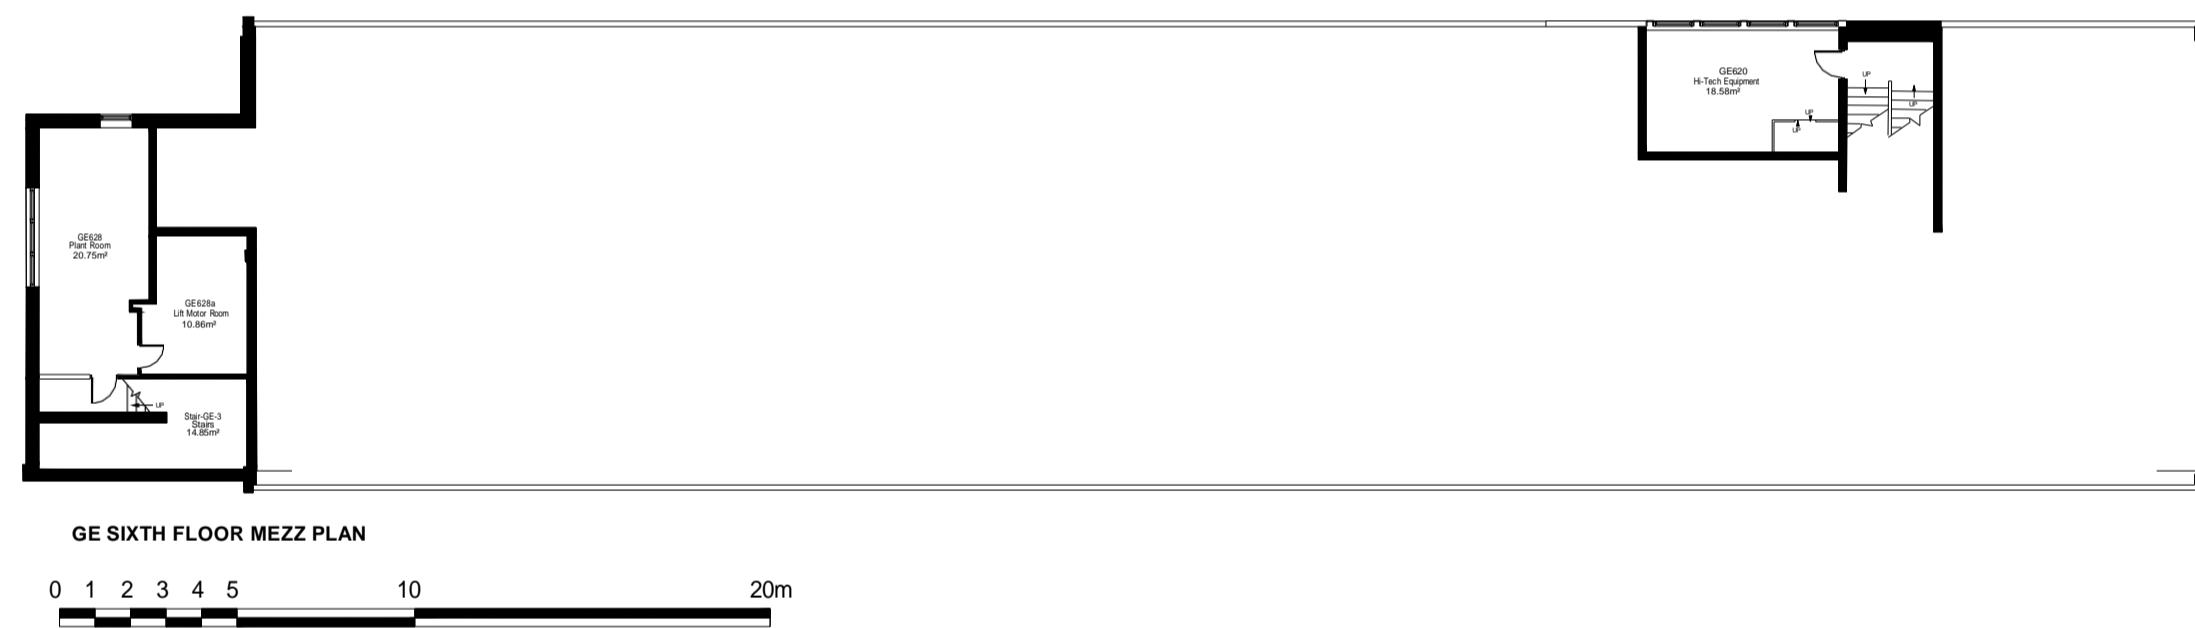

A 08/02/2018 Drawing amended to match as built floor plan
Rev. Date Amendment



Estates Department
Priority Street, Coventry
CV1 5FB
Tel: 024 76887688
Fax: 024 76887336

CURRENT STATUS

DRAFT

PROJECT

FACULTY OF BUSINESS & LAW
GEORGE ELIOT BUILDING


TITLE

AS BUILT SIXTH FLOOR MEZZANINE

DRAWN	EM	CHkD	DATE
		HS	08/06/2018
SCALE	DRAWING No.		REV.
1:200 @ A2	GE001-COV-MZ-06-M2-A		0000

NOTES

This Drawing Is The Copyright Of Coventry University Estates Department & Must Not Be Reproduced Without Their Permission. Figured Dimensions Must Be Taken In Preference To Scaled Dimensions & All Dimensions Must Be Verified On Site Prior To Commencing Any Works.

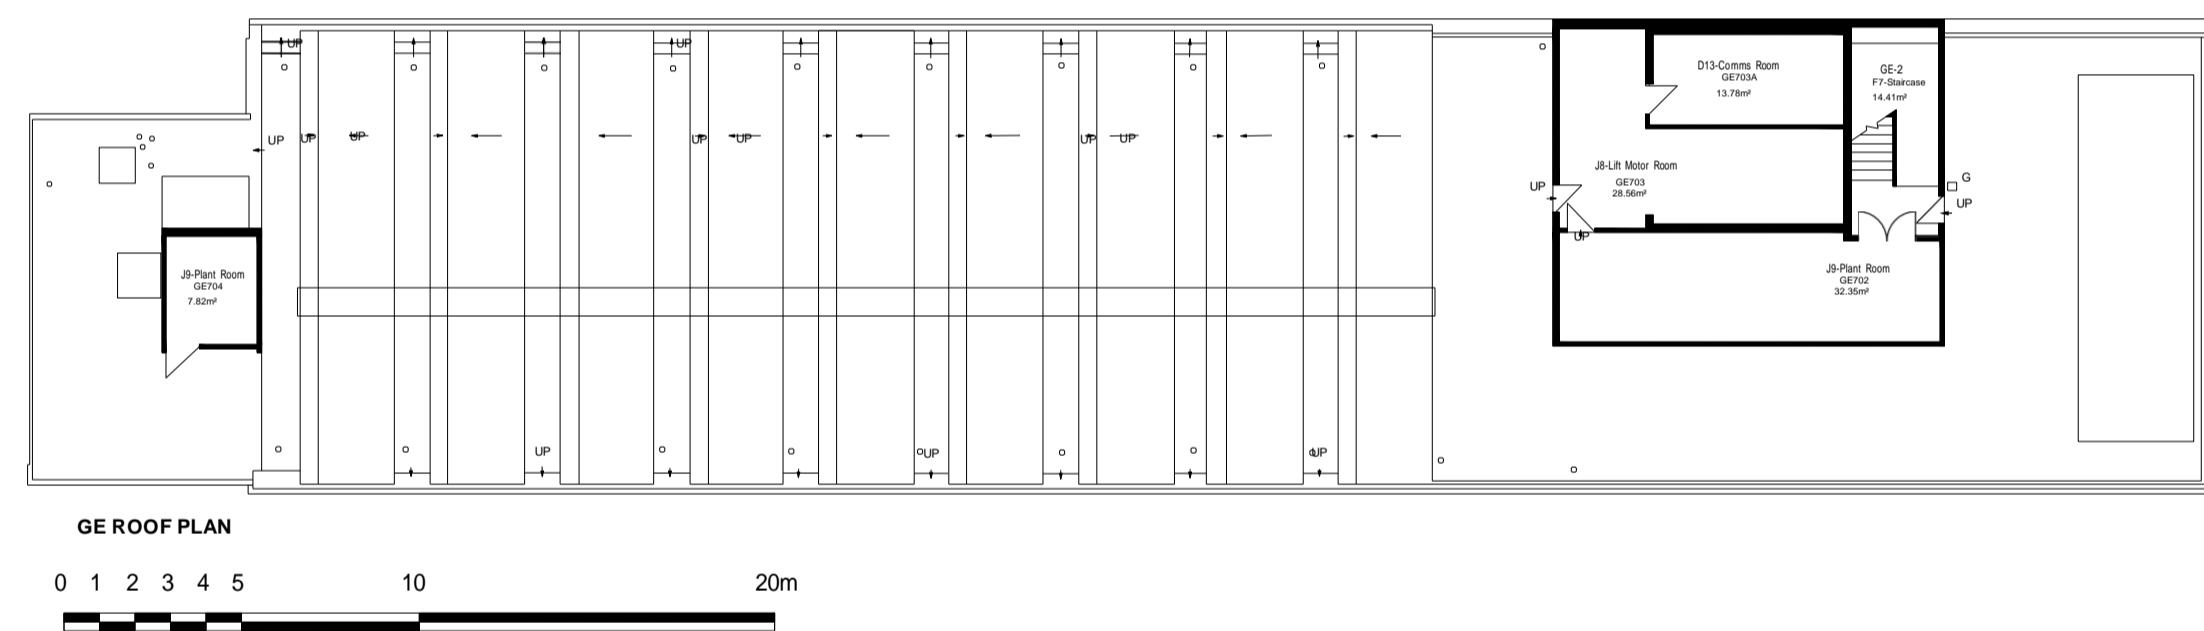

A 20/02/2018 Drawing amended to match as built roof plan

Rev. Date Amendment



Coventry
University

Estates Department
Priory Street, Coventry
CV1 5FB
Tel: 024 76887688
Fax: 024 76887336

CURRENT STATUS

DRAFT

PROJECT

**FACULTY OF BUSINESS & LAW
GEORGE ELIOT BUILDING**

TITLE

AS BUILT ROOF PLAN

DRAWN	EM	CHKD	DATE
		HS	20/02/2018

SCALE	DRAWING No.		REV.
1:200 @ A2	MF001-COV-00-R-M2-A		0000