


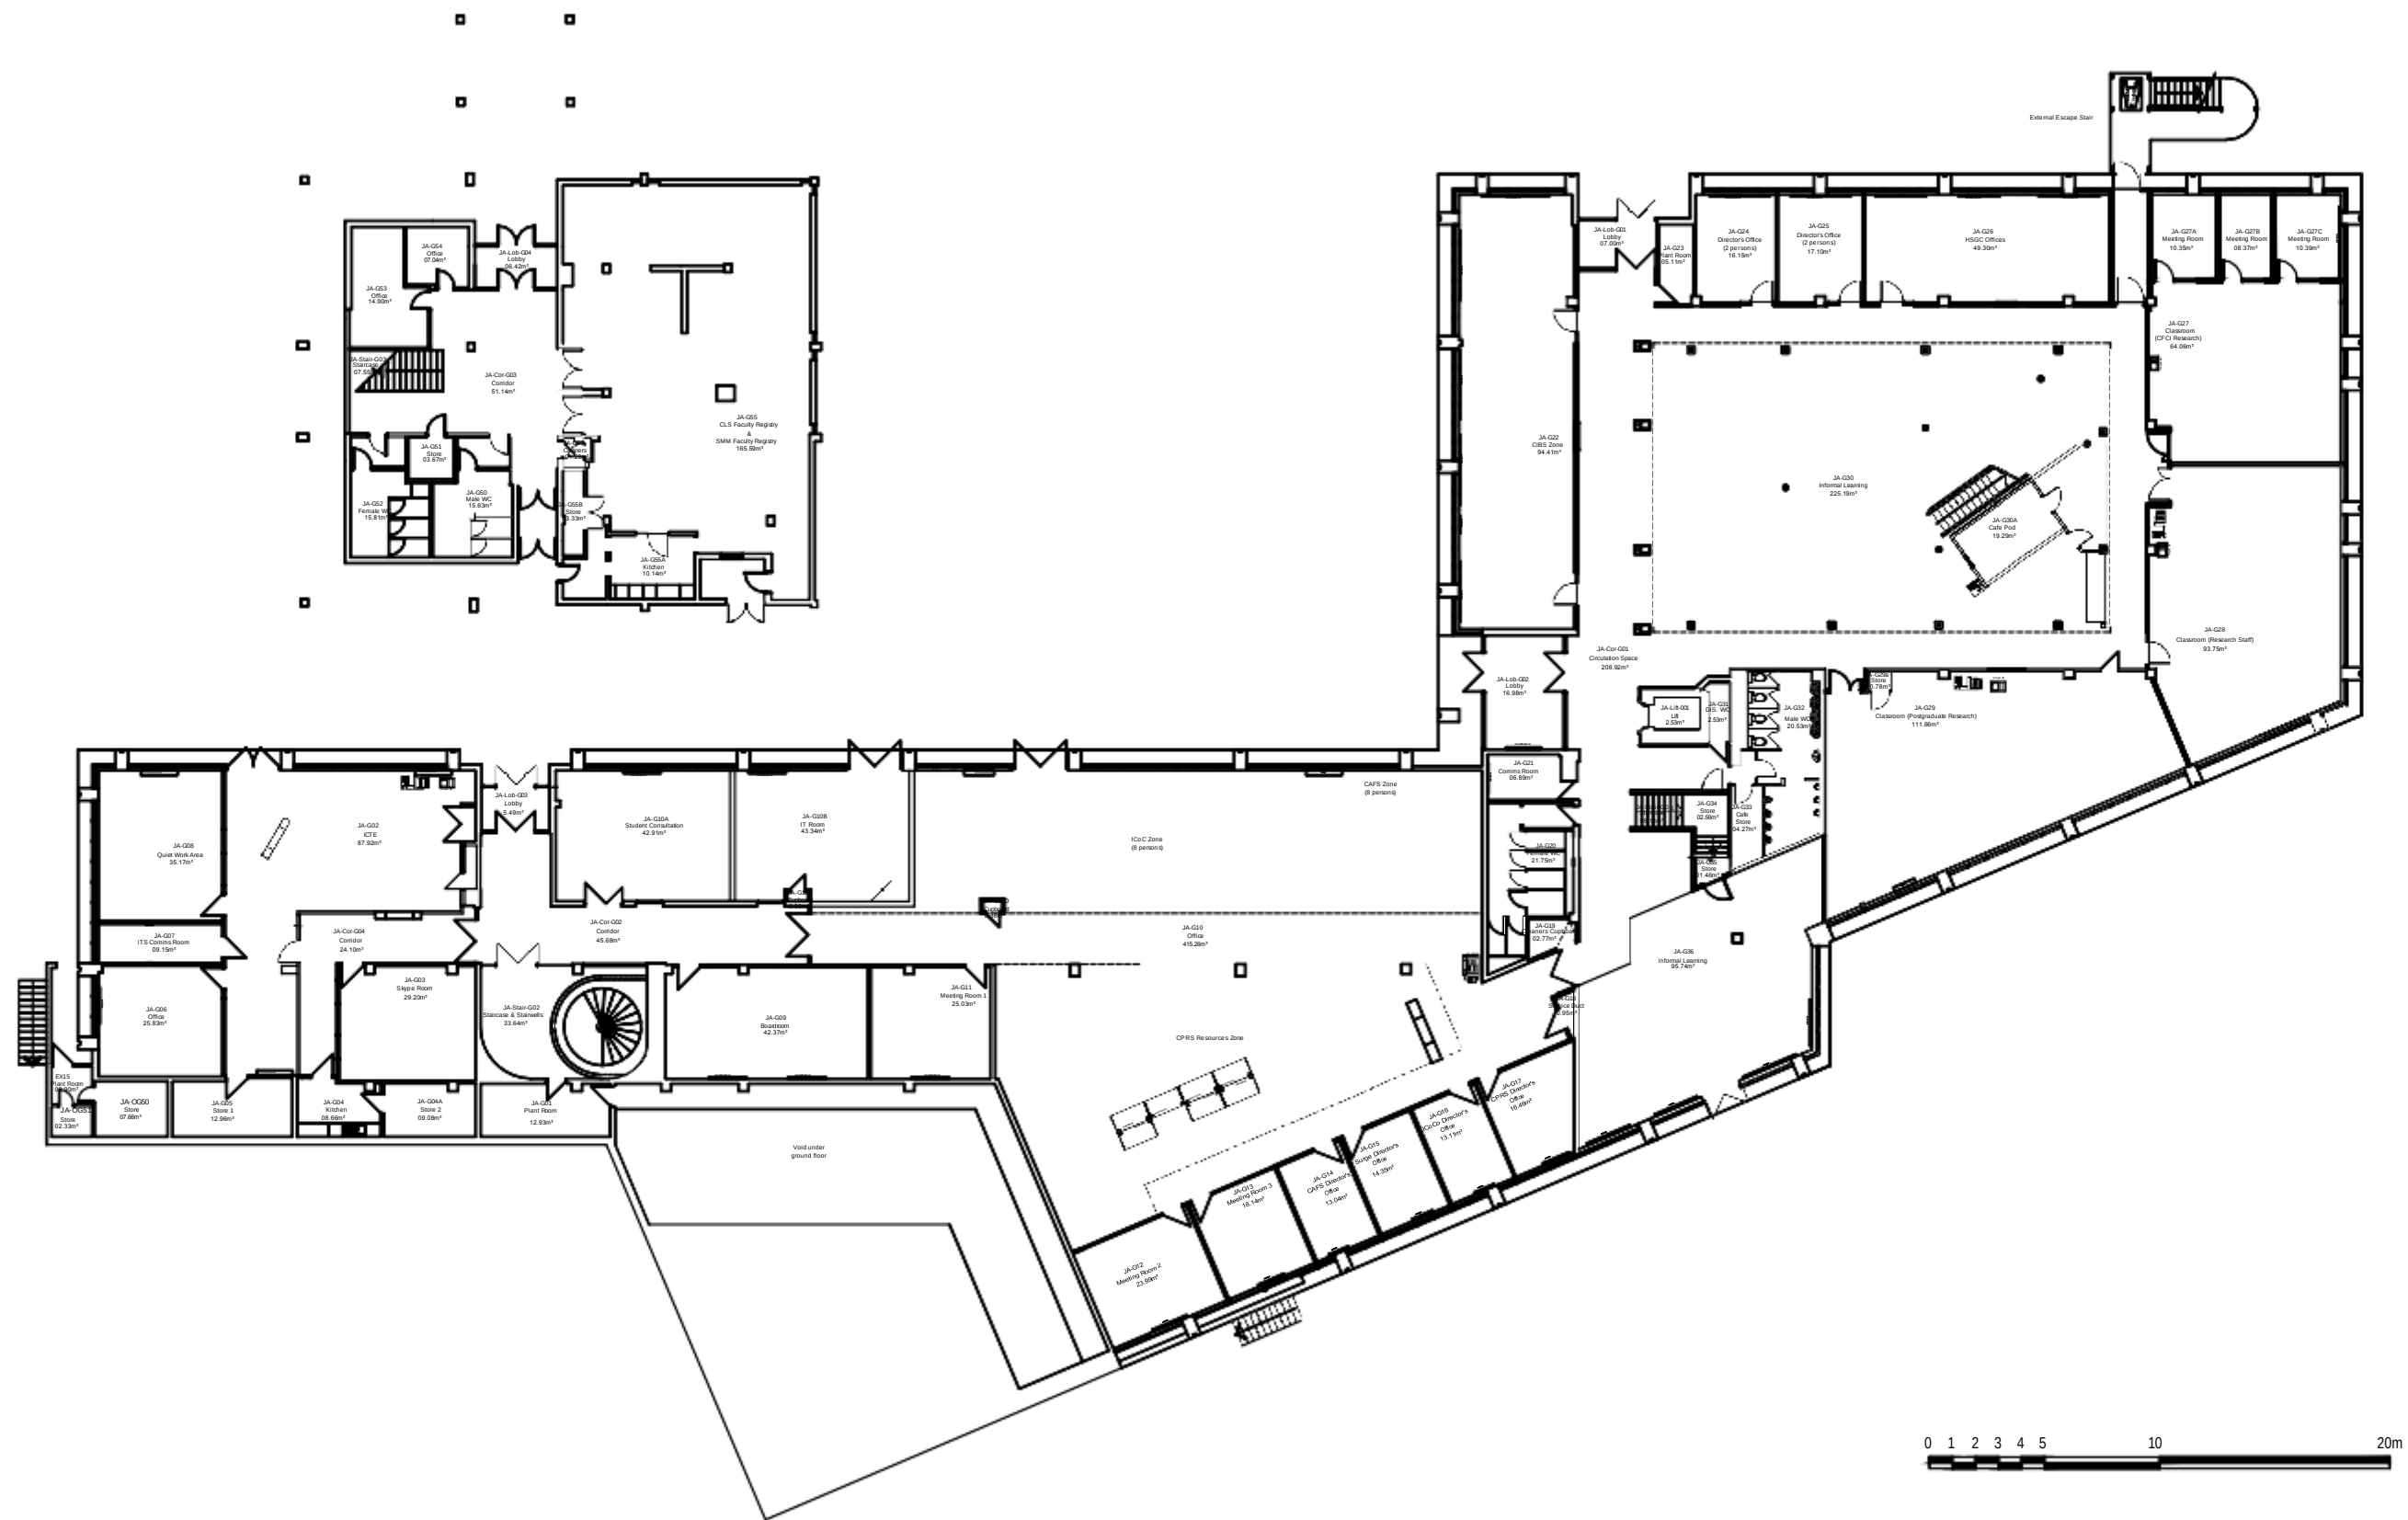

Ground Floor Plan

NOTES

This Drawing is The Copyright Of Coventry University Estates Department & Must Not Be Reproduced Without Their Permission. Figured Dimensions Must Be Taken In Preference To Scaled Dimensions & All Dimensions Must Be Verified On Site Prior To Commencing Any Works.

AREAS

GIA (Gross Internal Area)	2546.50 m ²
NIA (Net Internal Area)	1883.16 m ²



A	06/05/22	Plan amended to show new Research Facilities
Rev.	Date	Amendment



Estates Department
Priory Street, Coventry
CV1 5FB
Tel: 024 76887688
Fax: 024 76887336

CURRENT STATUS

RECORD DRAWING

PROJECT


JAGUAR BUILDING

TITLE

GROUND FLOOR PLAN

DRAWN	EM	CHKD	CHKD	DATE	11/07/2019
-------	----	------	------	------	------------

SCALE	1/200 @ A1	DRAWING No.	JA001-COV-00-GF-M2-A	REV.	A
-------	------------	-------------	----------------------	------	---

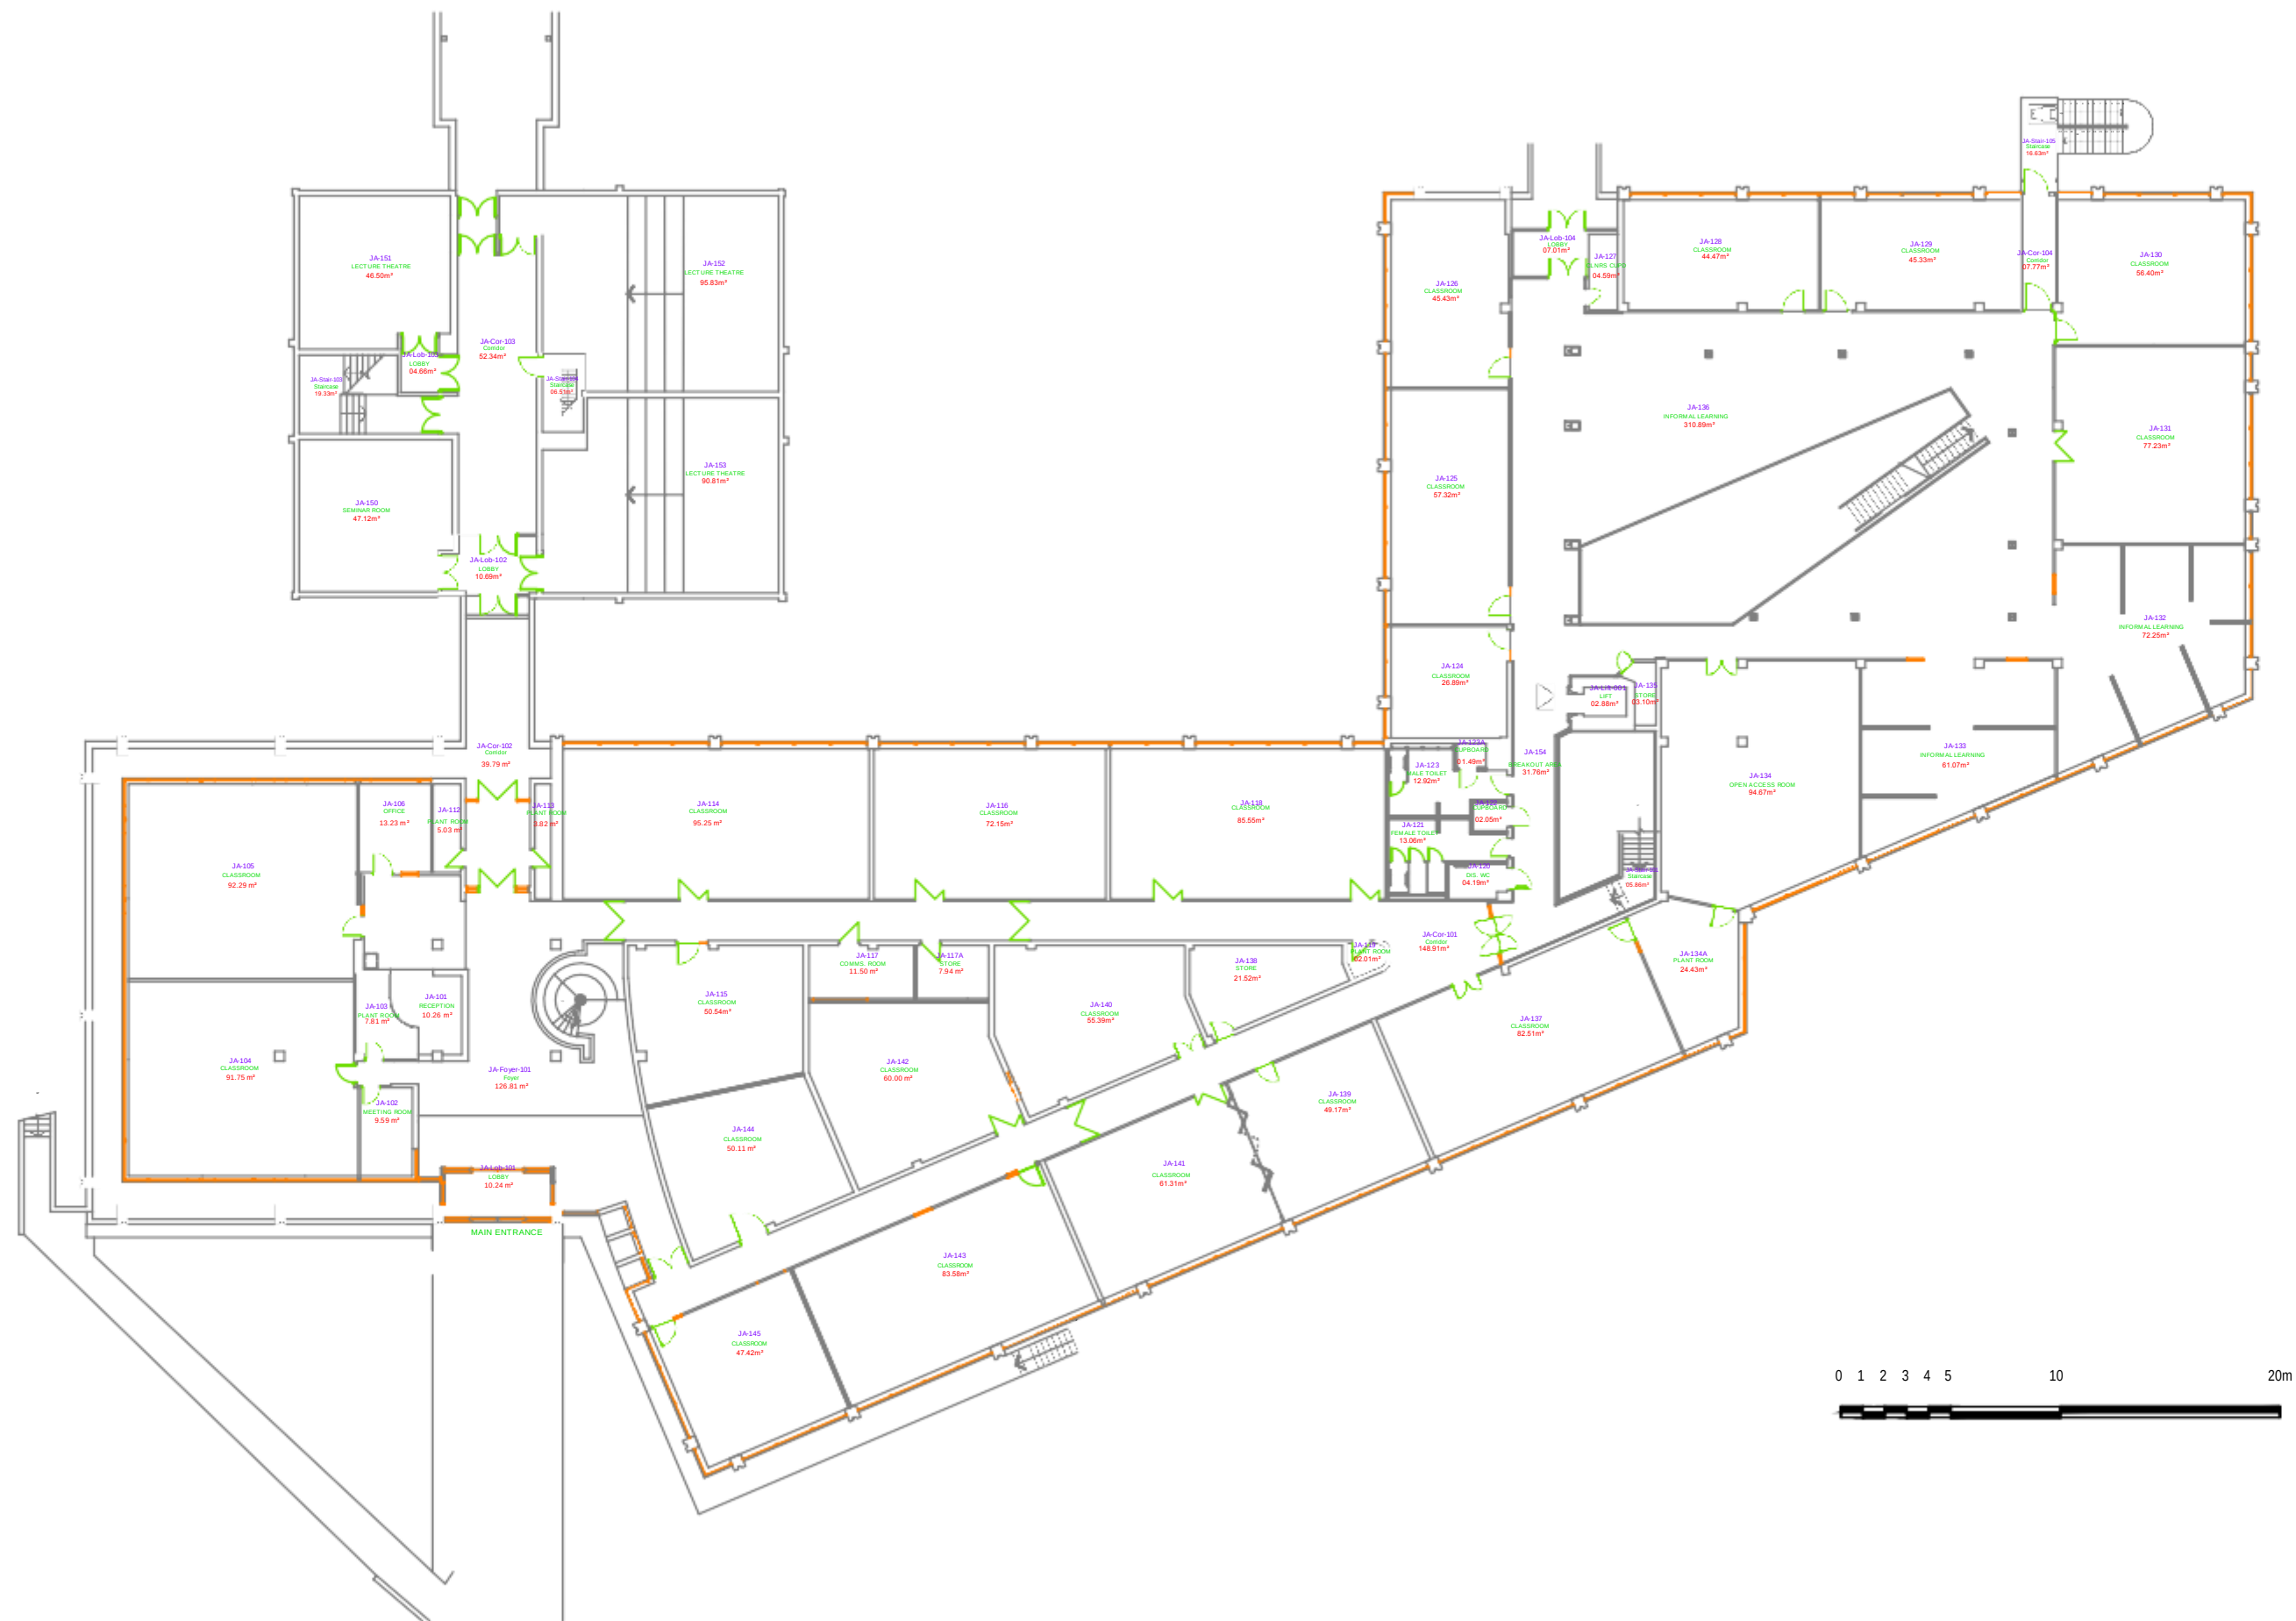

NOTES

This Drawing is The Copyright Of Coventry University
Estates Department & Must Not Be Reproduced
Without Their Permission. Figured Dimensions Must Be
Taken in Preference To Scaled Dimensions & All
Dimensions Must Be Verified On Site Prior To
Commencing Any Works.

AREAS

GIA (Gross Internal Area) 3044.55



A	17-09-21	JA-105-110 replaced by classrooms JA-104&105
Rev.	Date	Amendment



Estates Department
Priory Street, Coventry
CV1 5FB
Tel: 024 76887688
Fax: 024 76887336

CURRENT STATUS

RECORD DRAWING

PROJECT


JAGUAR BUILDING

TITLE

FIRST FLOOR PLAN

DRAWN EM CHKD CHKD DATE 02/02/2019

SCALE 1/200 @ A2 DRAWING No. JA001-COV-00-01-M2-A REV. A

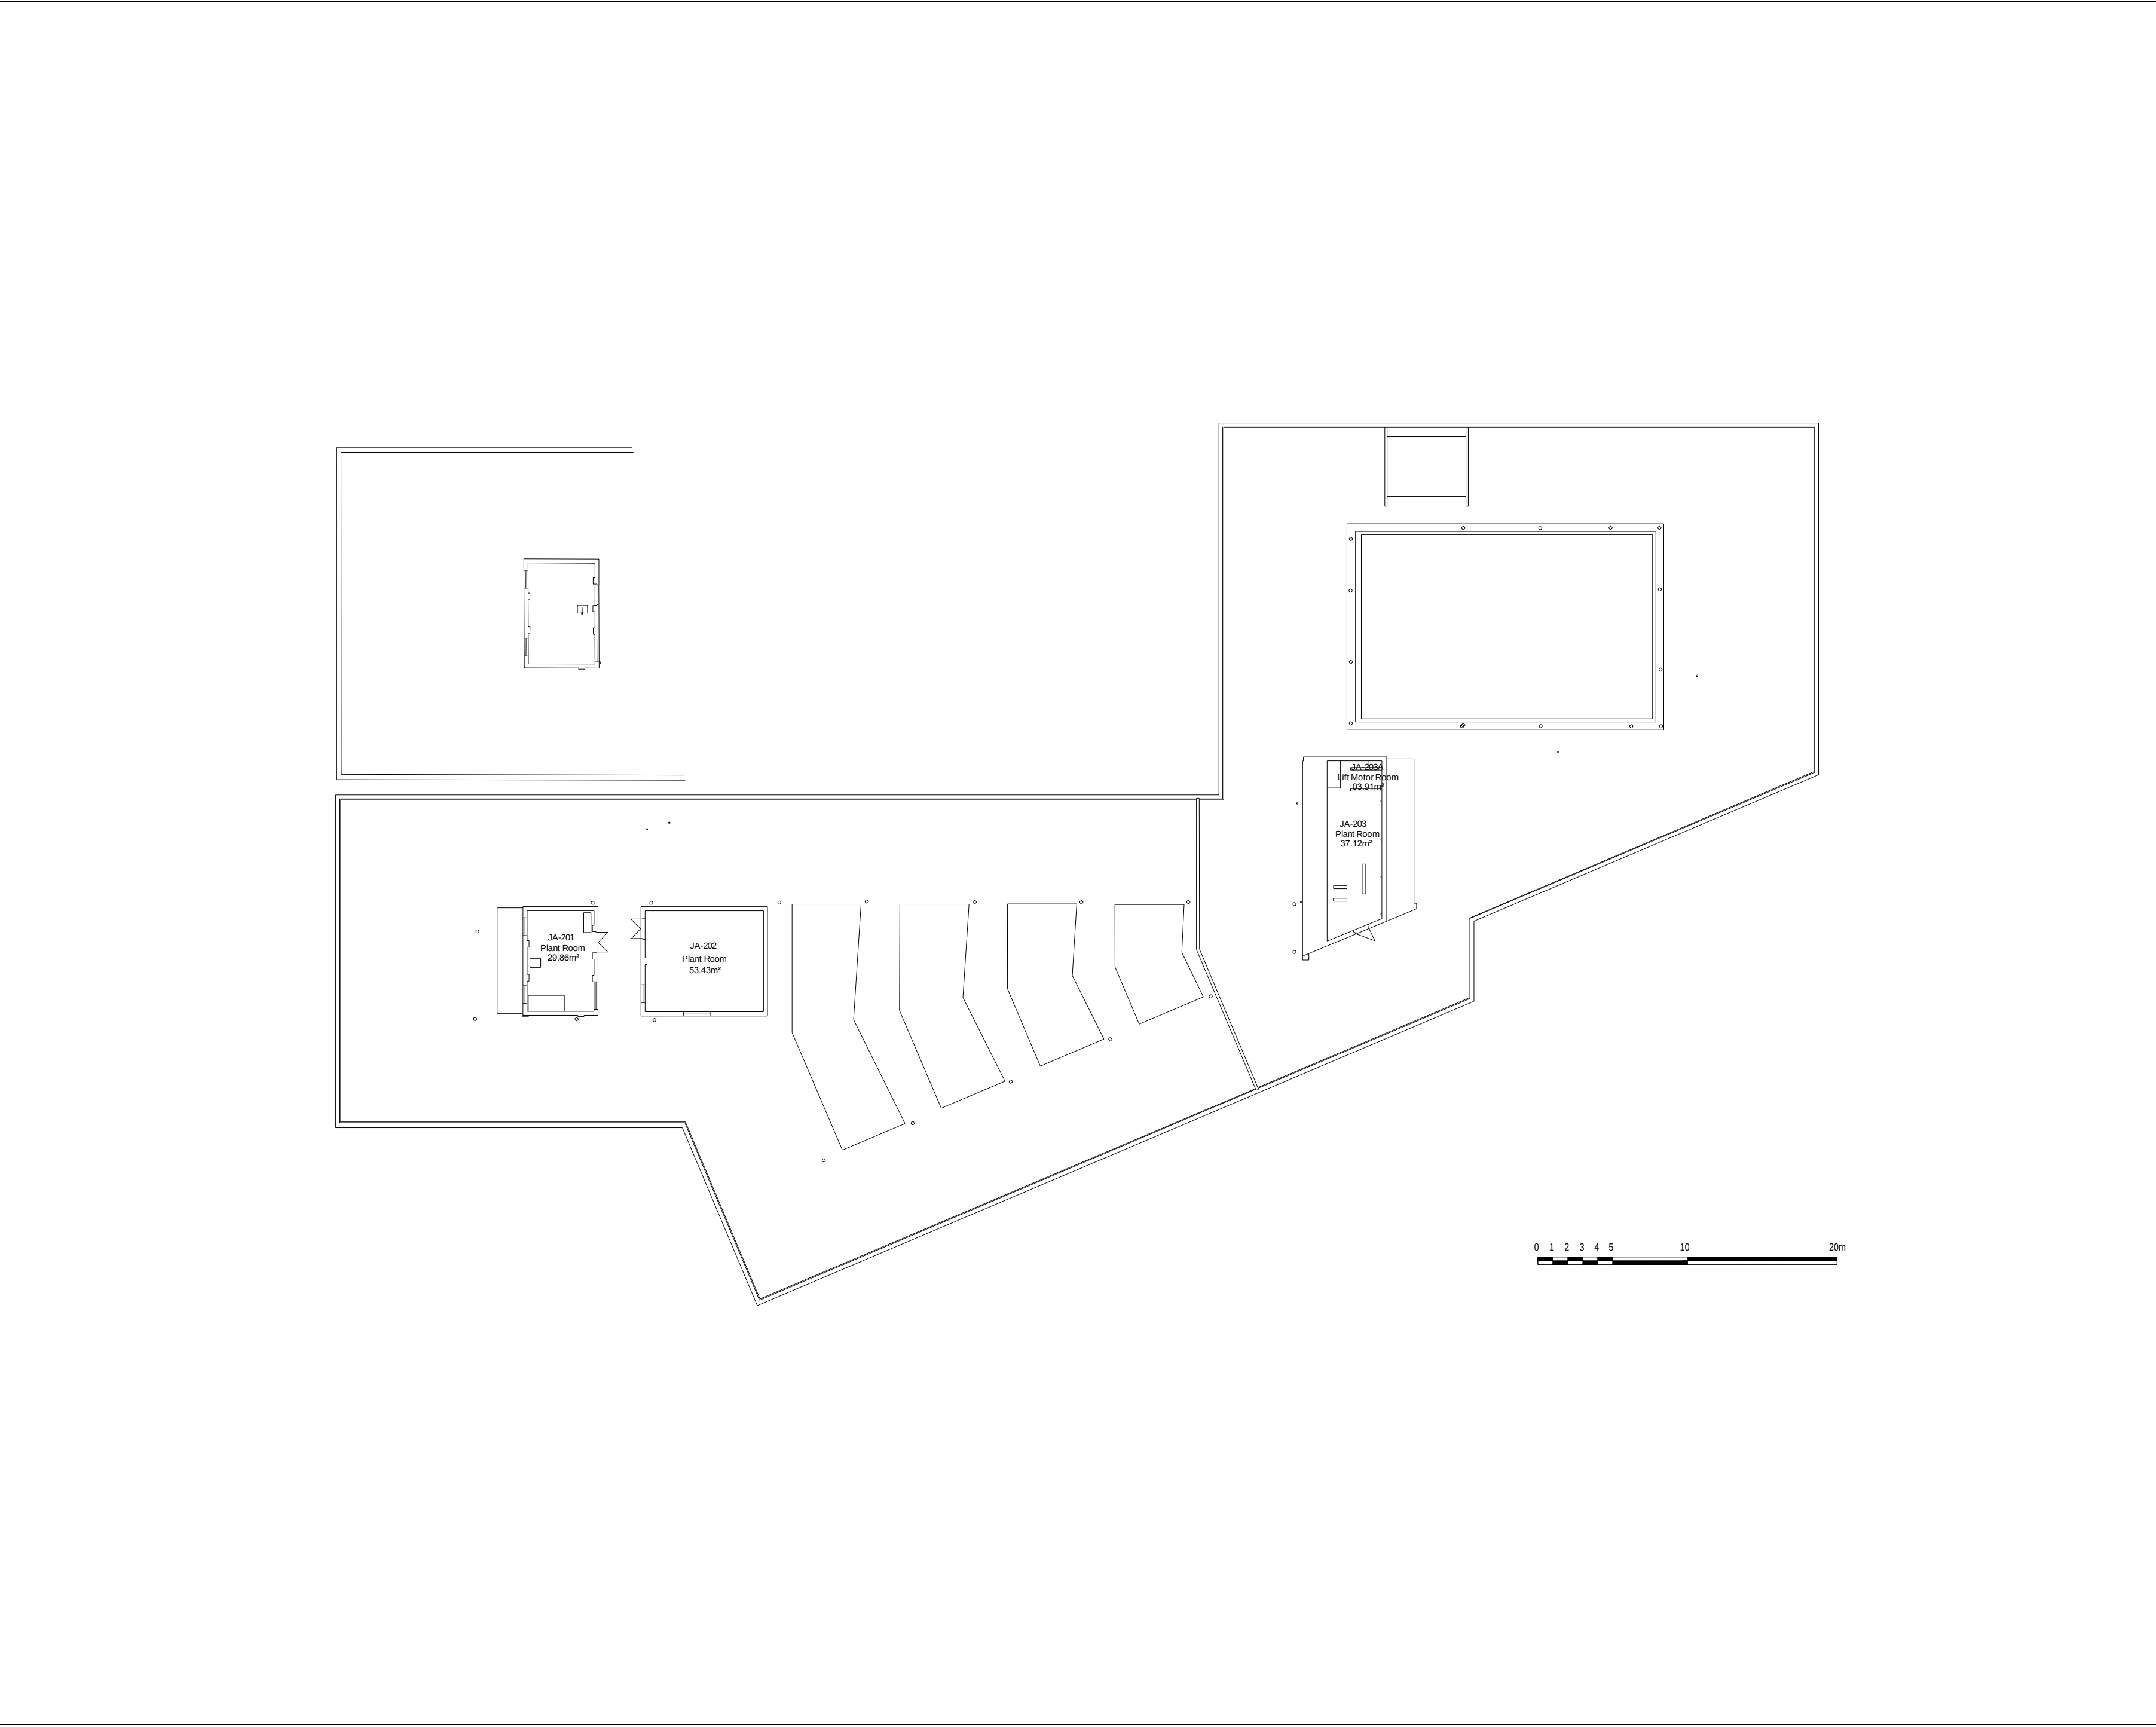

NOTES

This Drawing Is The Copyright Of Coventry University
Estates Department & Must Not Be Reproduced
Without Their Permission. Figured Dimensions Must Be
Taken In Preference To Scaled Dimensions & All
Dimensions Must Be Verified On Site Prior To
Commencing Any Works.

AREAS

GIA (Gross Internal Area)	120.41 m²

Rev.	Date	Amendment

Coventry
University

Estates Department
Priority Street, Coventry
CV1 5FB
Tel: 024 76887688
Fax: 024 76887336

CURRENT STATUS

RECORD DRAWING

PROJECT

JAGUAR BUILDING

TITLE

ROOF PLAN

DRAWN EM	CHKD CHKD	DATE 25/06/2019
-------------	--------------	--------------------

SCALE 1/100 @ A1	DRAWING No. JA001-COV-00-RF-M2-A	REV. 0000
---------------------	-------------------------------------	--------------