


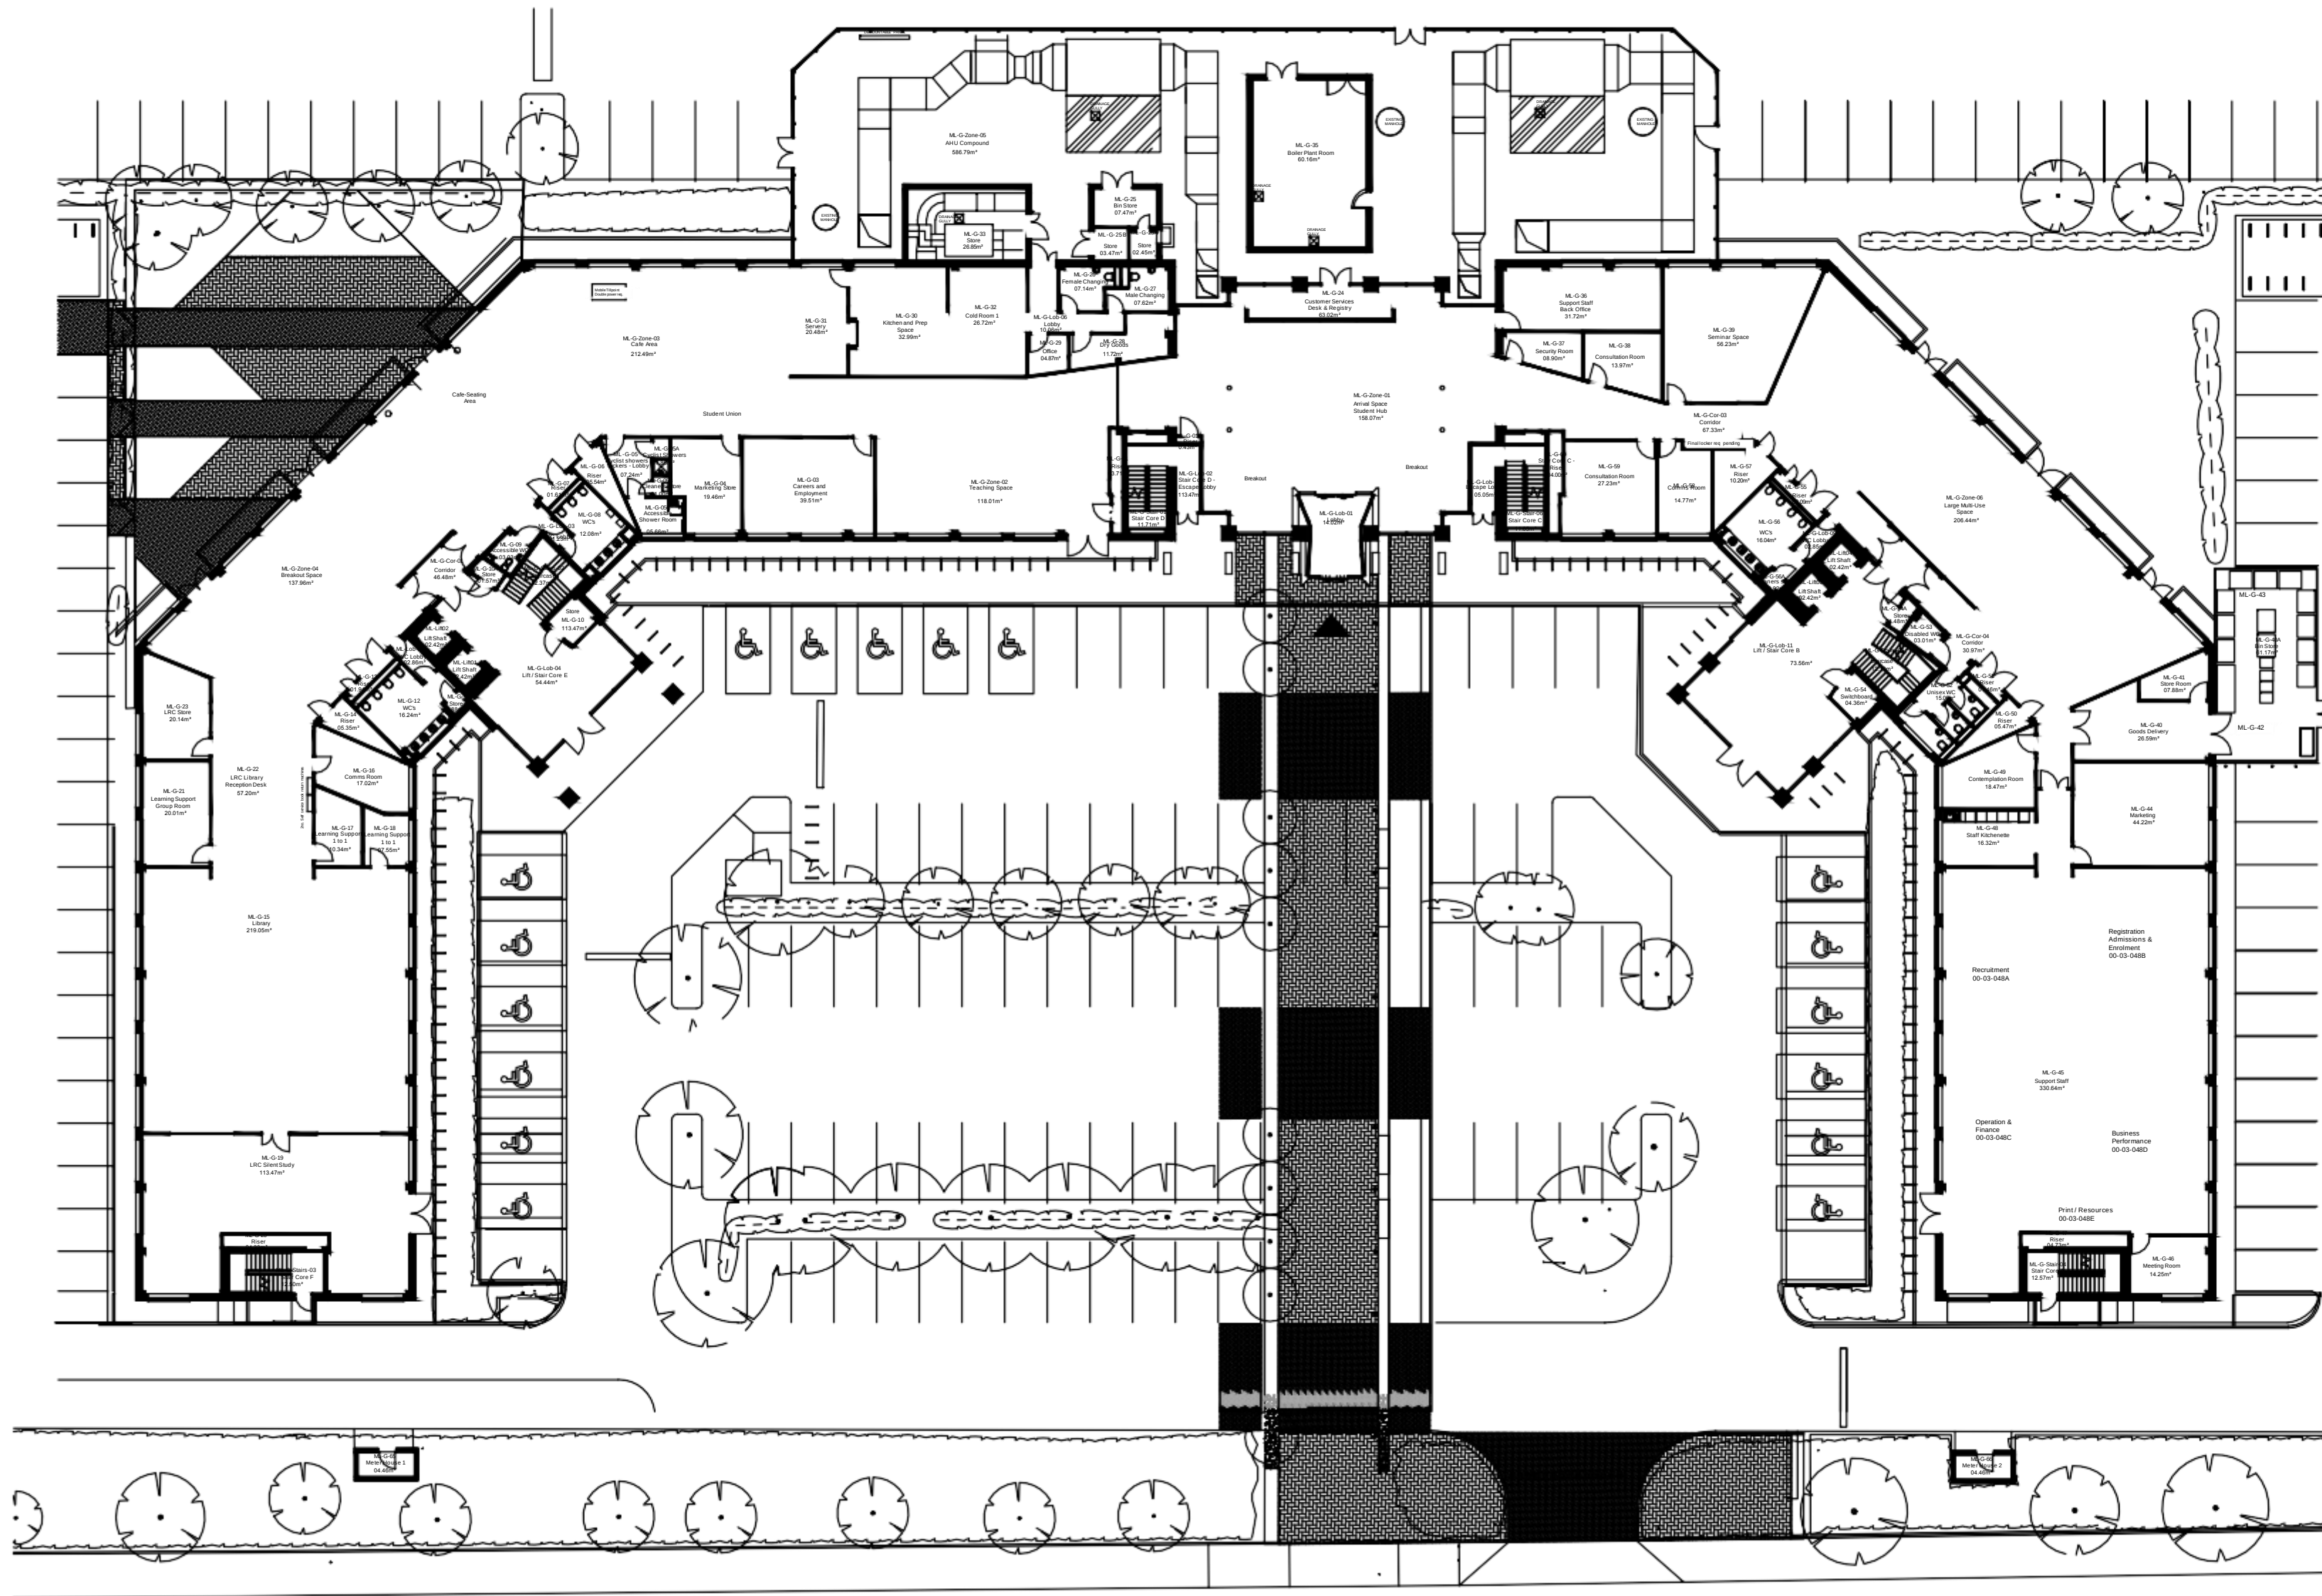

NOTES

This Drawing Is The Copyright Of Coventry University Estates Department & Must Not Be Reproduced Without Their Permission. Figured Dimensions Must Be Taken In Preference To Scaled Dimensions & All Dimensions Must Be Verified On Site Prior To Commencing Any Works.

AREAS

GIA (Gross Internal Area) 2793.70 m²



Rev. Date Amendment



Estates Department
Priory Street, Coventry
CV1 5FB
Tel: 024 76887688
Fax: 024 76887336

CURRENT STATUS

RECORD DRAWING

PROJECT


MILE LANE BUILDING

TITLE

AS BUILT GROUND FLOOR PLAN

DRAWN EM CHKD CHKD DATE 20/02/2019

SCALE 1/200 @ A1 DRAWING No. ML001-COV-00-GF-M2-A REV. 0000

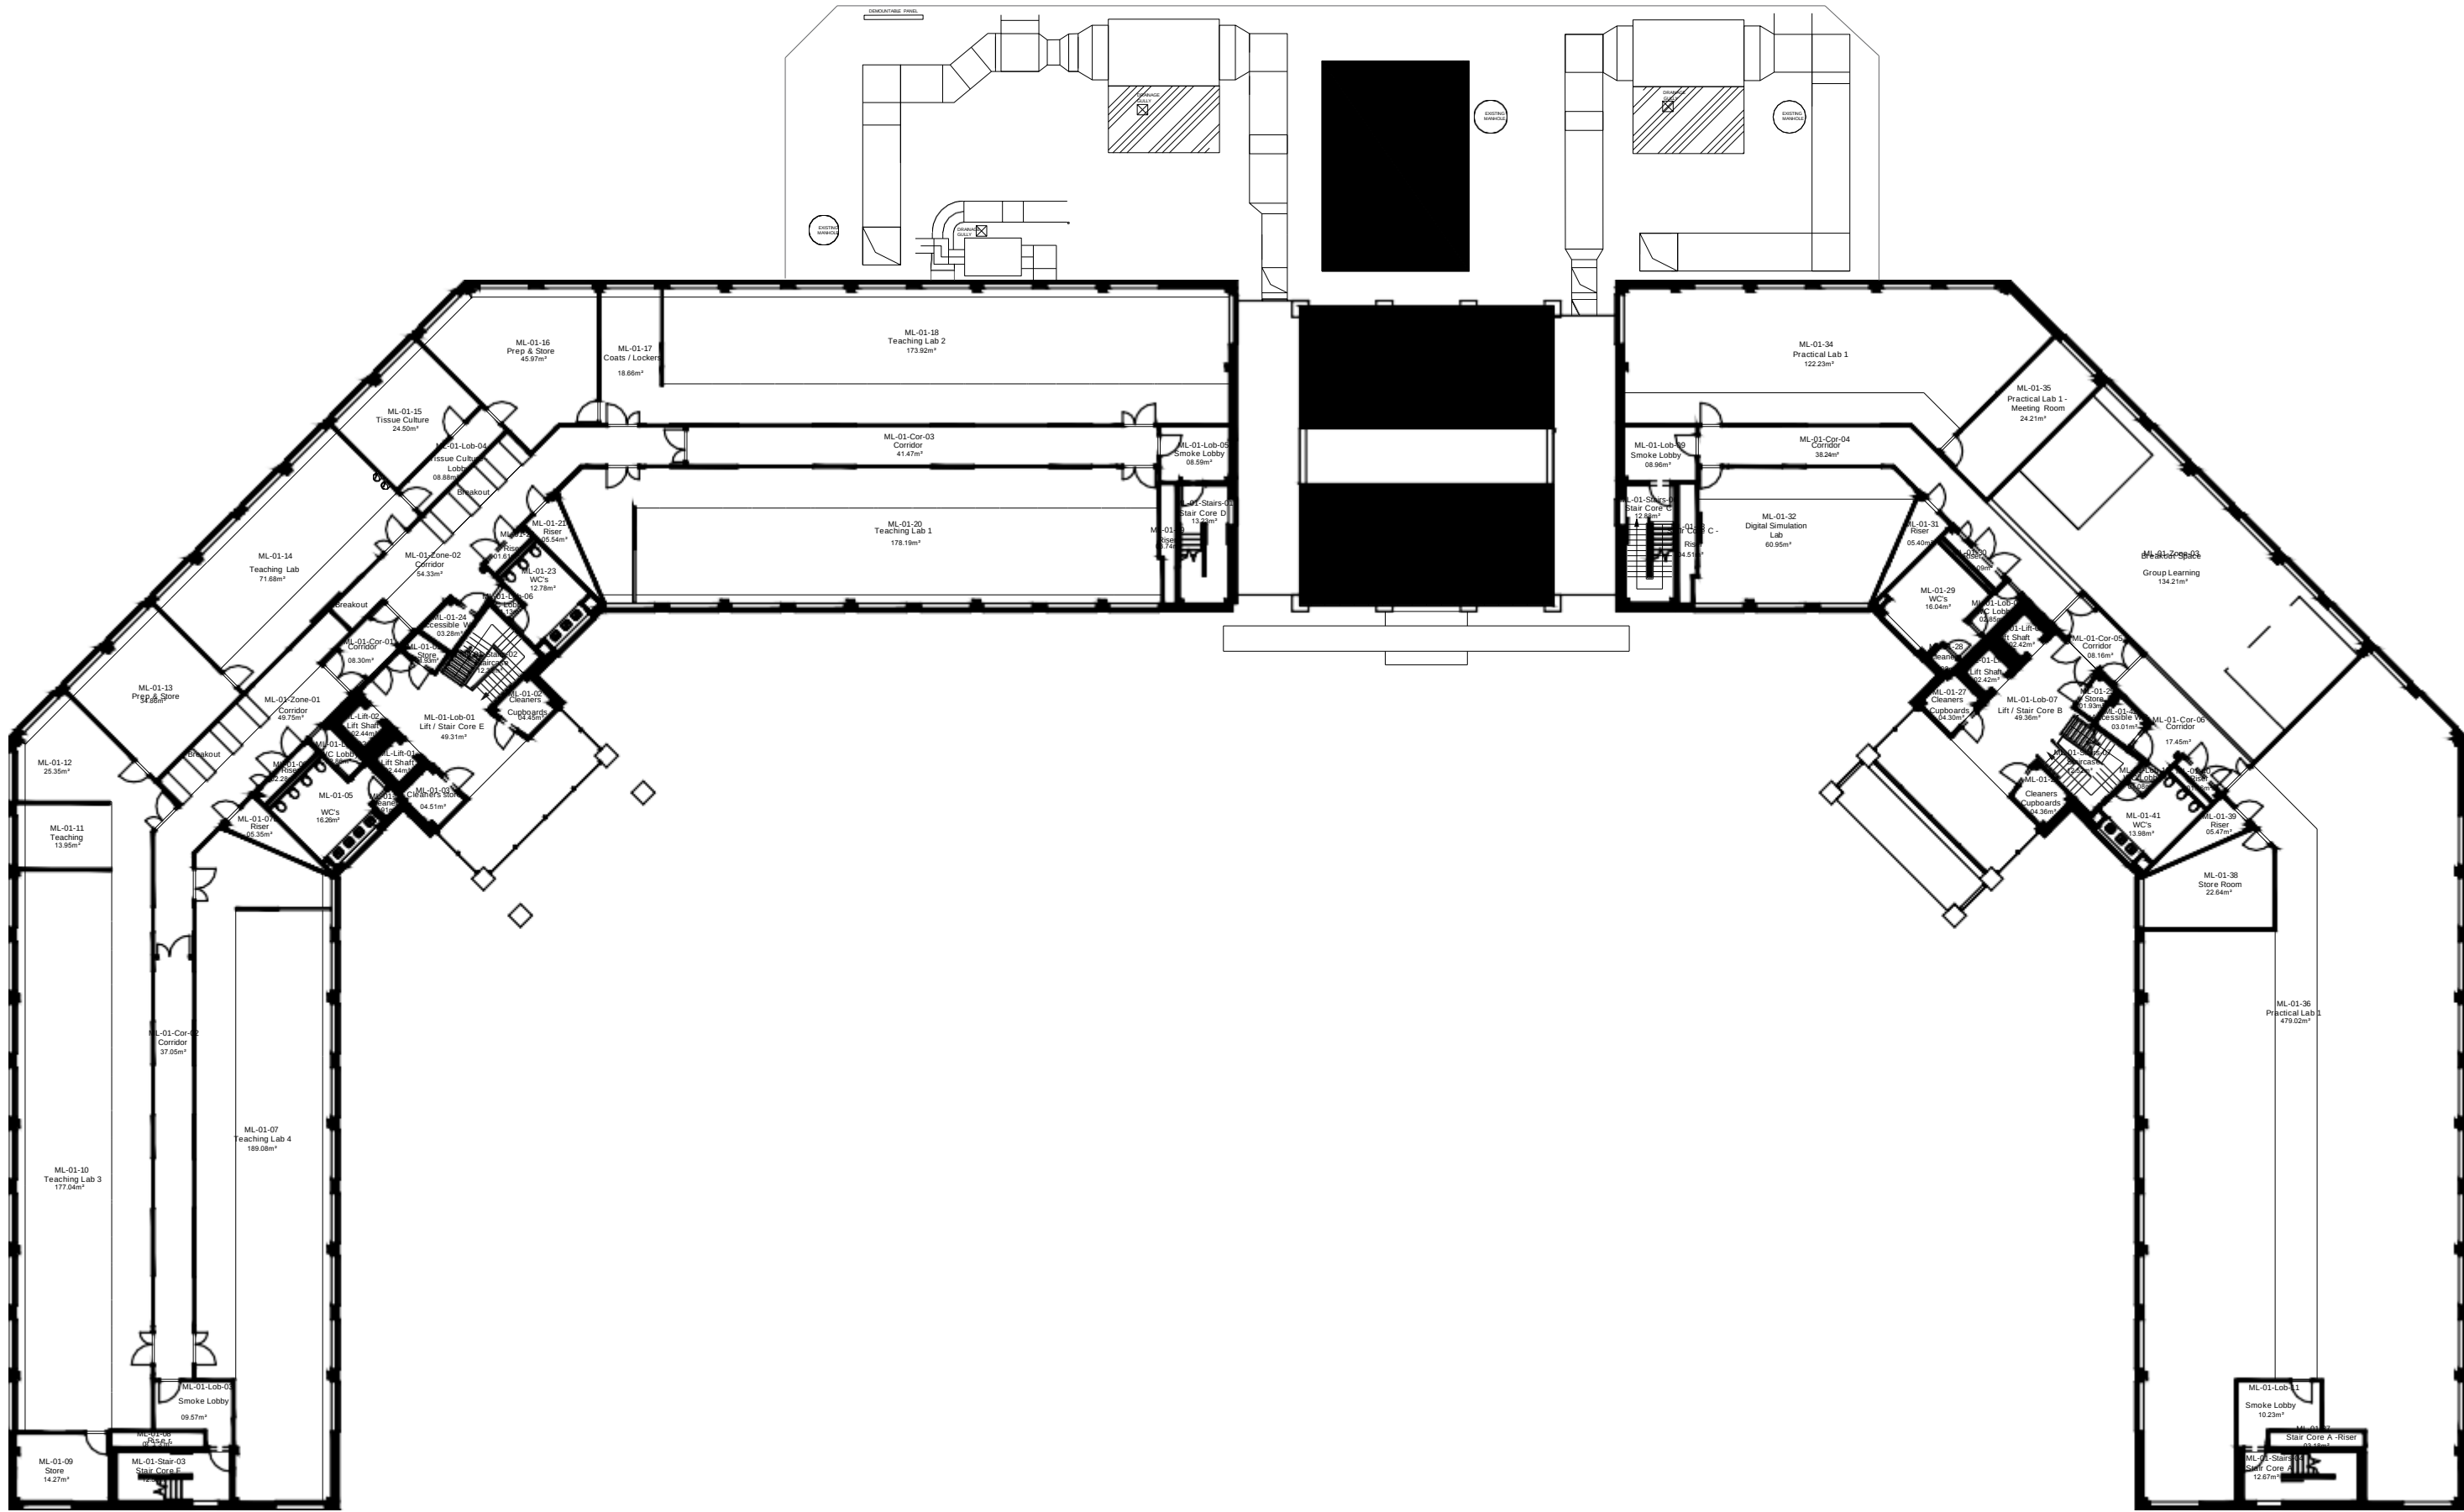

NOTES

This Drawing is The Copyright Of Coventry University
Estates Department & Must Not Be Reproduced
Without Their Permission. Figured Dimensions Must Be
Taken In Preference To Scaled Dimensions & All
Dimensions Must Be Verified On Site Prior To
Commencing Any Works.

AREAS

GIA (Gross Internal Area) 2522.95 m²



Rev.	Date	Amendment



Estates Department
Priory Street, Coventry
CV1 5FB
Tel: 024 76887688
Fax: 024 76887336

CURRENT STATUS

RECORD DRAWING

PROJECT


MILE LANE BUILDING

TITLE

AS BUILT FIRST FLOOR PLAN

DRAWN EM CHKD CHKD DATE 21/02/2019

SCALE 1/200 @ A1 DRAWING No. ML001-COV-00-01-M2-A REV. 0000

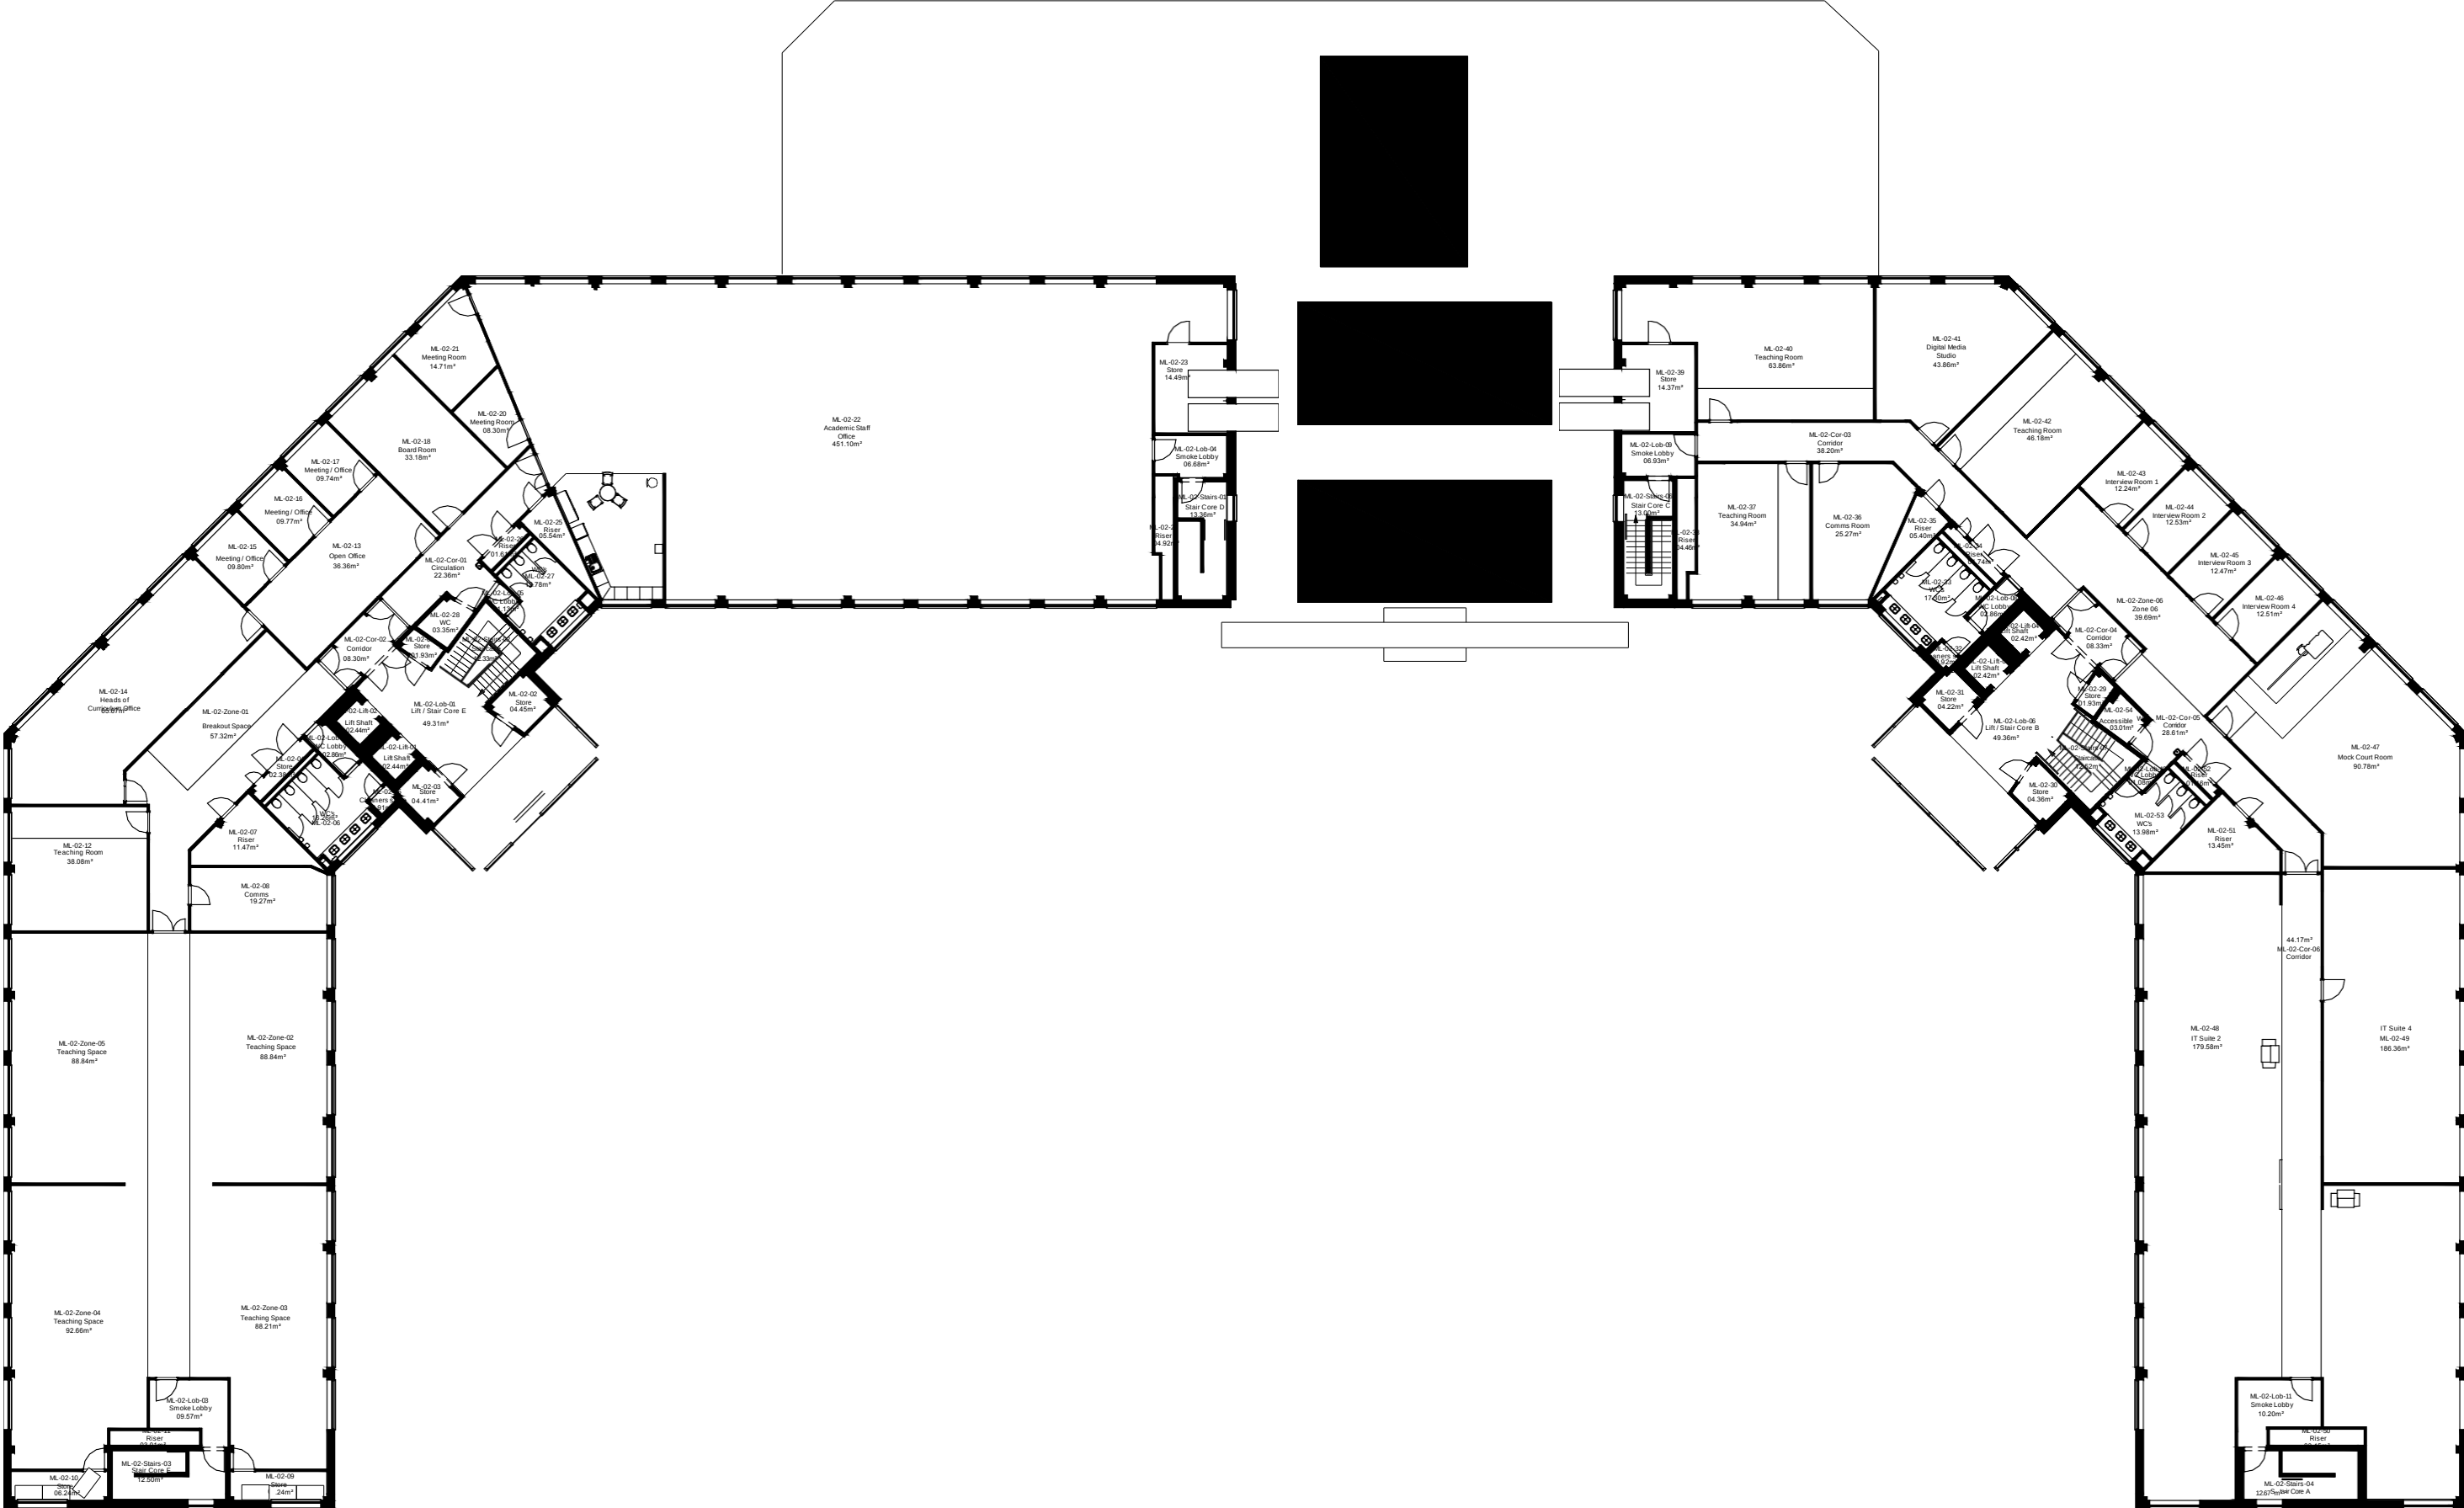

NOTES	
This Drawing is The Copyright Of Coventry University Estates Department & Must Not Be Reproduced Without Their Permission. Figured Dimensions Must Be Taken In Preference To Scaled Dimensions & All Dimensions Must Be Verified On Site Prior To Commencing Any Works.	
AREAS	
GIA (Gross Internal Area)	2522.95 m²



Rev.	Date	Amendment



Estates Department
Priory Street, Coventry
CV1 5FB
Tel: 024 76887688
Fax: 024 76887336

CURRENT STATUS		
RECORD DRAWING		
PROJECT		
MILE LANE BUILDING		
TITLE		
AS BUILT SECOND FLOOR PLAN		
DRAWN	CHKD	DATE
EM	CHKD	21/02/2019
SCALE	DRAWING No.	REV.
1/200 @ A1	ML001-COV-00-02-M2-A	0000

