


NOTES		
This Drawing Is The Copyright Of Coventry University Estates Department & Must Not Be Reproduced Without Their Permission. Figured Dimensions Must Be Taken In Preference To Scaled Dimensions & All Dimensions Must Be Verified On Site Prior To Commencing Any Works.		
AREAS		
GIA (Gross Internal Area)		115.96 m ²
NIA (Net Internal Area)		
GEA (Gross External Area)		
		
 Coventry University Estates Department Phoenix Street, Coventry CV1 5FB Tel: 024 76887688 Fax: 024 76887336		
CURRENT STATUS		
RECORD DRAWING		
PROJECT		
PORTAL HOUSE		
TITLE		
GROUND FLOOR PLAN		
DRAWN		CHKD
PC	KA	DATE 03/03/2020
SCALE		DRAWING No. PO001-COV-00-GF-M2-A
1/50 @ A1	1/100 @ A2	REV. 0000

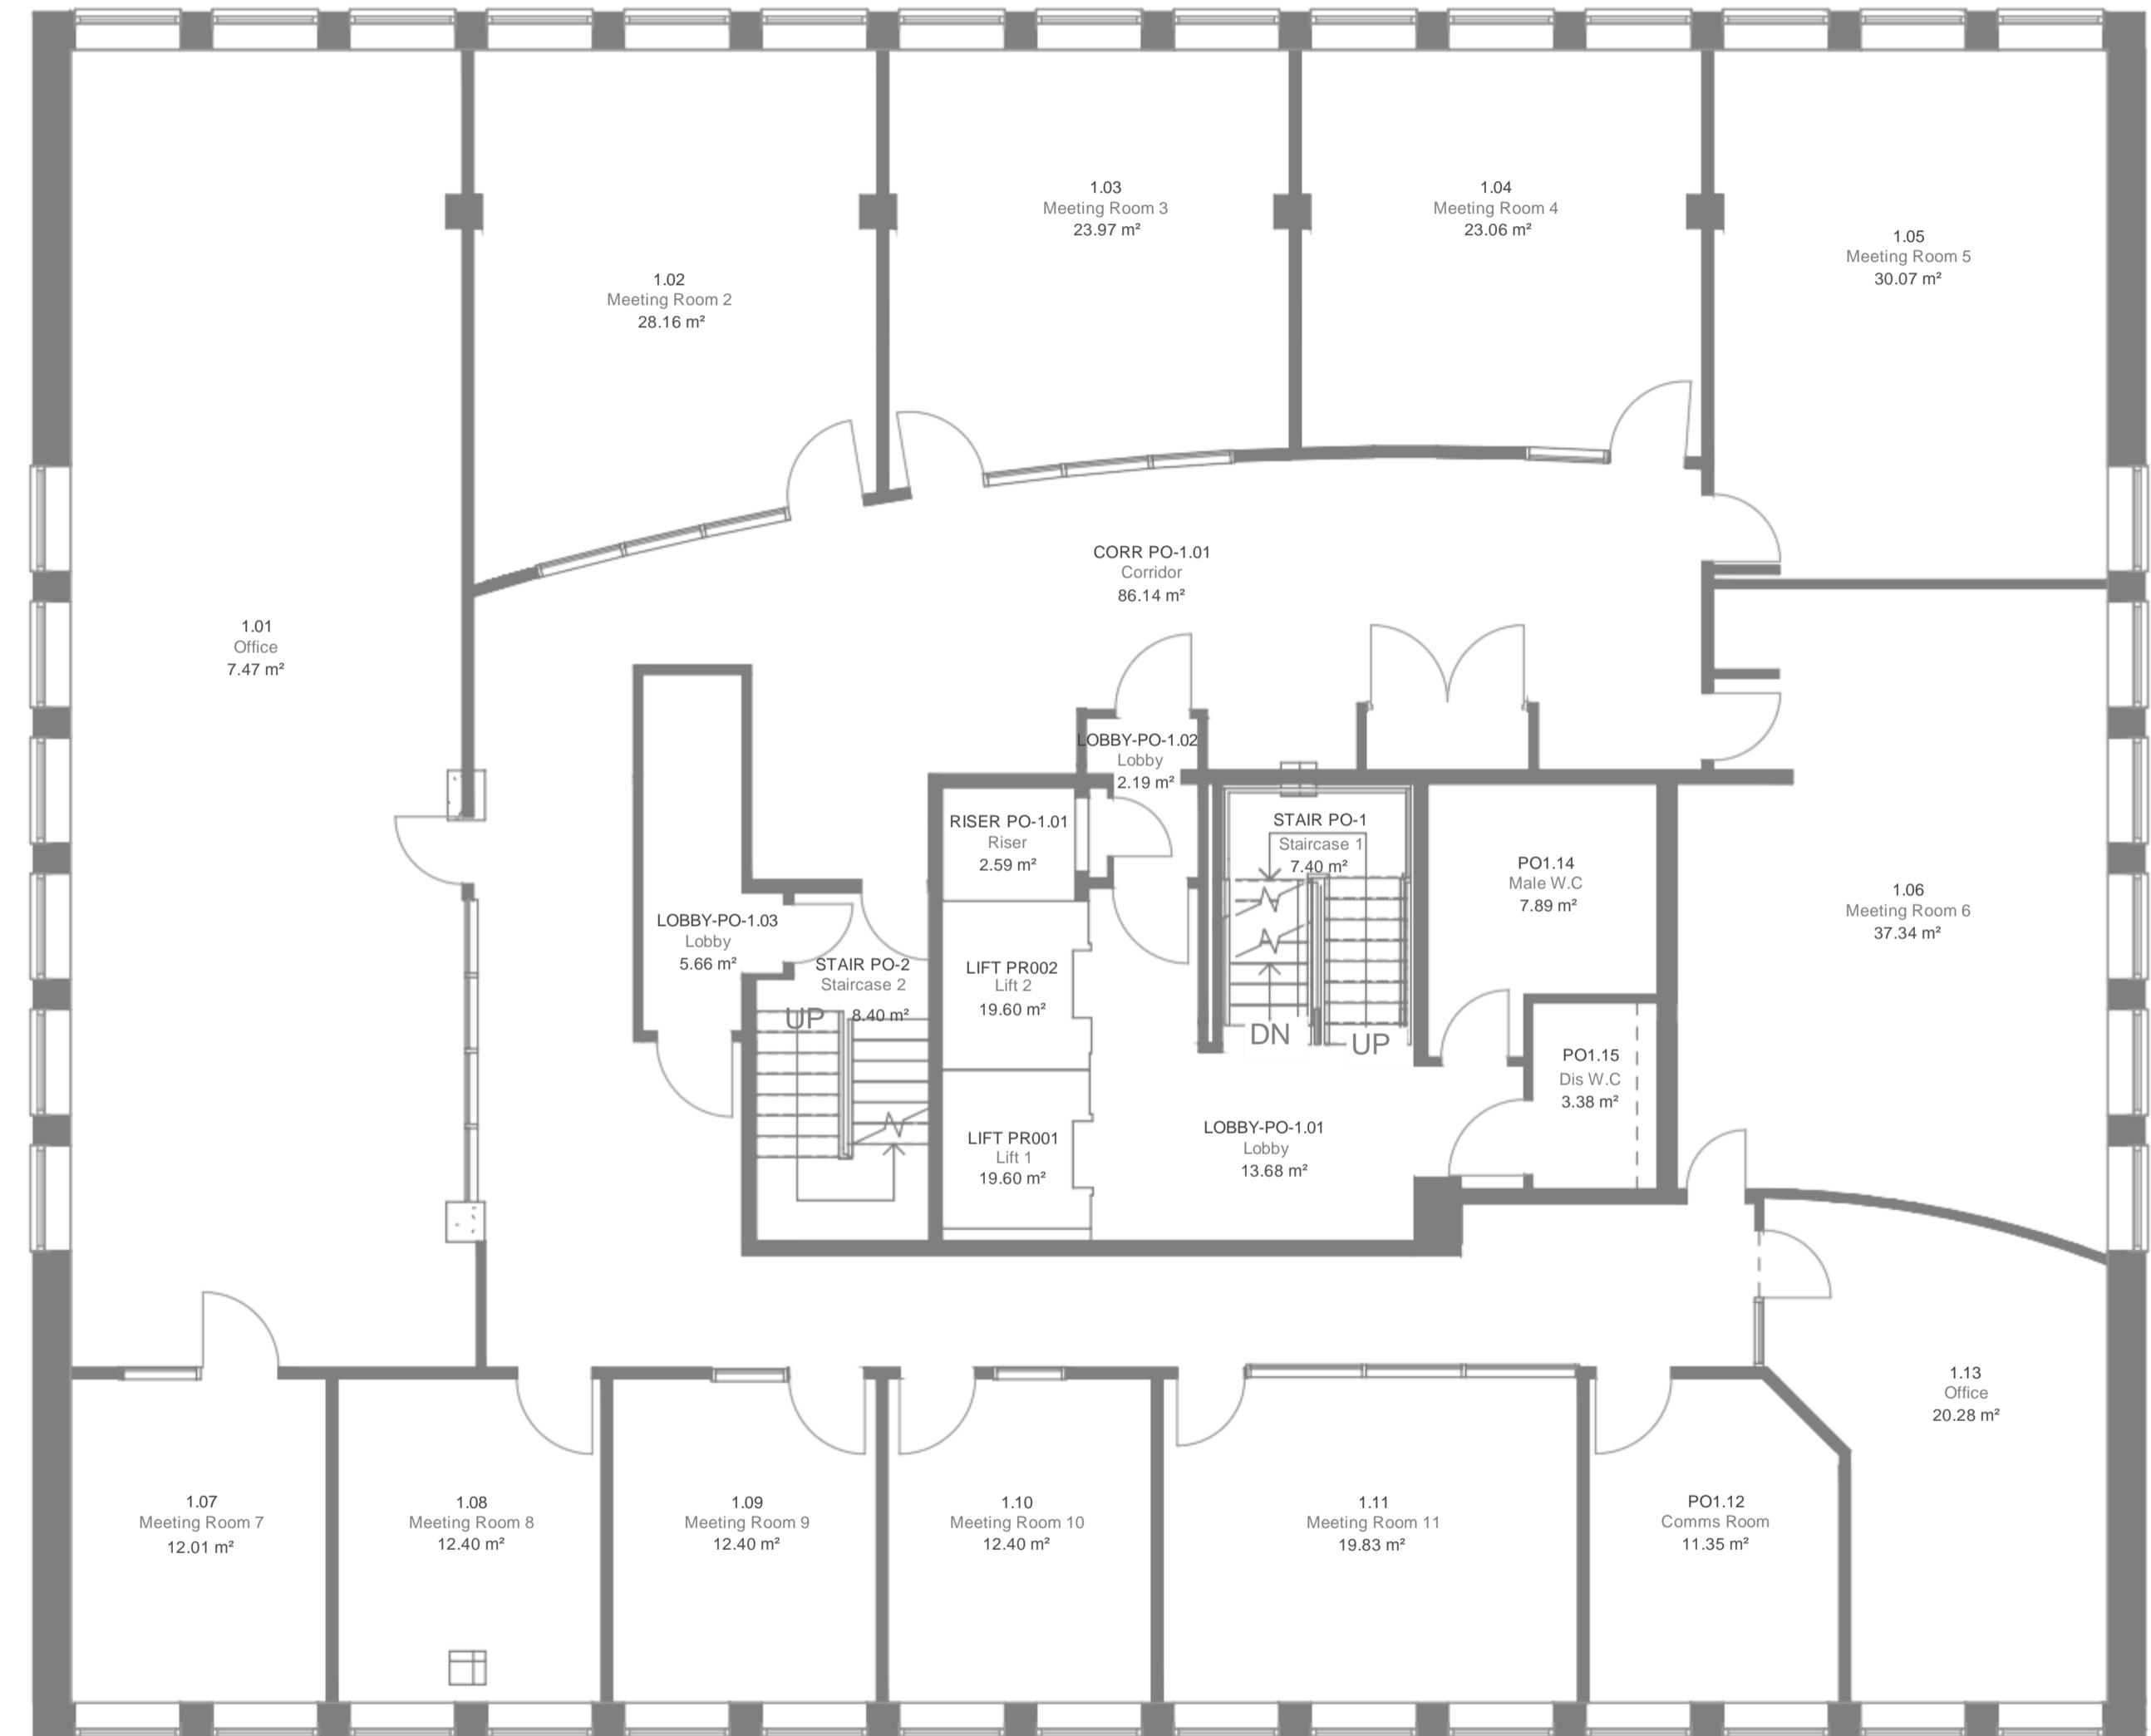

First Floor Plan

NOTES
This Drawing Is The Copyright Of Coventry University Estates Department & Must Not Be Reproduced Without Their Permission. Figured Dimensions Must Be Taken In Preference To Scaled Dimensions & All Dimensions Must Be Verified On Site Prior To Commencing Any Works.

AREAS

GIA (Gross Internal Area)	486.17 m ²
NIA (Net Internal Area)	
GEA (Gross External Area)	



Rev. Date Amendment



Coventry
University

Estate Department
Perry Street, Coventry
CV1 5FB
Tel: 024 76887688
Fax: 024 76887336

CURRENT STATUS

RECORD DRAWING

PROJECT


PORTAL HOUSE

TITLE

FIRST FLOOR PLAN

DRAWN PC CHKD KA DATE 03/03/2020

SCALE 1/50 @ A1 DRAWING No. P001-COV-00-01-M2-A REV. 0000
1/100 @ A2

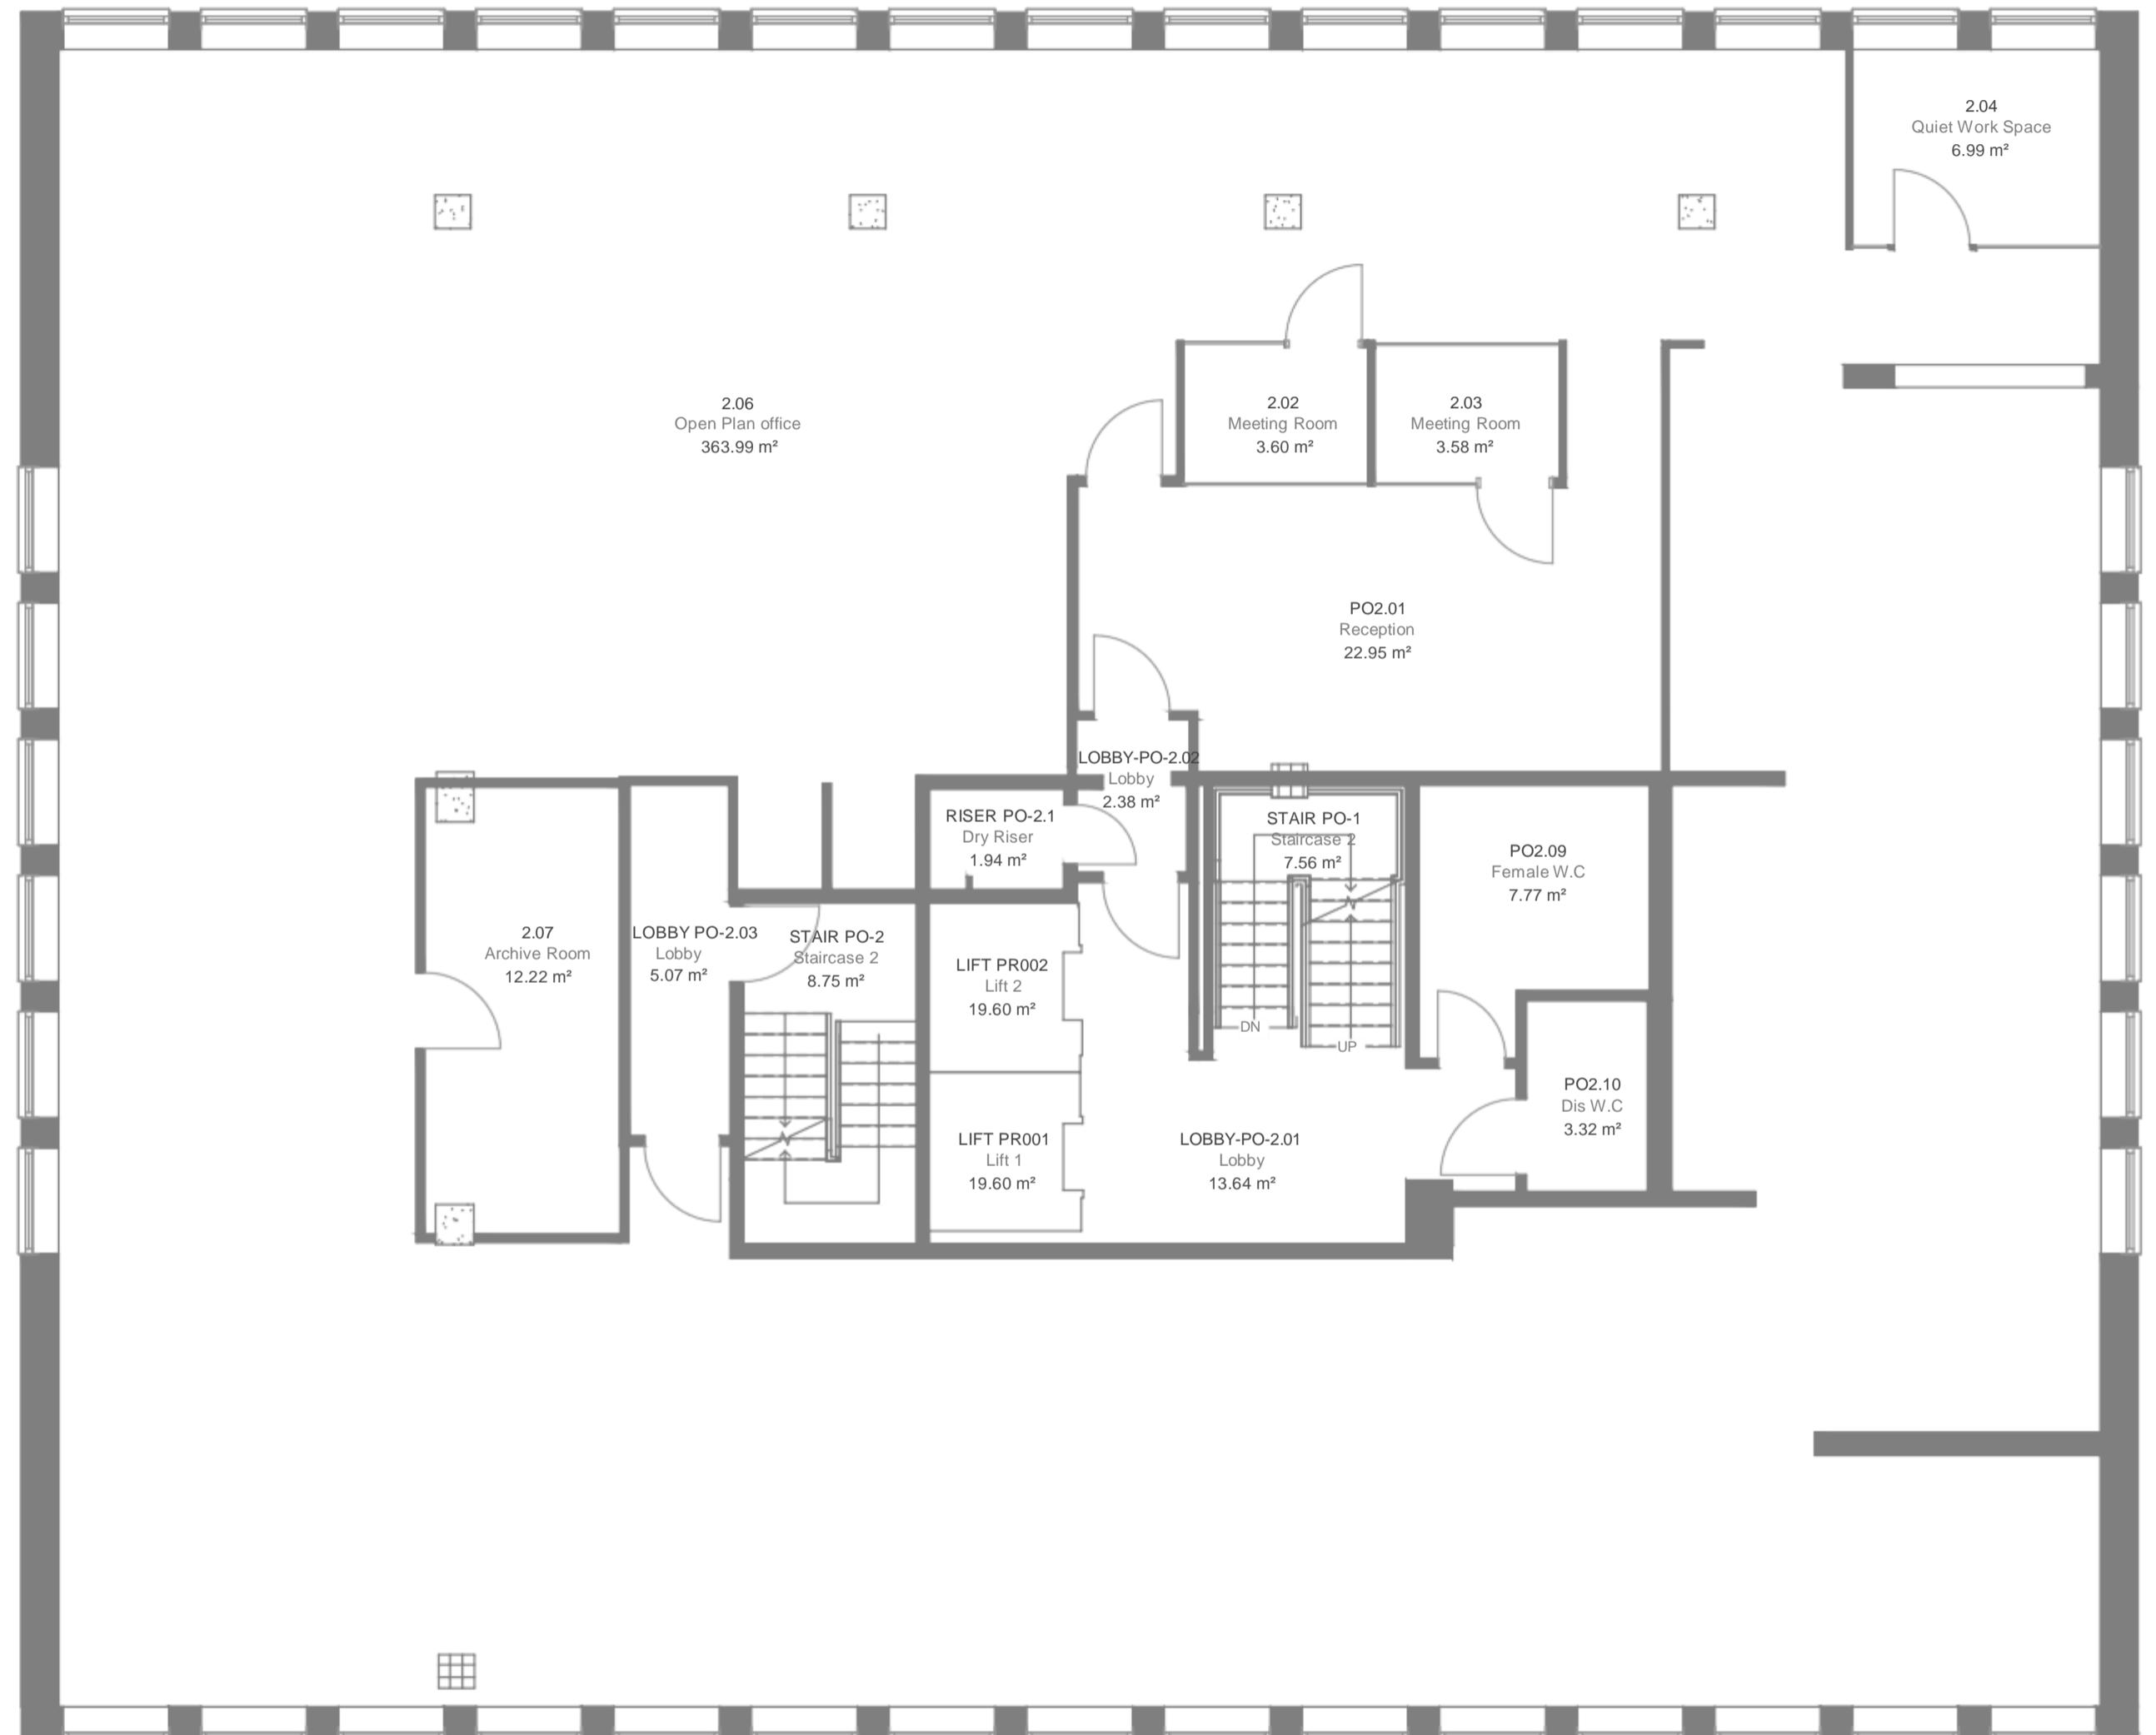

Second Floor Plan

NOTES
This Drawing Is The Copyright Of Coventry University Estates Department & Must Not Be Reproduced Without Their Permission. Figured Dimensions Must Be Taken In Preference To Scaled Dimensions & All Dimensions Must Be Verified On Site Prior To Commencing Any Works.

AREAS

GIA (Gross Internal Area)	486.17 m ²
NIA (Net Internal Area)	
GEA (Gross External Area)	



Rev. Date Amendment



Coventry
University

Estate Department
Perry Street, Coventry
CV1 5FB
Tel: 024 76887688
Fax: 024 76887336

CURRENT STATUS

RECORD DRAWING

PROJECT


PORTAL HOUSE

TITLE

SECOND FLOOR PLAN

DRAWN PC CHKD KA DATE 03/03/2020

SCALE 1/50 @ A1 1/100 @ A2 DRAWING No. P001-COV-00-02-M2-A REV. 0000

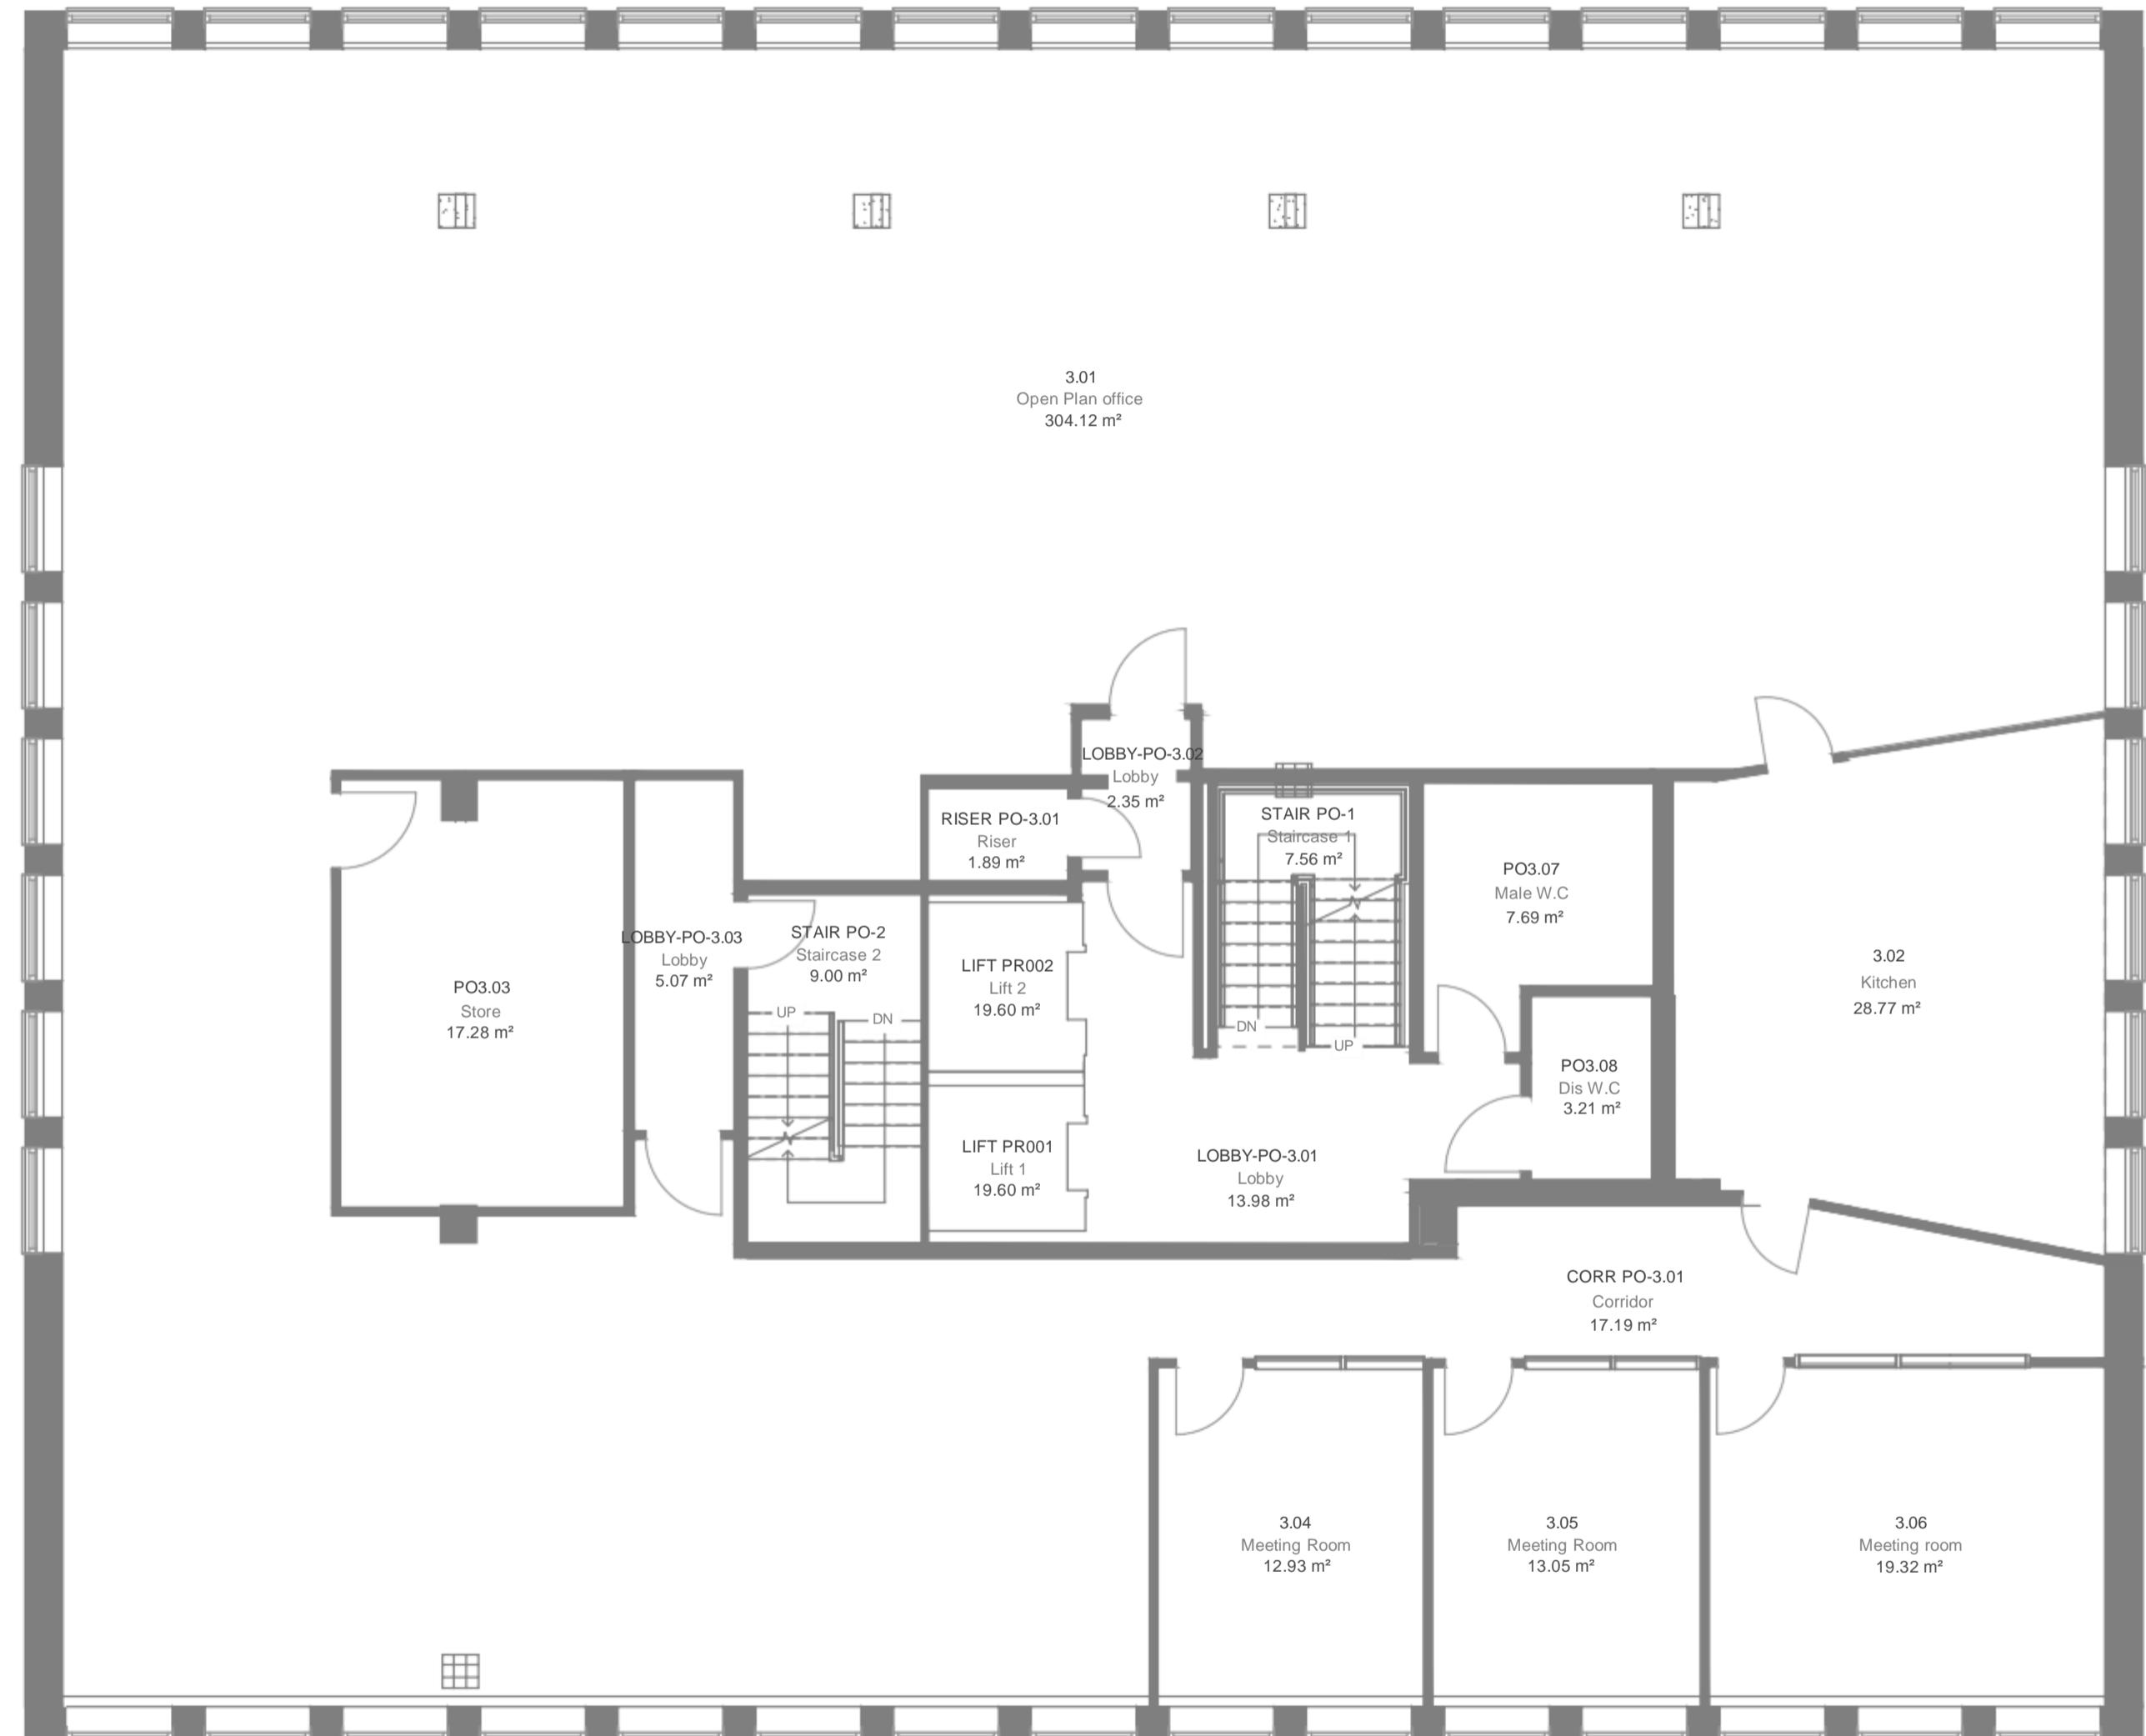

Third Floor Plan

0 1 2 3 4 5 10 m

NOTES
This Drawing Is The Copyright Of Coventry University Estates Department & Must Not Be Reproduced Without Their Permission. Figured Dimensions Must Be Taken In Preference To Scaled Dimensions & All Dimensions Must Be Verified On Site Prior To Commencing Any Works.

AREAS

GIA (Gross Internal Area)	486.17 m ²
NIA (Net Internal Area)	
GEA (Gross External Area)	



Rev. Date Amendment



**Coventry
University**

Estate Department
Pочy Street, Coventry
CV1 5FB
Tel: 024 76887688
Fax: 024 76887336

CURRENT STATUS

RECORD DRAWING

PROJECT


PORTAL HOUSE

TITLE

THIRD FLOOR PLAN

DRAWN PC CHKD KA DATE 03/03/2020

SCALE 1/50 @ A1 DRAWING No. P001-COV-00-03-M2-A REV. 0000
1/100 @ A2

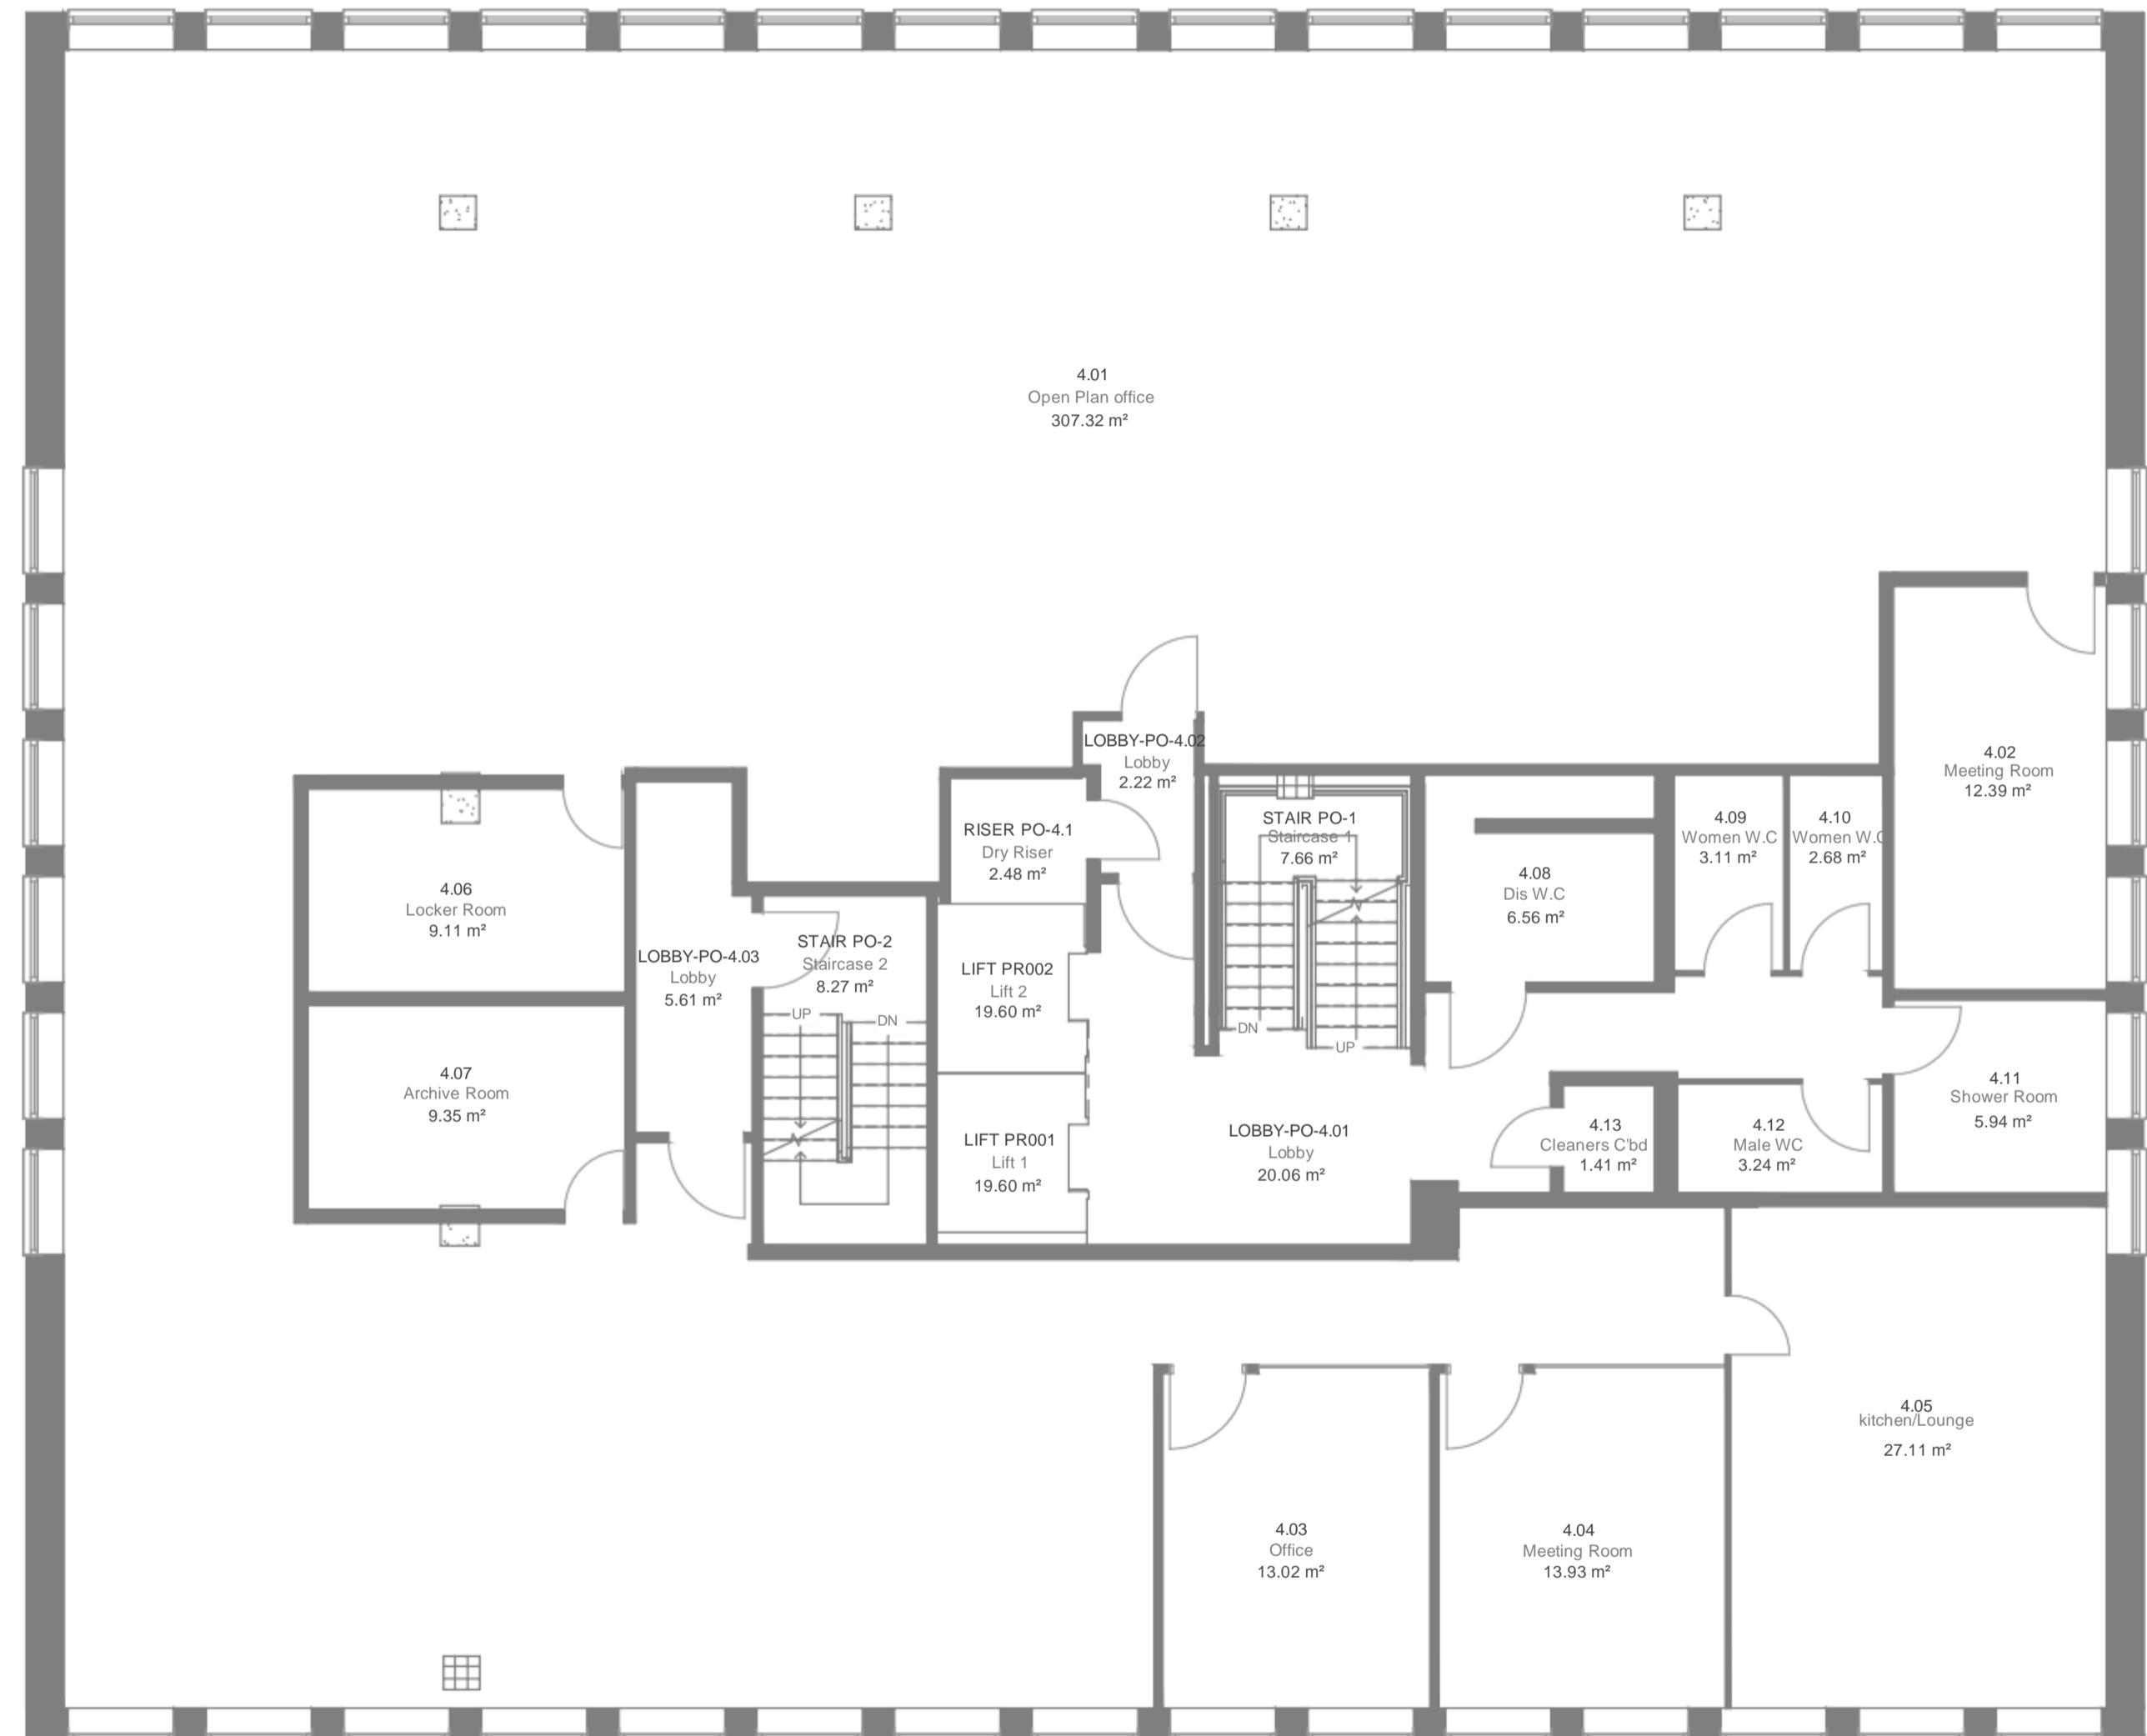

Fourth Floor Plan

0 1 2 3 4 5 10 m

NOTES
This Drawing Is The Copyright Of Coventry University Estates Department & Must Not Be Reproduced Without Their Permission. Figured Dimensions Must Be Taken In Preference To Scaled Dimensions & All Dimensions Must Be Verified On Site Prior To Commencing Any Works.

AREAS

GIA (Gross Internal Area)	486.17 m ²
NIA (Net Internal Area)	
GEA (Gross External Area)	



Rev. Date Amendment



**Coventry
University**

Estate Department
Pivvy Street, Coventry
CV1 5FB
Tel: 024 76887688
Fax: 024 76887336

CURRENT STATUS

RECORD DRAWING

PROJECT


PORTAL HOUSE

TITLE

FOURTH FLOOR PLAN

DRAWN PC CHKD KA DATE 03/03/2020

SCALE 1/50 @ A1 DRAWING No. P0001-COV-00-04-M2-A REV. 0000
1/100 @ A2

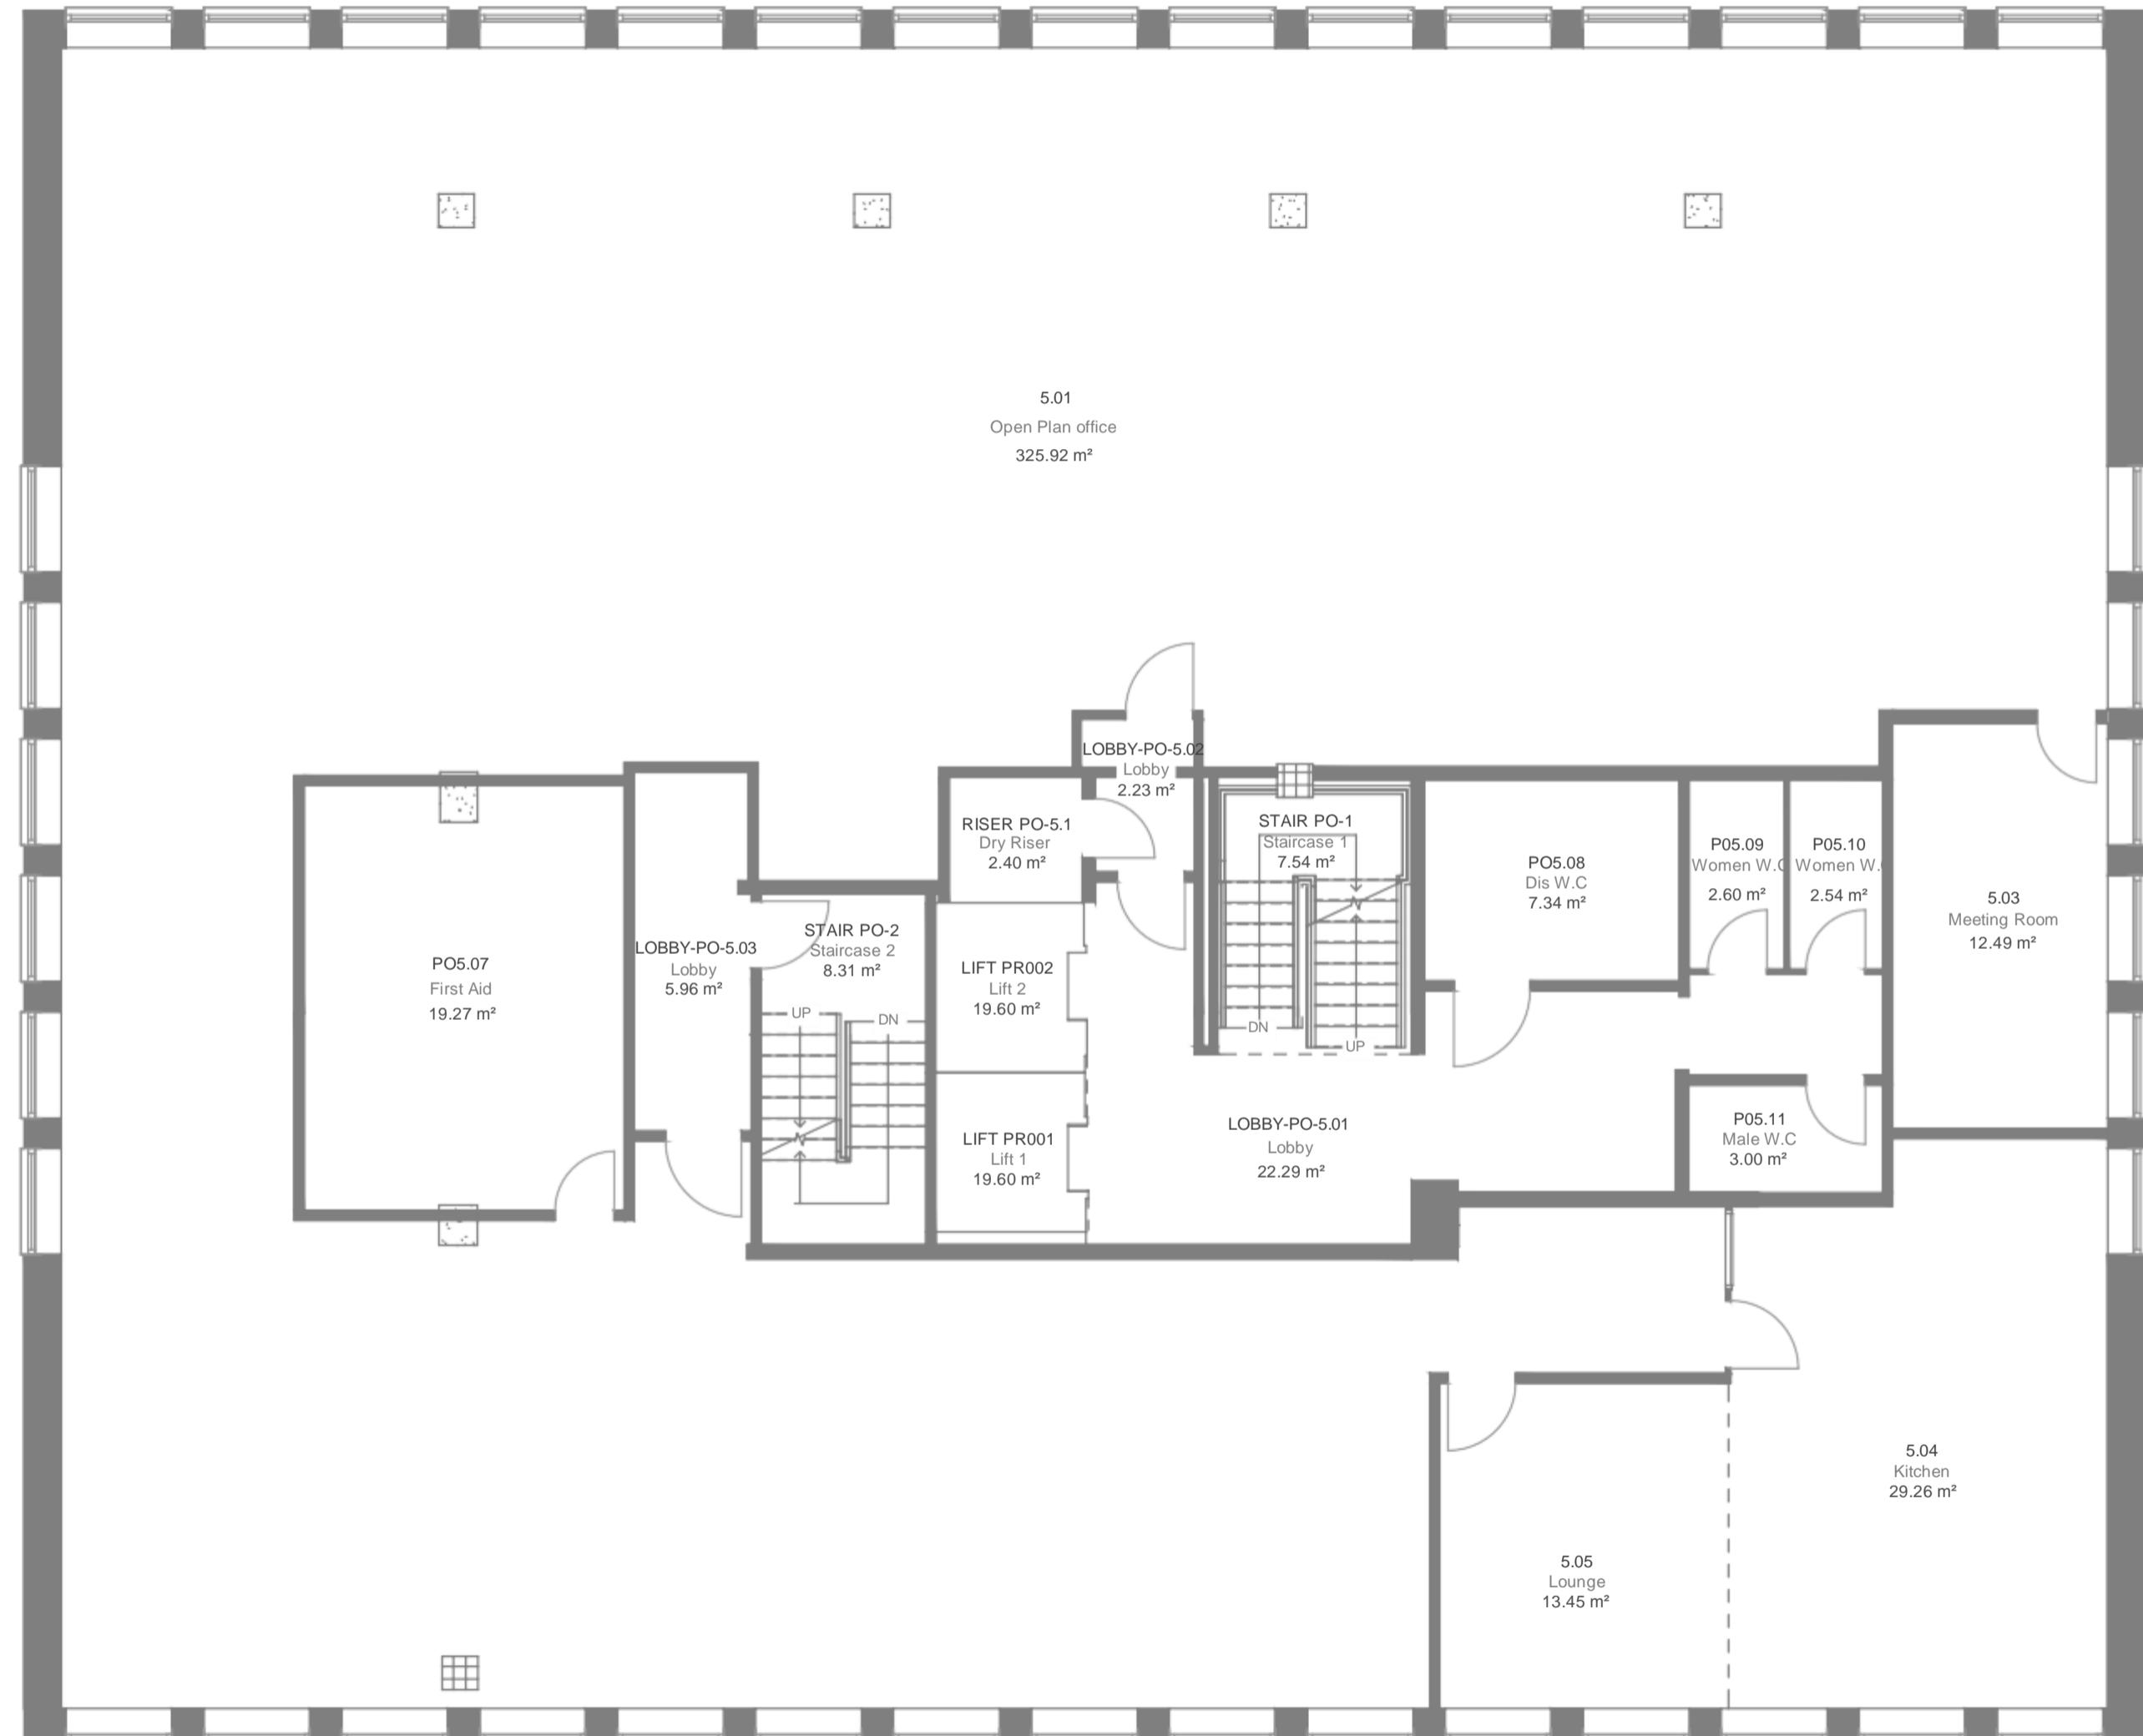

Fifth Floor Plan

0 1 2 3 4 5 10 m

NOTES
This Drawing Is The Copyright Of Coventry University Estates Department & Must Not Be Reproduced Without Their Permission. Figured Dimensions Must Be Taken In Preference To Scaled Dimensions & All Dimensions Must Be Verified On Site Prior To Commencing Any Works.

AREAS

GIA (Gross Internal Area)	486.17 m ²
NIA (Net Internal Area)	
GEA (Gross External Area)	



Rev. Date Amendment
 Coventry University
 Estates Department
 Phoenix Street, Coventry
 CV1 5FB
 Tel: 024 76887688
 Fax: 024 76887336

CURRENT STATUS

RECORD DRAWING

PROJECT


PORTAL HOUSE

TITLE

FIFTH FLOOR PLAN

DRAWN PC CHKD KA DATE 03/03/2020

SCALE 1/50 @ A1 DRAWING No. P001-COV-00-05-M2-A REV. 0000
 1/100 @ A2

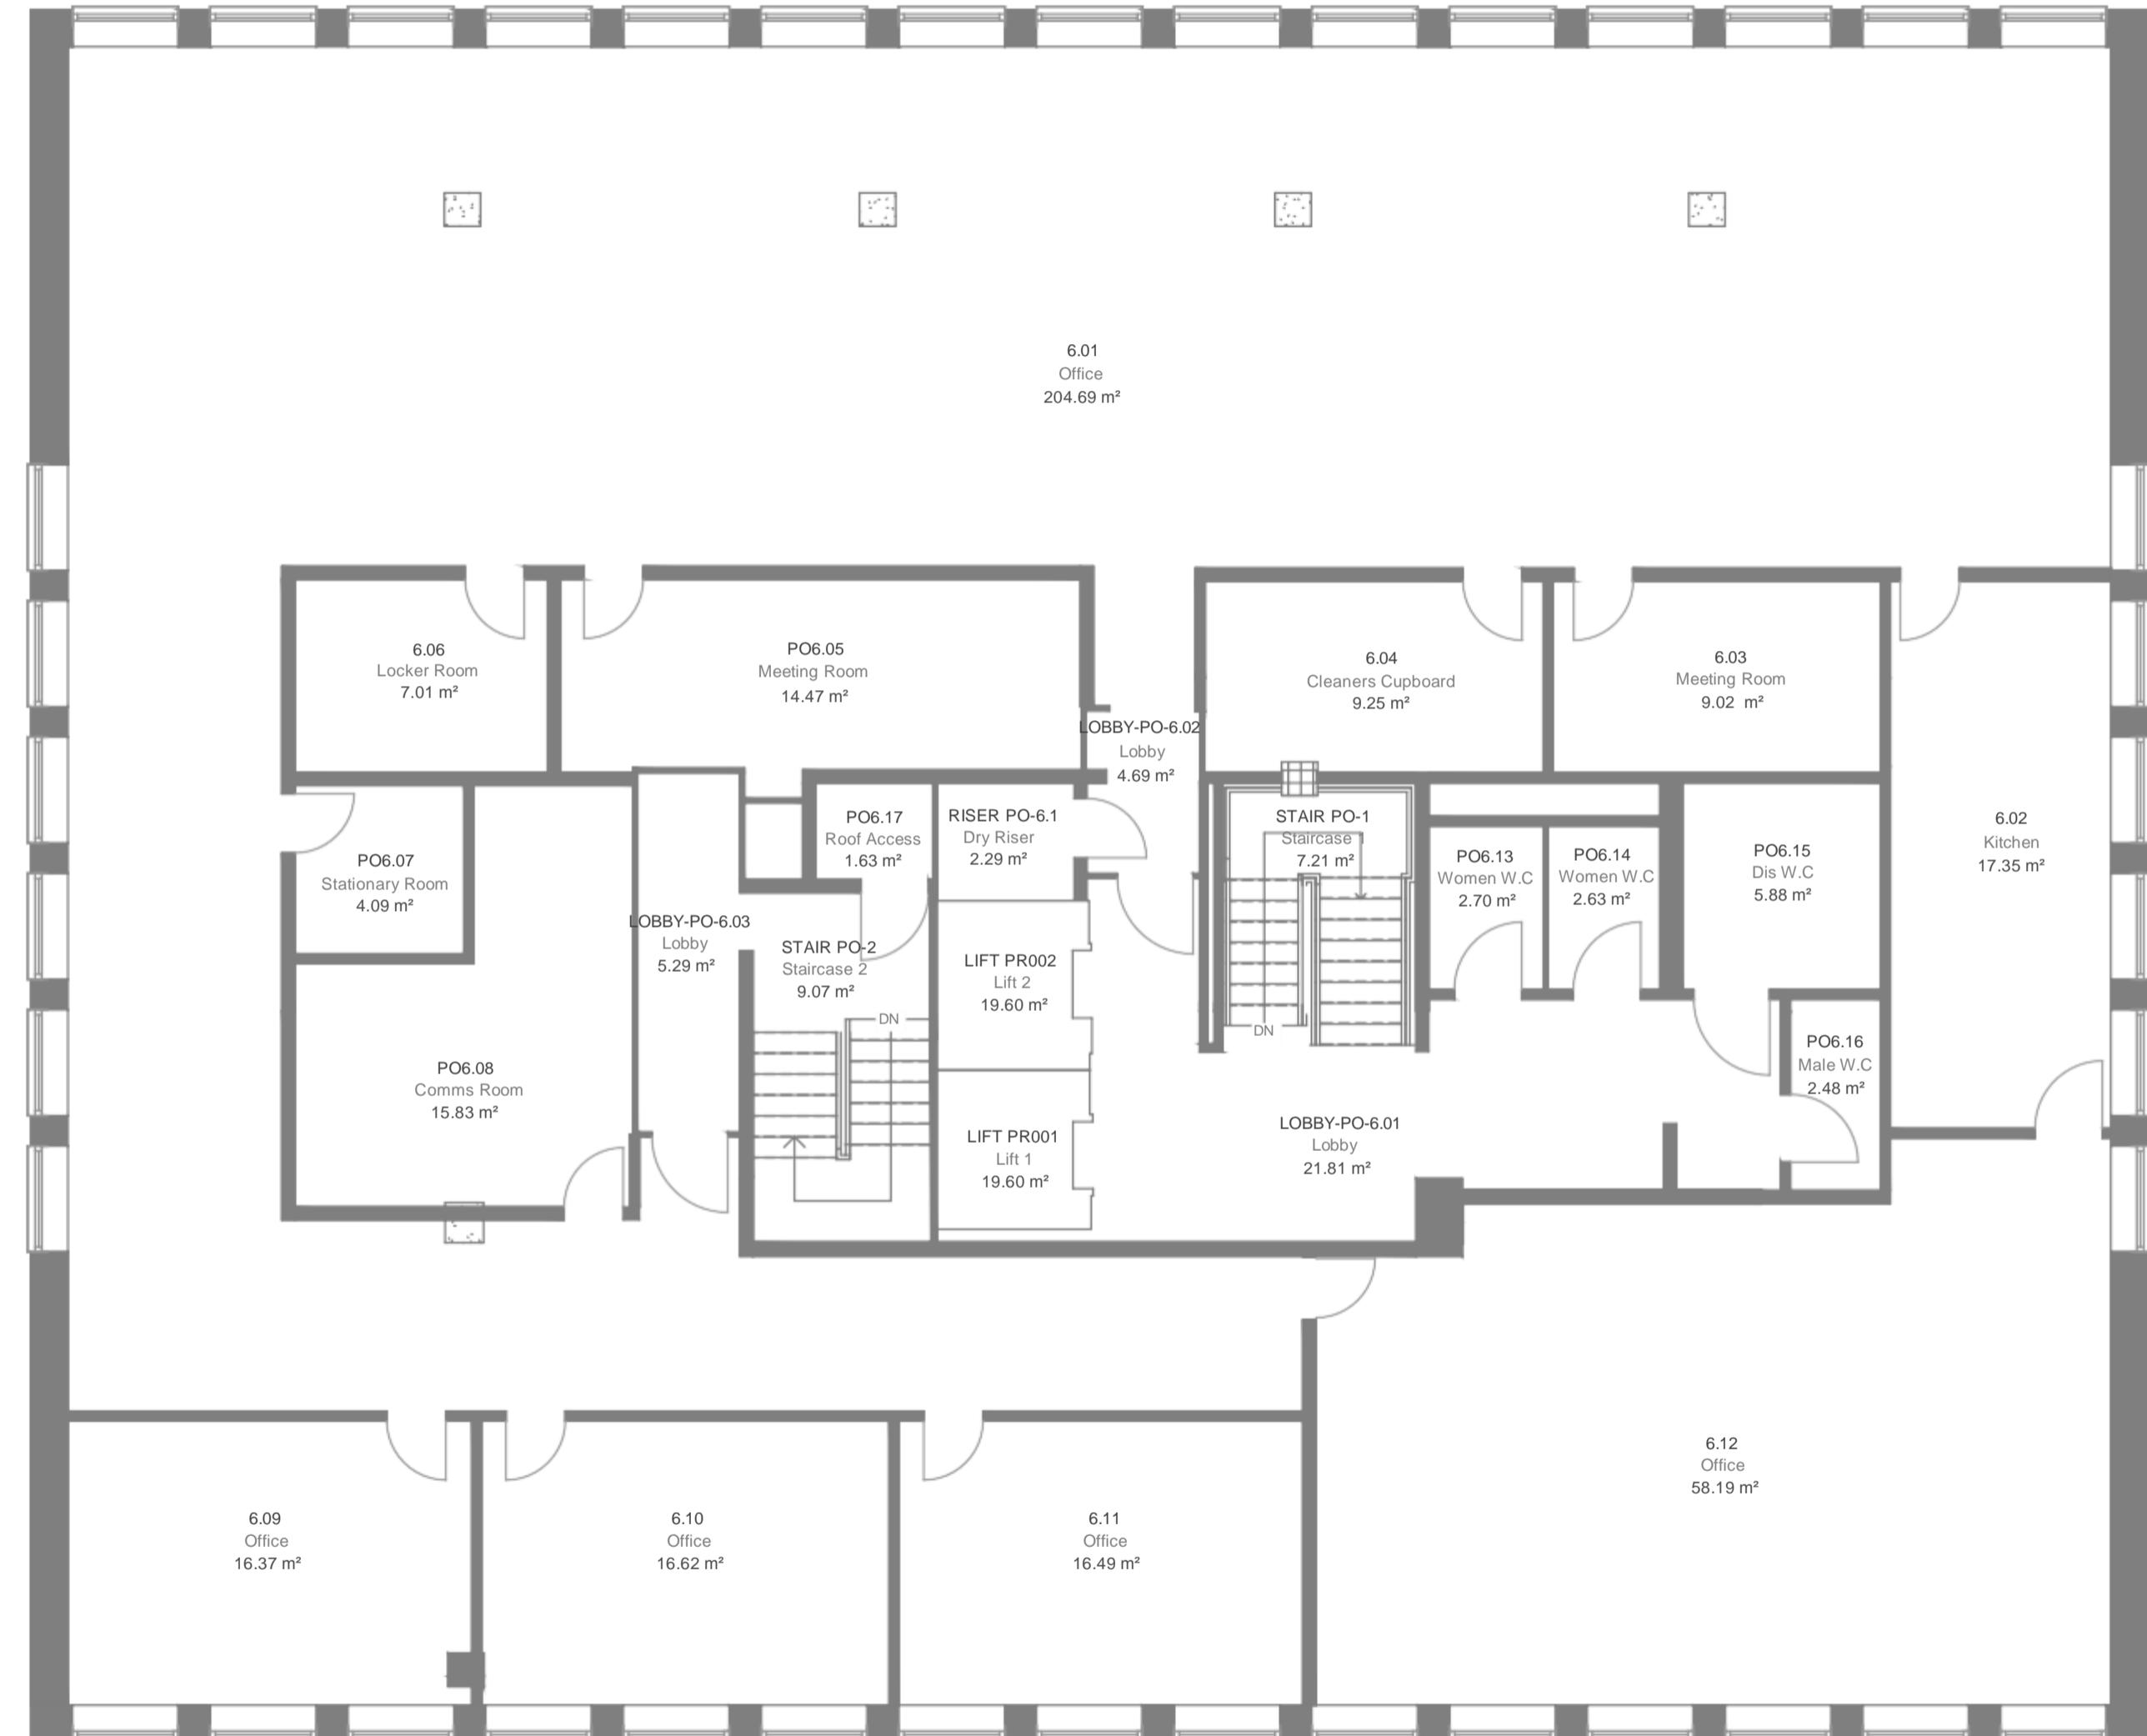


Sixth Floor Plan

0 1 2 3 4 5 10 m

NOTES					
This Drawing Is The Copyright Of Coventry University Estates Department & Must Not Be Reproduced Without Their Permission. Figured Dimensions Must Be Taken In Preference To Scaled Dimensions & All Dimensions Must Be Verified On Site Prior To Commencing Any Works.					
AREAS					
GIA (Gross Internal Area)	486.17 m ²				
NIA (Net Internal Area)					
GEA (Gross External Area)					
					
<table border="1"> <tr> <td>Rev.</td><td>Date</td><td>Amendment</td></tr> </table>			Rev.	Date	Amendment
Rev.	Date	Amendment			
 Coventry University					
Estates Department Phoenix Street, Coventry CV1 5FB Tel: 024 76887688 Fax: 024 76887336					
CURRENT STATUS					
RECORD DRAWING					
PROJECT					
PORTAL HOUSE					
TITLE					
SIXTH FLOOR PLAN					
DRAWN PC					
1/50 @ A1	CHKD KA	DATE 03/03/2020			
1/100 @ A2	DRAWING No. P001-COV-00-06-M2-A	REV. 0000			

 Roof Plan




0 1 2 3 4 5 10 m

NOTES
This Drawing Is The Copyright Of Coventry University Estates Department & Must Not Be Reproduced Without Their Permission. Figured Dimensions Must Be Taken In Preference To Scaled Dimensions & All Dimensions Must Be Verified On Site Prior To Commencing Any Works.

AREAS

GIA (Gross Internal Area)	
NIA (Net Internal Area)	
GEA (Gross External Area)	

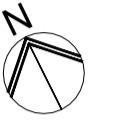

• •
Rev. Date Amendment



Coventry
University

Estate Department
Pivory Street, Coventry
CV1 5FB
Tel: 024 76887688
Fax: 024 76887336

CURRENT STATUS

RECORD DRAWING

PROJECT

PORTAL HOUSE

TITLE

SEVENTH FLOOR PLAN

DRAWN PC CHKD KA DATE 03/03/2020

SCALE 1/50 @ A1 DRAWING No. P0001-COV-00-07-M2-A REV. 0000
1/100 @ A2