



NOTES

This Drawing Is The Copyright Of Coventry University
States Department & Must Not Be Reproduced
Without Their Permission. Figured Dimensions Must Be
Taken In Preference To Scaled Dimensions & All
Dimensions Must Be Verified On Site Prior To
Commencing Any Works.



NOTE	
Gross Internal Area	2167.46 m ²
Gross External Area	2245.63 m ²

06/12/2022	Alteration to RCG16 & General Furniture Layout	
06/02/2019	Refurbishment to the cafe area	
28/02/2018	Drawing amended to match as built floor plan	
Rev.	Date	Amendment



Coventry
University

Estates Department
Priory Street, Coventry
CV1 5FB
Tel: 024 76887688
Fax: 024 76887336

Estates Department
Priory Street, Coventry
CV1 5FB
Tel: 024 76887688
Fax: 024 76887336

TEST STATUS


1000

PROJECT
FACULTY OF HEALTH & LIFE SCIENCES
RICHARD CROSSMAN BUILDING

TITLE

AS BUILT GROUND FLOOR PLAN

DRAWN SCALE	EM	CHkD HS	DATE 06/02/2019
		DRAWING No.	REV.
1:200 @ A2		RC001-COV-00-GF-M2-A	C

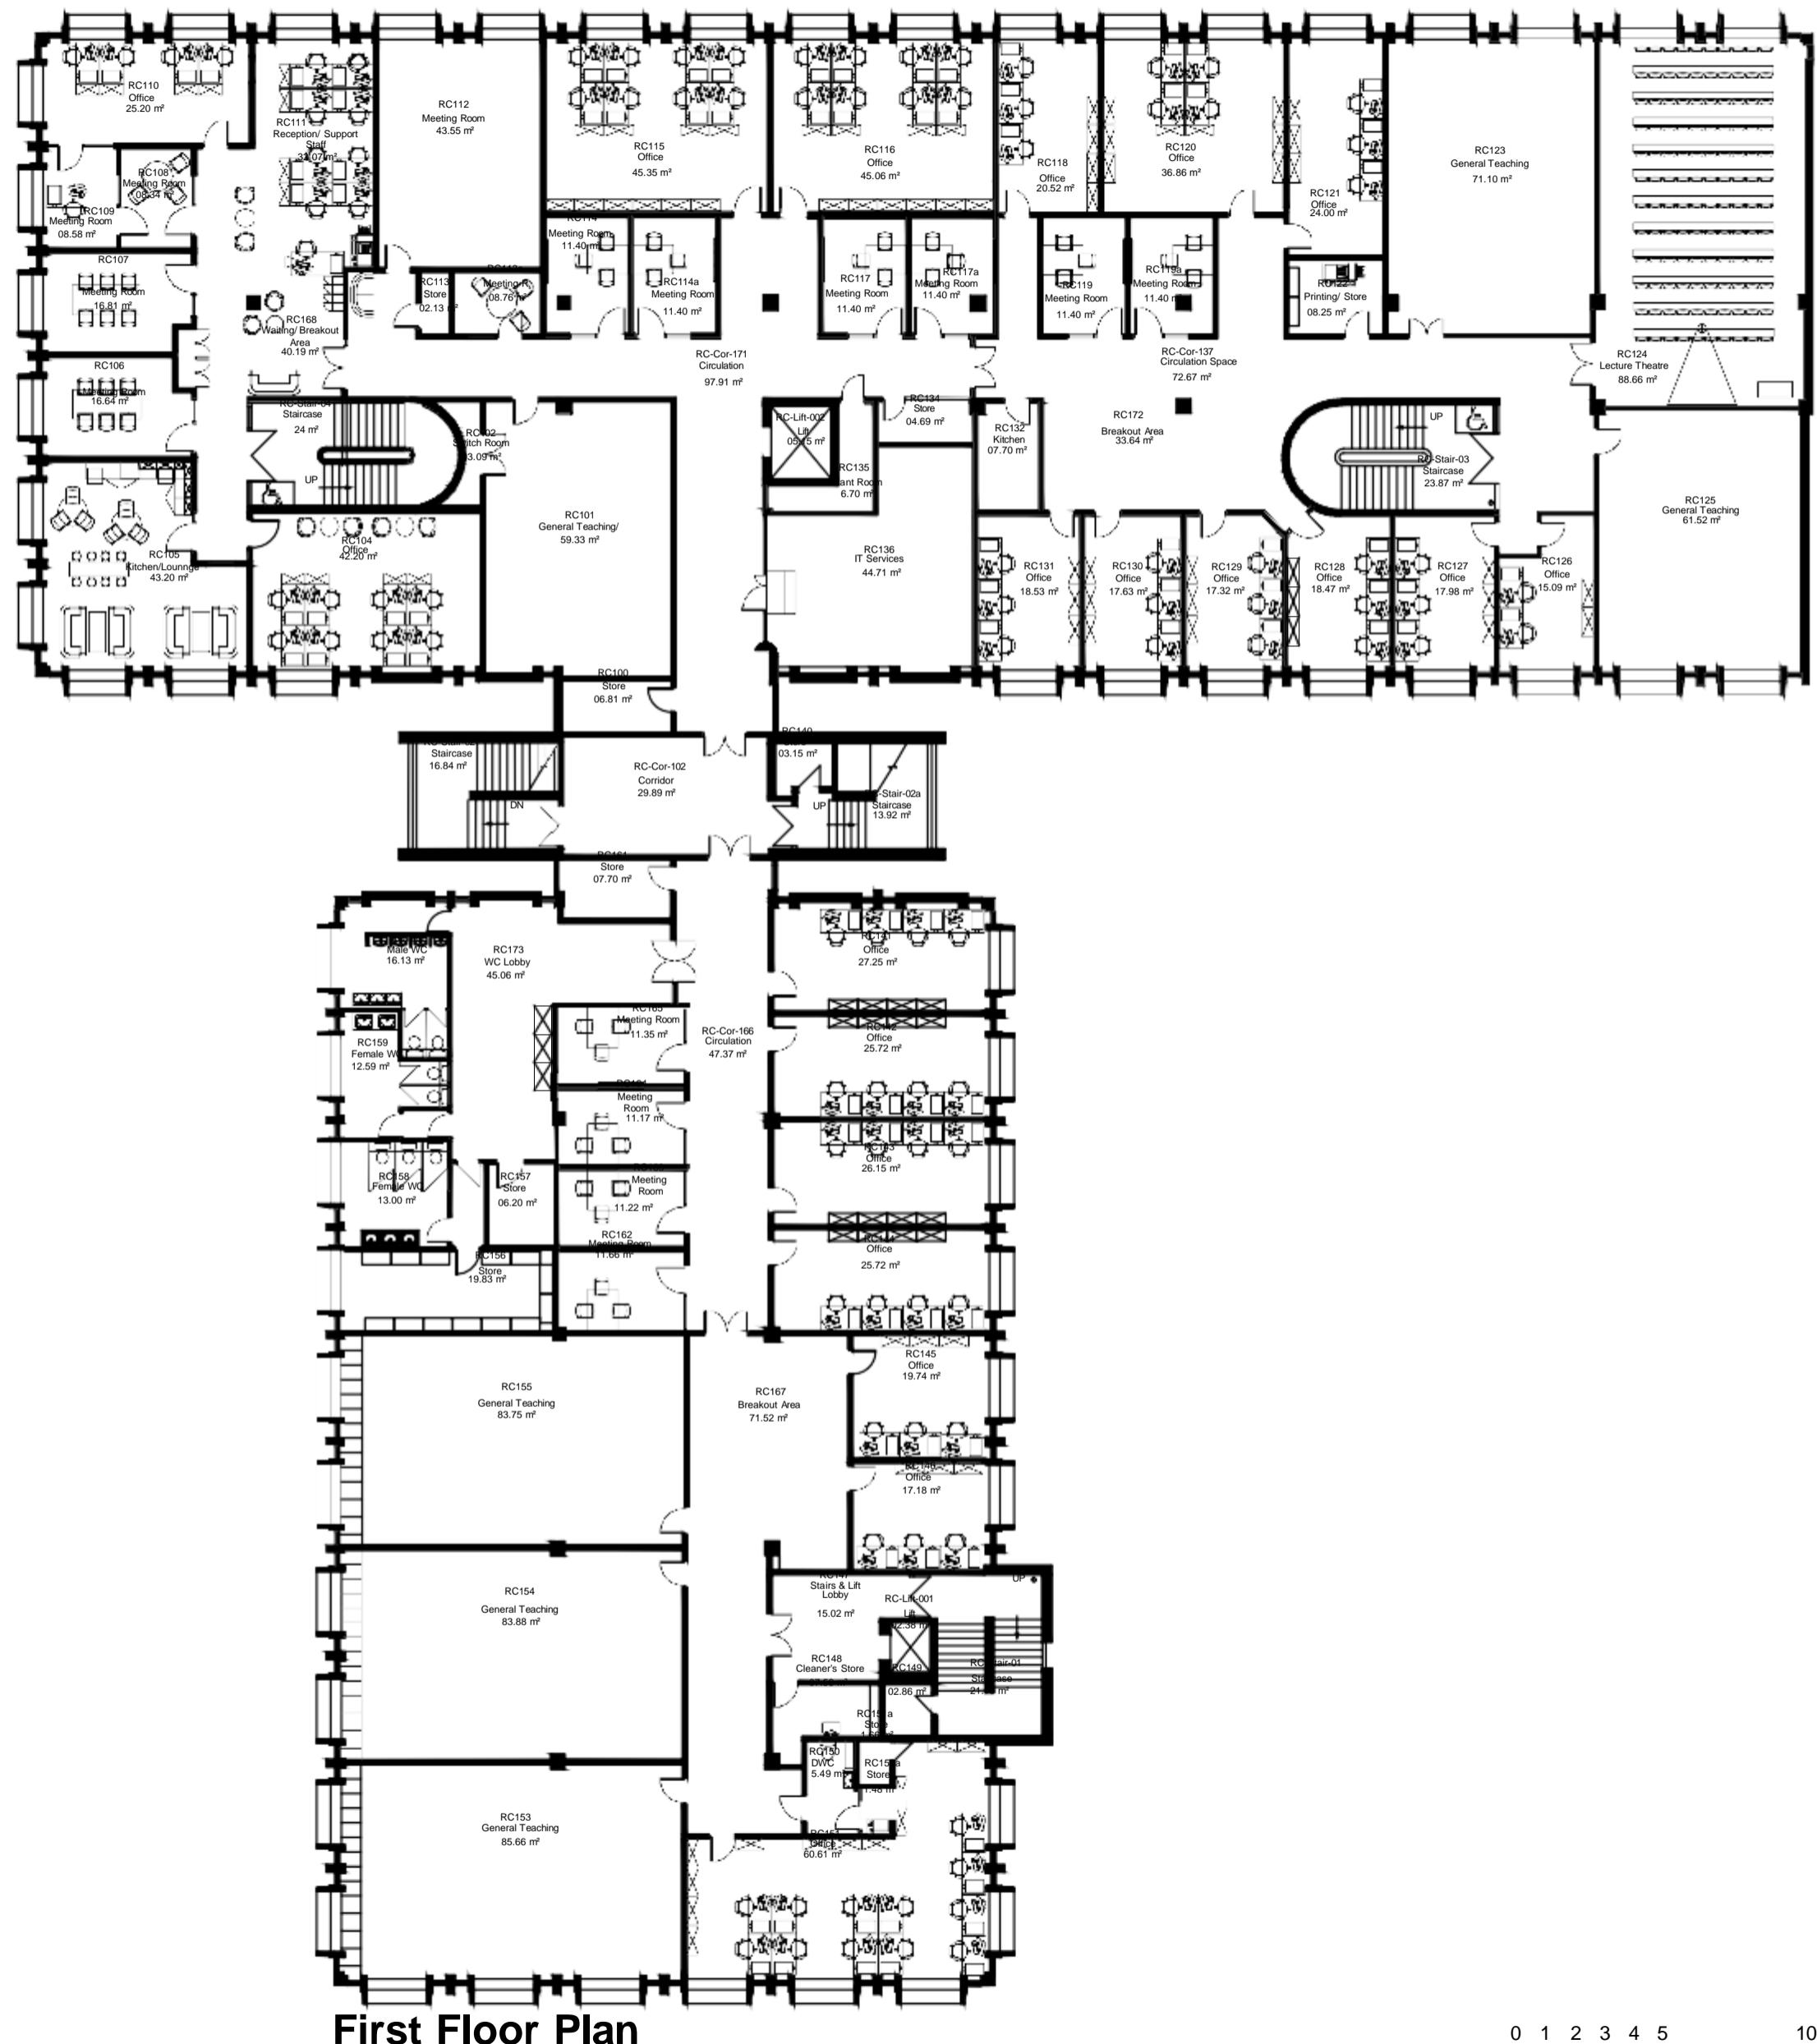

NOTES

This Drawing Is The Copyright Of Coventry University
Lectures Department & Must Not Be Reproduced
Without Their Permission. Figured Dimensions Must Be
Taken In Preference To Scaled Dimensions & All
Dimensions Must Be Verified On Site Prior To
Commencing Any Works.



NOTE

gross Internal Area	2223.25 m ²
gross External Area	2387.92 m ²

08/12/2022	Alterations to RC105 and general furniture layout
16/03/2018	Drawing amended to match as built floor plan
v. Date	Amendment



The logo for Coventry University, featuring the word "Coventry" in a large, bold, black serif font above the word "University" in a smaller, black sans-serif font. A small decorative scroll graphic is positioned above the "y" in "Coventry".

Estates Department
Priory Street, Coventry
CV1 5FB
Tel: 024 76887688
Fax: 024 76887336

PARENT STATUS:

RECORD DRAWING

PROJECT:
FACULTY OF HEALTH & LIFE SCIENCES

**FACULTY OF HEALTH & LIFE SCIENCES
RICHARD CROSSMAN BUILDING**


AS BUILT FIRST FLOOR PLAN

AWN: EM	CHkD HS	DATE 02/03/2018
ALE: 1-200 @ A2	DRAWING No. PC001-COV-00-01-M2-A	REV. B

NOTES

This Drawing Is The Copyright Of Coventry University Estates Department & Must Not Be Reproduced Without Their Permission. Figured Dimensions Must Be Taken In Preference To Scaled Dimensions & All Dimensions Must Be Verified On Site Prior To Commencing Any Works.

N

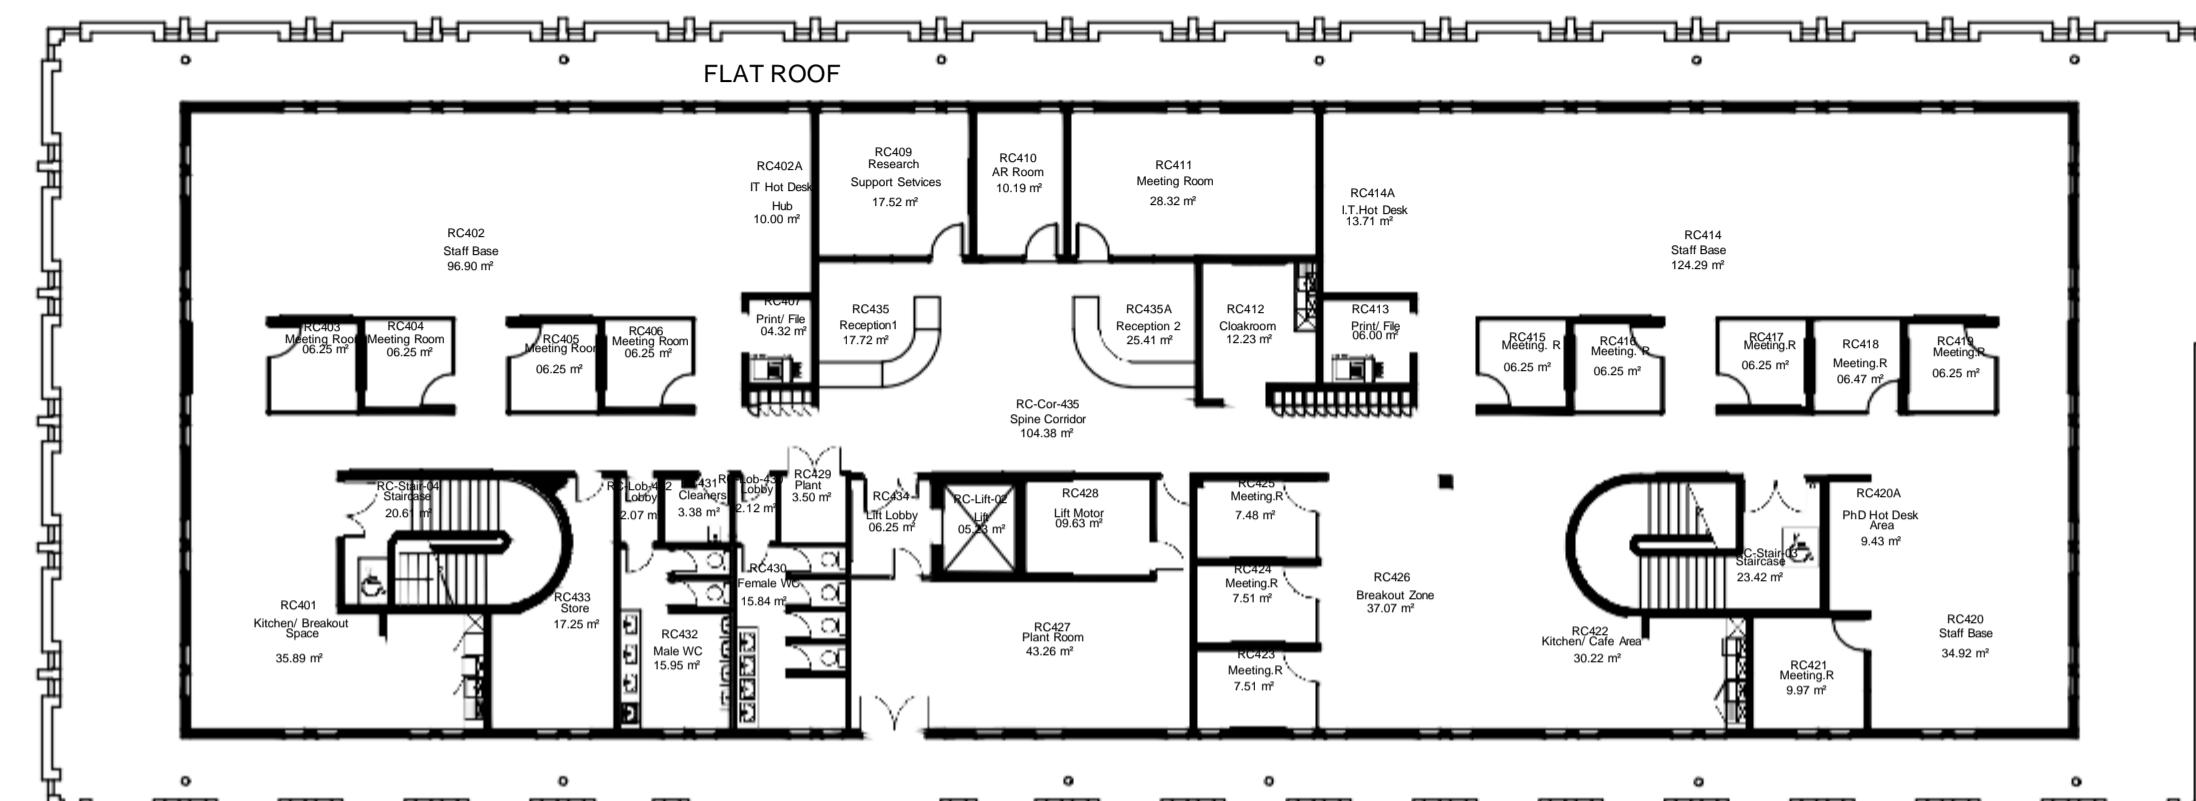

NOTES

This Drawing Is The Copyright Of Coventry University Estates Department & Must Not Be Reproduced Without Their Permission. Figured Dimensions Must Be Taken In Preference To Scaled Dimensions & All Dimensions Must Be Verified On Site Prior To Commencing Any Works.



NOTE

Gross Internal Area	2215.97 m ²
Gross External Area	2310.25 m ²

B	08/12/2022	Alterations to RC248 and general furniture layout
A	16/03/2018	Drawing amended to match as built floor plan
Rev.	Date	Amendment



**Coventry
University**

Estates Department
Prior Street, Coventry
CV1 5FB
Tel: 024 76887688
Fax: 024 76887336



CURRENT STATUS:	RECORD DRAWING
-----------------	----------------

PROJECT:	FACULTY OF HEALTH & LIFE SCIENCES RICHARD CROSSMAN BUILDING	
----------	--	--

TITLE:	AS BUILT SECOND FLOOR PLAN	
--------	----------------------------	--

DRAWN:	EM	CHKD	DATE
		HS	02/03/2018

SCALE:	DRAWING No.	REV.
1:200 @ A2	RC001-COV-00-02-M2-A	B

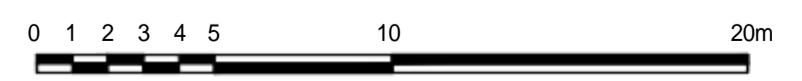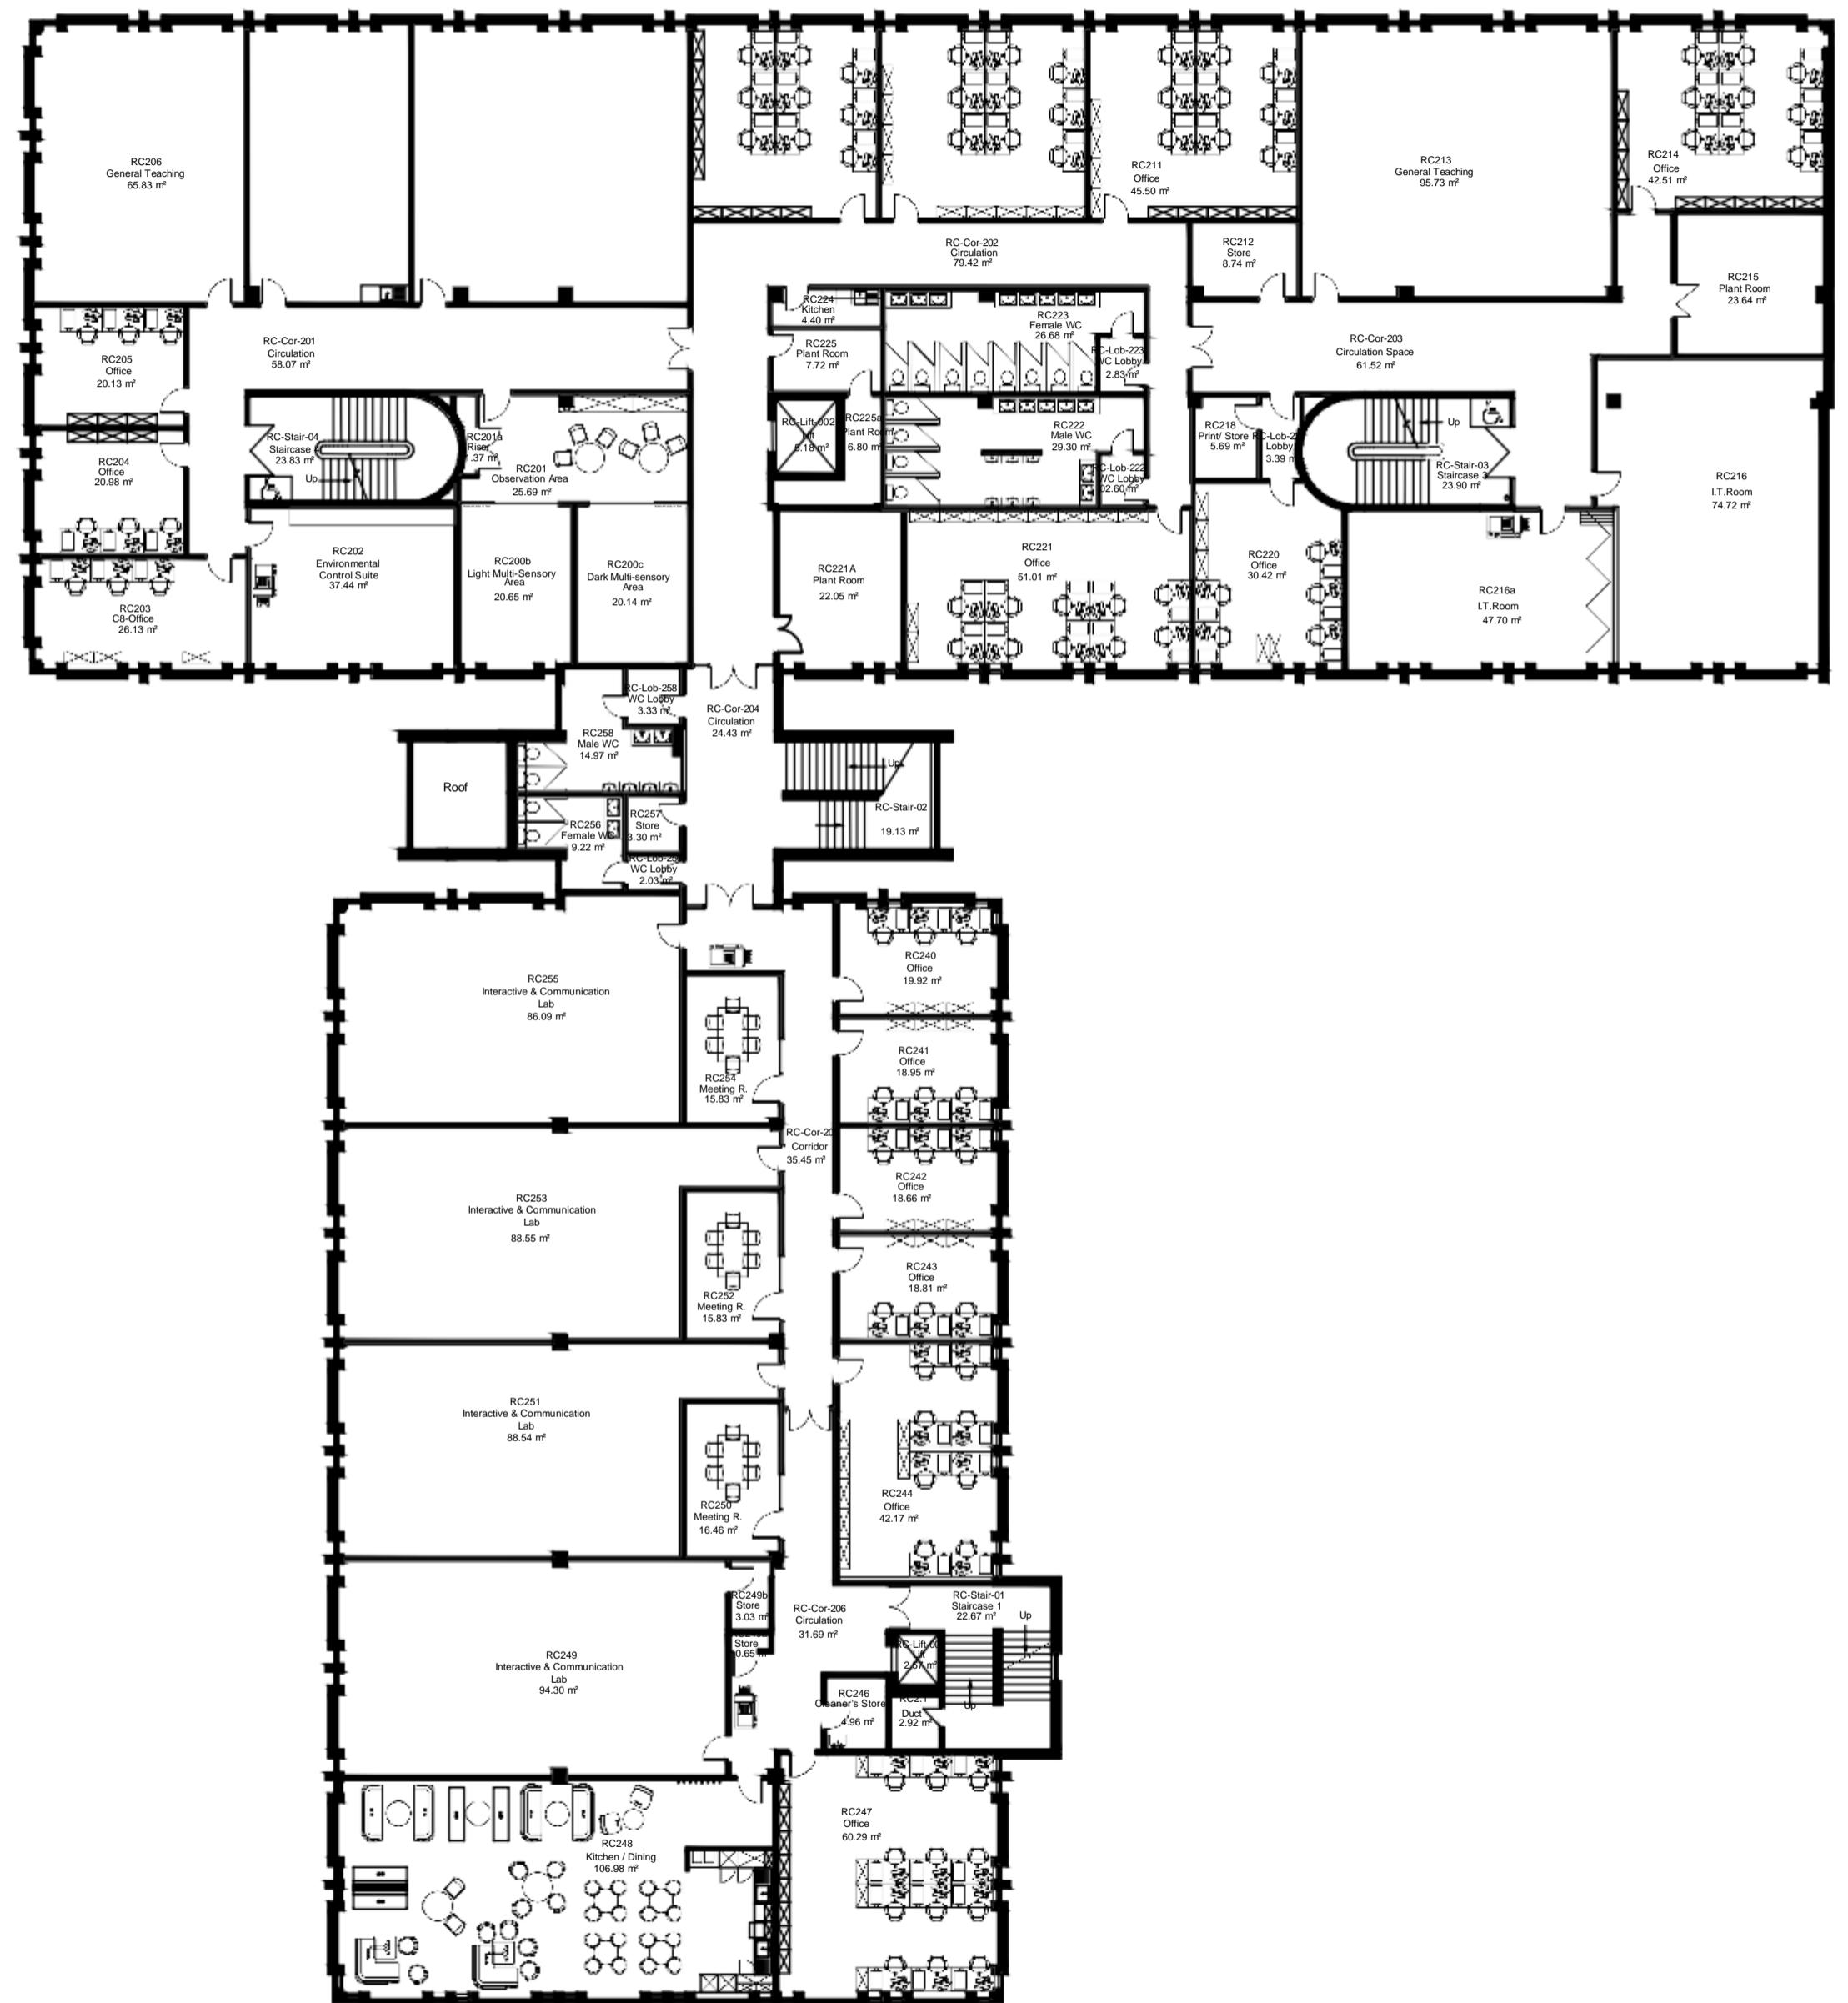

NOTES

This Drawing Is The Copyright Of Coventry University Estates Department & Must Not Be Reproduced Without Their Permission. Figured Dimensions Must Be Taken In Preference To Scaled Dimensions & All Dimensions Must Be Verified On Site Prior To Commencing Any Works.



NOTE

Gross Internal Area	2215.89 m ²
Gross External Area	2310.25 m ²

A	09/12/2022	Drawing amended to as fitted Layout
A	28/02/2018	Drawing amended to match as built floor plan
Rev.	Date	Amendment



**Coventry
University**

Estates Department
Priory Street, Coventry
CV1 5FB
Tel: 024 76887688
Fax: 024 76887336

CURRENT STATUS: RECORD DRAWING

PROJECT:
FACULTY OF HEALTH & LIFE SCIENCES RICHARD CROSSMAN BUILDING

TITLE:
AS BUILT THIRD FLOOR PLAN

DRAWN:	EM	CHkd	DATE
		HS	05/03/2018

SCALE:	DRAWING No.	REV.
1:200 @ A2	RC001-COV-00-03-M2-A	B

