

Ground Floor Plan

A horizontal scale with numerical markers at 0, 1, 2, 3, 4, 5, 10, and 20. A thick black horizontal bar is positioned such that its right end aligns with the 20 mark, and its left end is located between the 10 and 15 marks, indicating a value of approximately 18.

NOTES



CW - Second Floor Plan

GIA (gross Internal Area)	2025.5
GEA (gross External Area)	000.00

•	•	
ev.	Date	Amendment



Coventry
University

JURRENT STATUS

RECORD DRAWING

SIR JOHN LAING BUILDING

GROUND FLOOR PLAN

CALE NTS @ A1	DRAWING No. JL001-COV-00-GF-M2-A	REV. 0000
------------------	-------------------------------------	--------------


NOTES

This Drawing Is The Copyright Of Coventry University Estates Department & Must Not Be Reproduced Without Their Permission. Figured Dimensions Must Be Taken In Preference To Scaled Dimensions & All Dimensions Must Be Verified On Site Prior To Commencing Any Works.



CW - Second Floor Plan

GIA (gross Internal Area)	1649.77 m ²
GEA (gross External Area)	000.00 m ²

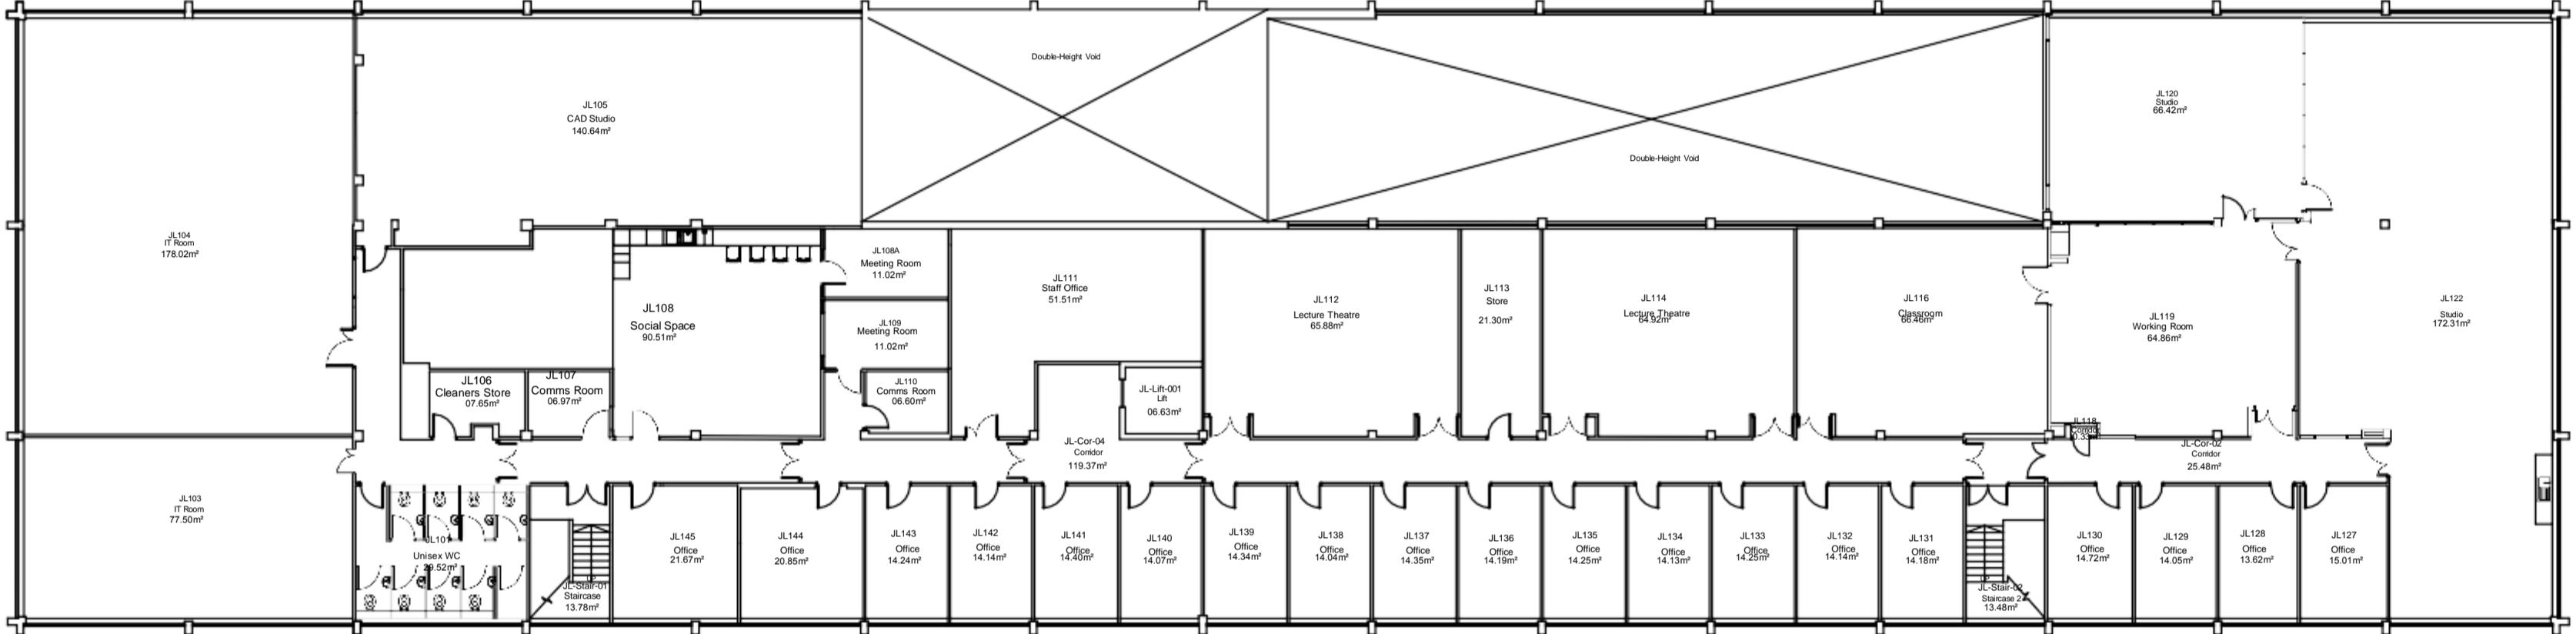

First Floor Plan



*	*	*
Rev.	Date	Amendment



Coventry
University

Estates Department
Phry Street, Coventry
CV1 5FB
Tel: 024 76887688
Fax: 024 76887336

CURRENT STATUS

RECORD DRAWING

PROJECT **FACULTY OF ENGINEERING,
ENVIRONMENT & COMPUTING.
SIR JOHN LAING BUILDING**

TITLE

AS BUILT FIRST FLOOR PLAN

DRAWN KA & EM CHKD CHKD DATE 28/02/2020

SCALE NTS @ A1 DRAWING No. JL001-COV-00-01-M2-A REV. 0000

NOTES


This Drawing Is The Copyright Of Coventry University Estates Department & Must Not Be Reproduced Without Their Permission. Figured Dimensions Must Be Taken In Preference To Scaled Dimensions & All Dimensions Must Be Verified On Site Prior To Commencing Any Works.



CW - Second Floor Plan

GIA (gross Internal Area)	34.43 m ²
------------------------------	----------------------

GEA (gross External Area)	000.00 m ²
------------------------------	-----------------------

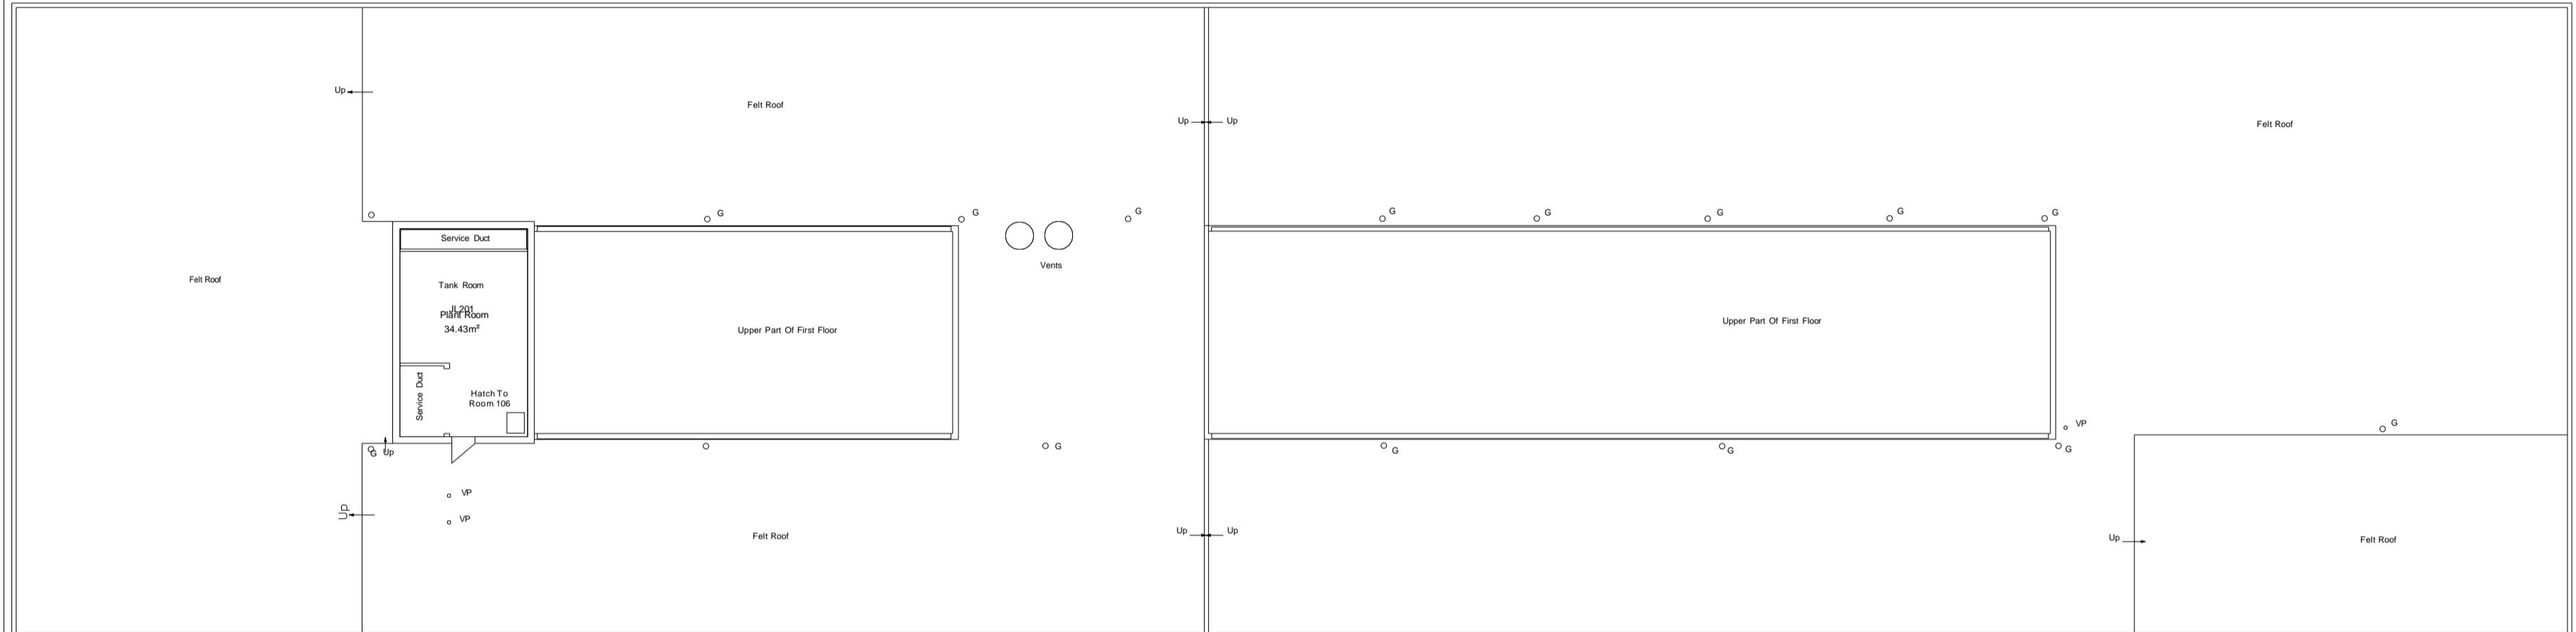

Roof Plan

0 1 2 3 4 5 10 20m

A 06/04/2018 Drawing amended to match as built floor plan
Rev. Date Amendment



Coventry
University

Estates Department
Priory Street, Coventry
CV1 5FB
Tel: 024 76887688
Fax: 024 76887336

CURRENT STATUS
RECORD DRAWING

PROJECT FACULTY OF ENGINEERING,
ENVIRONMENT & COMPUTING.
SIR JOHN LAING BUILDING

TITLE
AS BUILT ROOF PLAN

DRAWN EM CHKD DATE 28/02/2020

SCALE NTS @ A1 DRAWING No. JL001-COV-00-R-M2-A REV. 0000