


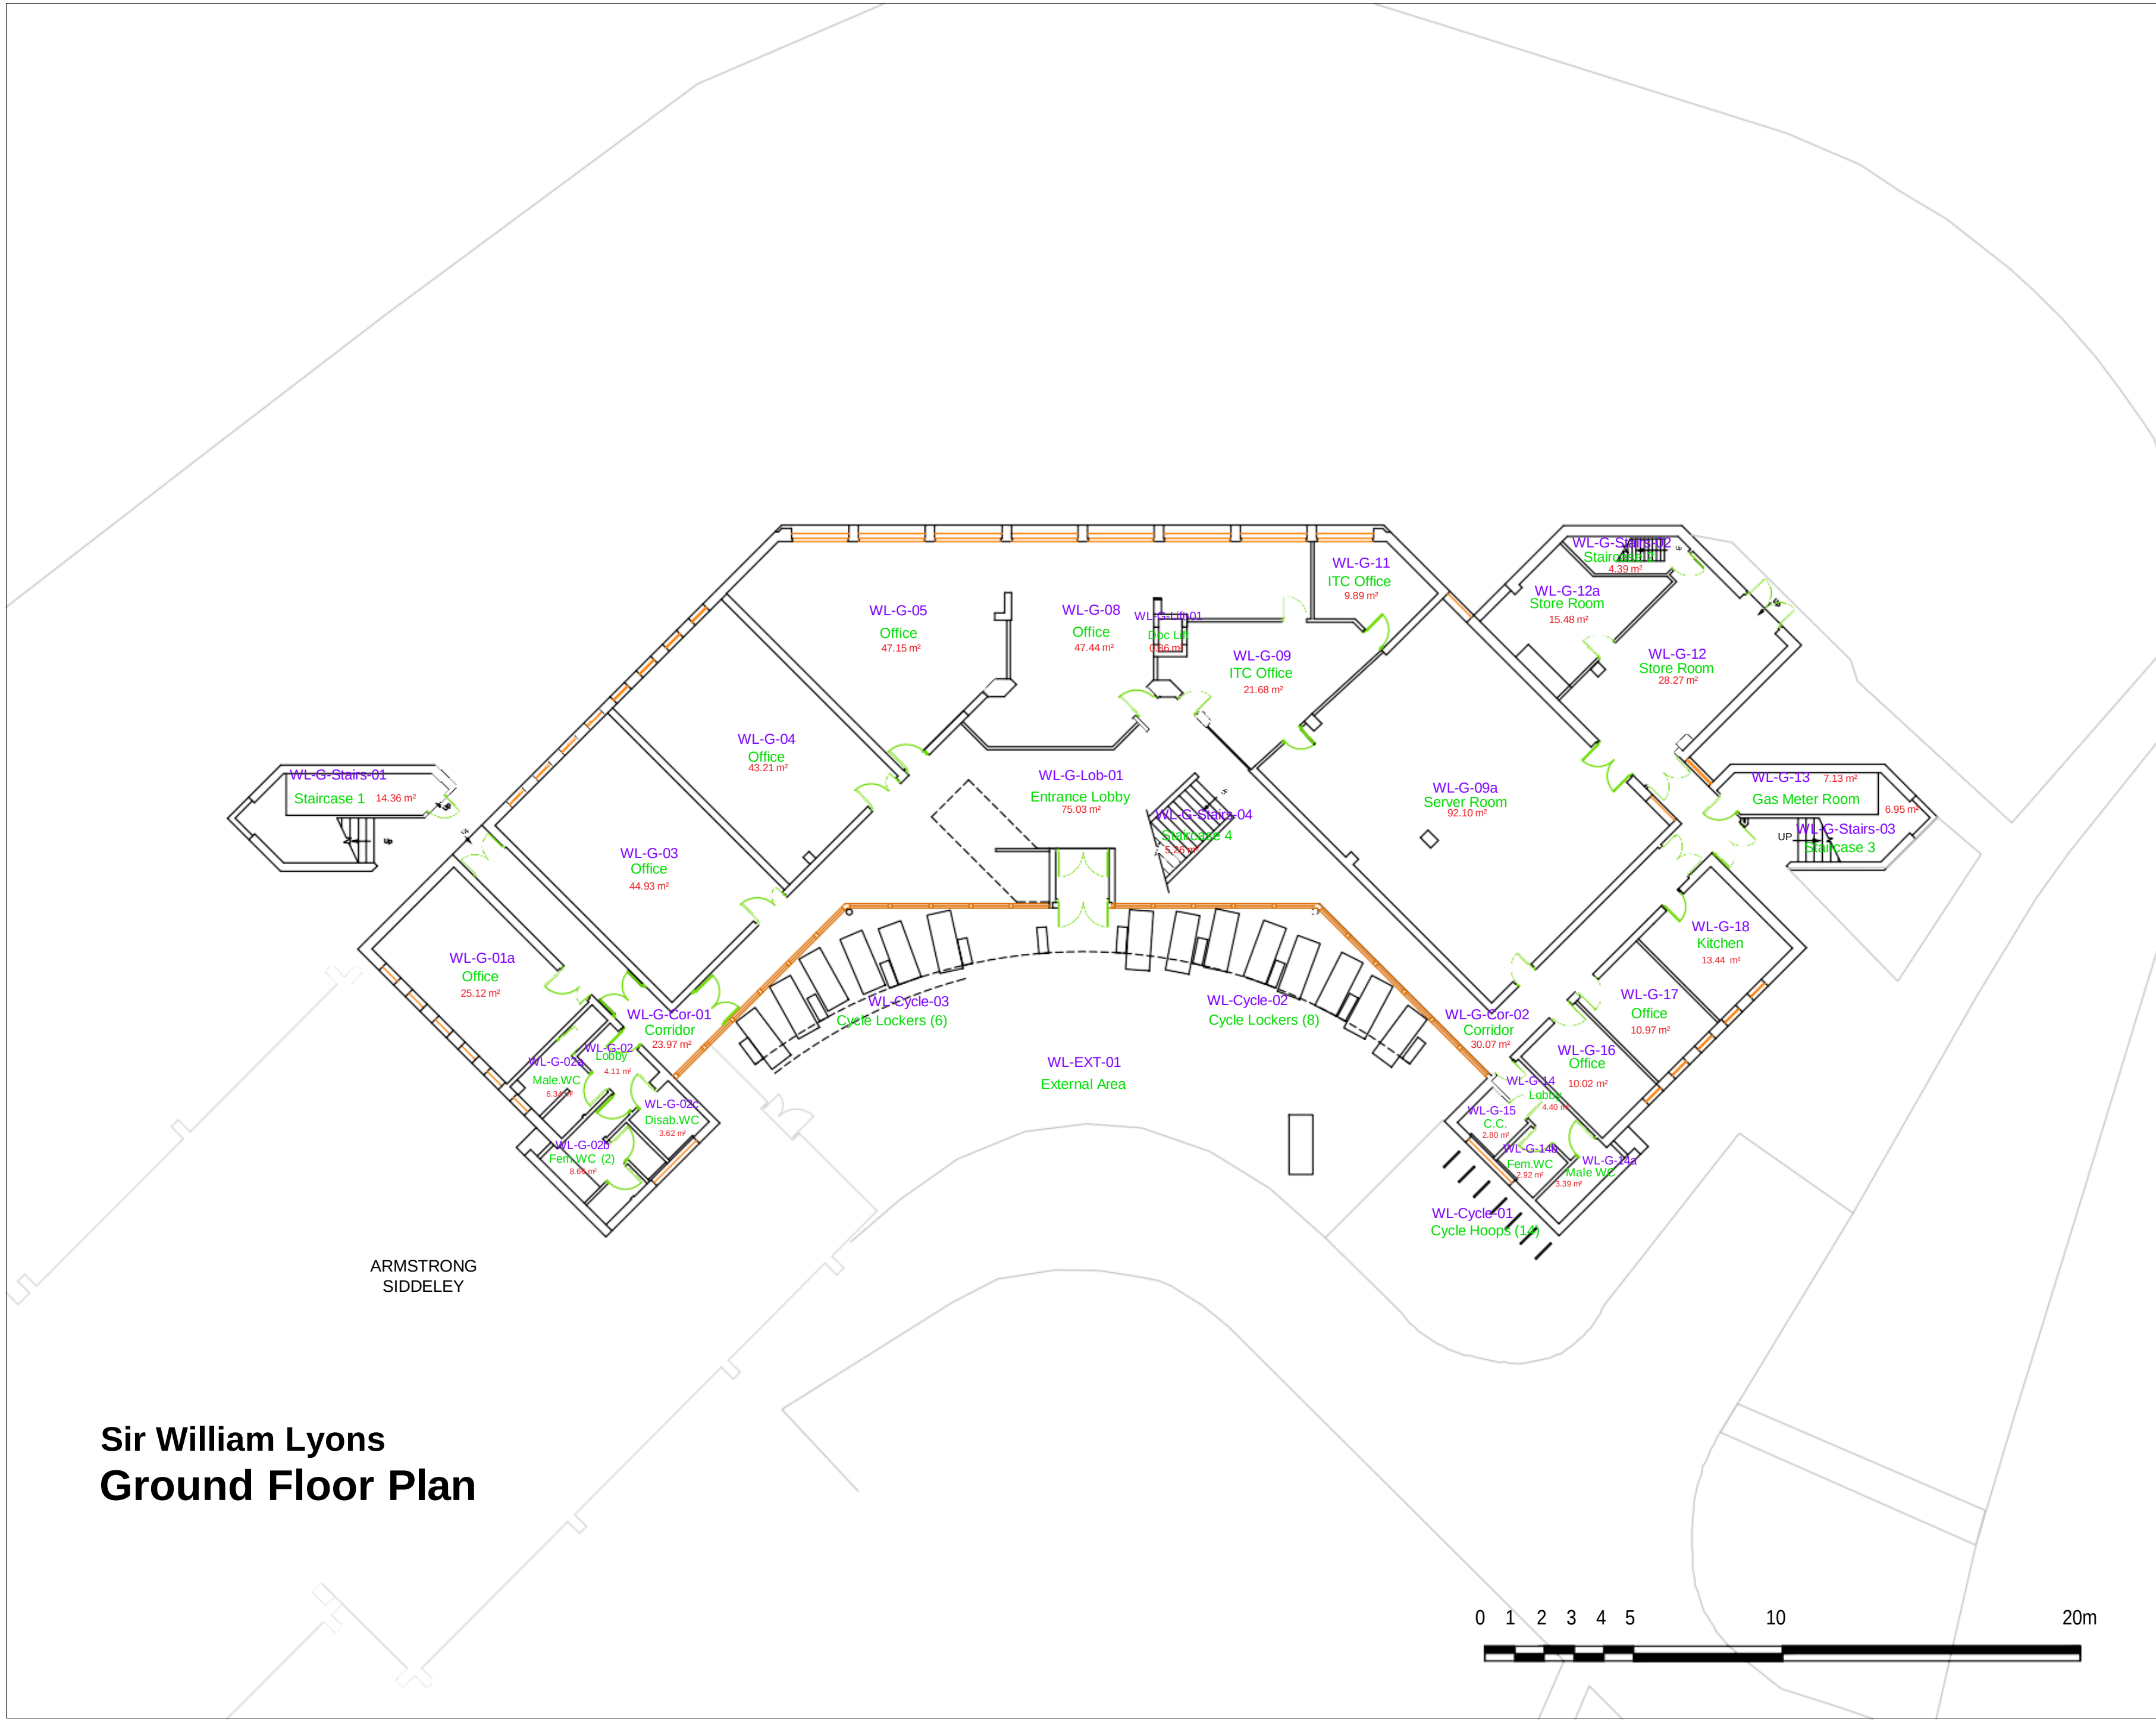

Sir William Lyons
Ground Floor Plan

NOTES

This Drawing is The Copyright Of Coventry University Estates Department & Must Not Be Reproduced Without Their Permission. Figured Dimensions Must Be Taken in Preference To Scaled Dimensions & All Dimensions Must Be Verified On Site Prior To Commencing Any Works.

AREAS

GEA (Gross External Area)	685.20 m ²
GIA (Gross Internal Area)	631.30 m ²
NIA (Net Internal Area)	222.65 m ²

Rev.	Date	Amendment

Coventry University

Estates Department
Priority Street, Coventry
CV1 5F9
Tel: 024 76887688
Fax: 024 76887336

CURRENT STATUS

RECORD DRAWING

PROJECT

SIR WILLIAM LYONS


TITLE

GROUND FLOOR

DRAWN	CHKD	DATE
PC	CHKD	07/12/2021

SCALE	DRAWING No.	REV.
1/100 @ A1 1/200 @ A2	SWL01-COV-00-GF-M2-A	0000

Sir William Lyons
First Floor Plan

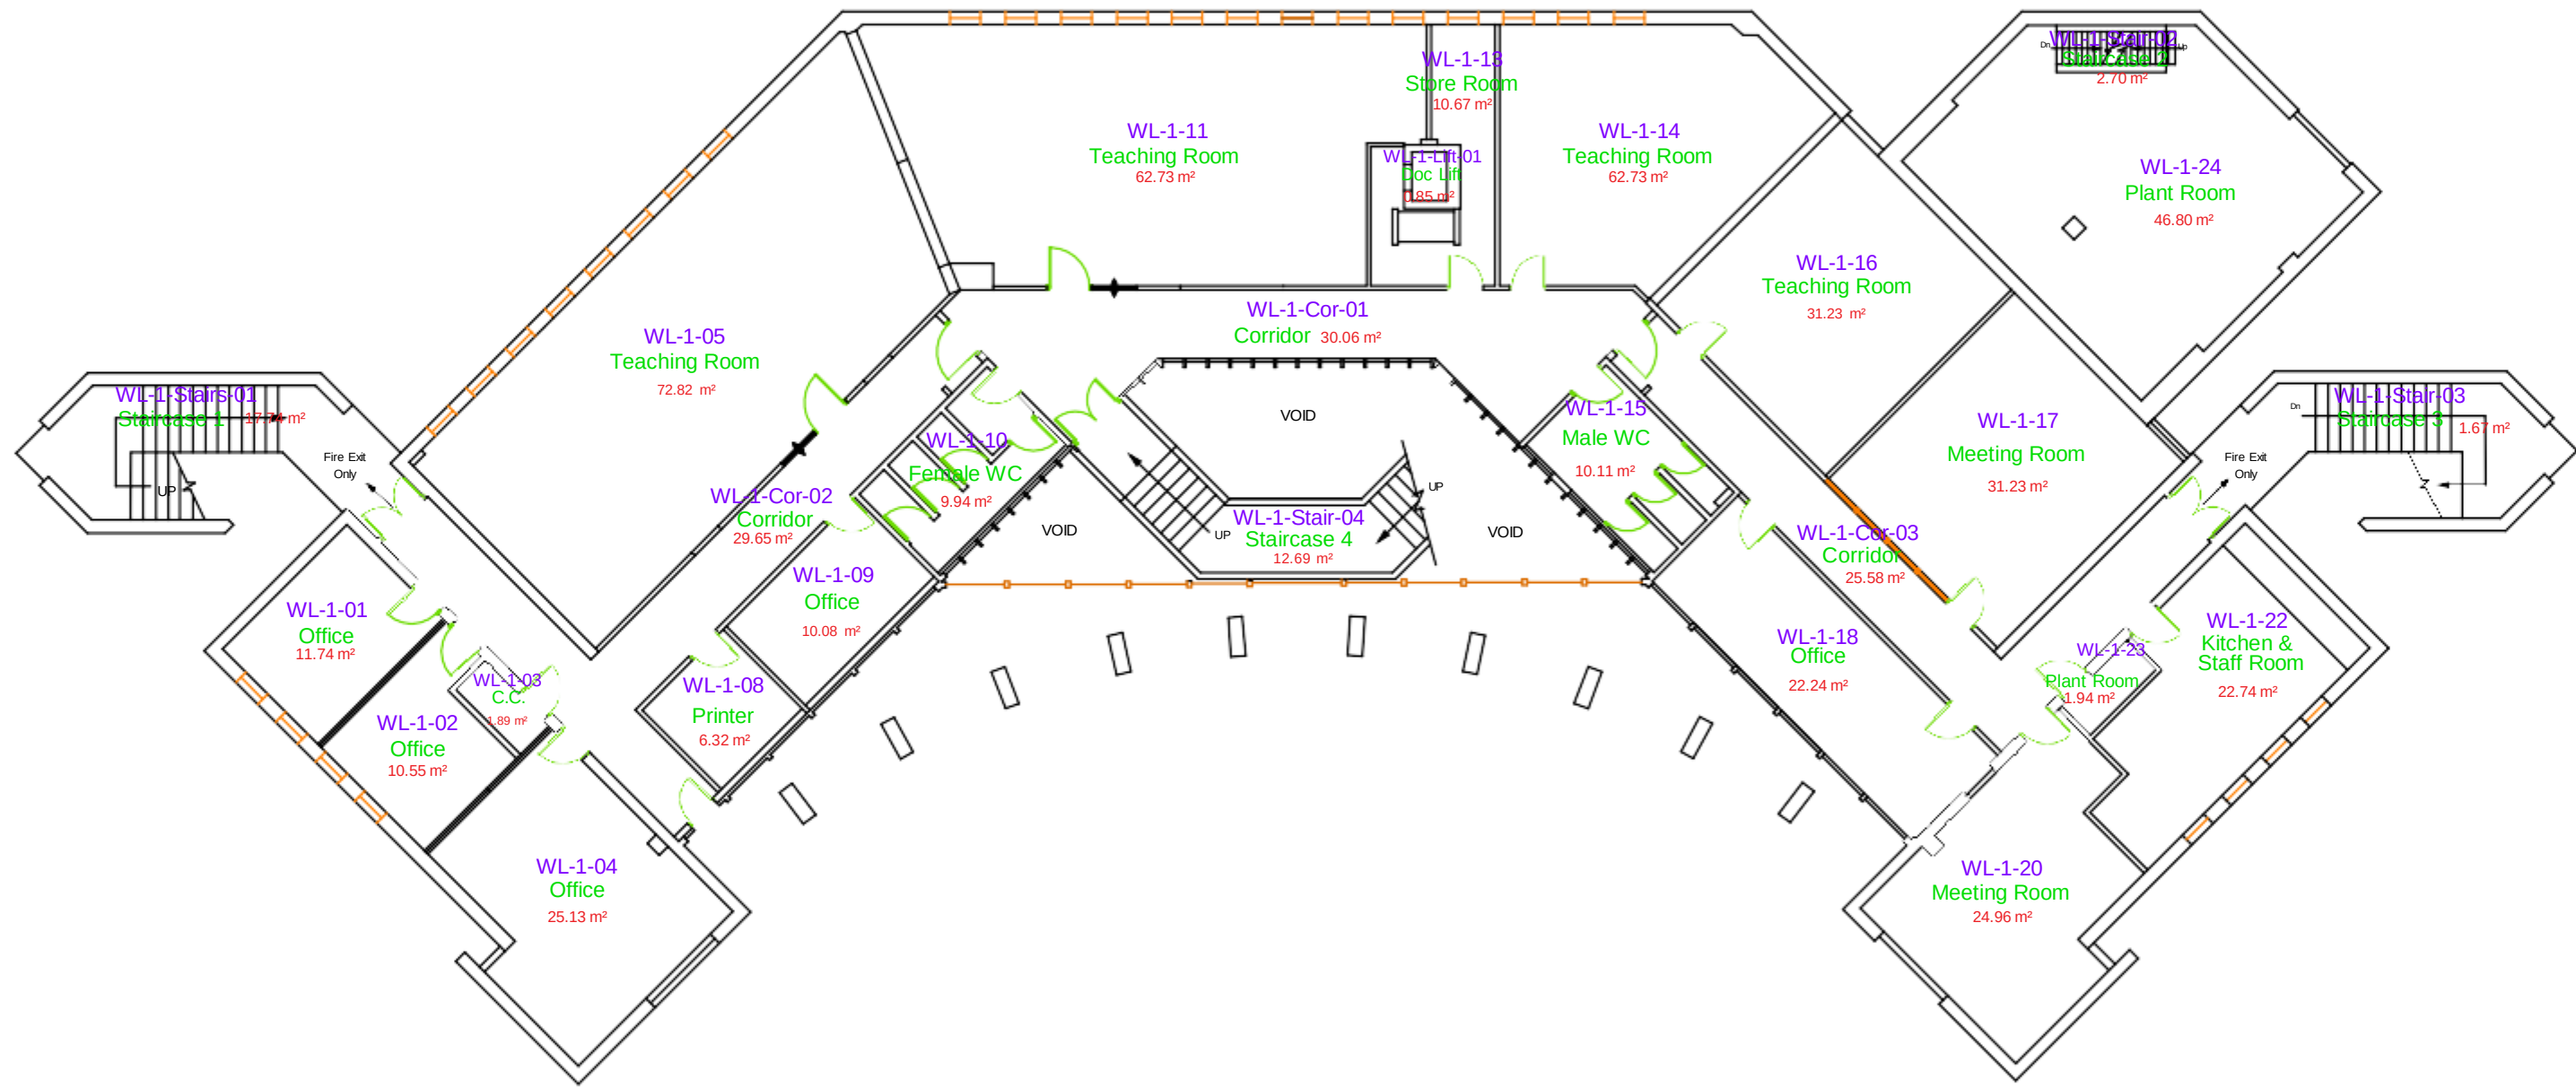

NOTES

This Drawing is The Copyright Of Coventry University
Estates Department & Must Not Be Reproduced
Without Their Permission. Figured Dimensions Must Be
Taken in Preference To Scaled Dimensions & All
Dimensions Must Be Verified On Site Prior To
Commencing Any Works.

AREAS

GEA (Gross External Area)	699.33 m ²
GIA (Gross Internal Area)	576.32 m ²
NIA (Net Internal Area)	387.06 m ²



Rev.	Date	Amendment
------	------	-----------



Estates Department
Priority Street, Coventry
CV1 5F9
Tel: 024 76887688
Fax: 024 76887336

CURRENT STATUS

RECORD DRAWING

PROJECT

SIR WILLIAM LYONS

TITLE

FIRST FLOOR

DRAWN PC	CHKD CHKD	DATE 07/12/2021
-------------	--------------	--------------------

SCALE 1/100 @ A1 1/200 @ A2	DRAWING No. SWL01-COV-00-01-M2-A	REV. 0000
-----------------------------------	-------------------------------------	--------------