



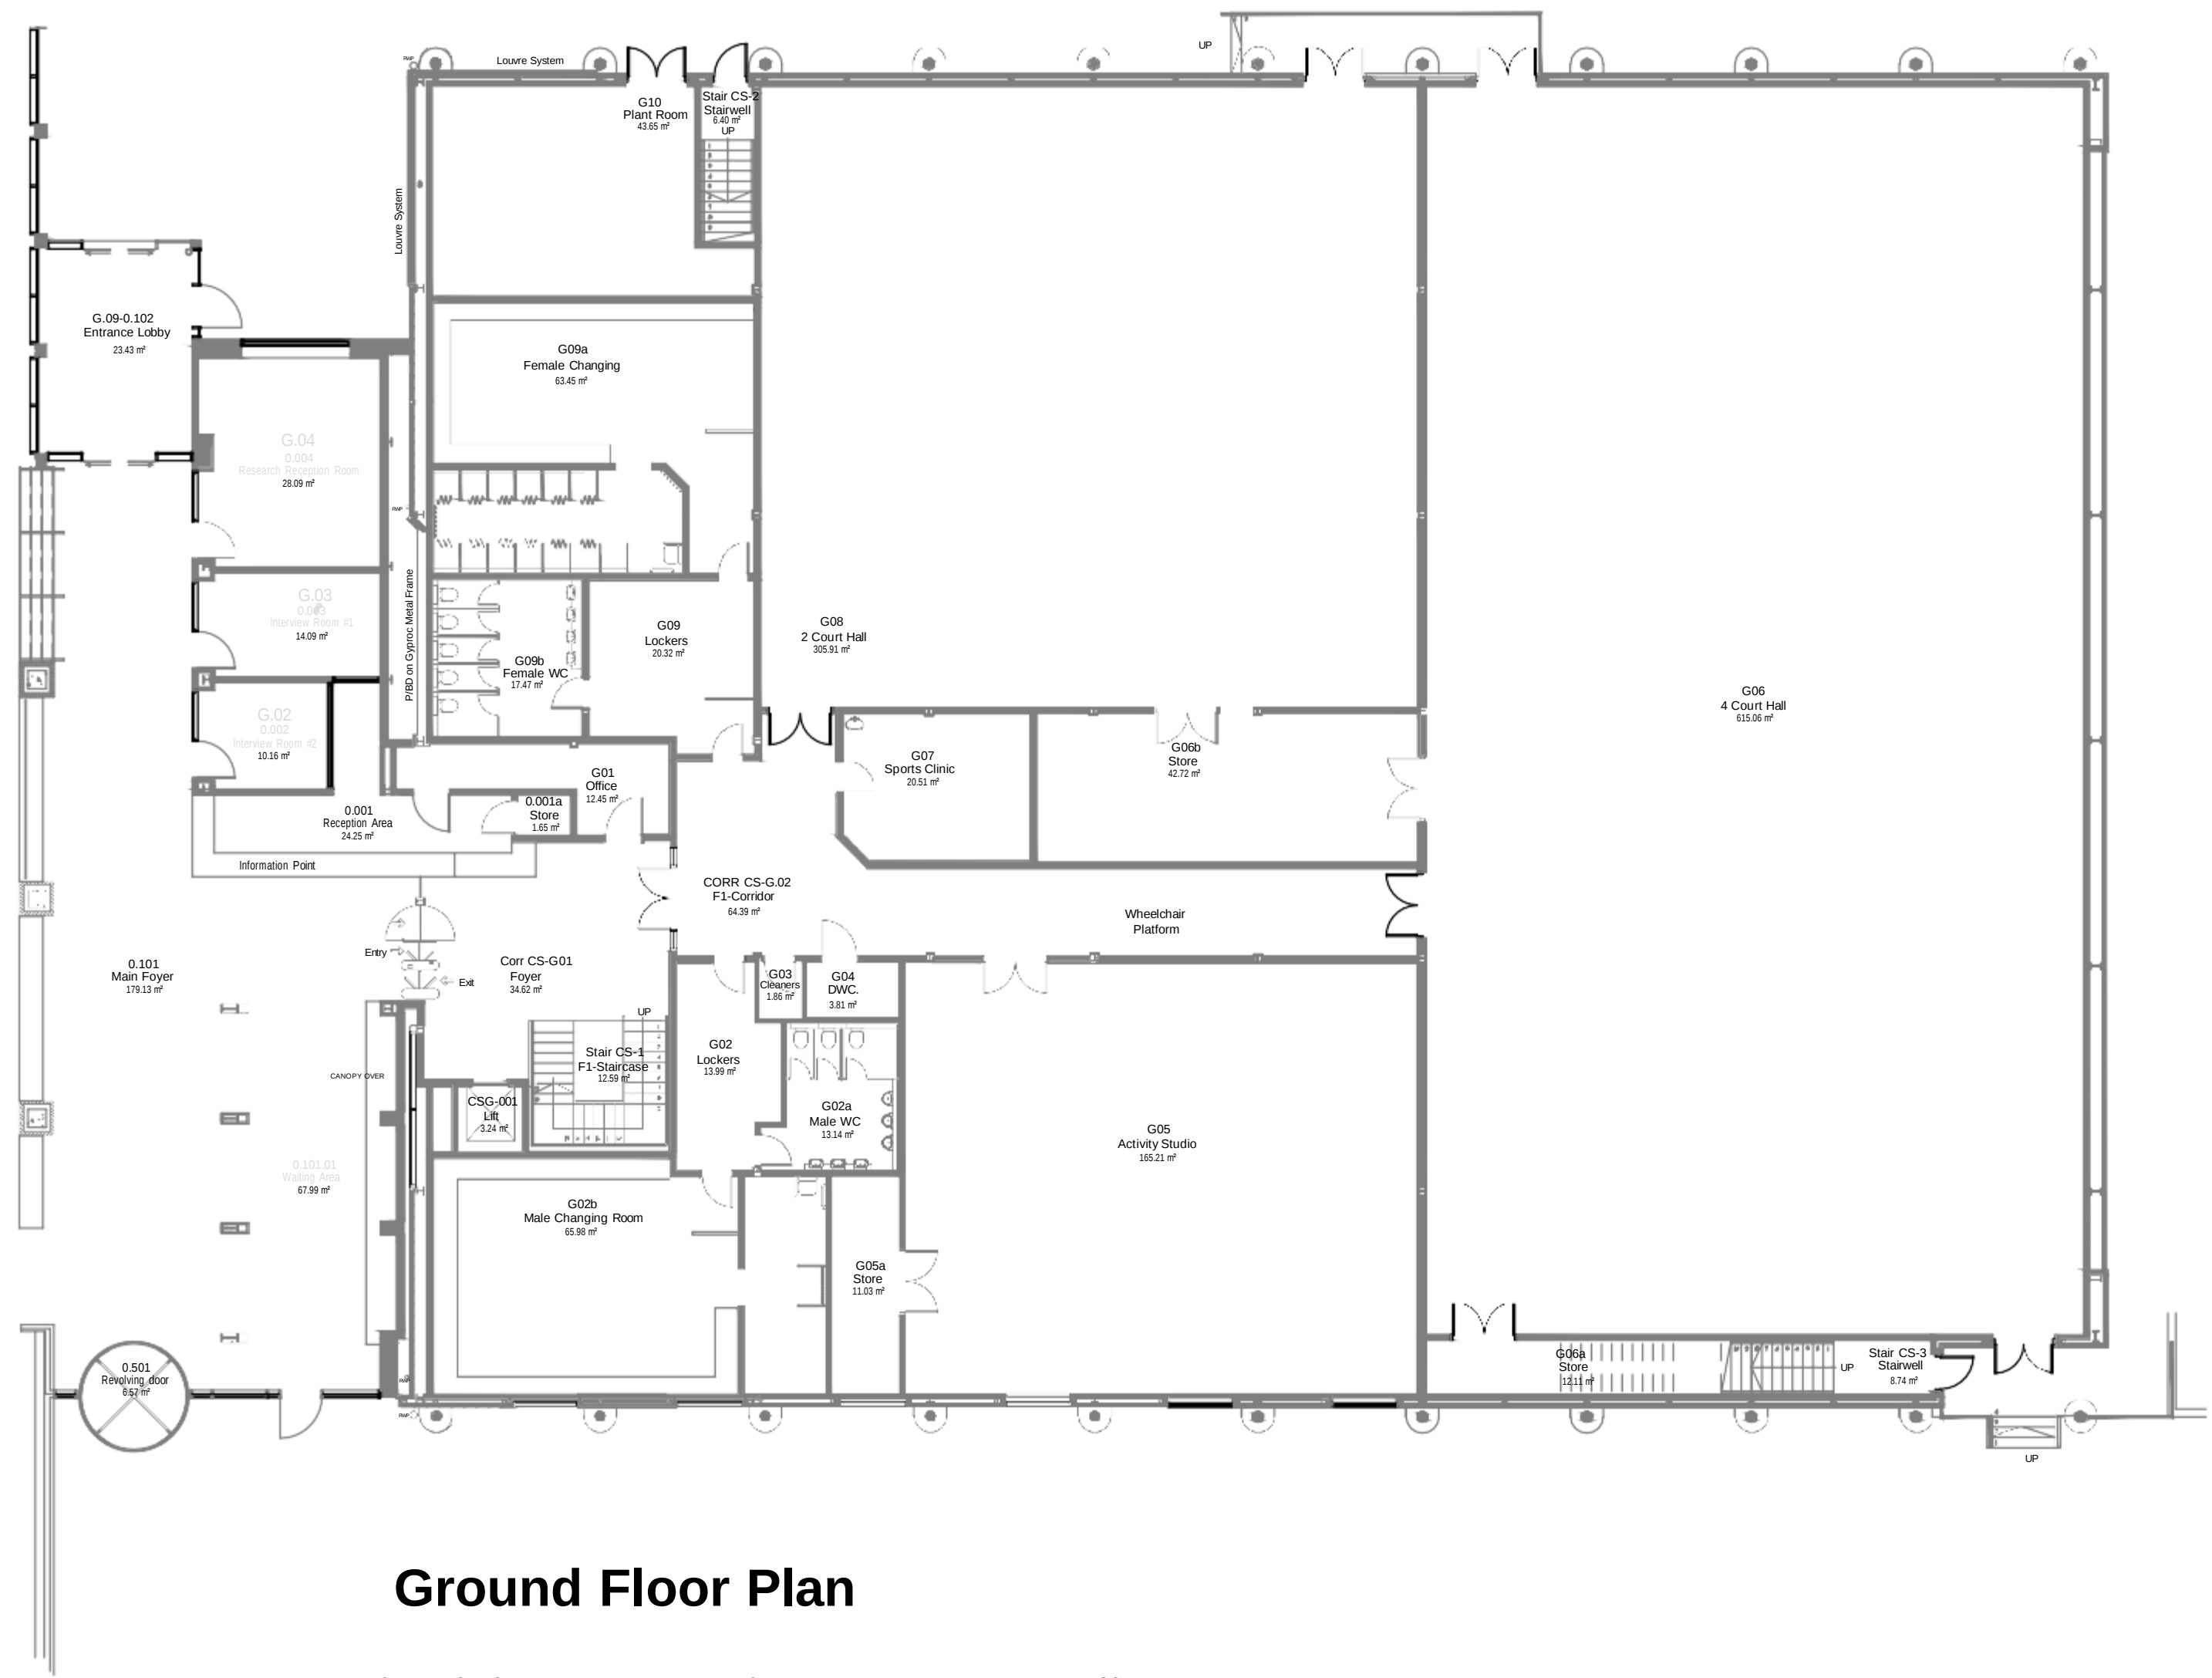

Ground Floor Plan

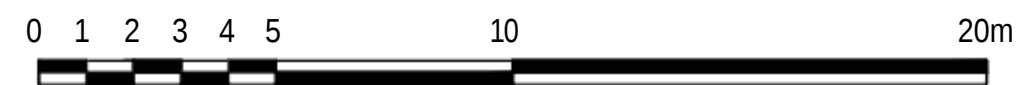

NOTES

This Drawing Is The Copyright Of Coventry University Estates Department & Must Not Be Reproduced Without Their Permission. Figured Dimensions Must Be Taken In Preference To Scaled Dimensions & All Dimensions Must Be Verified On Site Prior To Commencing Any Works.



NOTE	
GIA	1611.56 m²
GEA	1712.68 m²


A	16/03/2018	Drawing amended to match as built floor plan
Rev.	Date	Amendment




Coventry University

Estates Department
Priory Street, Coventry
CV1 5FB
Tel: 024 76887688
Fax: 024 76887336

CURRENT STATUS		
RECORD DRAWING		
PROJECT		
SPORTS CENTRE		
TITLE		
GROUND FLOOR PLAN		
DRAWN	CHKD	DATE
EM	HS	16/03/2018
SCALE	DRAWING No.	REV.
1/150 @ A2	CS001-COV-00-GF-M2-A	0000

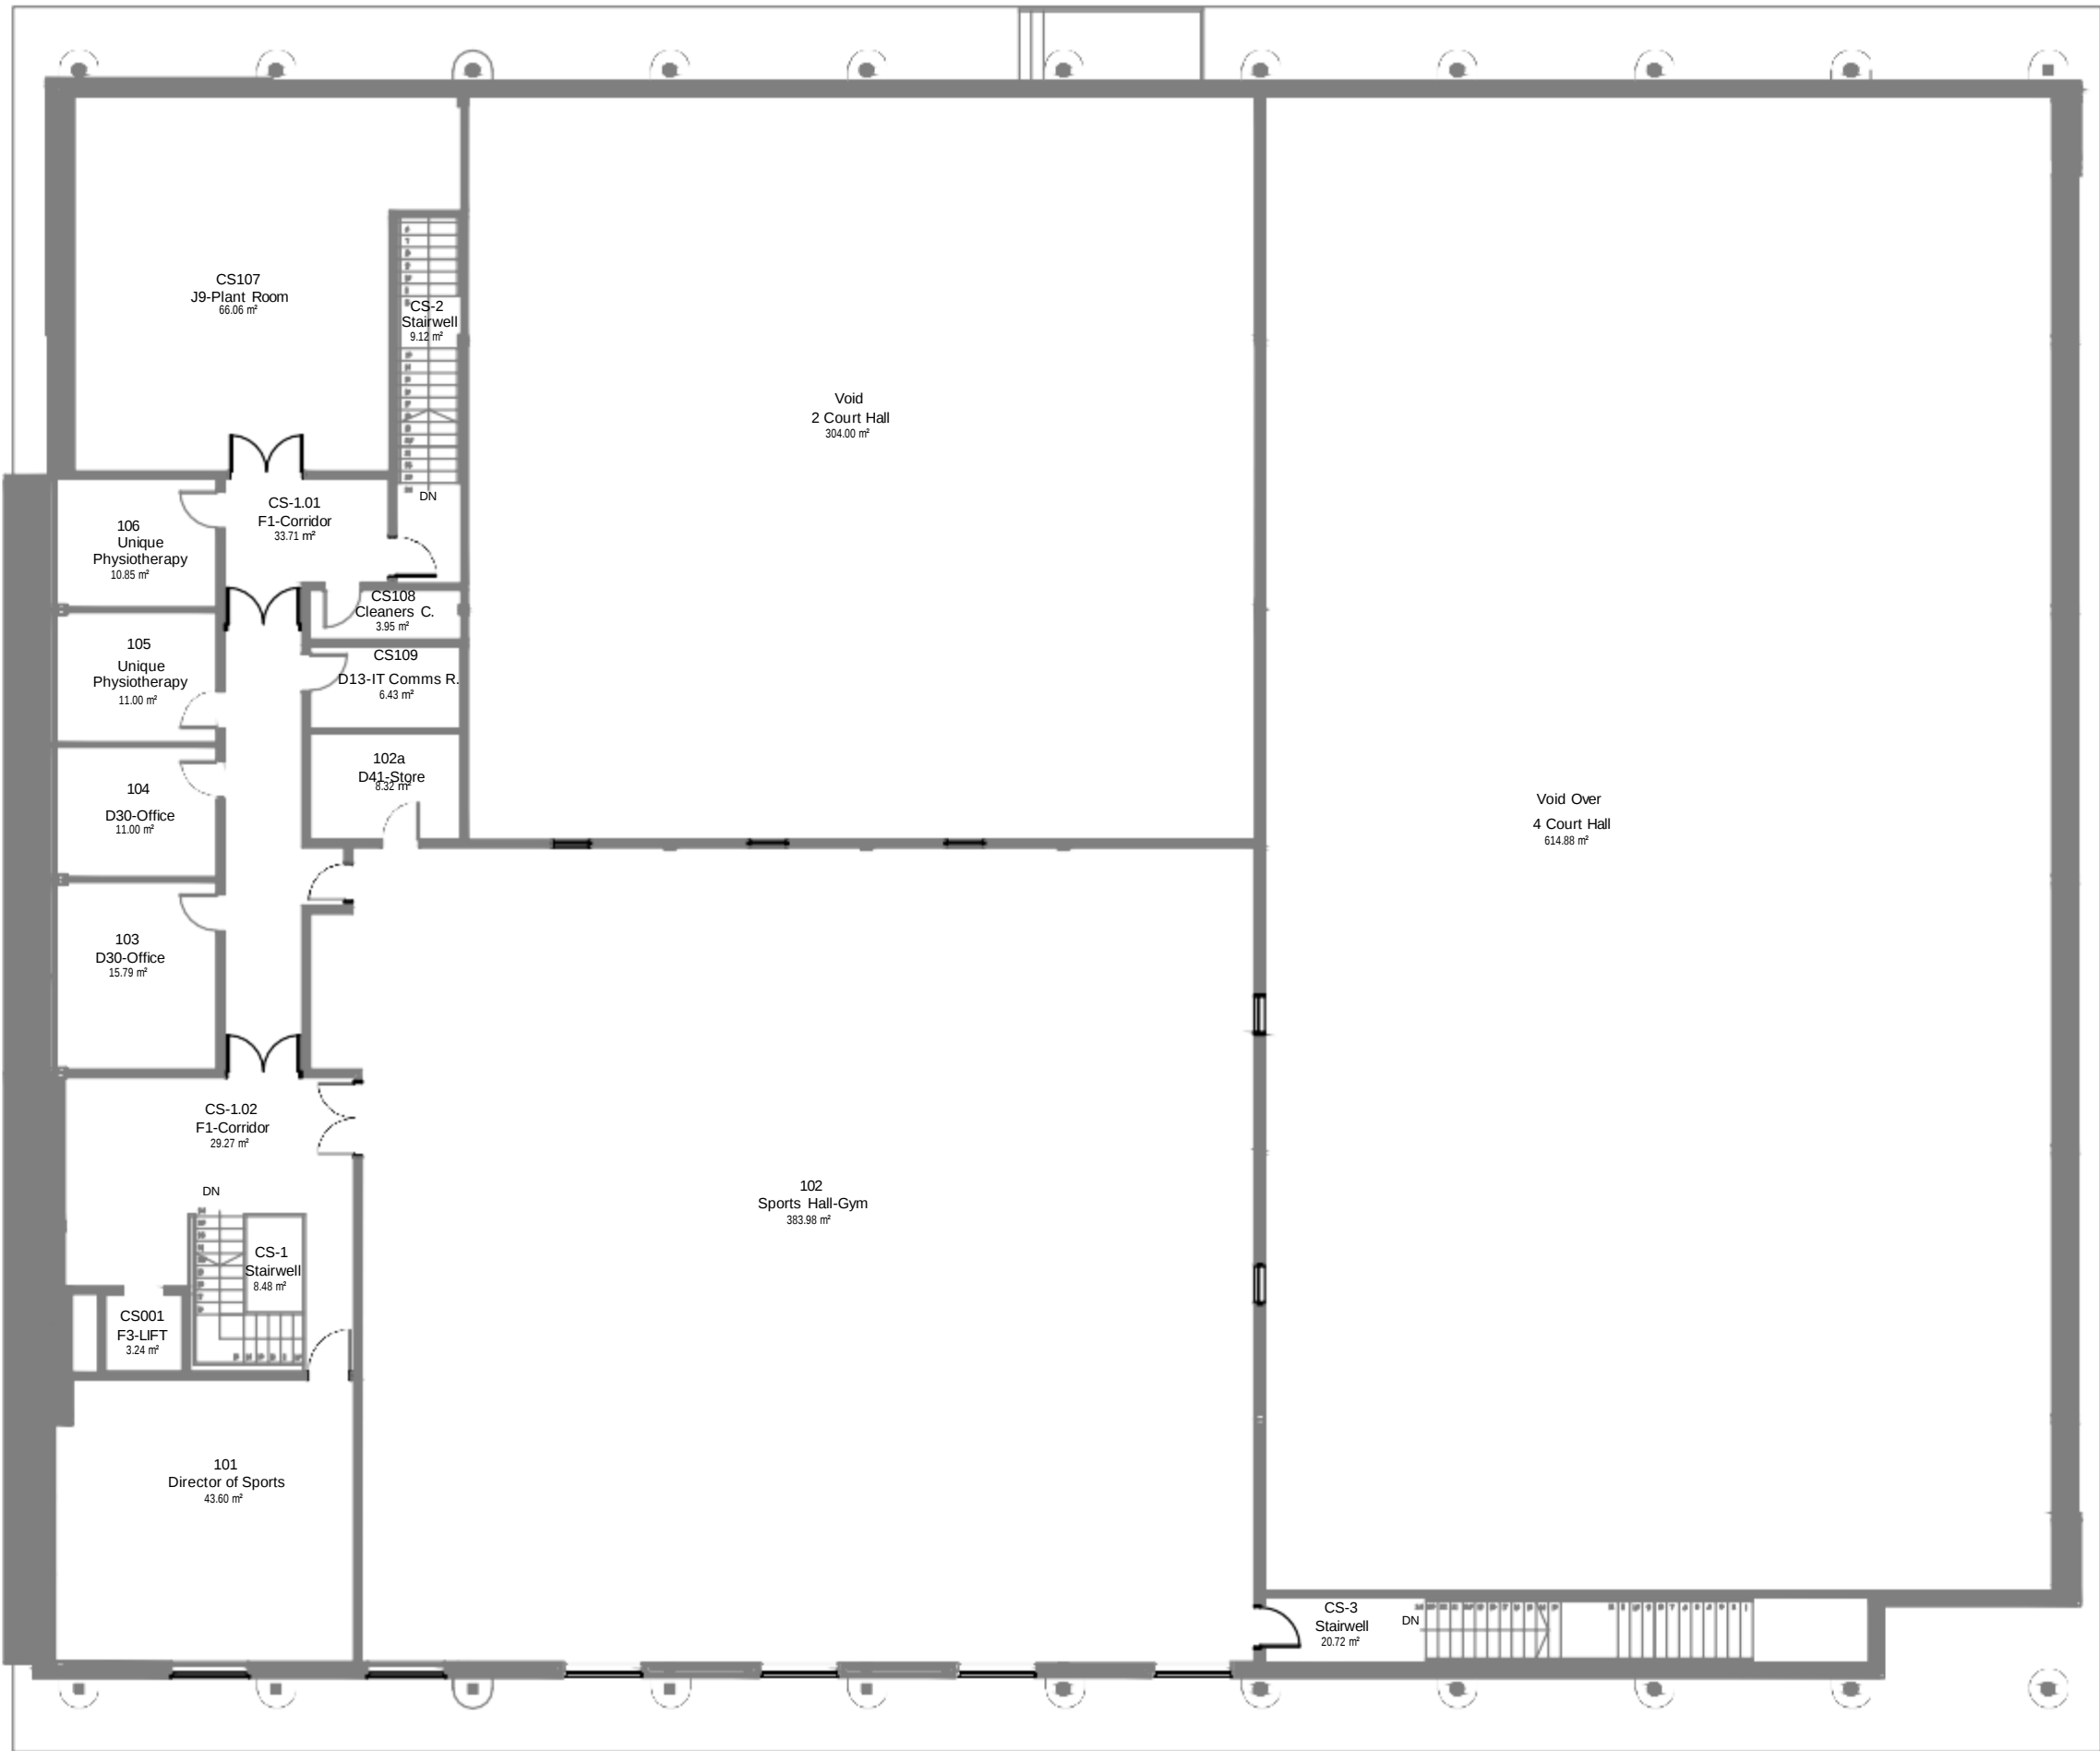


First Floor Plan

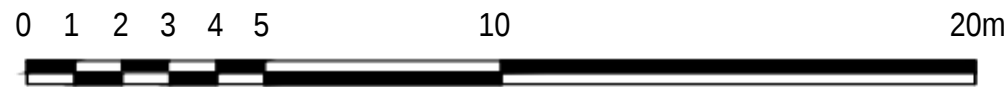

NOTES

This Drawing Is The Copyright Of Coventry University Estates Department & Must Not Be Reproduced Without Their Permission. Figured Dimensions Must Be Taken In Preference To Scaled Dimensions & All Dimensions Must Be Verified On Site Prior To Commencing Any Works.

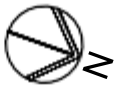

NOTE

GIA	1620.15 m²
GEA	1715.56 m²

A	16/03/2018	Drawing amended to match as built floor plan
Rev.	Date	Amendment



Coventry University

Estates Department
Priority Street, Coventry
CV1 5FB
Tel: 024 76887688
Fax: 024 76887336

CURRENT STATUS			
RECORD DRAWING			
PROJECT			
SPORTS CENTRE			
TITLE			
FIRST FLOOR PLAN			
DRAWN		CHKD	DATE
EM		HS	16/03/2018
SCALE		DRAWING No.	
1/150 @ A2		CS001-COV-00-01-M2-A	
REV.			0000