



NOTES	
This Drawing Is The Copyright Of Coventry University Estates Department & Must Not Be Reproduced Without Their Permission. Figured Dimensions Must Be Taken In Preference To Scaled Dimensions & All Dimensions Must Be Verified On Site Prior To Commencing Any Works.	
GIA (Gross Internal Area)	1377.02 m ²
GEA (Gross External Area)	1436.81 m ²
NIA (Net Internal Area)	/ m ²

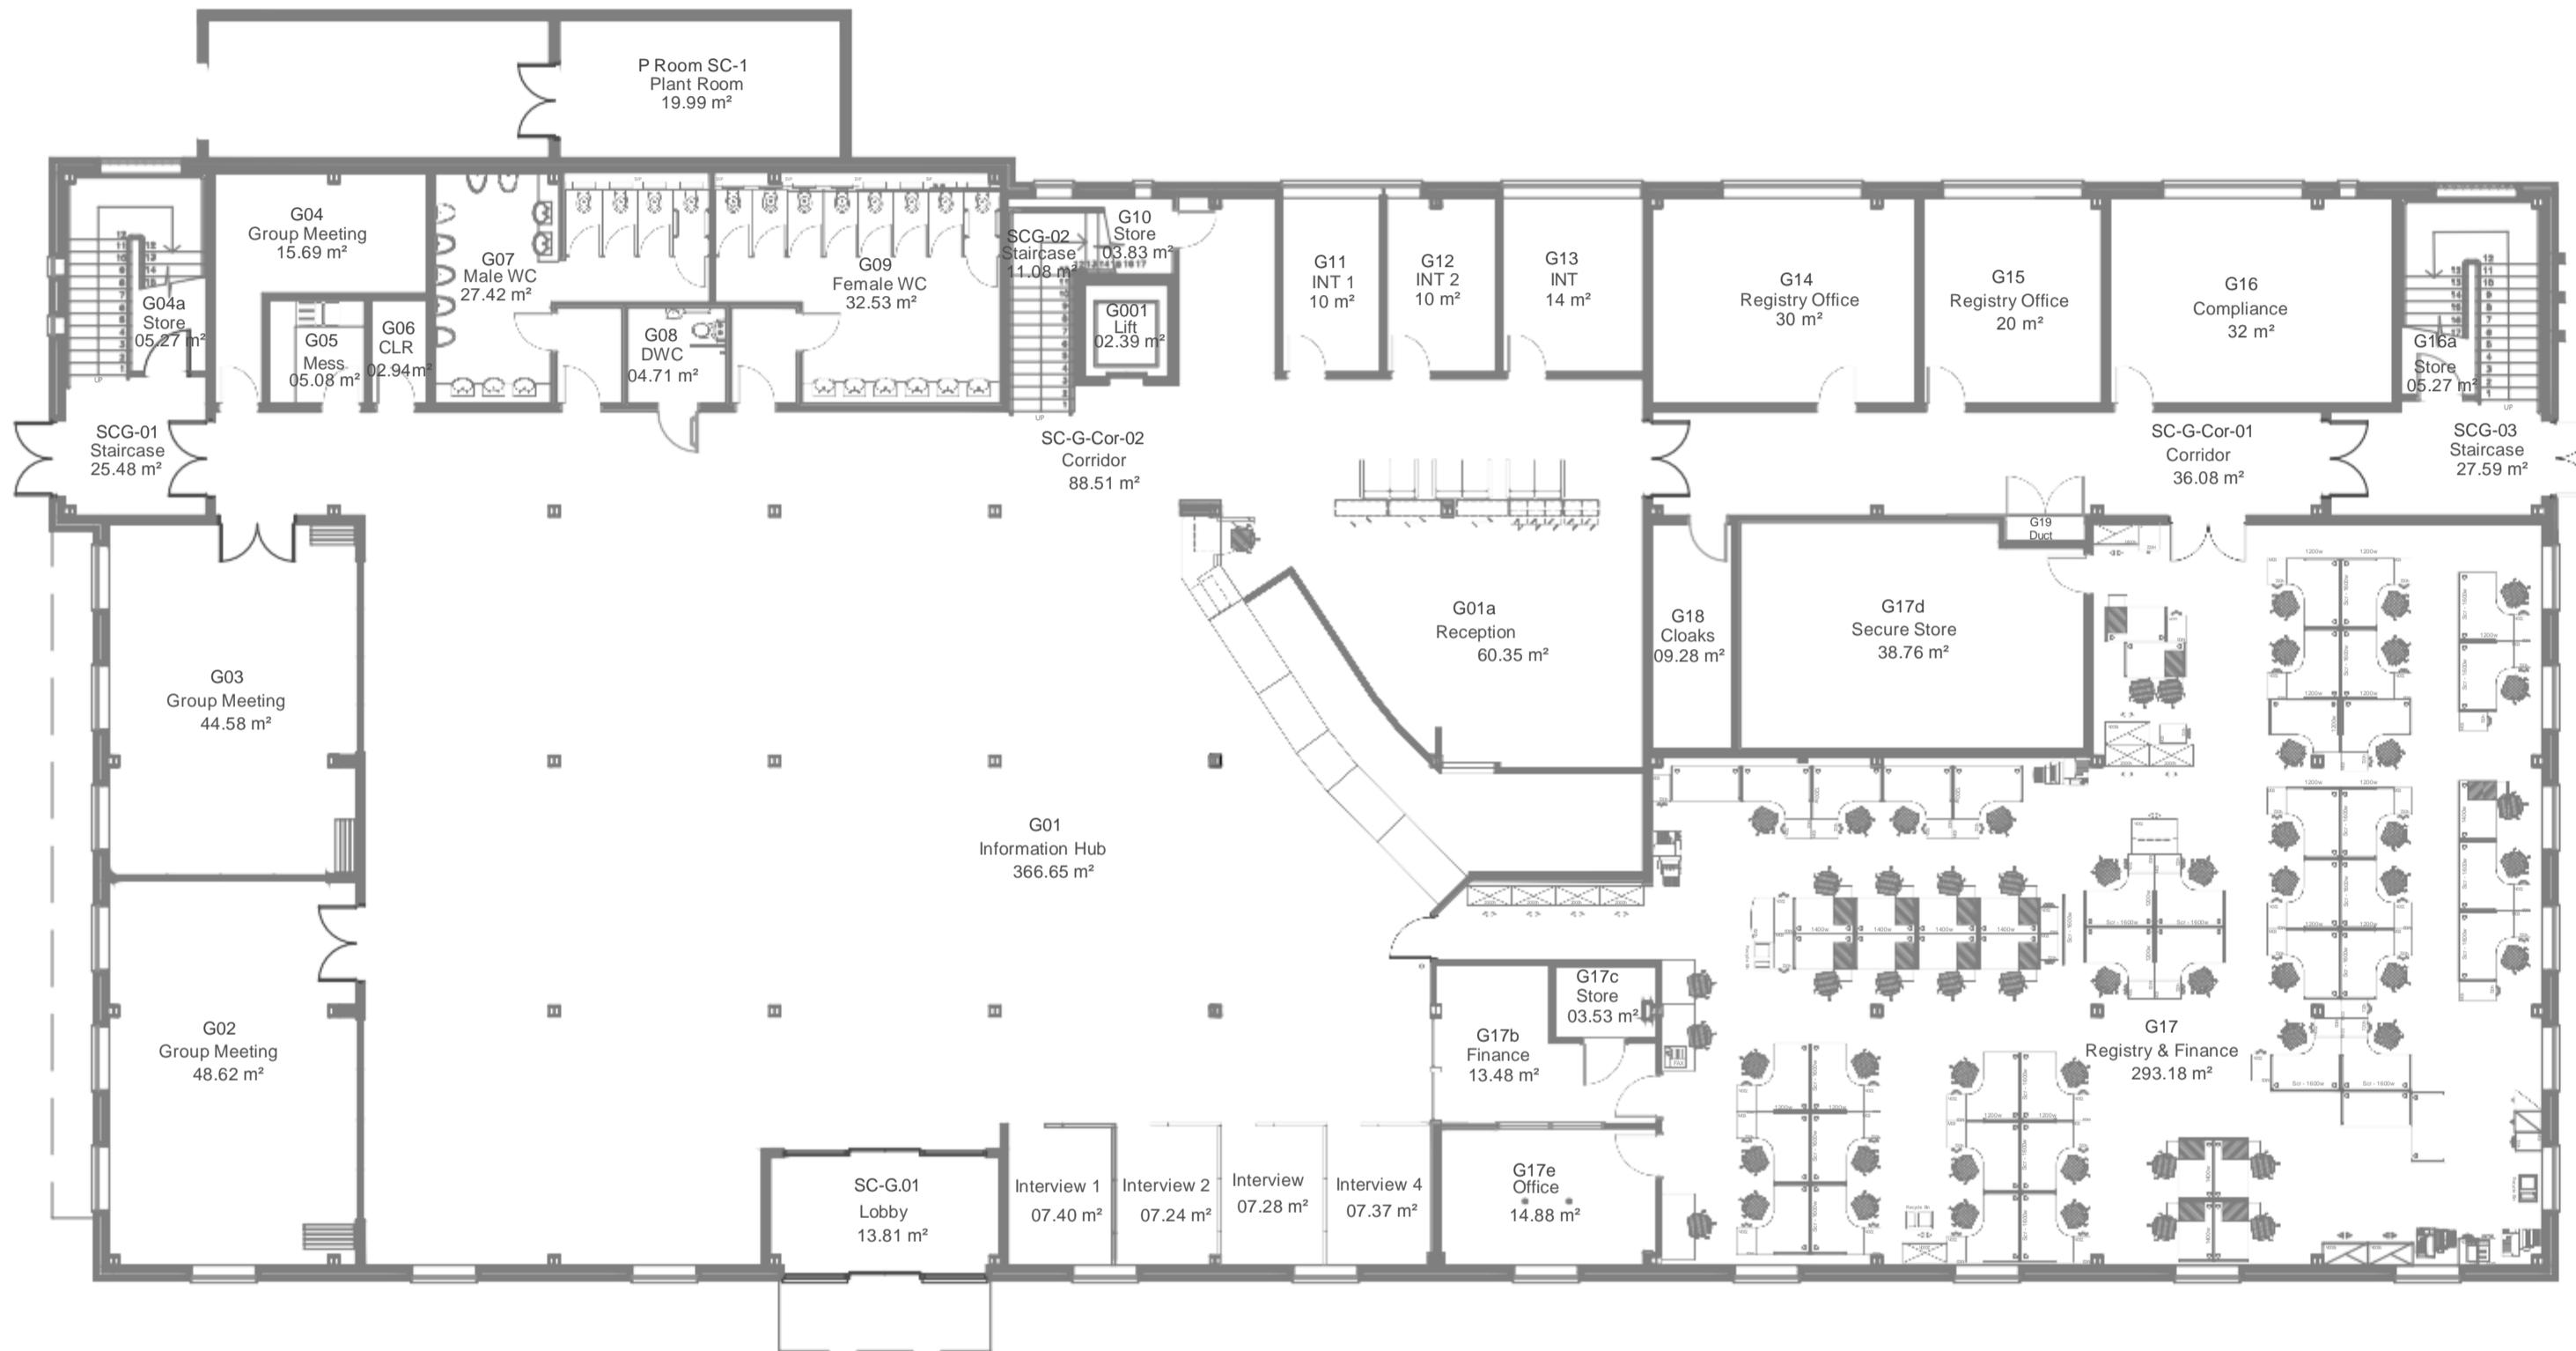

Student Centre Ground Floor Plan

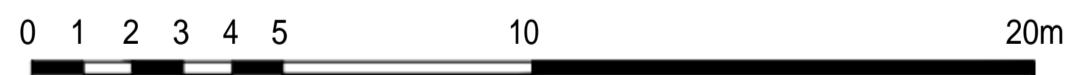

B	04/02/2021	Corridor numbers changed
A	11/06/2018	Drawing amended to match as built floor plan
Rev. Date		Amendment



**Coventry
University**


Estate Department
Philly Street, Coventry
CV1 5FB
Tel: 024 76887688
Fax: 024 76887336

CURRENT STATUS		
RECORD DRAWING		
PROJECT		
STUDENT CENTRE BUILDING		
TITLE		
AS BUILT GROUND FLOOR PLAN		
DRAWN	EM	CHKD
		HS
DATE		
04/02/2021		
SCALE	1/100 @ A1	DRAWING No.
		SC001-COV-00-GF-M2-A
REV.		B


NOTES

This Drawing Is The Copyright Of Coventry University Estates Department & Must Not Be Reproduced Without Their Permission. Figured Dimensions Must Be Taken As A Guide. Detailed Dimensions & All Dimensions Must Be Verified On Site Prior To Commencing Any Works.

GIA (gross Internal Area)	1353.75 m ²
GEA (gross External Area)	1413.92 m ²
NIA (Net Internal Area)	/ m ²

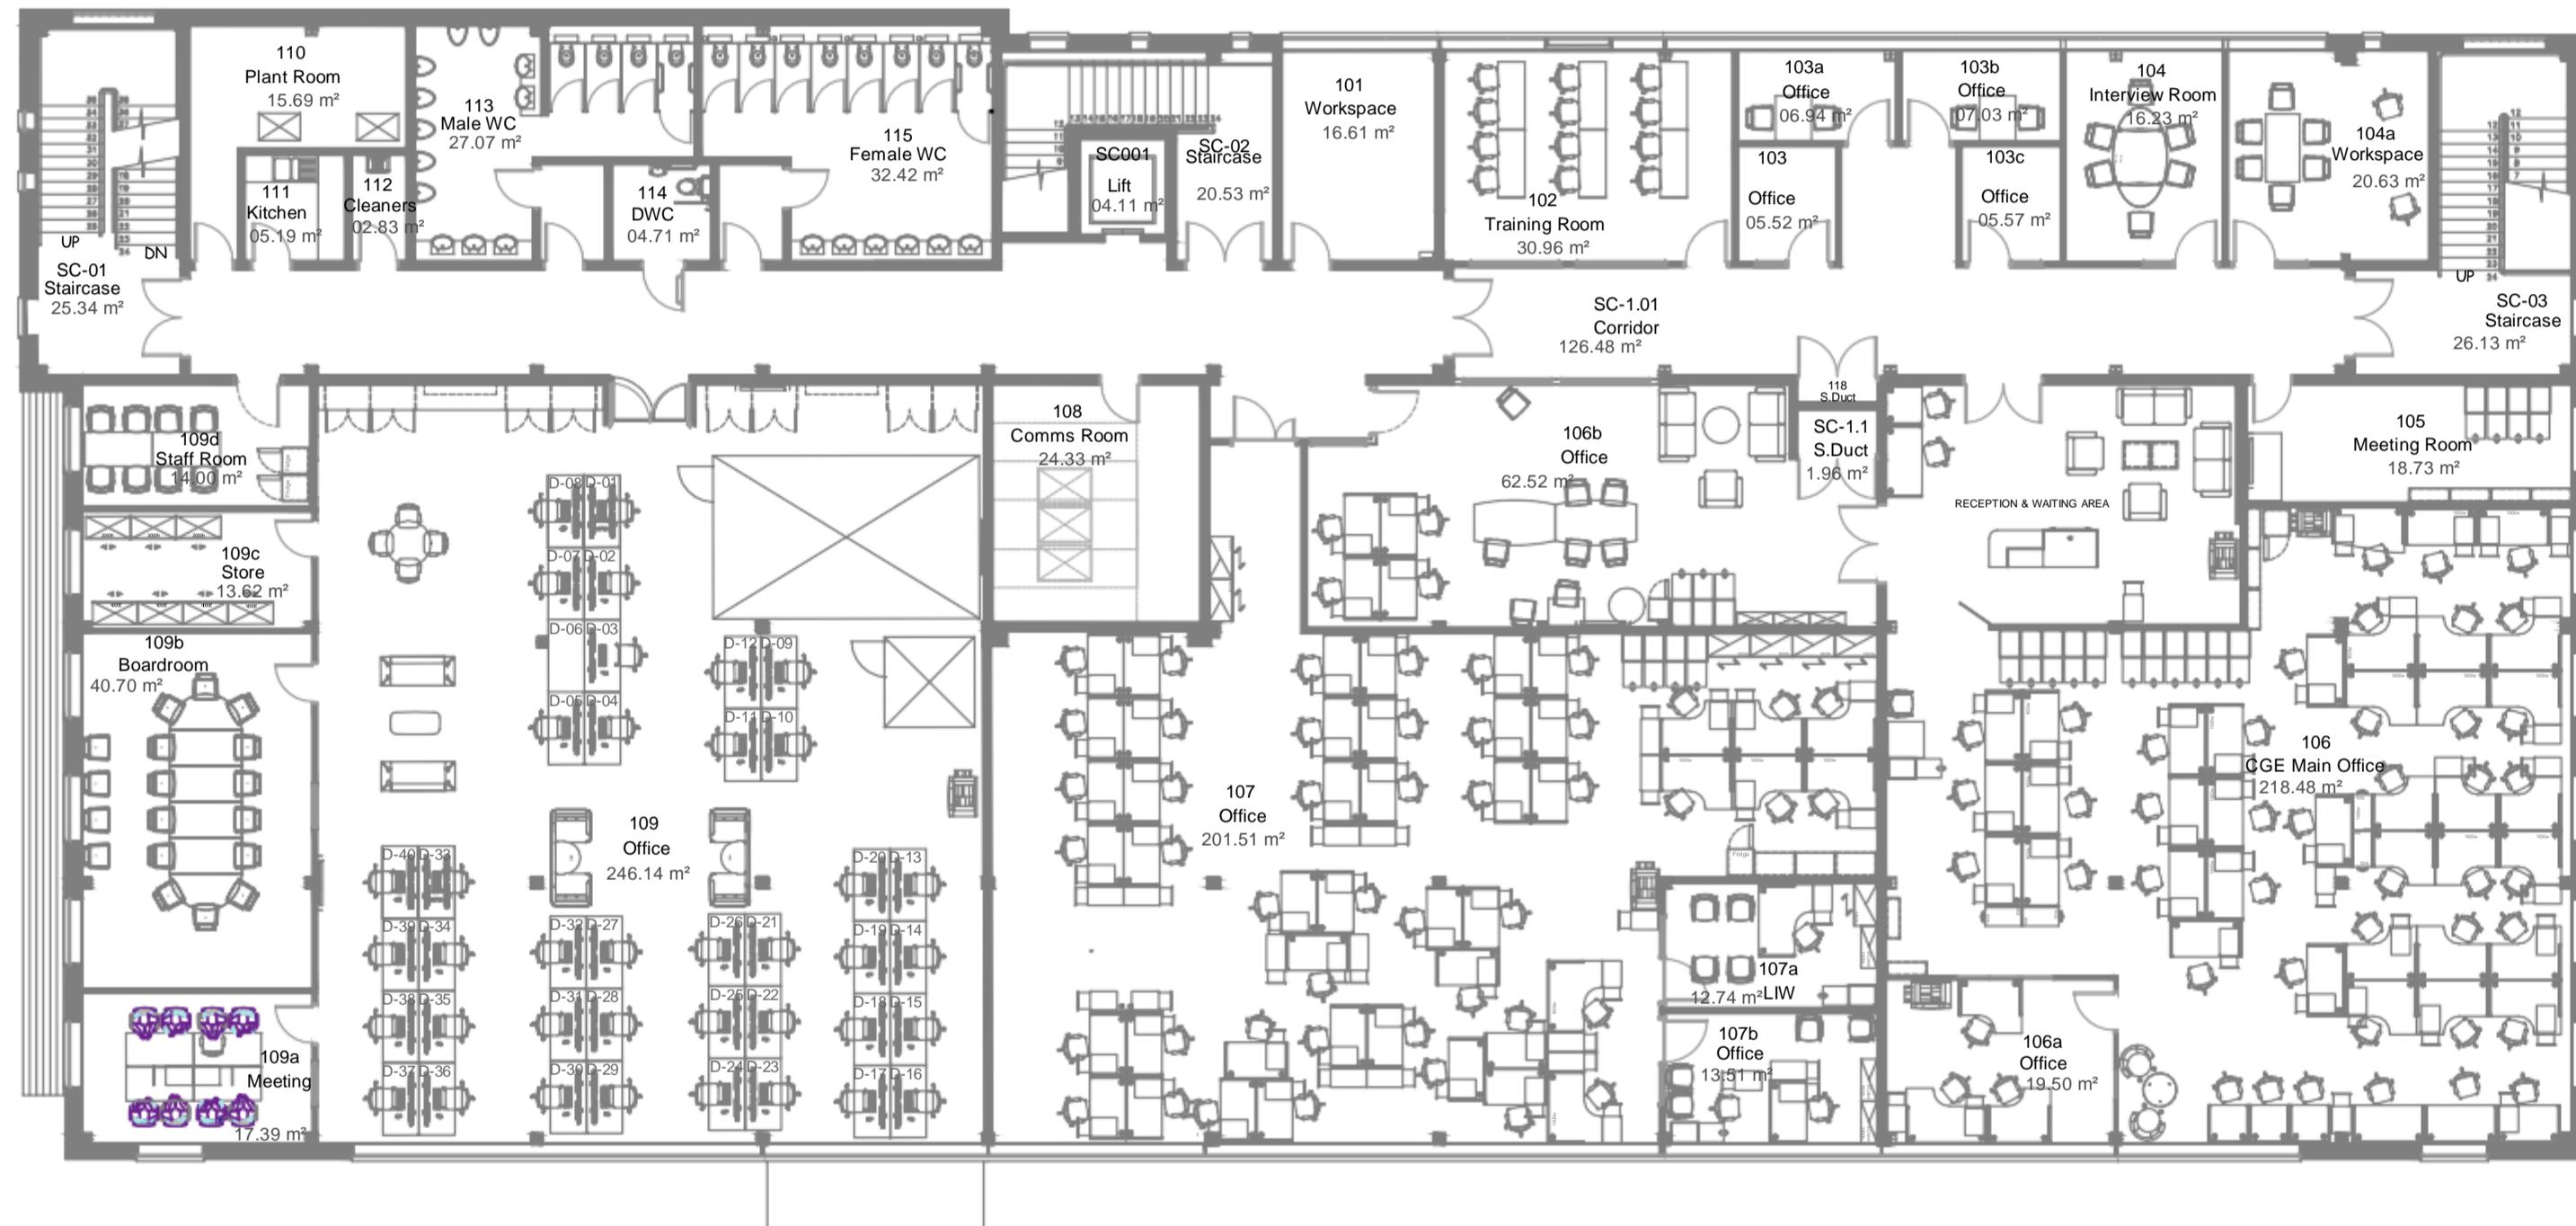

Student Centre First Floor Plan

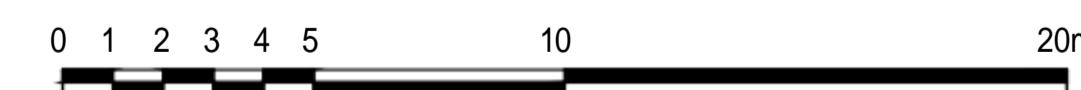

B 30/09/2022 Space change - Room 109 created with Bookable desks
A 11/06/2018 Drawing amended to match as built floor plan
Rev. Date Amendment



Coventry
University

Estate Department
Priory Street, Coventry
CV1 5FB
Tel: 024 76887688
Fax: 024 76887336

CURRENT STATUS

RECORD DRAWING

PROJECT
STUDENT CENTRE BUILDING


TITLE
AS BUILT FIRST FLOOR PLAN

DRAWN EM	CHKD HS	DATE 11/06/2018
SCALE 1/100 @ A1	DRAWING No. SC001-COV-00-01-M2-A	REV. B

NOTES

This Drawing Is The Copyright Of Coventry University Estates Department & Must Not Be Reproduced Without Their Permission. Figured Dimensions Must Be Given In Preference To Scaled Dimensions & All Dimensions Must Be Verified On Site Prior To Commencing Any Works.

GIA (gross Internal Area)	166.04 m ²
GEA (gross External Area)	184.93 m ²
NIA (Net Internal Area)	/ m ²

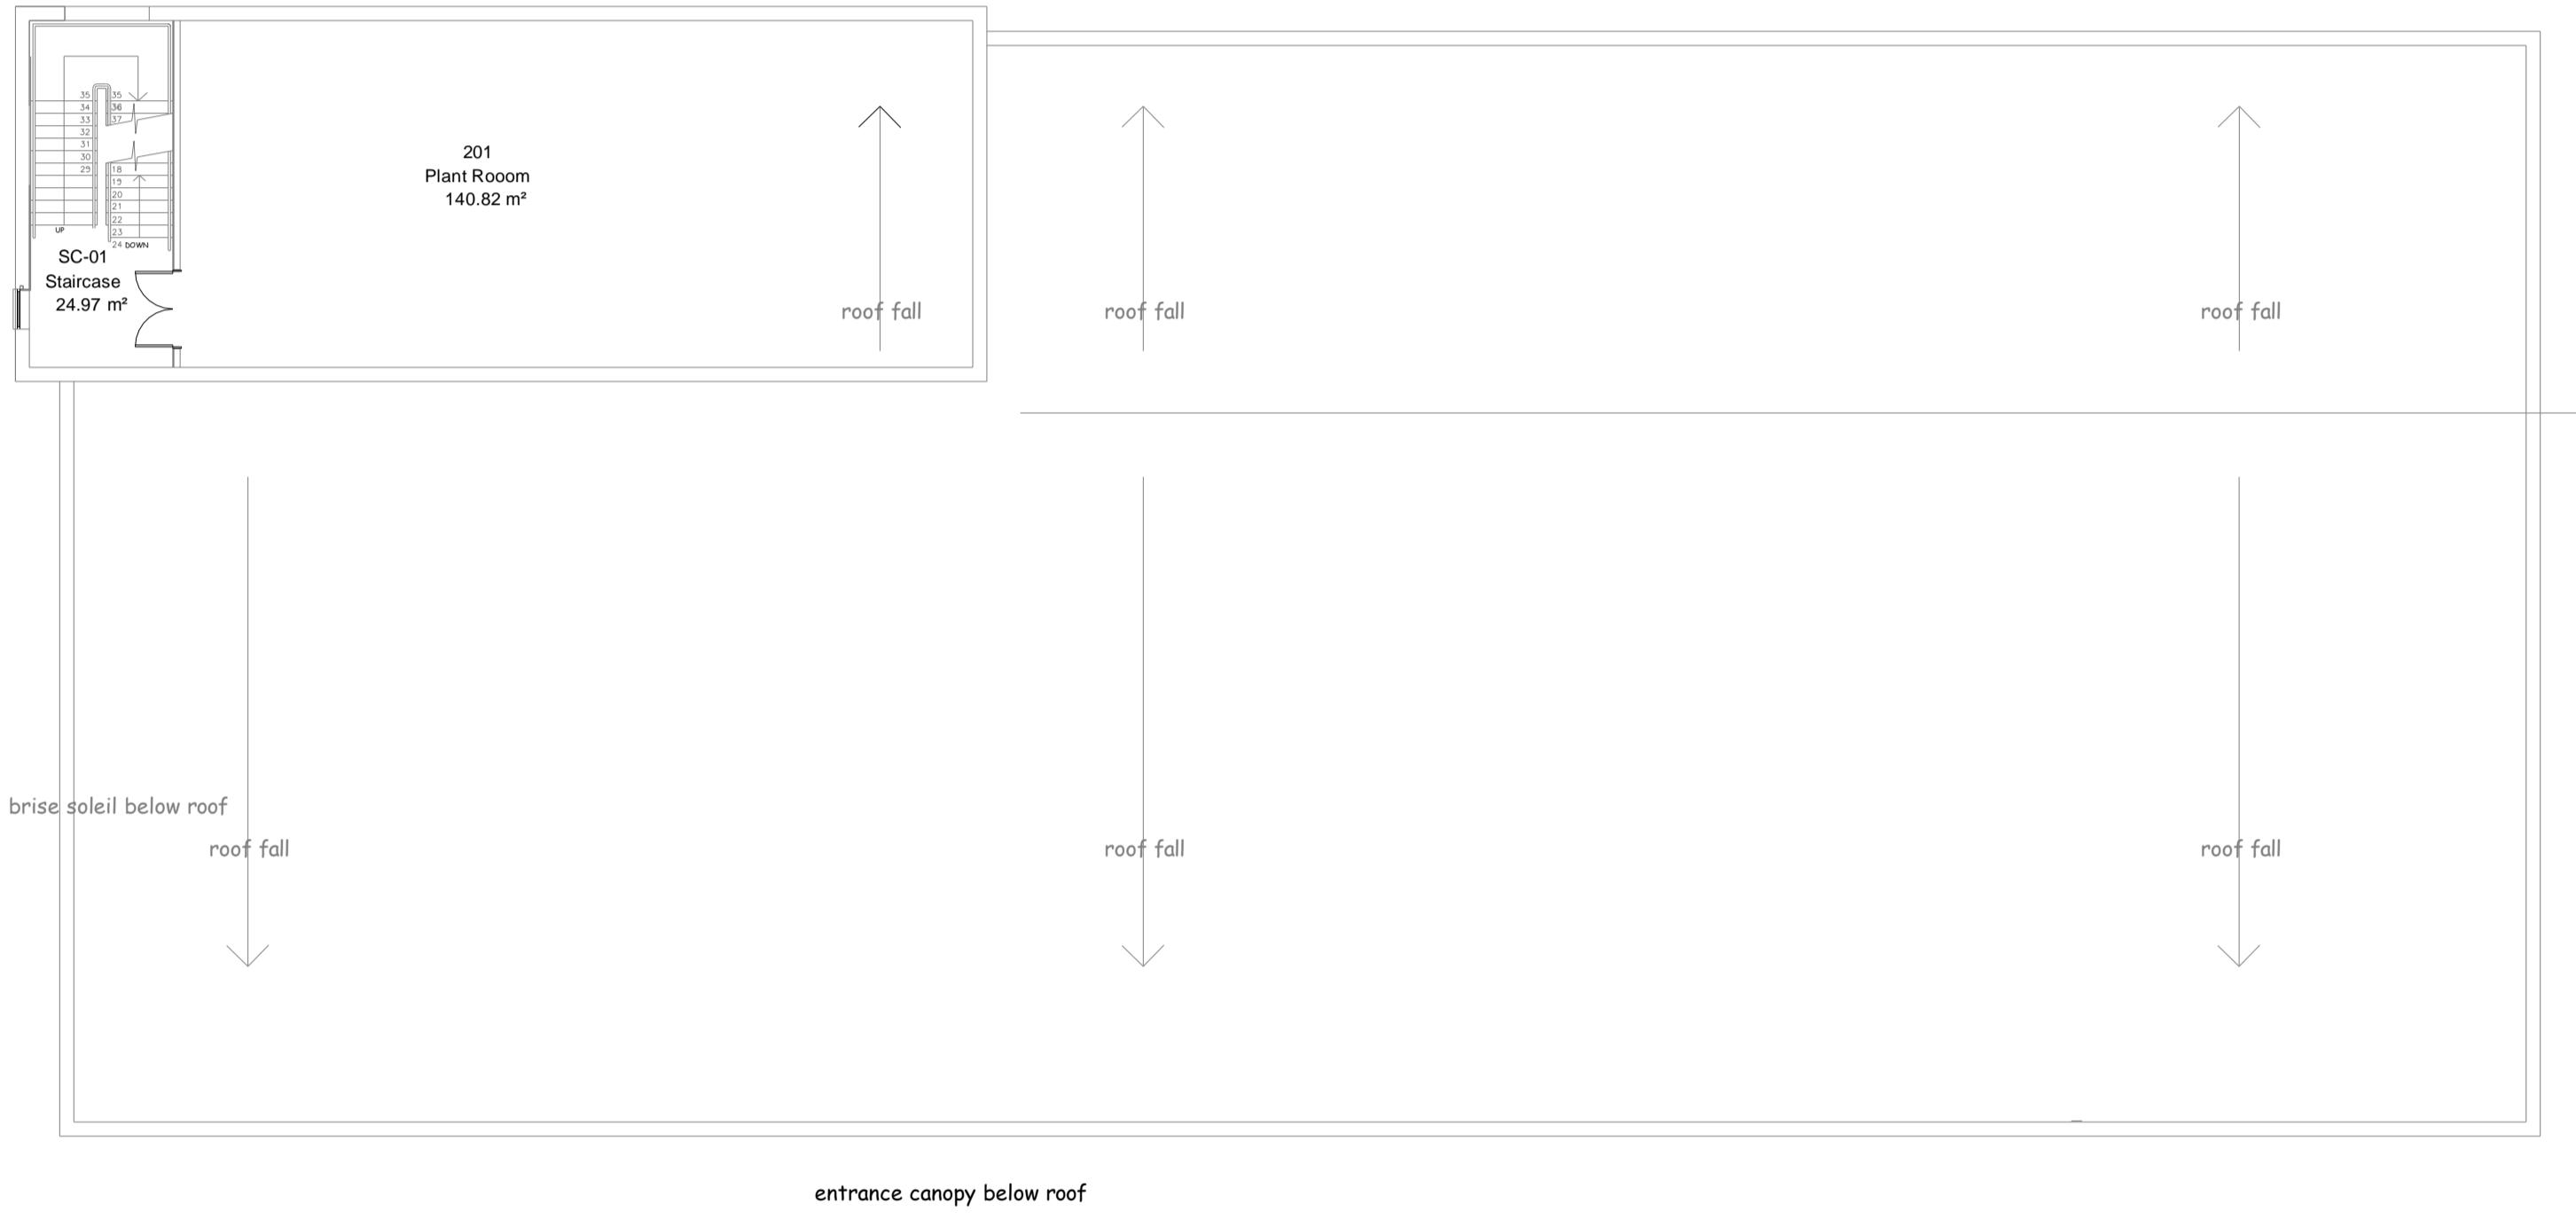

0 1 2 3 4 5 10 20m

Roof Plan

A 11/06/2018 Drawing amended to match as built floor plan
Rev. Date Amendment



Coventry
University

Estates Department
Priory Street, Coventry
CV1 5FB
Tel: 024 76887688
Fax: 024 76887336

CURRENT STATUS
RECORD DRAWING

PROJECT
STUDENT CENTRE BUILDING

TITLE
AS BUILT ROOF PLAN

DRAWN EM CHKD HS DATE
11/06/2018

SCALE 1/100 @ A1 DRAWING No. SC001-COV-00-R-M2-A REV. 0000