


NOTES

This Drawing Is The Copyright Of Coventry University Estates Department & Must Not Be Reproduced Without Their Permission. Figured Dimensions Must Be Taken In Preference To Scaled Dimensions & All Dimensions Must Be Verified On Site Prior To Commencing Any Works.

NIA : 55.94m²
(Net Internal Area) :

GIA : 118.78m²
(Gross Internal Area)

GEA : 137.40m²
(Gross External Area)

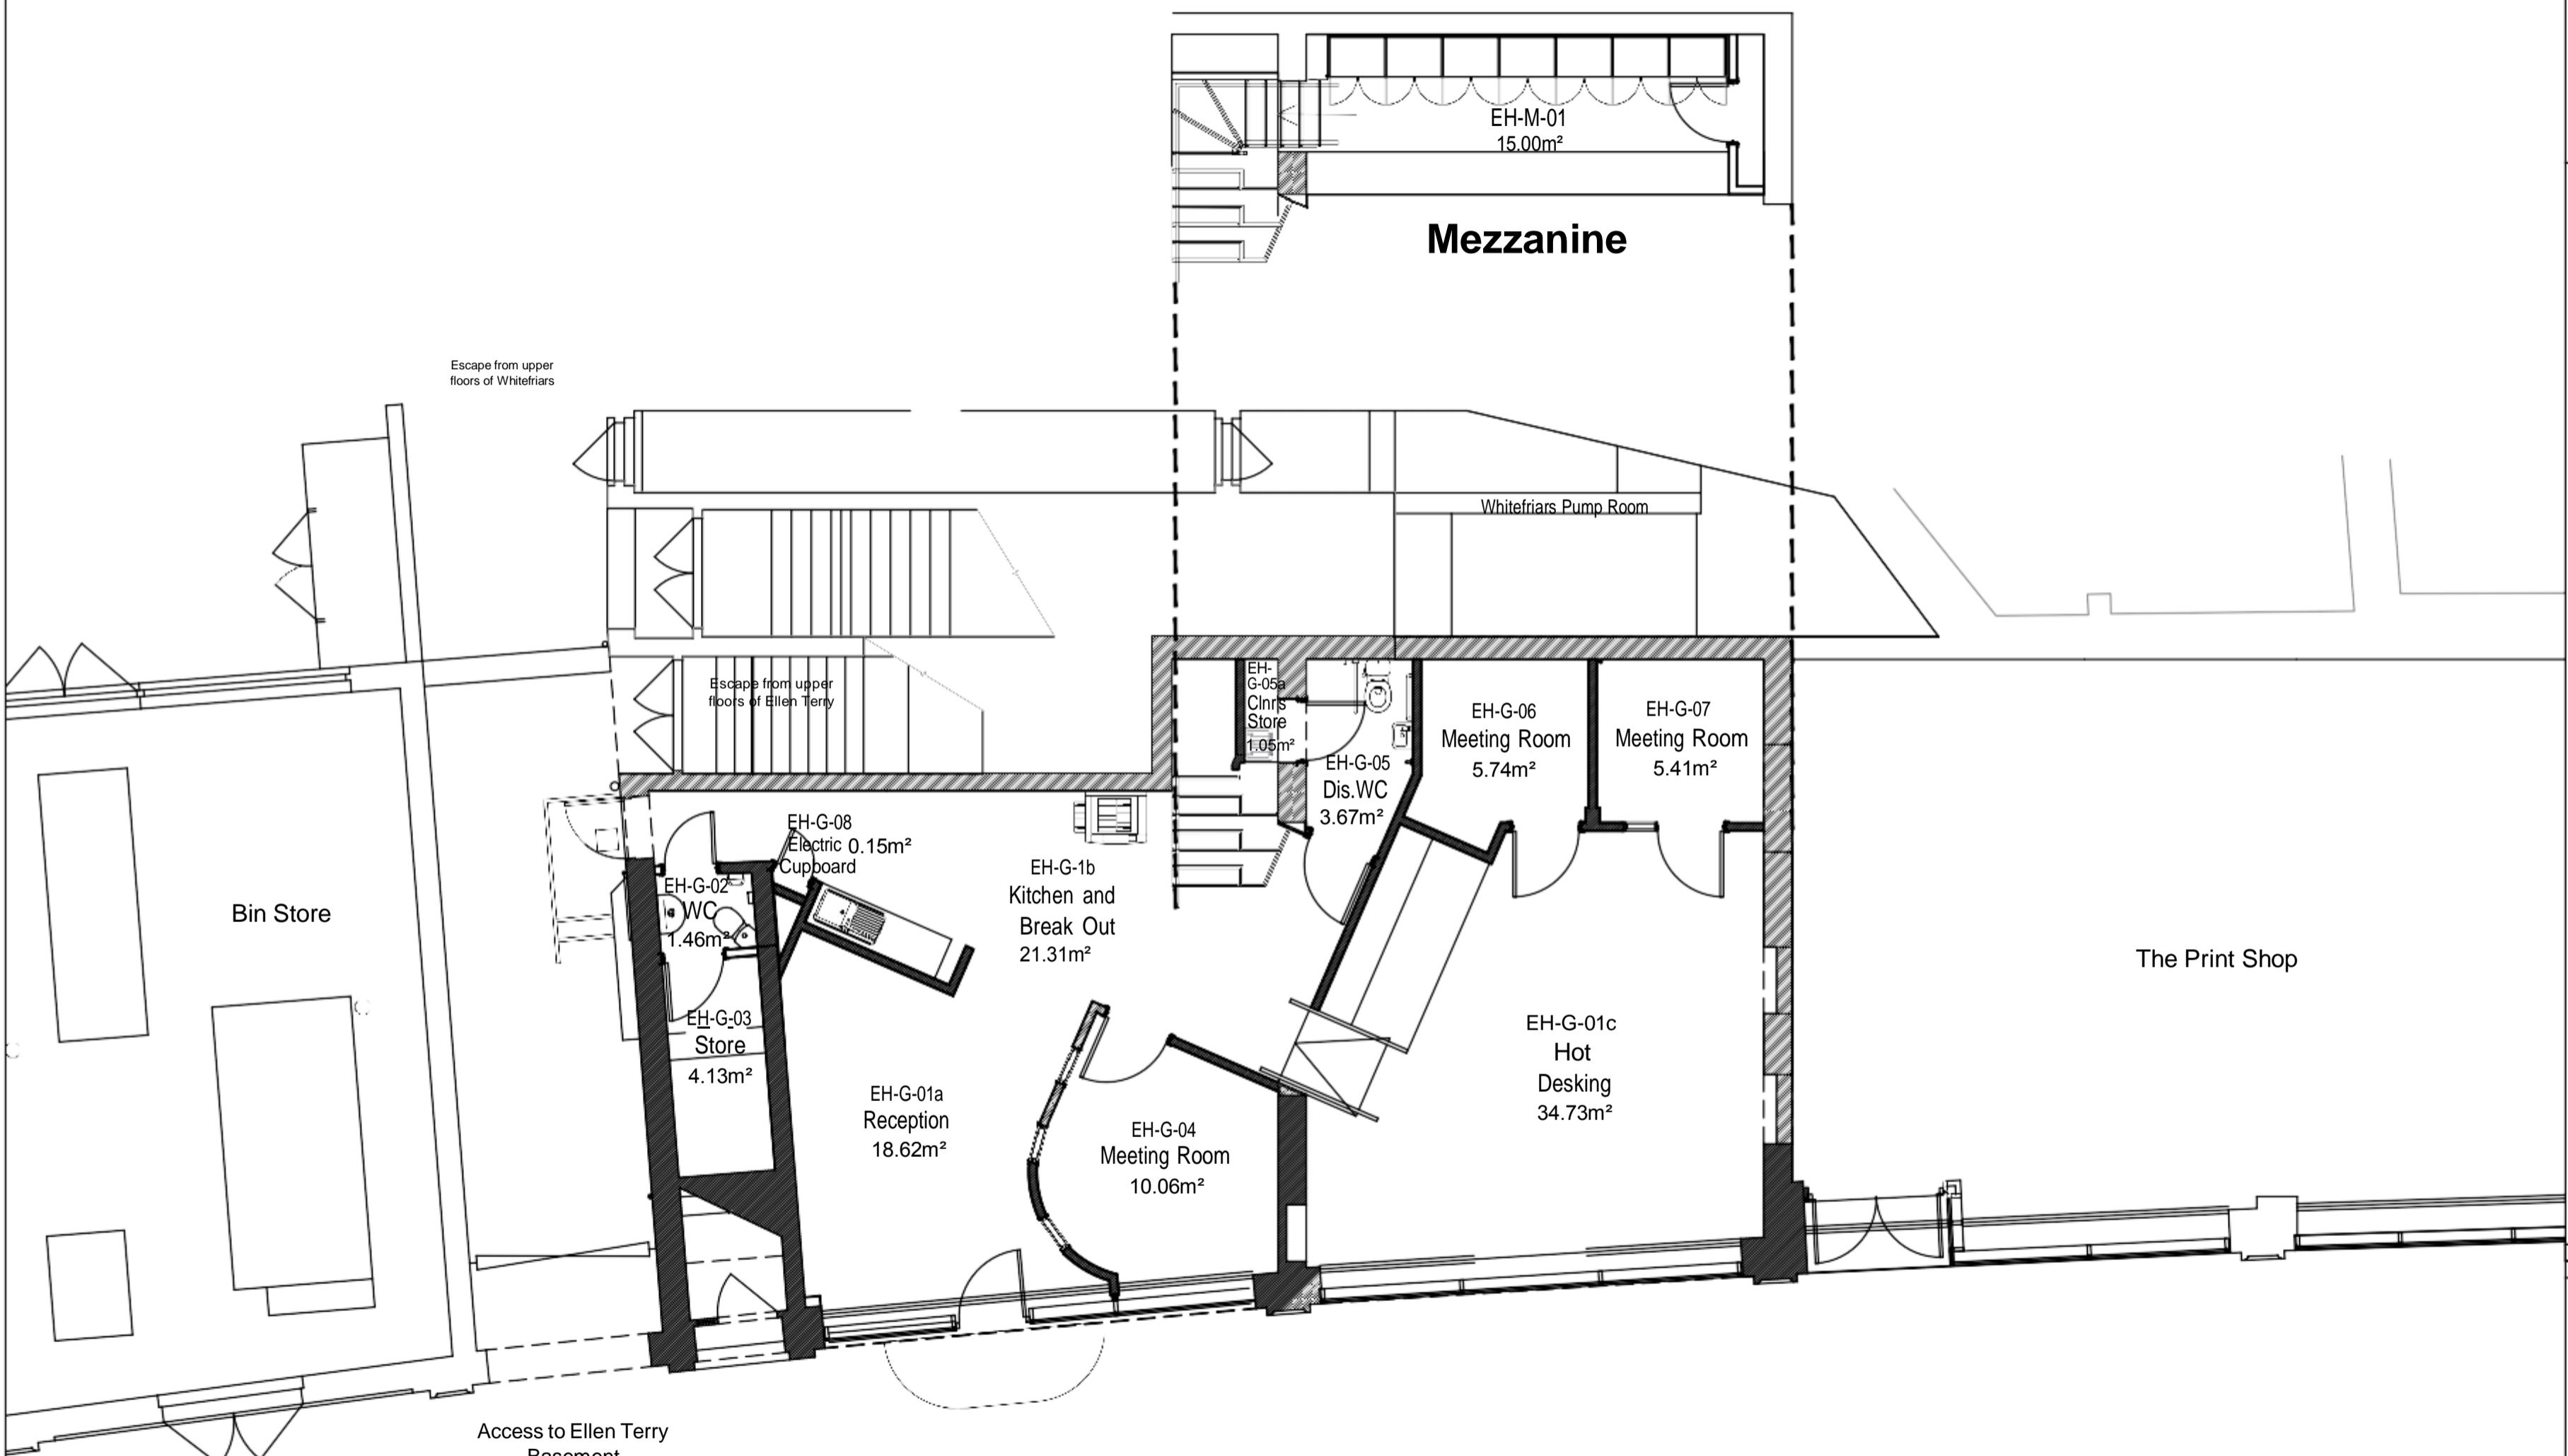

The Enterprise Hub
Ground Floor Plan

Rev. Date Amendment


Coventry University

Estates Department
Pivory Street, Coventry
CV1 5FB
Tel: 024 76887688
Fax: 024 76887336

CURRENT STATUS

RECORD DRAWING

PROJECT

THE ENTERPRISE HUB

TITLE

GROUND FLOOR PLAN

DRAWN PC	CHKD HS	DATE 13/04/2018
SCALE 1/50 @ A1 1/100 @ A2	DRAWING No. WFEH001-COV-00-GF-M2-A	REV. 0000

NOTES

This Drawing Is The Copyright Of Coventry University Estates Department & Must Not Be Reproduced Without Their Permission. Figured Dimensions Must Be Taken In Preference To Scaled Dimensions & All Dimensions Must Be Verified On Site Prior To Commencing Any Works.

NIA : 127.57m²
(Net Internal Area) :

GIA : 157.79m²
(Gross Internal Area)

GEA : 184.07m²
(Gross External Area)



Rev. Date Amendment



Estate Department
Philly Street, Coventry
CV1 5FB
Tel: 024 76887688
Fax: 024 76887336

CURRENT STATUS

RECORD DRAWING

PROJECT


THE INK WELL

TITLE

GROUND FLOOR PLAN

DRAWN	PC	CHKD	DATE
		HS	16/04/2018

SCALE	1/50 @ A1	DRAWING No.	REV.
	1/100 @ A2	WFTIW001-COV-00-GF-M2-A	0000

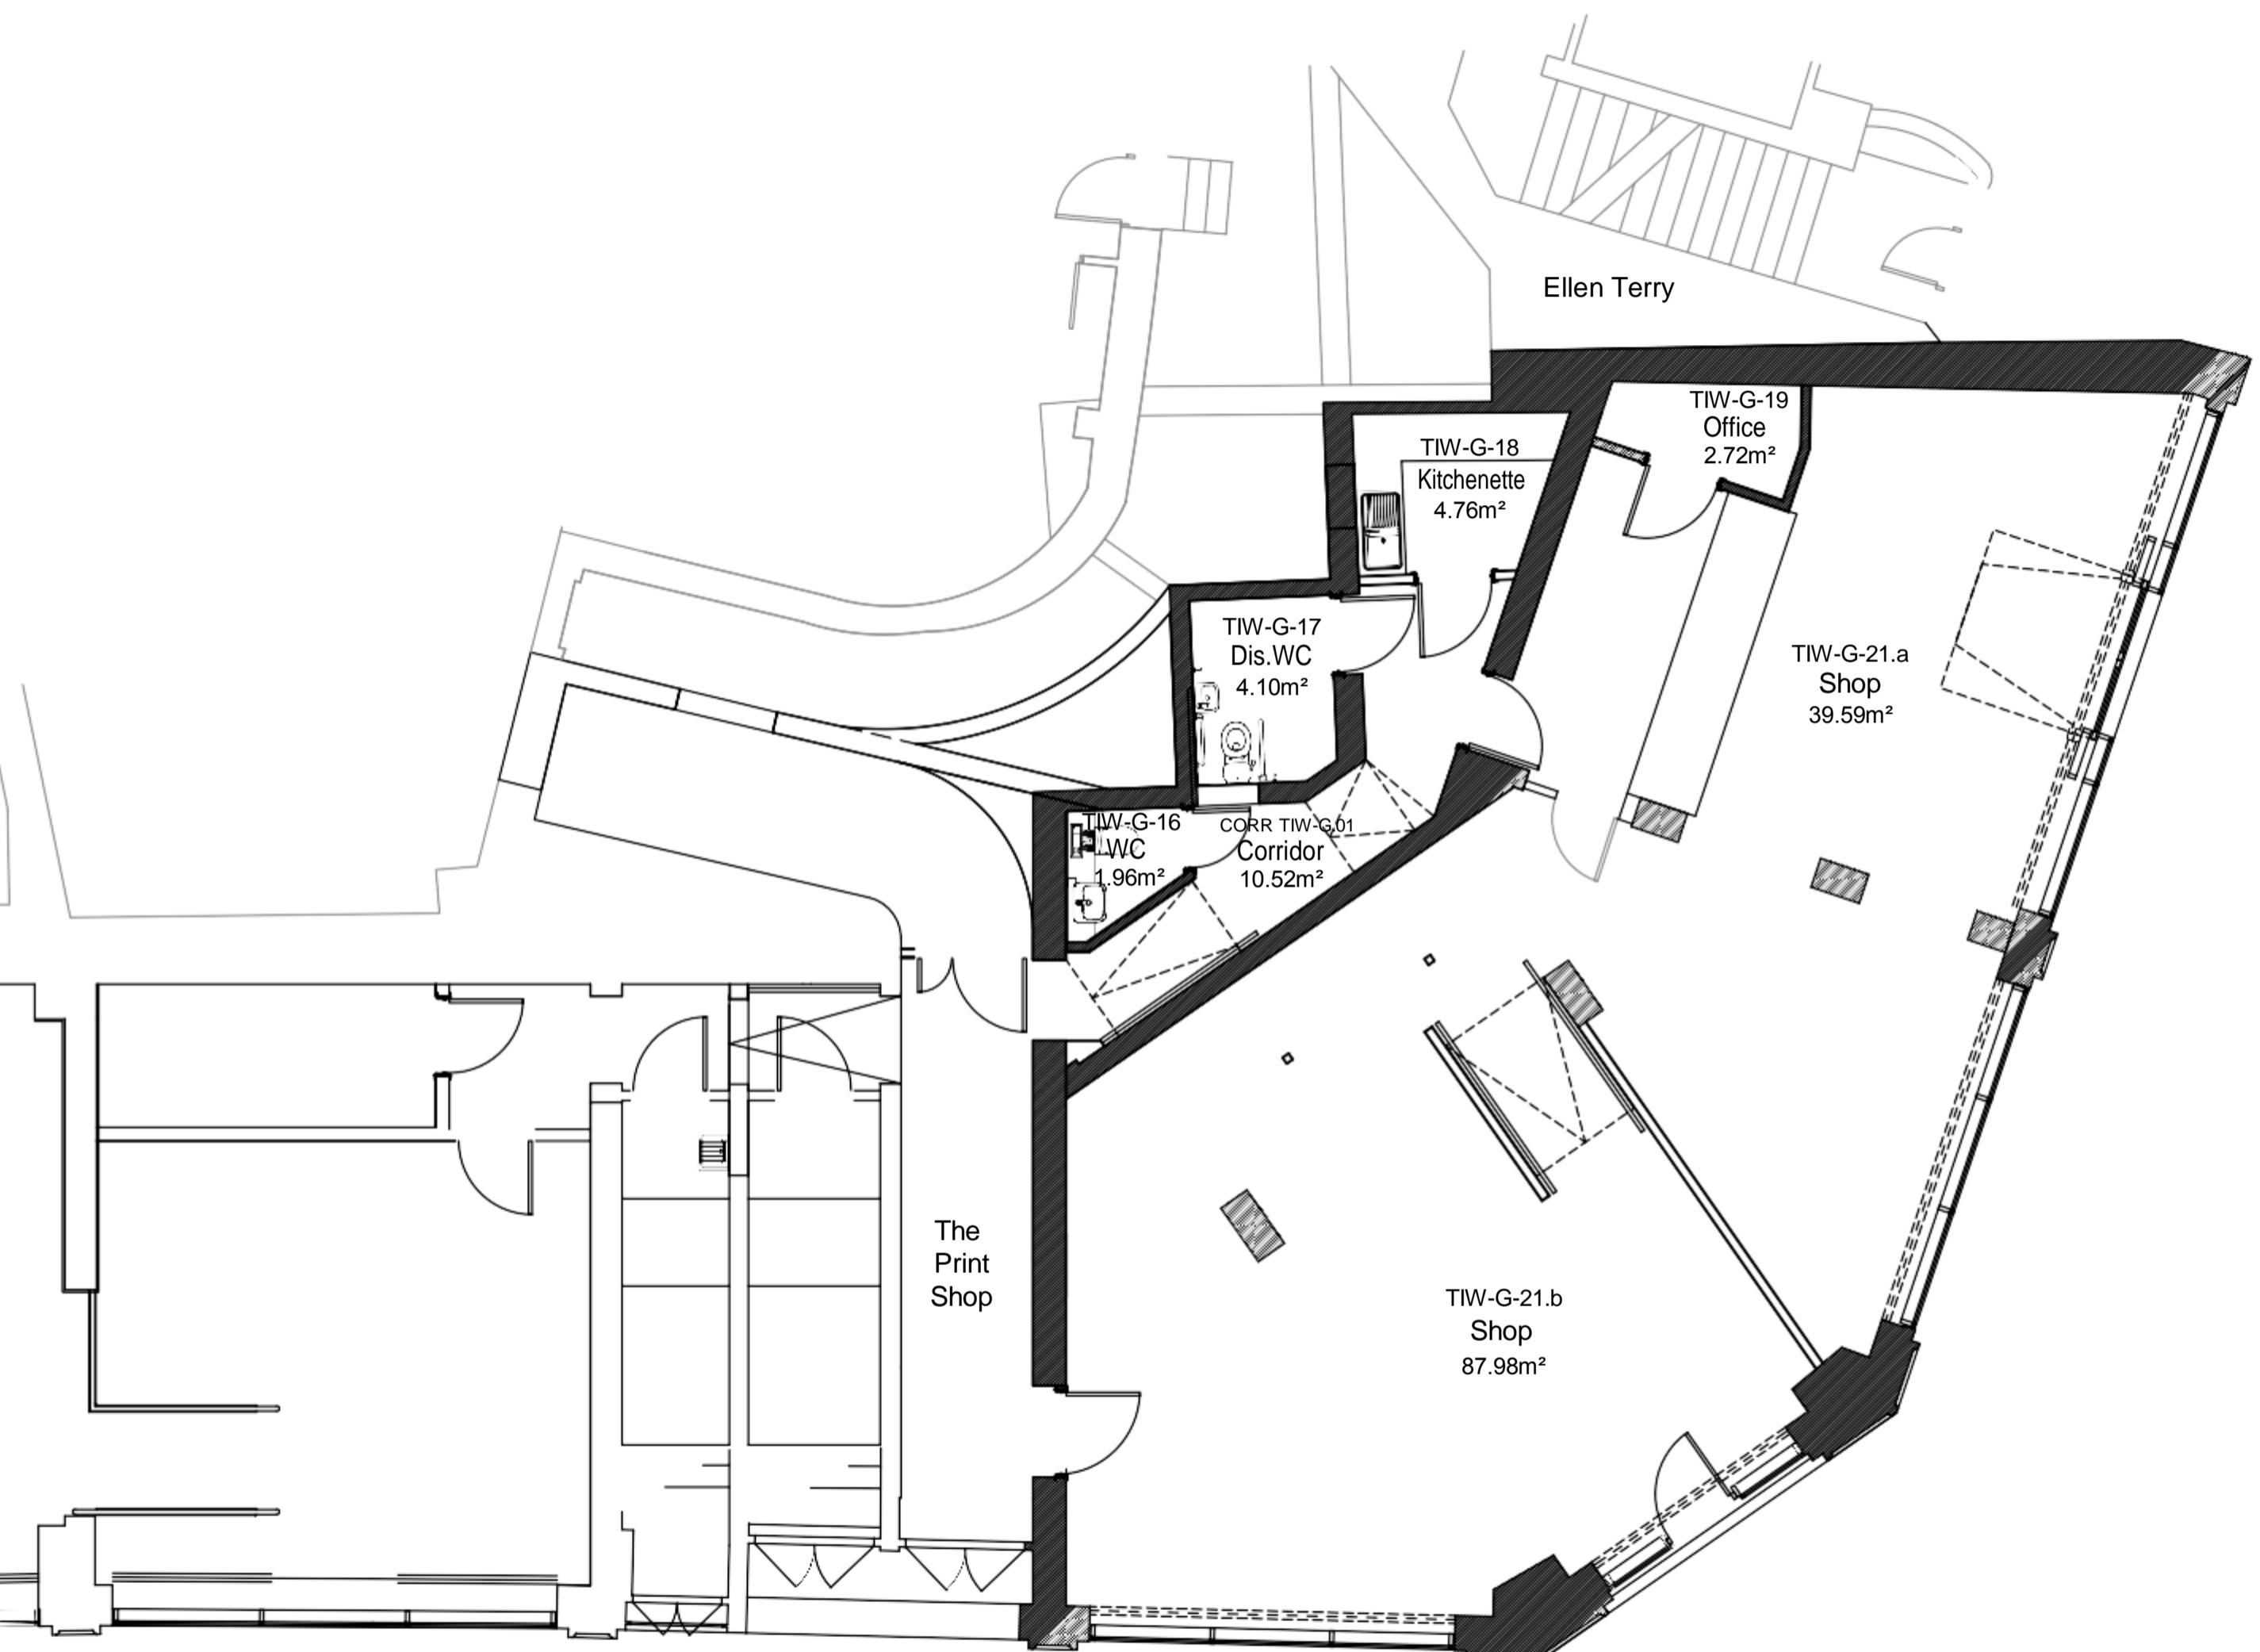


The Ink Well
Ground Floor Plan

NOTES

This Drawing Is The Copyright Of Coventry University
Estates Department & Must Not Be Reproduced
Without Their Permission. Figured Dimensions Must Be
Taken In Preference To Scaled Dimensions & All
Dimensions Must Be Verified On Site Prior To
Commencing Any Works.

NOTE

Gross Internal Area	513.30 m ²
Gross External Area	565.44 m ²
Net Internal Area	380.09 m ²

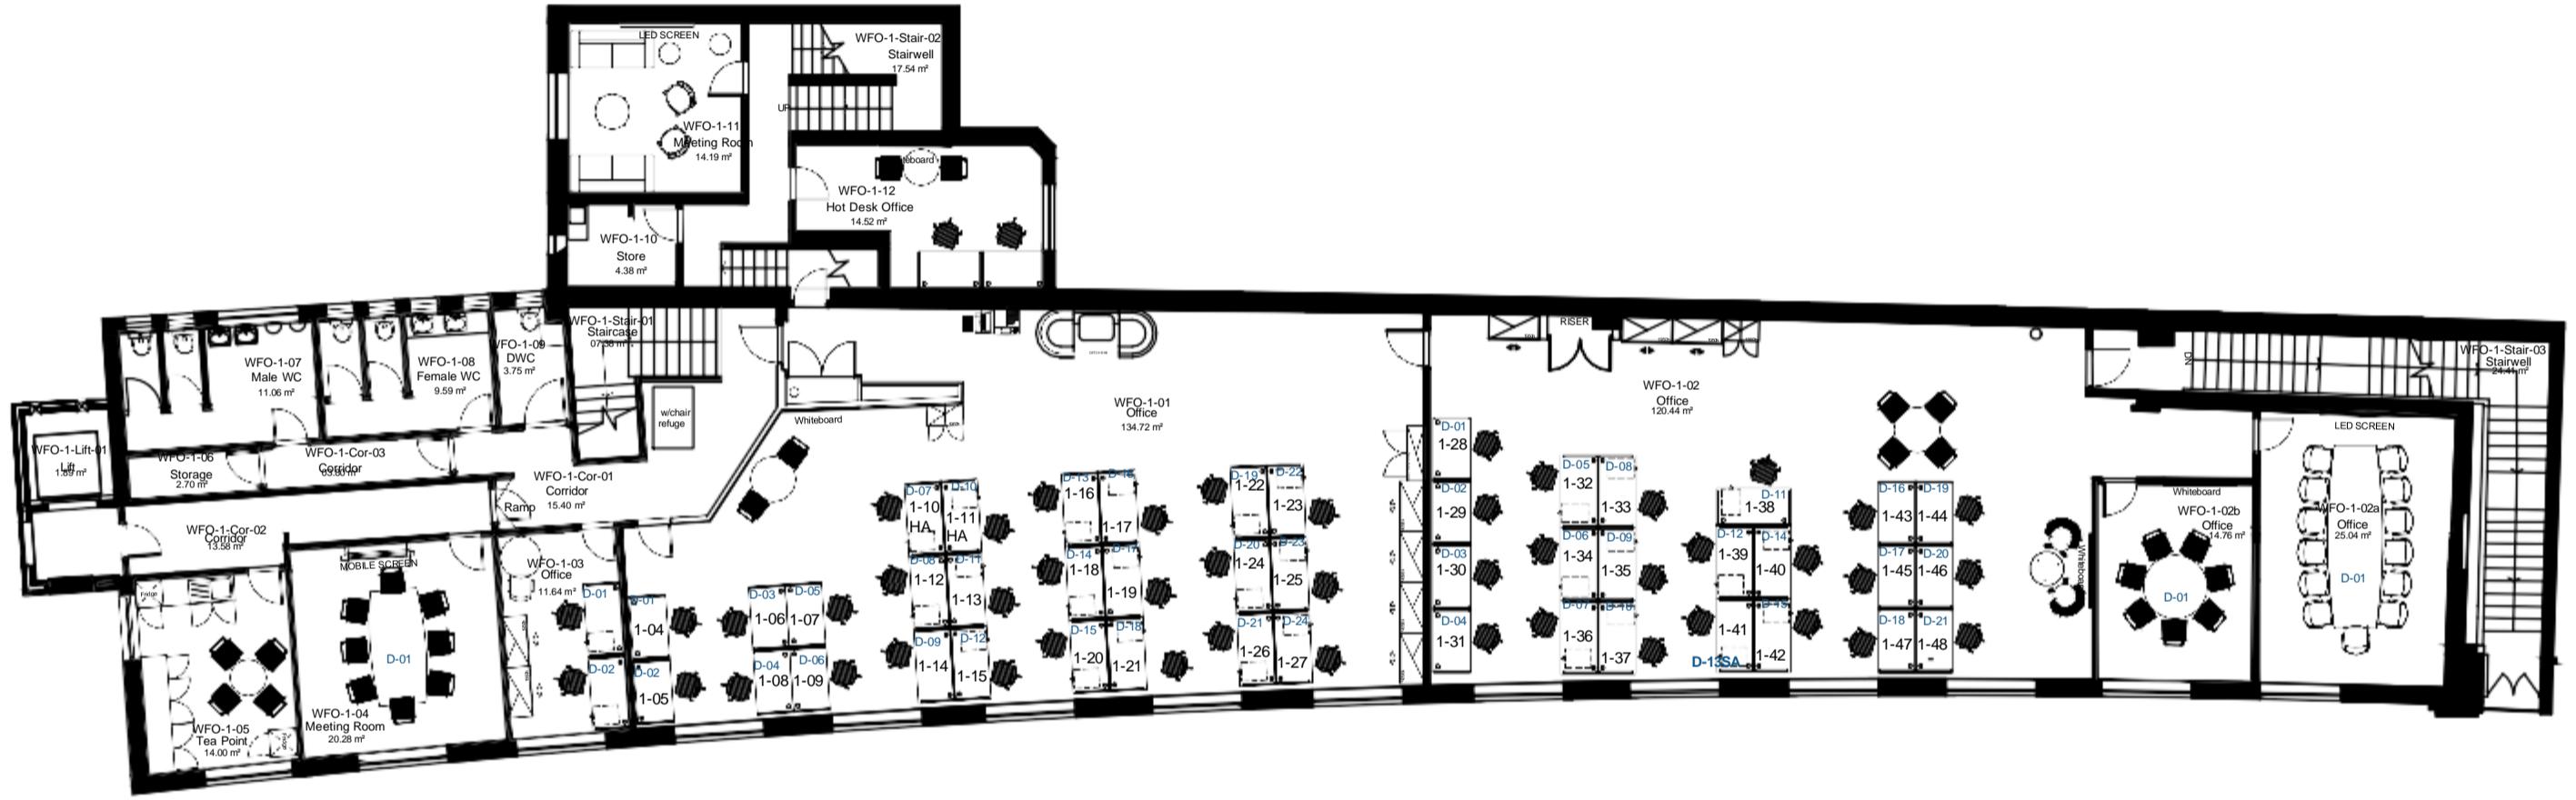

First Floor Plan

0 1 2 3 4 5

10

20m

B	08/04/21	Drawing amended to new refurbishment
A	08/09/20	Desk Numbers amended in 102
Rev.	Date	Amendment



Coventry
University

Estates Department
Priory Street, Coventry
CV1 5FB
Tel: 024 76887688
Fax: 024 76887338

CURRENT STATUS
FOR INFORMATION

PROJECT
WHITEFRIARS

TITLE
FIRST FLOOR PLAN


DRAWN	IPH/EM	CHkd	DATE
			28/04/2021
SCALE	DRAWING No.		REV.

1:100 @ A1 WF--COV-01-M2-A B

NOTES

This Drawing Is The Copyright Of Coventry University Estates Department & Must Not Be Reproduced Without Their Permission. Figured Dimensions Must Be Taken In Preference To Scaled Dimensions & All Dimensions Must Be Verified On Site Prior To Commencing Any Works.

Rev.	Date	Amendment	DRWN
A	19/03/2018	Drawing amended to match as built floor plans.	EM
B	22/03/2022	Plant room & corridor added to ground floor plan.	EM

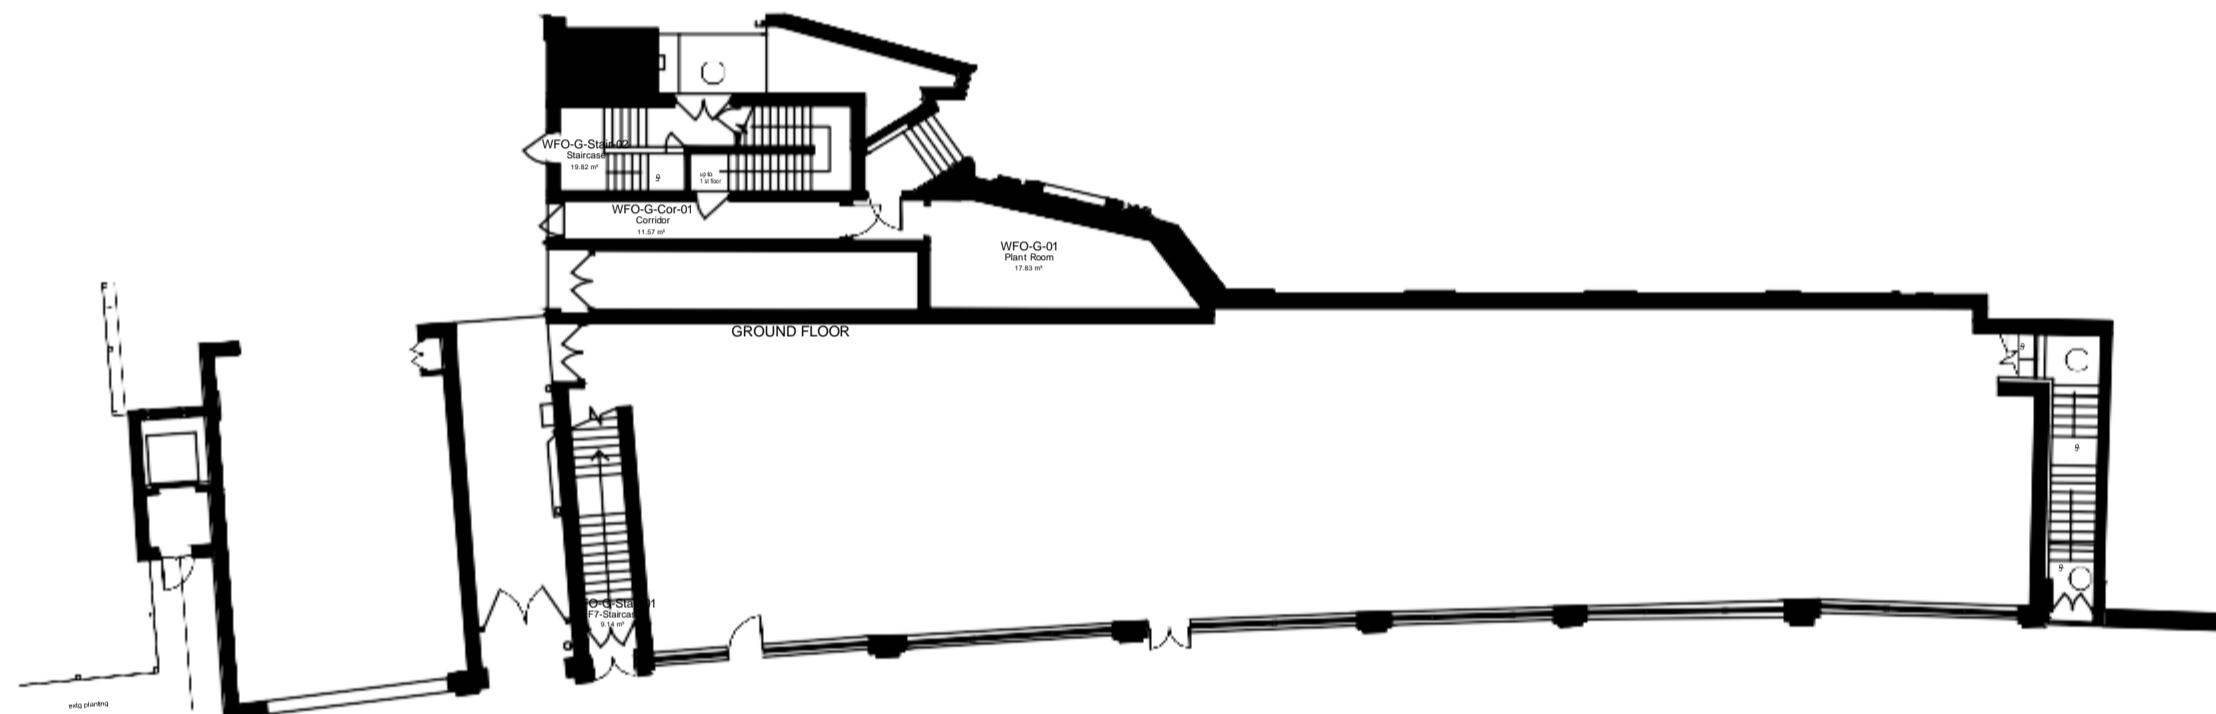

Ground Floor Plan

0 1 2 3 4 5 10 20m

**Coventry
University**

Estates Department
Priory Street, Coventry
CV1 5FB
Tel: 024 76887688
Fax: 024 76887336


CURRENT STATUS
RECORD DRAWING

PROJECT WHITEFRIARS BUILDING

TITLE
AS BUILT GROUND FLOOR PLAN

DRAWN EM **CHKD** HS **DATE** 19/03/2018

SCALE 1:200 @ A2 **DRAWING No.** WH001-COV-00-GF-M2-A **REV.** B

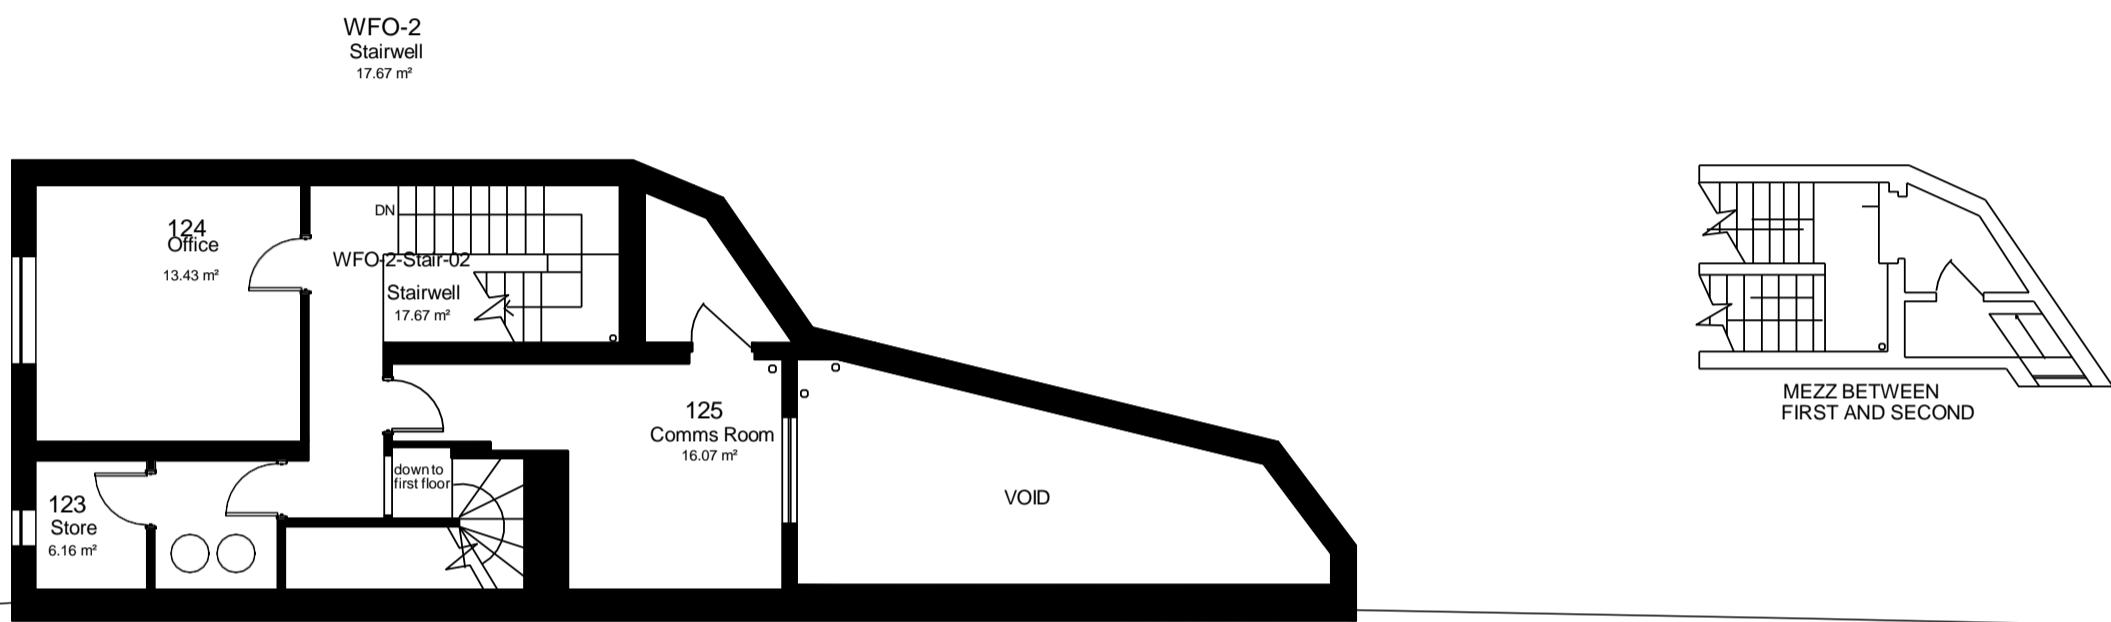

Second Floor Plan

0 1 2 3 4 5 10 20m

NOTES

This Drawing Is The Copyright Of Coventry University Estates Department & Must Not Be Reproduced Without Their Permission. Figured Dimensions Must Be Taken In Preference To Scaled Dimensions & All Dimensions Must Be Verified On Site Prior To Commencing Any Works.

Rev.	Date	Amendment	DRWN
A	19/03/2018	Drawing amended to match as built floor plans.	EM



NOTE

Gross Internal Area	58.11 m ²
Net Internal Area	20.48 m ²
Gross External Area	94.80 m ²

*	*	*
Rev.	Date	Amendment



Estates Department
Priory Street, Coventry
CV1 5FB
Tel: 024 76887688
Fax: 024 76887336

CURRENT STATUS

RECORD DRAWING

PROJECT WHITEFRIARS BUILDING

TITLE

AS BUILT SECOND FLOOR PLAN

DRAWN	EM	CHKD	DATE
		HS	10/10/2018

SCALE	DRAWING No.	REV.
1:100 @ A2	WH001-COV-00-02-M2-A	A