


NOTES

This Drawing Is The Copyright Of Coventry University Estates Department & Must Not Be Reproduced Without Their Permission. Figured Dimensions Must Be Taken In Preference To Scaled Dimensions & All Dimensions Must Be Verified On Site Prior To Commencing Any Works.

GIA (gross Internal Area)	1659.94 m ²
GEA (gross External Area)	1764.68 m ²
NIA (Net Internal Area)	/ m ²

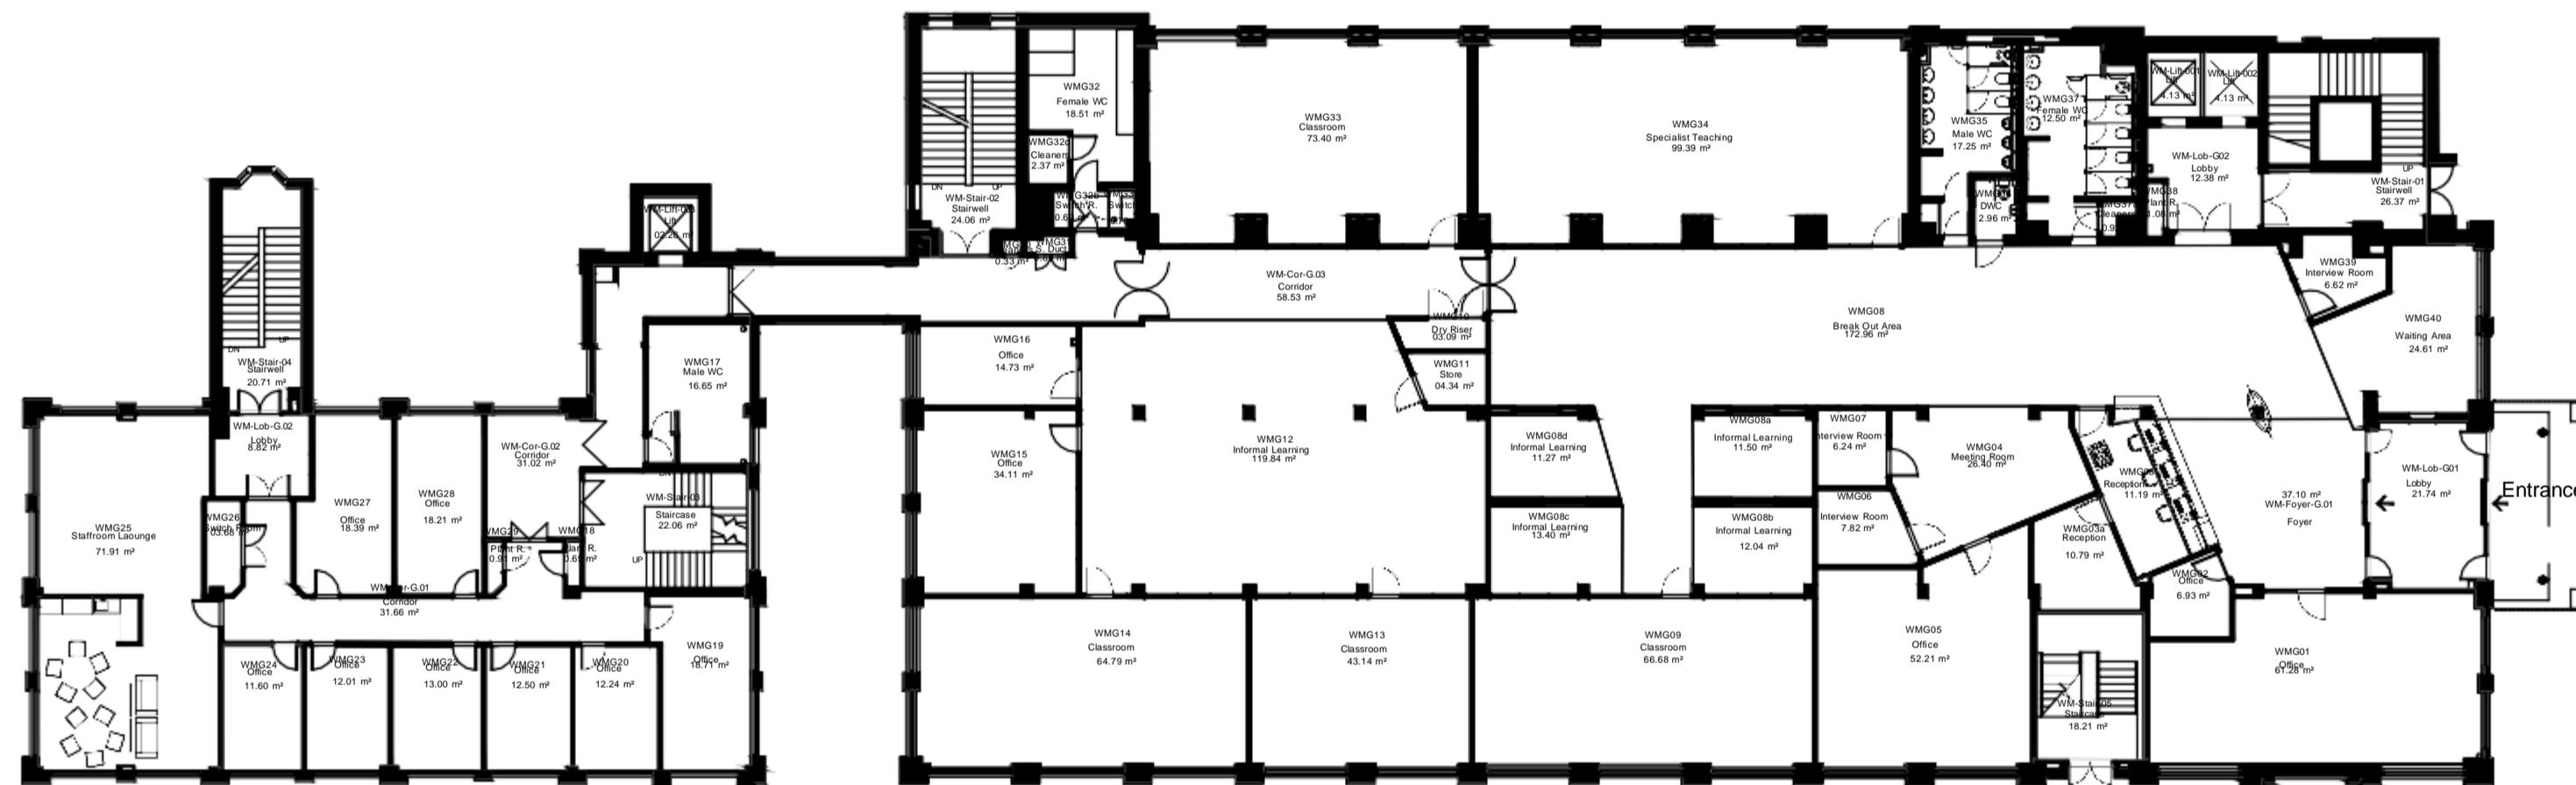

Ground Floor Plan

B	26/05/2022	G15-G16 space names updated
A	19/04/2018	Drawing amended to match as built floor plan
Rev	Date	Amendment



Coventry
University

Estates Department
Priory Street, Coventry
CV1 5FB
Tel: 024 76887688
Fax: 024 76887336

3D DRAWING

COLLEGE OF BUSINESS & LAW

OF BUSINESS & LAW
MORRIS BUILDING

GROUND FLOOR PLAN

CHINESE-AMERICAN

CHkD	DATE 29/05/2019
------	--------------------

0 1 2 3 4 5 10 20m

CURRENT STATUS

RECORD DRAWING

PROJECT

FACULTY OF BUSINESS & LAW

FACULTY OF BUSINESS & LAW
WILLIAM MORRIS BUILDING

WILLIAM VICTORIS BUILDING

As BUILT GROUND FLOOR PLAN


11. *What is the primary purpose of the following statement?*

DRAWN KA CHkD DATE 29/05/2019

NOTES

This Drawing Is The Copyright Of Coventry University Estates Department & Must Not Be Reproduced Without Their Permission. Figured Dimensions Must Be Taken In Preference To Scaled Dimensions & All Dimensions Must Be Verified On Site Prior To Commencing Any Works.

GIA (gross Internal Area)	1658.91 m ²
GEA (gross External Area)	1764.68 m ²
NIA (Net Internal Area)	/ m ²

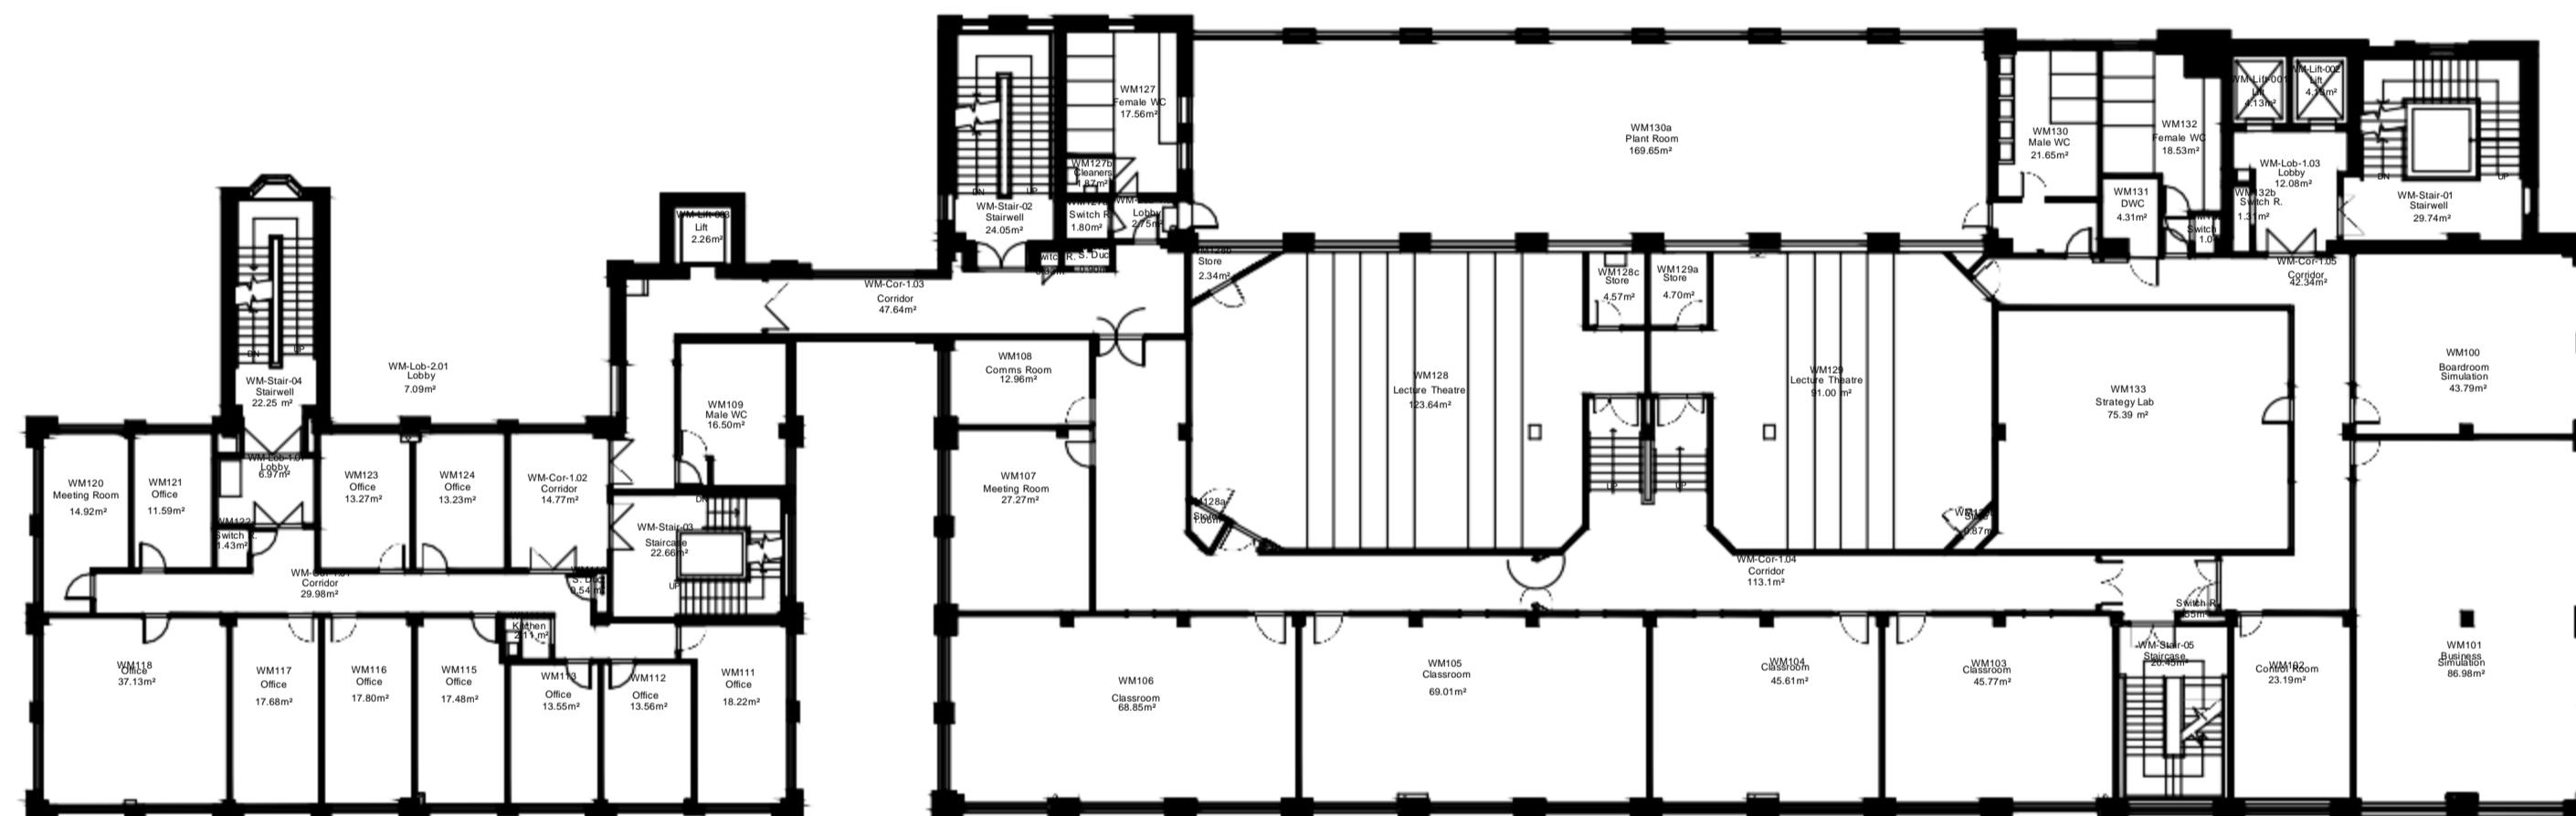

First Floor Plan

B 29/05/2019 Drawing amended to match as built floor plan
 A 23/04/2018 Drawing amended to match as built floor plan
 Rev. Date Amendment

0 1 2 3 4 5 10 20m



Coventry
University

Estates Department
Priority Street, Coventry
CV1 5FB
Tel: 024 76887688
Fax: 024 76887336

CURRENT STATUS

RECORD DRAWING

PROJECT
FACULTY OF BUSINESS & LAW
WILLIAM MORRIS BUILDING

TITLE
As BUILT FIRST FLOOR PLAN

DRAWN KA CHkD EM DATE 29/05/2019

SCALE 1:150 @ A1 DRAWING No. WM001-COV-00-01-M2-A REV. 0000

NOTES

This Drawing Is The Copyright Of Coventry University Estates Department & Must Not Be Reproduced Without Their Permission. Figured Dimensions Must Be Taken In Preference To Scaled Dimensions & All Dimensions Must Be Verified On Site Prior To Commencing Any Works.

GIA (gross Internal Area)	1430.93 m ²
GEA (gross External Area)	1537.45 m ²
NIA (Net Internal Area)	/ m ²



Second Floor Plan

B	29/05/2109	Drawing amended to match as built floor plan
A	01/05/2018	Drawing amended to match as built floor plan
Rev.	Date	Amendment

0 1 2 3 4 5 10 20m




Coventry
University

Estates Department
Priory Street, Coventry
CV1 5FB
Tel: 024 76887688
Fax: 024 76887336

CURRENT STATUS			
RECORD DRAWING			
PROJECT			
FACULTY OF BUSINESS & LAW			
WILLIAM MORRIS BUILDING			
TITLE			
As BUILT SECOND FLOOR PLAN			
DRAWN		CHKD	DATE
KA		EM	29/05/2019
SCALE		DRAWING No.	
1:150 @ A1		WM001-COV-00-02-M2-A	
		REV.	
		0000	

NOTES	
This Drawing Is The Copyright Of Coventry University Estates Department & Must Not Be Reproduced Without Their Permission. Figured Dimensions Must Be Taken In Preference To Scaled Dimensions & All Dimensions Must Be Verified On Site Prior To Commencing Any Works.	
GIA (gross Internal Area)	1350.79 m ²
GEA (gross External Area)	1575.18 m ²
NIA (Net Internal Area)	/ m ²

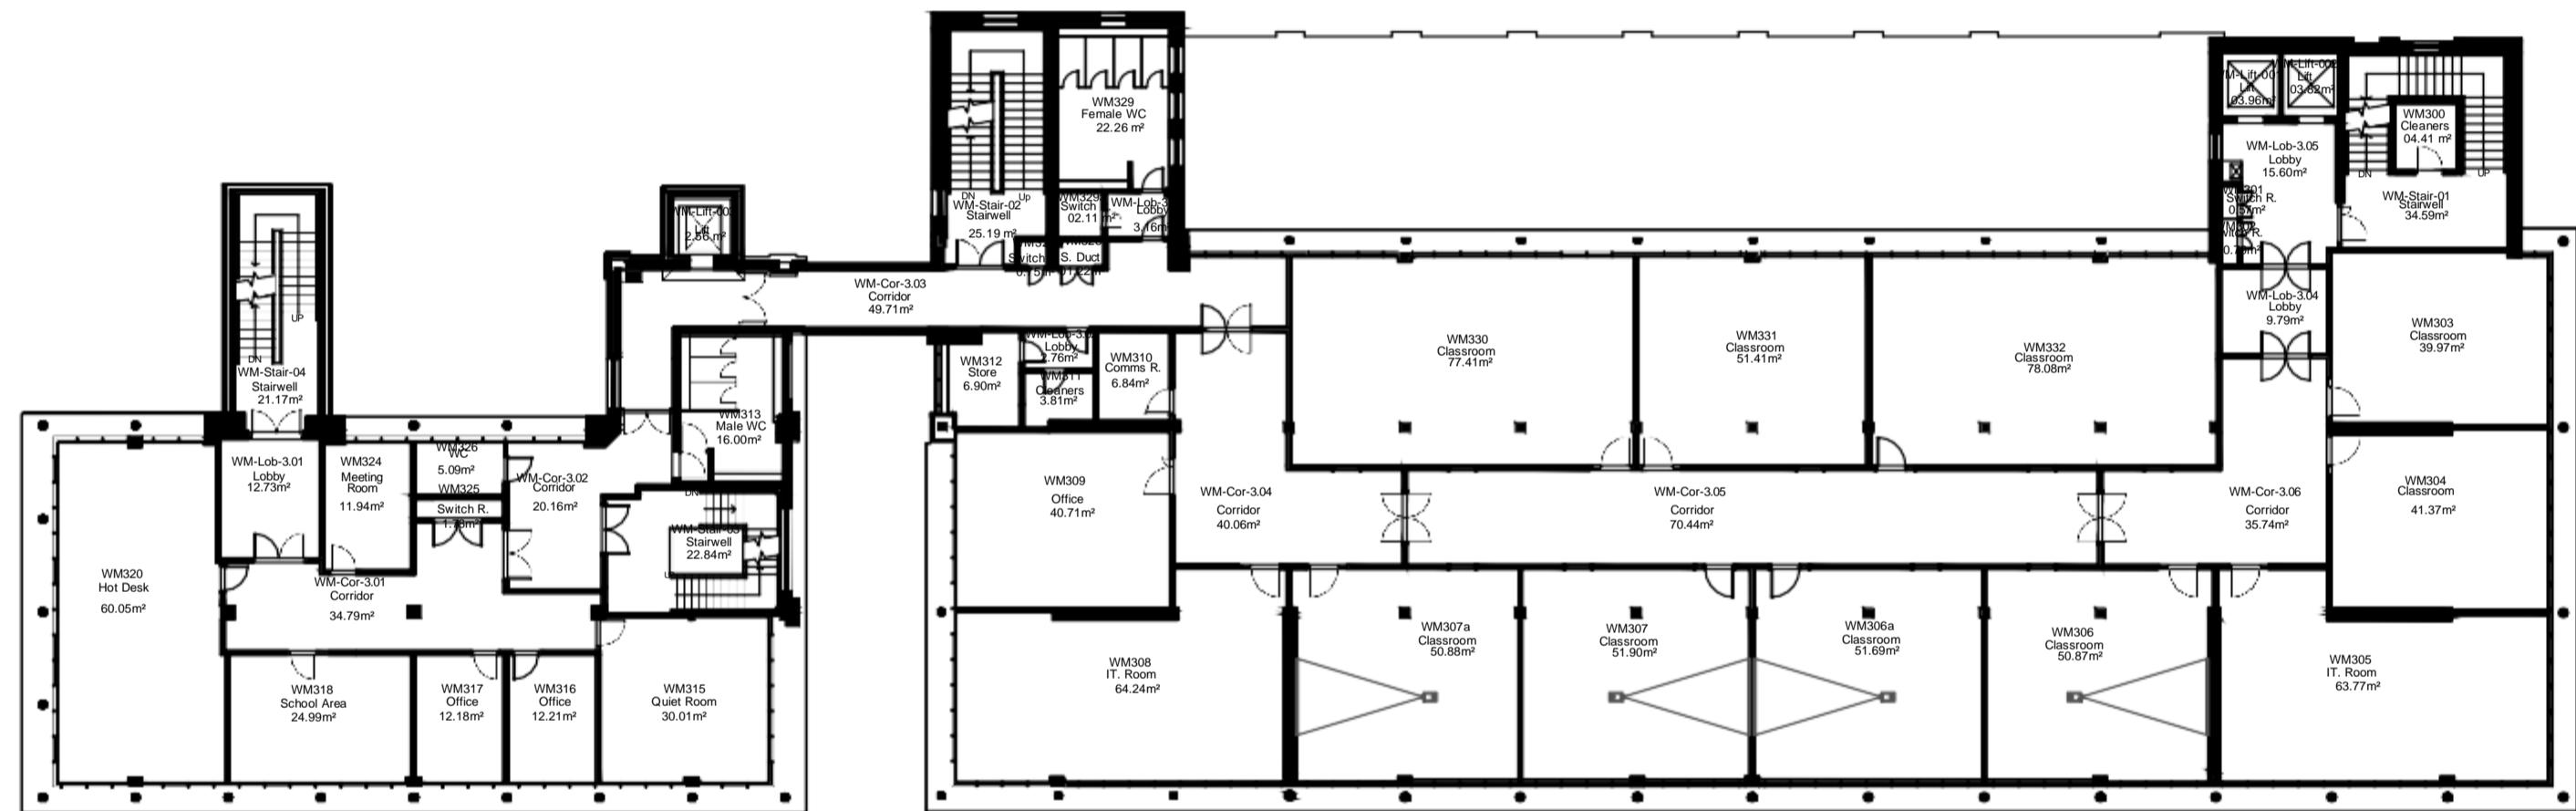

Third Floor Plan

	02/05/2018	Drawing amended to match as built floor plan
v.	Date	Amendment




Coventry
University

Estates Department
Priory Street, Coventry
CV1 5FB
Tel: 024 76887688
Fax: 024 76887336

RENT STATUS			
RECORD DRAWING			
PROJECT			
FACULTY OF BUSINESS & LAW			
WILLIAM MORRIS BUILDING			
TITLE			
As BUILT THIRD FLOOR PLAN			
AWN	KA	CHKD EM	DATE 29/05/2019
ALE 1:150 @ A1	DRAWING No. WM001-COV-00-03-M2-A	REV.	0000

NOTES

This Drawing Is The Copyright Of Coventry University Estates Department & Must Not Be Reproduced Without Their Permission. Figured Dimensions Must Be Taken In Preference To Scaled Dimensions & All Dimensions Must Be Verified On Site Prior To Commencing Any Works.

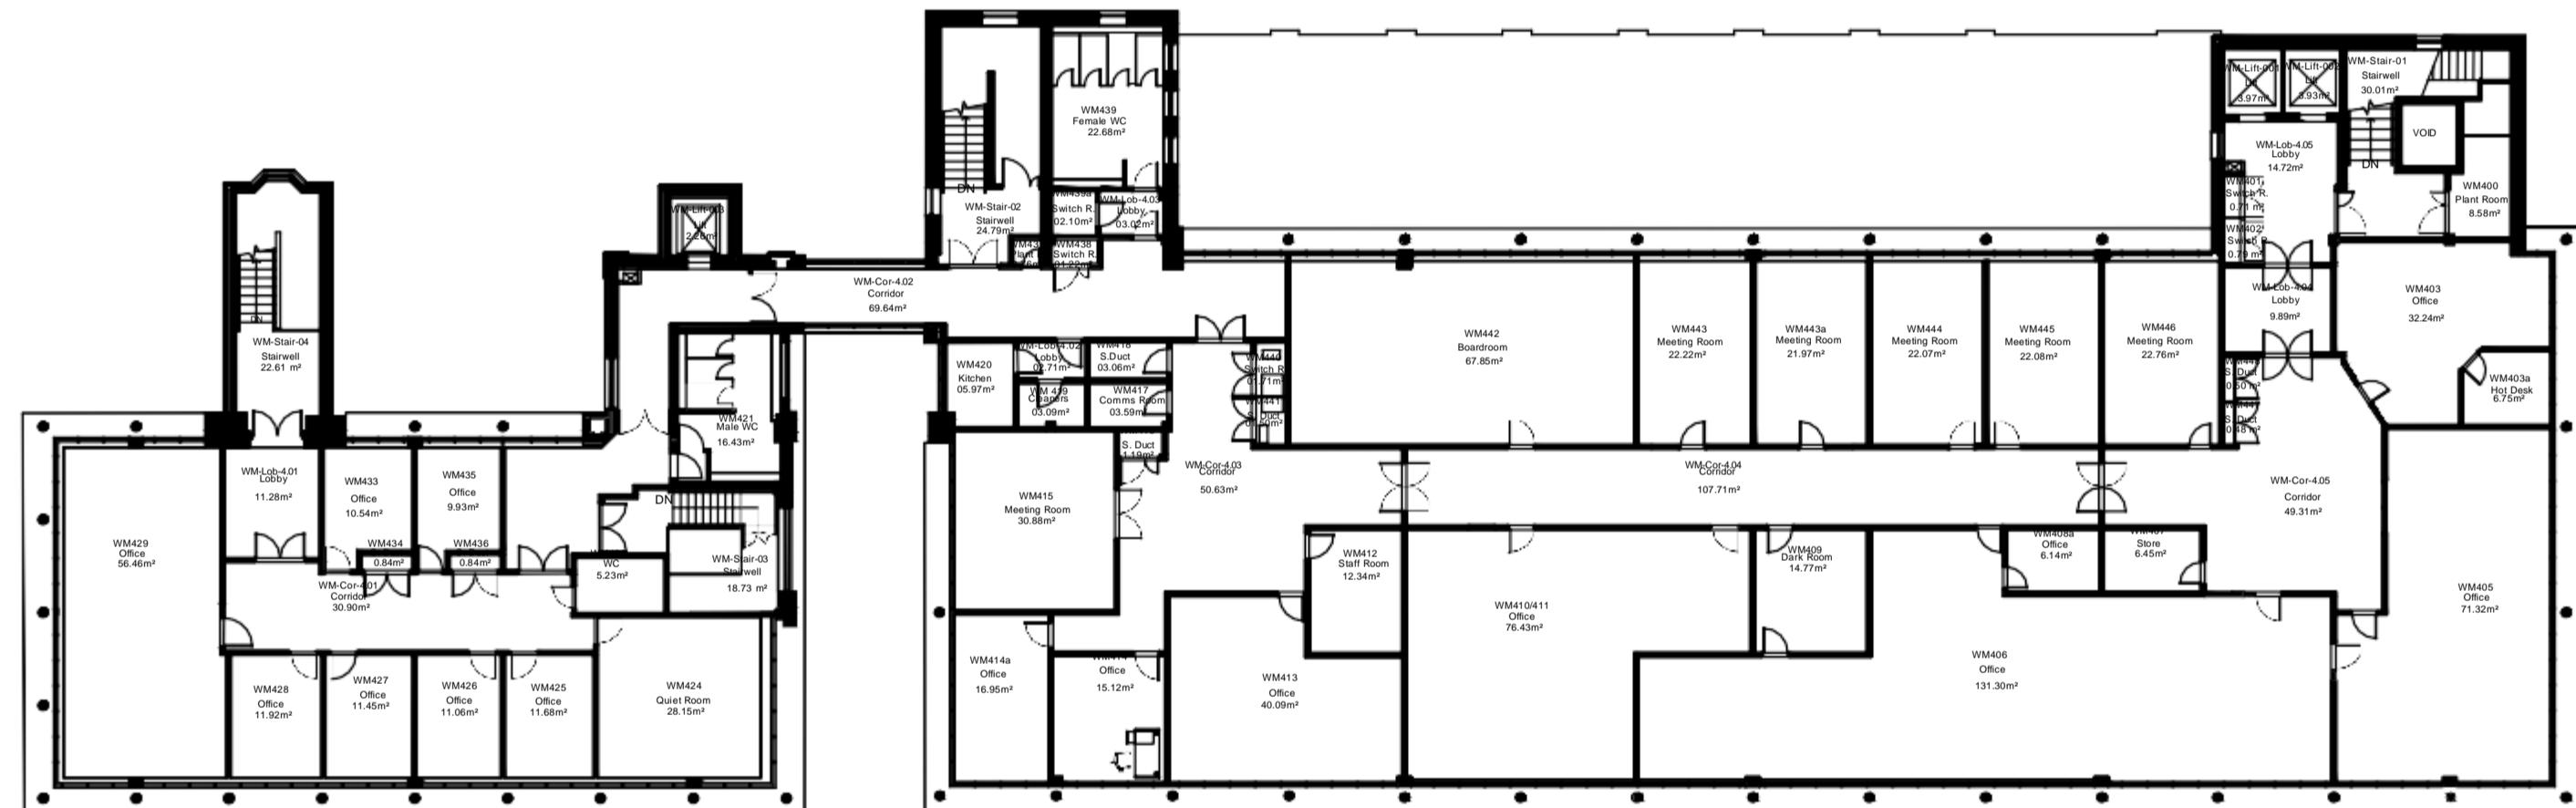

Fourth Floor Plan

B	24/05/2022	WM413 layout amended to match as built
A	03/05/2018	Drawing amended to match as built floor plan
Rev	Date	Amendment



Coventry
University

Estates Department
Priory Street, Coventry
CV1 5FB
Tel: 024 76887688
Fax: 024 76887336

BR DRAWING

RD DRAWING

SCOPE OF BUSINESS

Y OF BUSINESS
L MORRIS BUIL

THE MORRIS BUILDING

FOURTH FLOOR

CHkD	DATE
FM	29/0

EM 29/0

DRAWING No.

0 1 2 3 4 5 10 20m




NOTES

This Drawing Is The Copyright Of Coventry University Estates Department & Must Not Be Reproduced Without Their Permission. Figured Dimensions Must Be Taken In Preference To Scaled Dimensions & All Dimensions Must Be Verified On Site Prior To Commencing Any Works.

GIA (gross Internal Area)	189.48 m ² (W+E Areas)
GEA (gross External Area)	238.24 m ²
NIA (Net Internal Area)	/ m ²

N

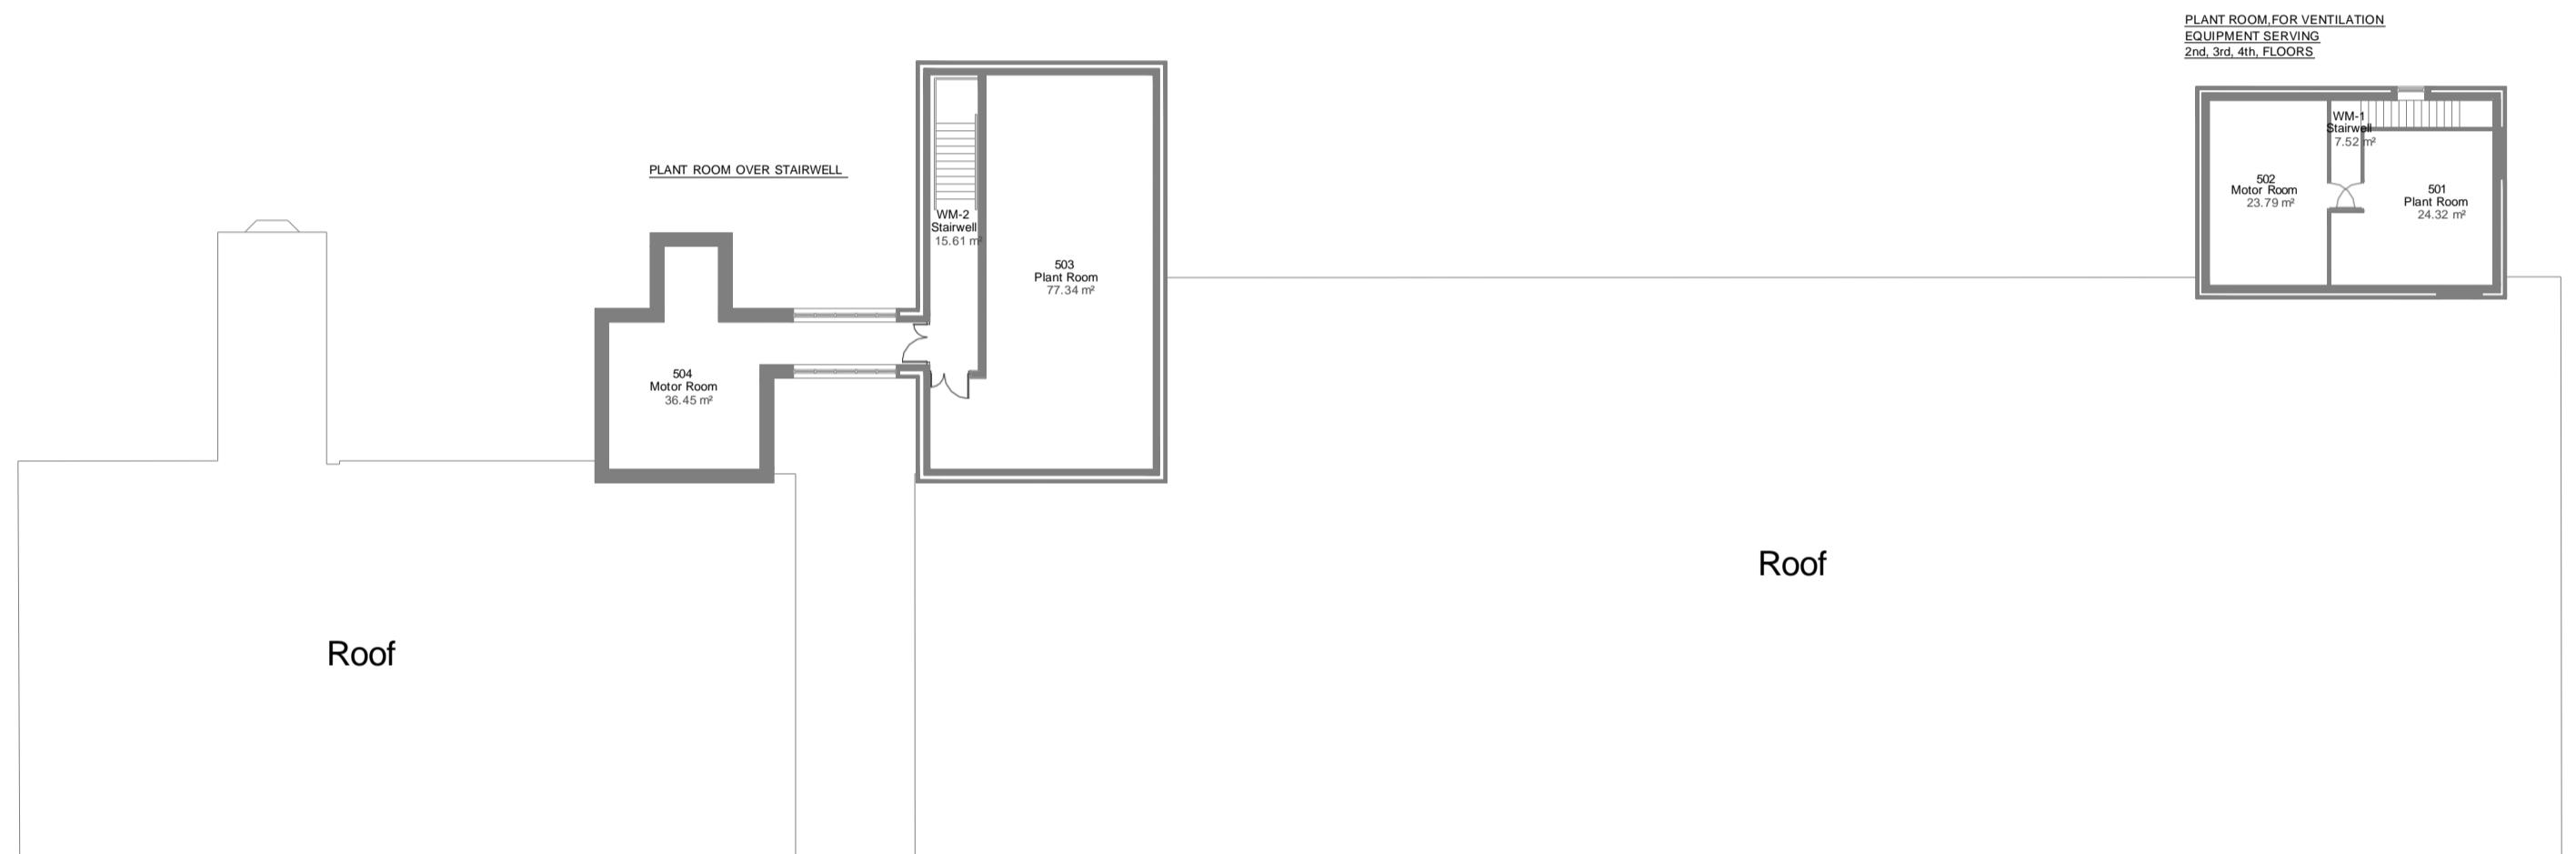

Fifth Floor Plan

0 1 2 3 4 5 10 20m

A 08/05/2018 Drawing amended to match as built floor plan
Rev. Date Amendment



Coventry
University

Estates Department
Priory Street, Coventry
CV1 5FB
Tel: 024 76887688
Fax: 024 76887336

CURRENT STATUS
RECORD DRAWING

PROJECT
FACULTY OF BUSINESS & LAW
WILLIAM MORRIS BUILDING

TITLE
As BUILT FIFTH FLOOR PLAN

DRAWN EM CH&D HS DATE 08/05/2018

SCALE 1:150 @ A1 DRAWING No. WM001-COV-00-05-M2-A REV. 0000